















SCHEDULE 'F'



The  
Maplewood  
42' SERIES

Elevation A • 2,770 sq.ft.  
Elevation B • 2,725 sq.ft.


PV-102 *see attach*  
March 22 2020

BACK FLOW  
PREVENTER VALVE

9' BASEMENT  
CEILING HEIGHT

24x30"

24x30"

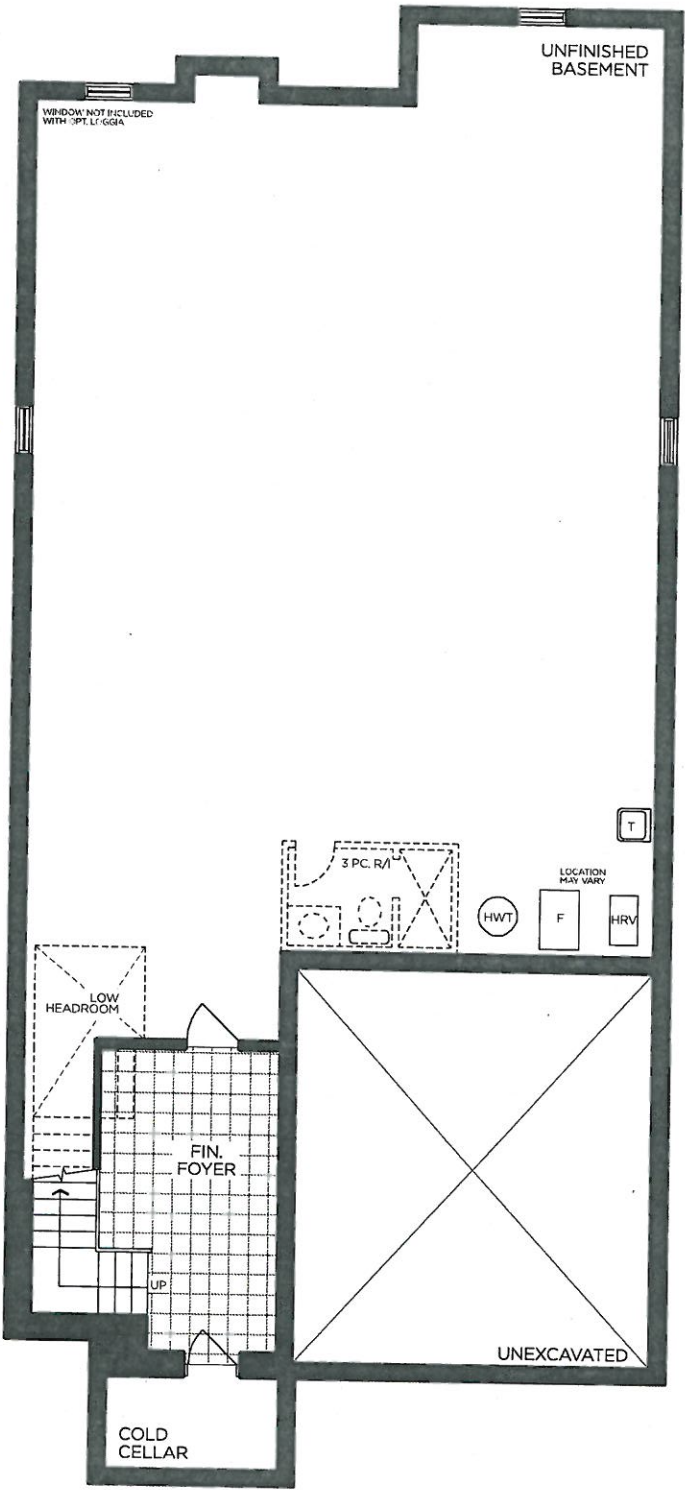

BASEMENT | ELEV. A

VENDOR

PURCHASER

PURCHASER


GOLDPARK  
WORTH MORE™

Prices, figures, illustrations, sizes, features and finishes are subject to change without notice. Areas and dimensions are approximate and actual usable floor space may vary from the stated area. Layout may be reverse of the unit purchased. E. & O.E. 4201

see attach.

TV-102  
MAR 22 2020

Elevation A • 2,770 sq.ft.  
Elevation B • 2,725 sq.ft.

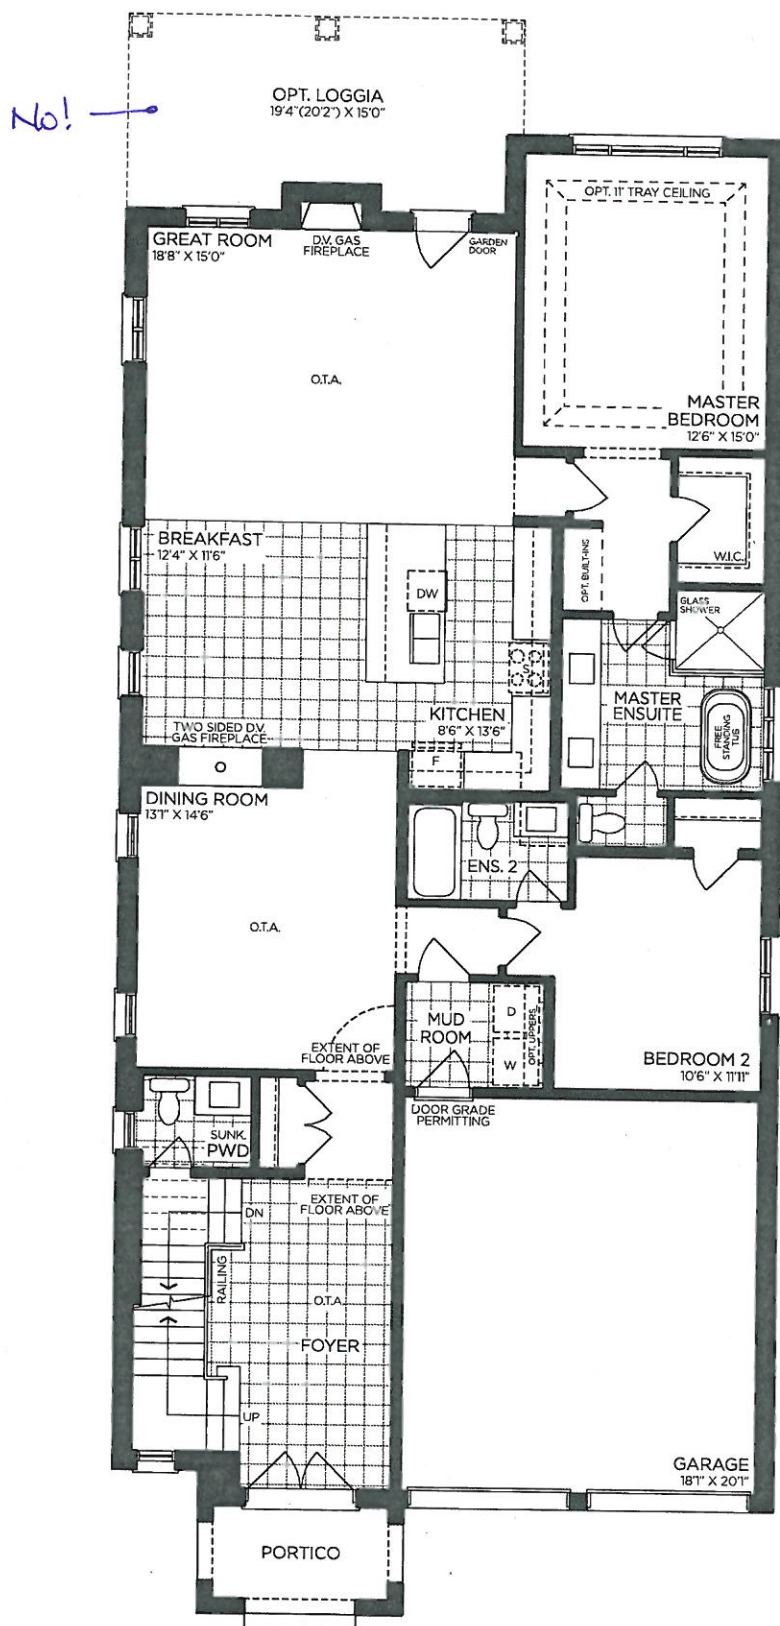

GROUND FLOOR | ELEV. A

--

--

--

**GOLDPARK**  
WORTH MORE™

Prices, figures, illustrations, sizes, features and finishes are subject to change without notice. Areas and dimensions are approximate and actual usable floor space may vary from the stated area. Layout may be reverse of the unit purchased. E. & O.E. 4201


SCHEDULE 'F'



PV-102 *see sketch*  
March 22 2020

The  
Maplewood  
42' SERIES

Elevation A • 2,770 sq.ft.  
Elevation B • 2,725 sq.ft.

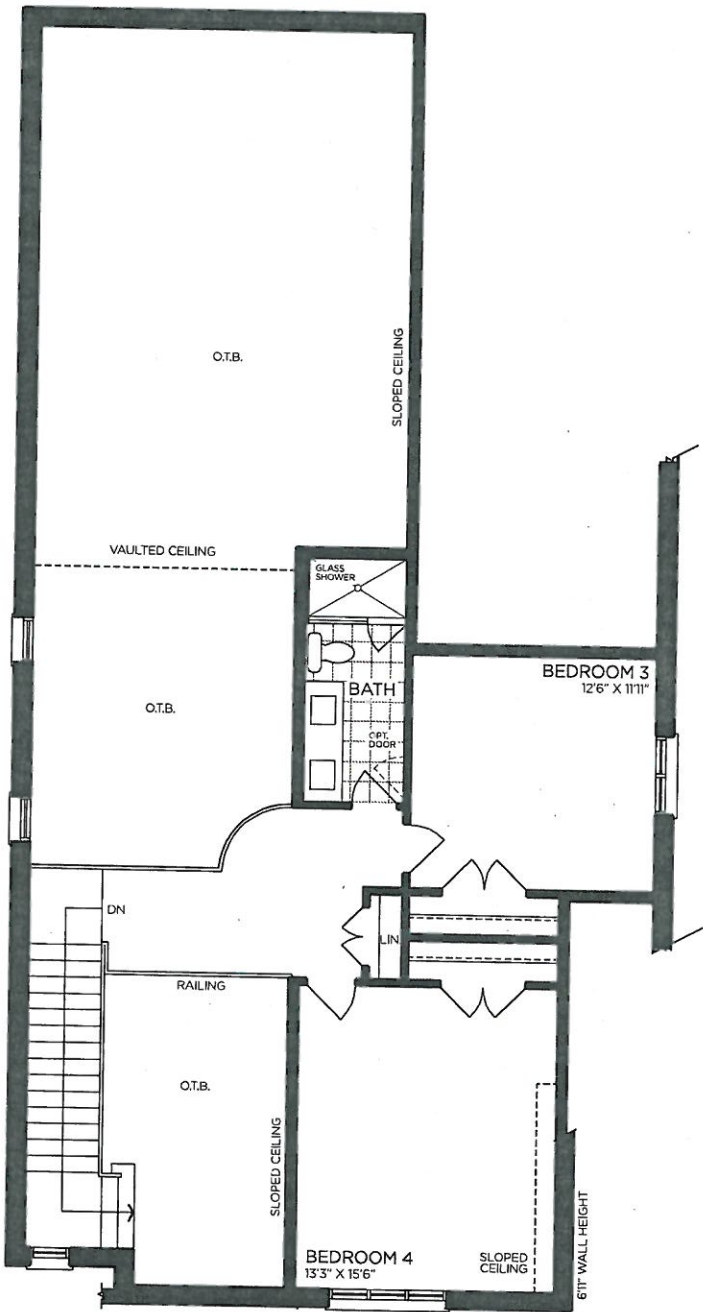

LOFT | ELEV. A

VENDOR	
PURCHASER	
PURCHASER	

GOLDPARK  
WORTH MORE™

Prices, figures, illustrations, sizes, features and finishes are subject to change without notice. Areas and dimensions are approximate and actual usable floor space may vary from the stated area. Layout may be reverse of the unit purchased. E. & O.E. 4201