

GOLDPARK

WORTH MORE™

CONSTRUCTION SUMMARY

Lot: 103

Model: 50.04 C BEAUMONT

Project/Phase: Pine Valley Forevergreen / 1

Invoice	Qty.	Description
---------	------	-------------

CERAMIC

Invoice	Qty.	Description
2357	1	.**CUSTOM LAYOUT** ADD 1 ADDITIONAL SHOWER FAUCET IN MASTER ENSUITE SHOWER - TOTAL OF 2 SEPARATE SHOWER SYSTEMS
NoCat		
2357	1	.**CUSTOM LAYOUT** MASTER ENSUITE: DELETE DOUBLE SINK, DELETE LINEN SHELVES AND ADD VANITY TO MATCH. WITH STANDARD ELECTRICAL FIXTURE- [APS ITEM]
NoCat		

DRYWALL

Invoice	Qty.	Description
2357	1	.UPGRADE REAR GARDEN DOOR ASSEMBLY TO 8' HEIGHT
NoCat		
2357	7	.MAIN FLOOR: UPGRADE TO 9' SOLID-CORE DOORS ON MAIN FLOOR
NoCat		
2357	1	.**CUSTOM LAYOUT** FOYER: DELETE DOORS TO LIBRARY
NoCat		

ELECTRICAL

Invoice	Qty.	Description
2357 72,281	1	.GREAT ROOM: INTERIOR WALL OUTLET: ADDITIONAL 110V WALL INTERIOR RECEPTACLE ON EXISTING CIRCUIT FOR WALL MOUNTED TV - LOCATE ABOVE FIREPLACE, APPROX 66" A.F.F.
2357 72,289	6	.MAIN HALL & HALL AT MUDROOM: 4" E/S LED INTERIOR POT LIGHT - GROUND FLOOR - EACH (IN LIEU OF STANDARD CEILING LIGHTS)  INCLUDED IN APS - USE STANDARD SWITCHES
2357	1	.SERVERY: ADD DISHWASHER ROUGH-IN - SEE PLAN FOR LOCATION
NoCat		
2357	1	.**CUSTOM LAYOUT** MASTER ENSUITE: DELETE DOUBLE SINK, DELETE LINEN SHELVES AND ADD VANITY TO MATCH. WITH STANDARD ELECTRICAL FIXTURE- [APS ITEM]
NoCat		

EXTERIOR COLOURS

Invoice	Qty.	Description
2357	1	EXTERIOR COLOUR PACKAGE # C.8
NoCat		

Page 1 of 3

Printed and Sent: 03-Jun-20





SCHEDULE 'F'



PV-103

MAY 26 2020




# The Beaumont

## 50' SERIES

Elevation A • 4,170 sq.ft.  
4,315 sq.ft. Opt. Elevator

Elevation B • 4,165 sq.ft.  
4,315 sq.ft. Opt. Elevator

→ Elevation C • 4,250 sq.ft.  
4,400 sq.ft. Opt. Elevator

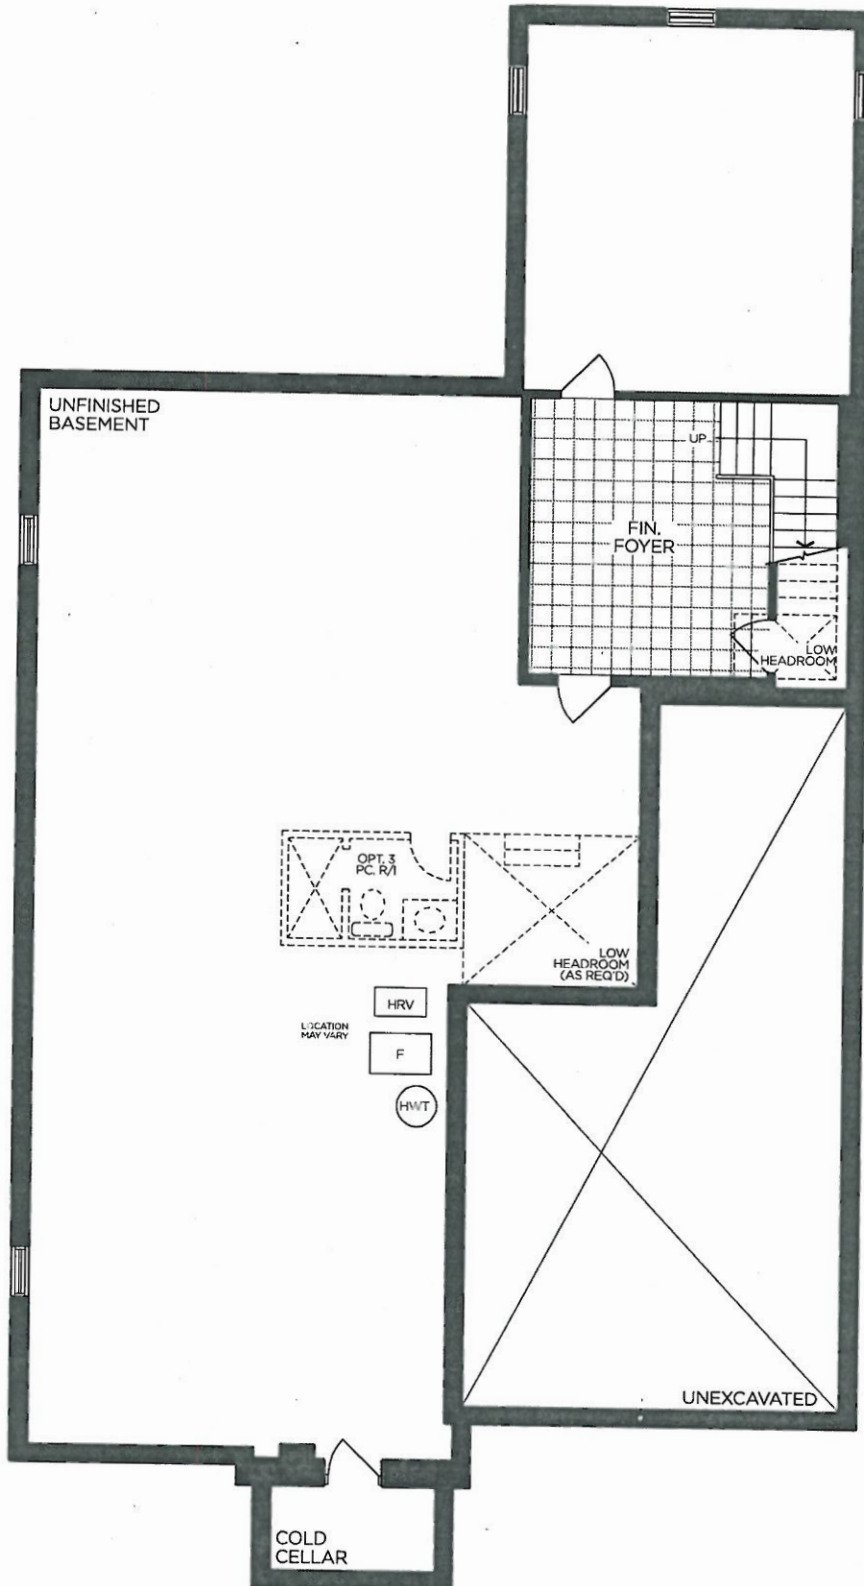

BASEMENT | ELEV. A

VENDOR

PURCHASER

PURCHASER

**GOLDPARK**  
WORTH MORE™

Prices, figures, illustrations, sizes, features and finishes are subject to change without notice. Areas and dimensions are approximate and actual usable floor space may vary from the stated area. Layout may be reverse of the unit purchased. E. & O.E. 5004

SCHEDULE 'F'



PV-103  
MAY 26 2020

See email

The  
Beaumont  
50' SERIES

Elevation A • 4,170 sq.ft.  
4,315 sq.ft. Opt. Elevator

Elevation B • 4,165 sq.ft.  
4,315 sq.ft. Opt. Elevator

→ Elevation C • 4,250 sq.ft.  
4,400 sq.ft. Opt. Elevator

9' DOORS ON MAIN FLOOR

No!


8' DOORS.

66" AFF (NO CONDUIT).

ADD: 2ND A/W.

ADD: SINGLE DOOR CLOSET

DELETE DOORS TO LIBRARY

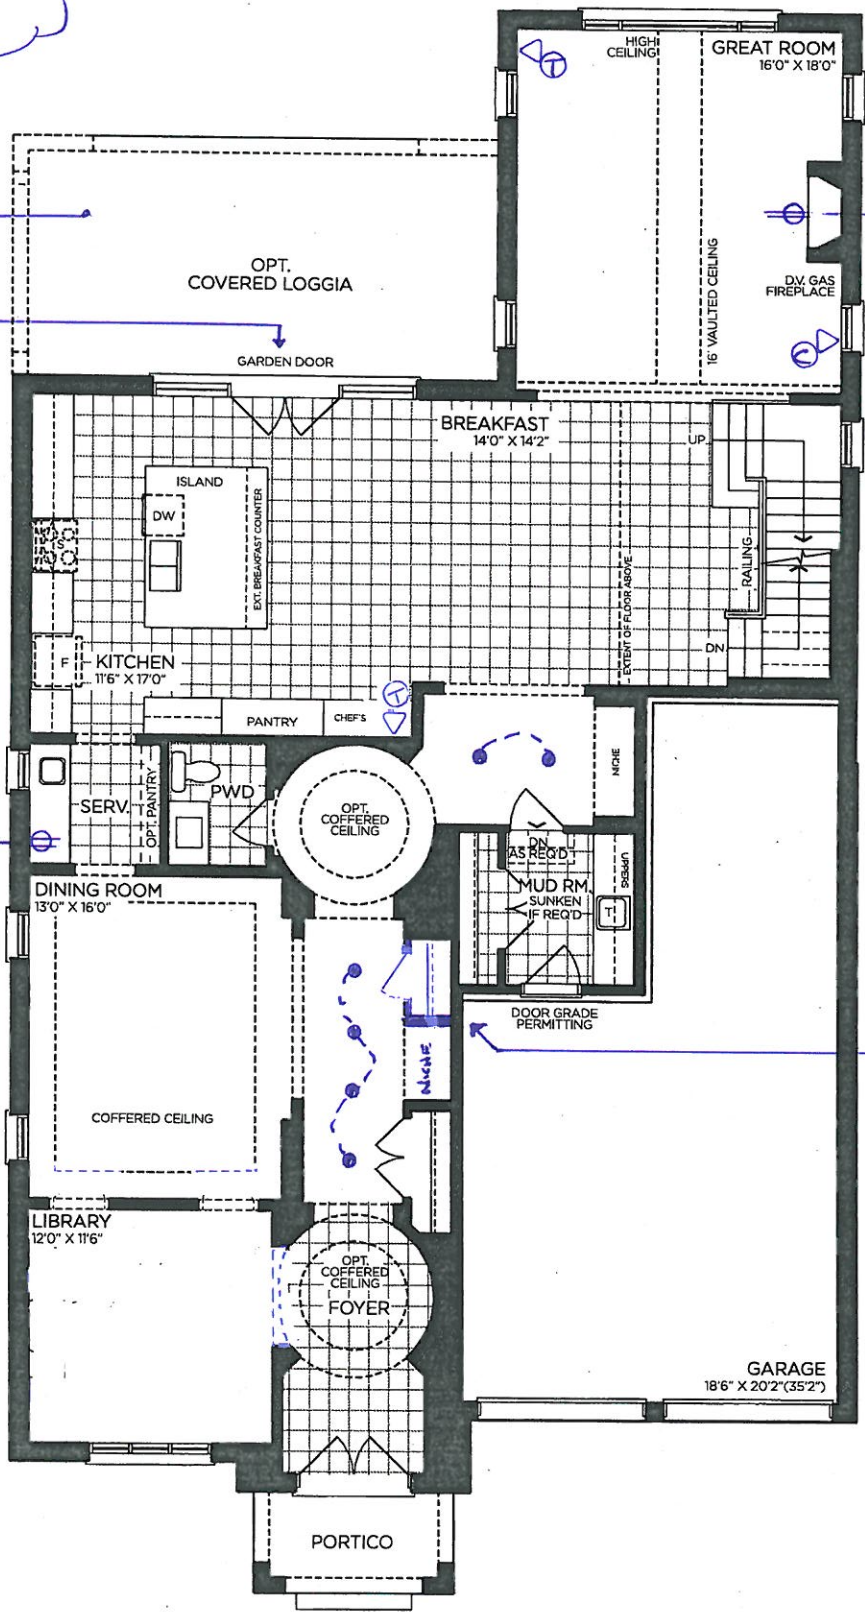

GROUND FLOOR | ELEV. A

VENDOR

PURCHASER

PURCHASER

GOLDPARK  
WORTH MORE™

Prices, figures, illustrations, sizes, features and finishes are subject to change without notice. Areas and dimensions are approximate and actual usable floor space may vary from the stated area. Layout may be reverse of the unit purchased. E. & O.E. 5004



# SCHEDULE 'F'



PV-103  
MAY 26 2020


See email

## The Beaumont 50' SERIES

Elevation A • 4,170 sq.ft.  
4,315 sq.ft. Opt. Elevator

Elevation B • 4,165 sq.ft.  
4,315 sq.ft. Opt. Elevator

→ Elevation C • 4,250 sq.ft.  
4,400 sq.ft. Opt. Elevator

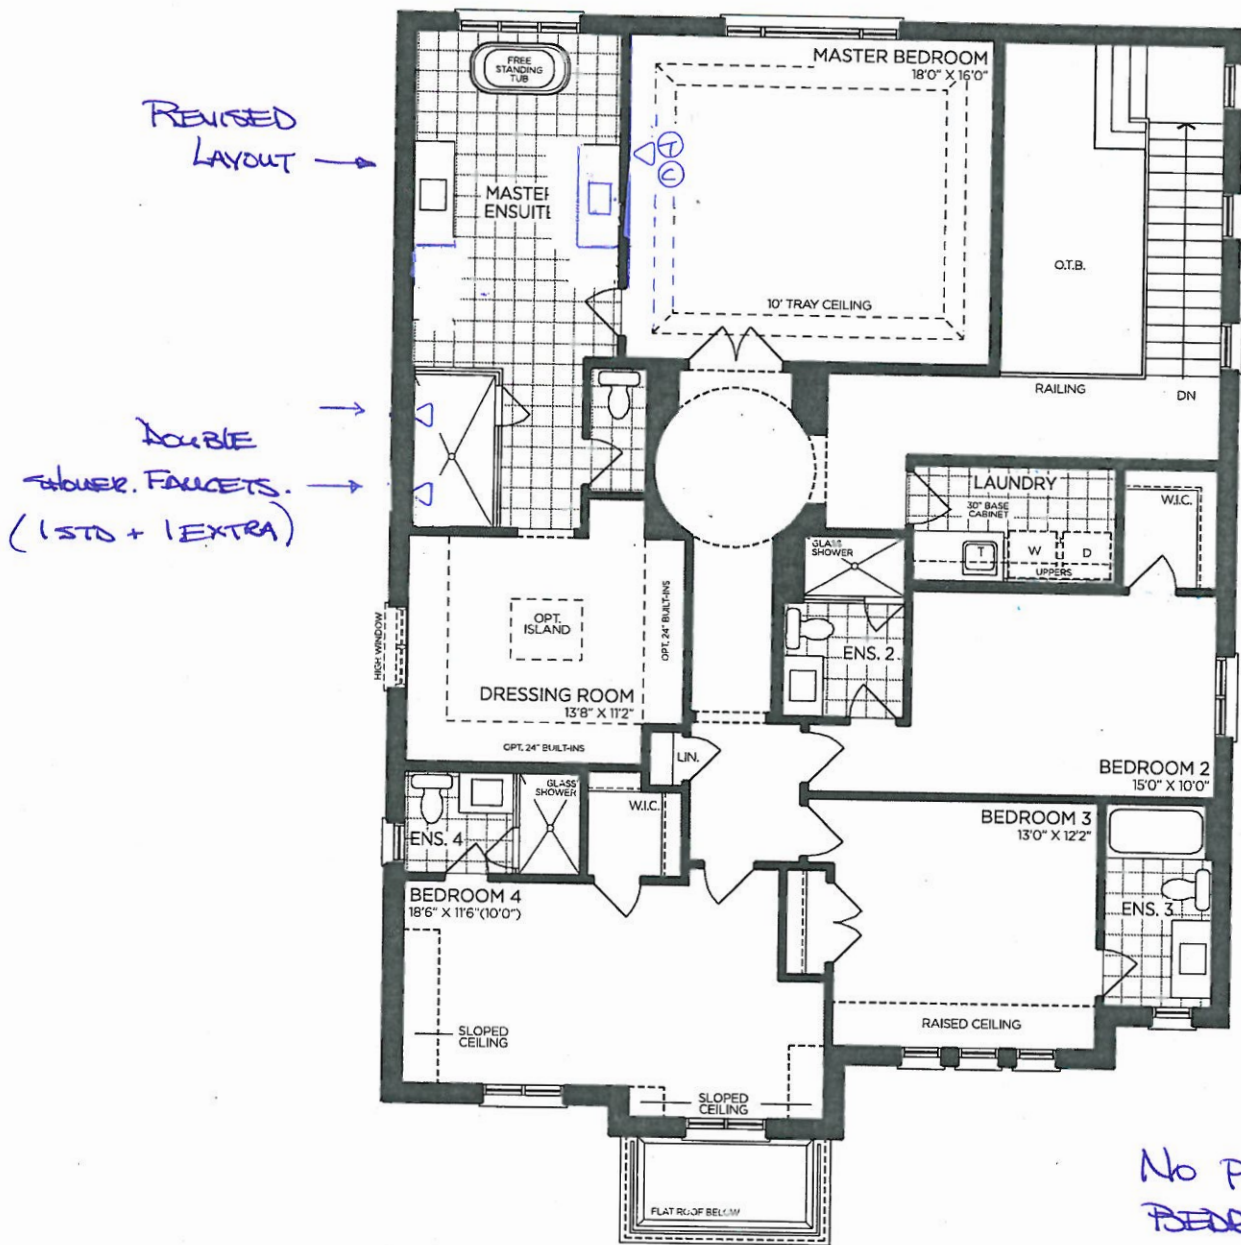

SECOND FLOOR | ELEV. A

VENDOR	
PURCHASER	
PURCHASER	

**GOLDPARK**  
WORTH MORE™

Prices, figures, illustrations, sizes, features and finishes are subject to change without notice. Areas and dimensions are approximate and actual usable floor space may vary from the stated area. Layout may be reverse of the unit purchased. E. & O.E. 5004