

GOLDPARK

WORTH MORE™

CONSTRUCTION SUMMARY

Lot: 109

Model: 50.04 A BEAUMONT

Project/Phase: Pine Valley Forevergreen / 1

CONCRETE AND DRAIN		
Invoice	Qty.	Description
2241	1	BACK-FLOW PREVENTER VALVE
NoCat		
2290	1	BASEMENT:*IN ADDITION TO STANDARD* ADD A 2ND ROUGH-IN FOR 3PC IN BASEMENT, WASTE ROUGH-IN ONLY, NO WATER LINES.
NoCat		

CROWN MOULDING		
Invoice	Qty.	Description
2290	1	.FOYER - OPT. CIRCULAR COFFERED CEILING AS PER PLAN
NoCat		
2290	1	.HALLWAY MAIN FLOOR - OPT. CIRCULAR COFFERED CEILING DETAIL AS PER PLAN
NoCat		

DRYWALL		
Invoice	Qty.	Description
2241	2	.BASEMENT WINDOWS - UPGRADE BASEMENT WINDOW SIZE TO 30 " X 24" - 10" FRAME (PINEVALLEY 50 FOOT LOTS ONLY)
NoCat		
2290	1	.FOYER - OPT. CIRCULAR COFFERED CEILING AS PER PLAN
NoCat		
2290	1	.HALLWAY MAIN FLOOR - OPT. CIRCULAR COFFERED CEILING DETAIL AS PER PLAN
NoCat		

Page 1 of 5

Printed and Sent: 14-Jun-20

GOLDPARK

WORTH MORE™

CONSTRUCTION SUMMARY

Lot: 109

Model: 50.04 A BEAUMONT

Project/Phase: Pine Valley Forevergreen / 1

INTERIOR TRIM AND DOORS

Invoice	Qty.	Description
2241 NoCat	2	.BASEMENT WINDOWS - UPGRADE BASEMENT WINDOW SIZE TO 30 " X 24" - 10" FRAME (PINEVALLEY 50 FOOT LOTS ONLY)
2290 NoCat	1	.FOYER - OPT. CIRCULAR COFFERED CEILING AS PER PLAN
2290 NoCat	1	.HALLWAY MAIN FLOOR - OPT. CIRCULAR COFFERED CEILING DETAIL AS PER PLAN

MISC.

Invoice	Qty.	Description
2241 NoCat	1	BONUS PACKAGE: \$30,000.00 (INCLUDING TAXES) WORTH OF UPGRADES FROM GOLD PARK HOMES DÉCOR CENTRE IS BEING APPLIED TOWARD THIS ORDER. PURCHASER HAS A REMAINING AMOUNT OF \$28,672.25 (INCLUDING TAXES).

NETWORK AND WIRING

Invoice	Qty.	Description
2290 72,258	1	KITCHEN (LOCATE ABOVE COUNTER AT CHEF'S DESK) / GREAT ROOM (LOCATE APPROX. 66" A.F.F. ABOVE FIREPLACE) / BEDROOM 2 / BEDROOM 3 / BEDROOM 4: ADDITIONAL CAT6 ETHERNET OUTLET - EACH SEE PLAN FOR LOCATION ***PACKAGE PRICE***
2290 NoCat	1	GREAT ROOM *NOTE* LOCATE STANDARD CABLE APPROX. 66" A.F.F. ABOVE FIREPLACE
2290 72,260	1	CONDUIT PIPE - FROM ATTIC TO BASEMENT - FROM ELECTRICAL PANEL IN BASEMENT TO APPROX. CENTER OF ATTIC

PAINT

Invoice	Qty.	Description
2290 NoCat	1	.FOYER - OPT. CIRCULAR COFFERED CEILING AS PER PLAN
2290 NoCat	1	.HALLWAY MAIN FLOOR - OPT. CIRCULAR COFFERED CEILING DETAIL AS PER PLAN

PLUMBING

Invoice	Qty.	Description
2290 72,342	1	BASEMENT:*IN ADDITION TO STANDARD* ADD A 2ND ROUGH-IN FOR 3PC IN BASEMENT, WASTE ROUGH-IN ONLY, NO WATER LINES. SEE PLAN FOR LOCATION

Page 4 of 5

Printed and Sent: 14-Jun-20



CONSTRUCTION SUMMARY

Lot: 109

Model: 50.04 A BEAUMONT

Project/Phase: Pine Valley Forevergreen / 1

WINDOWS - BASEMENT

Invoice	Qty.	Description
2241	2	.BASEMENT WINDOWS - UPGRADE BASEMENT WINDOW SIZE TO 30 " X 24" - 10" FRAME (PINEVALLEY 50 FOOT LOTS ONLY)
NoCat		


SCHEDULE 'F'



PV-109 ~~109~~
April 23 2020

The Beaumont 50' SERIES

Elevation A • 4,170 sq.ft.
4,315 sq.ft. Opt. Elevator
Elevation B • 4,165 sq.ft.
4,315 sq.ft. Opt. Elevator
Elevation C • 4,250 sq.ft.
4,400 sq.ft. Opt. Elevator

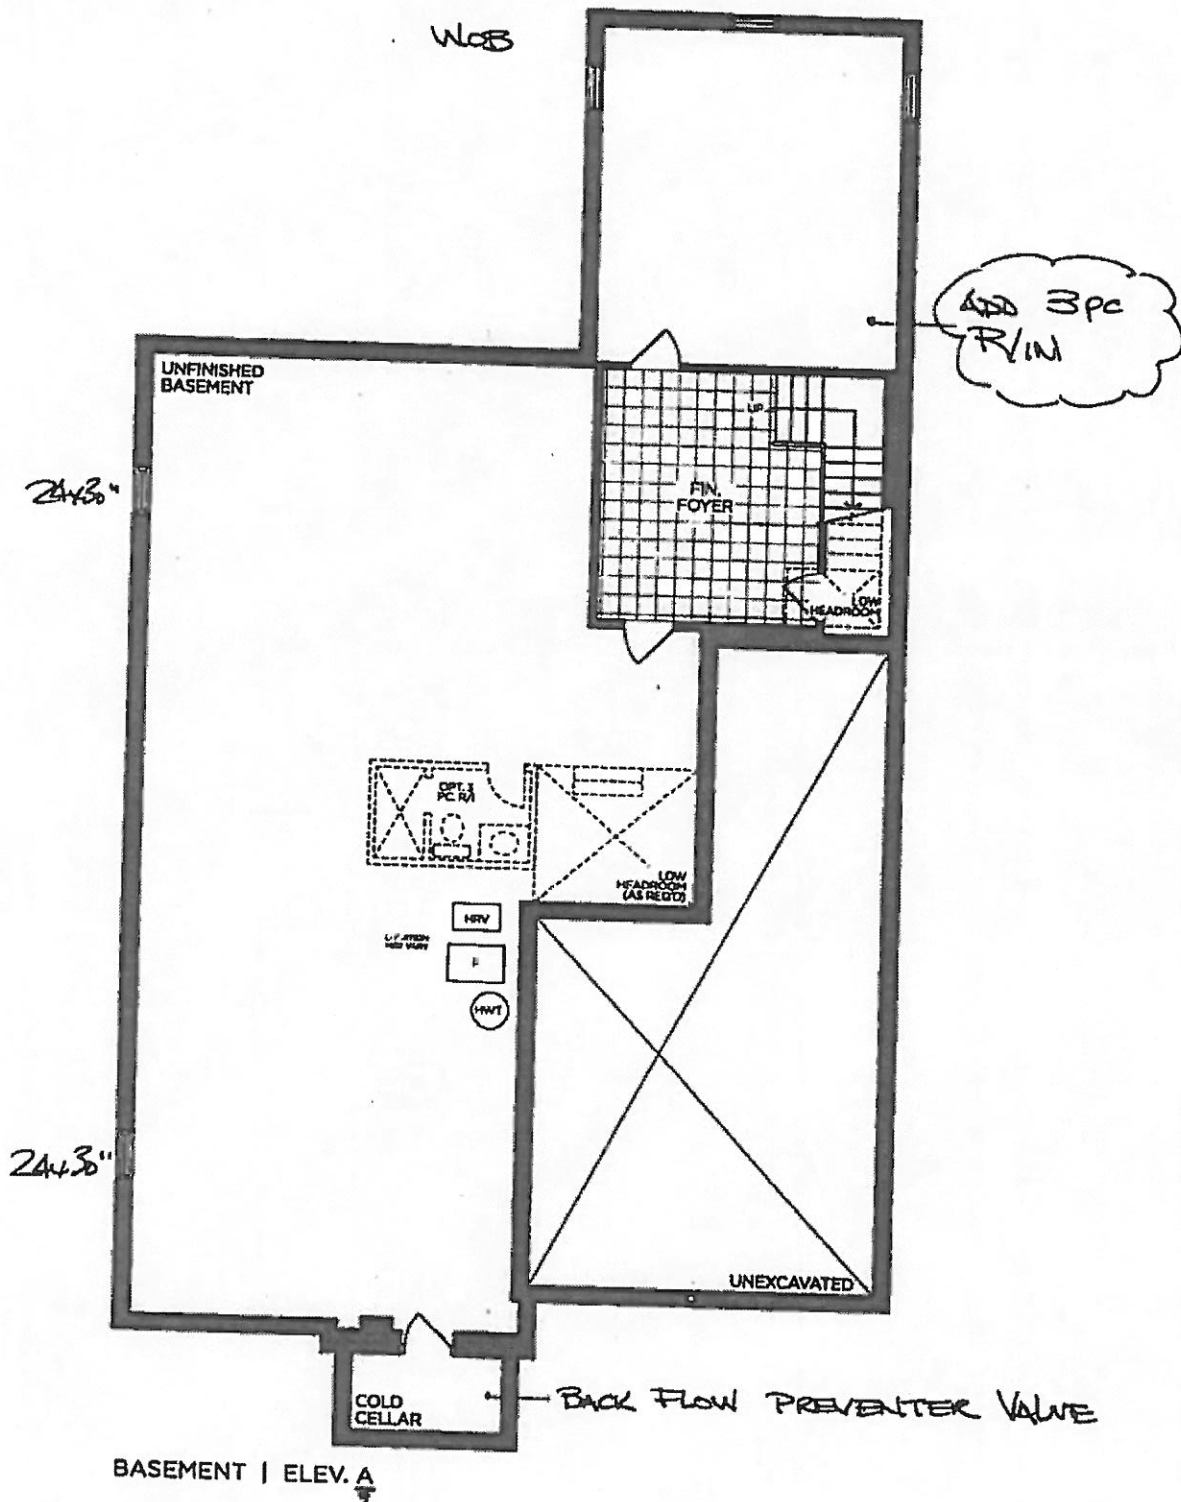

BASEMENT | ELEV. A

VENDOR

PURCHASER

PURCHASER

<i>[Signature]</i>
<i>[Signature]</i>

GOLDPARK
WORTH MORE™

Prices, figures, illustrations, sizes, features and finishes are subject to change without notice. Areas and dimensions are approximate and actual usable floor space may vary from the stated area. Layout may be reverse of the unit purchased. E. & O.E. 5004

SCHEDULE 'F'




PV-109

APRIL 23 2020

The Beaumont

50' SERIES

- Elevation A • 4,170 sq.ft.
4,315 sq.ft. Opt. Elevator
- Elevation B • 4,165 sq.ft.
4,315 sq.ft. Opt. Elevator
- Elevation C • 4,250 sq.ft.
4,400 sq.ft. Opt. Elevator

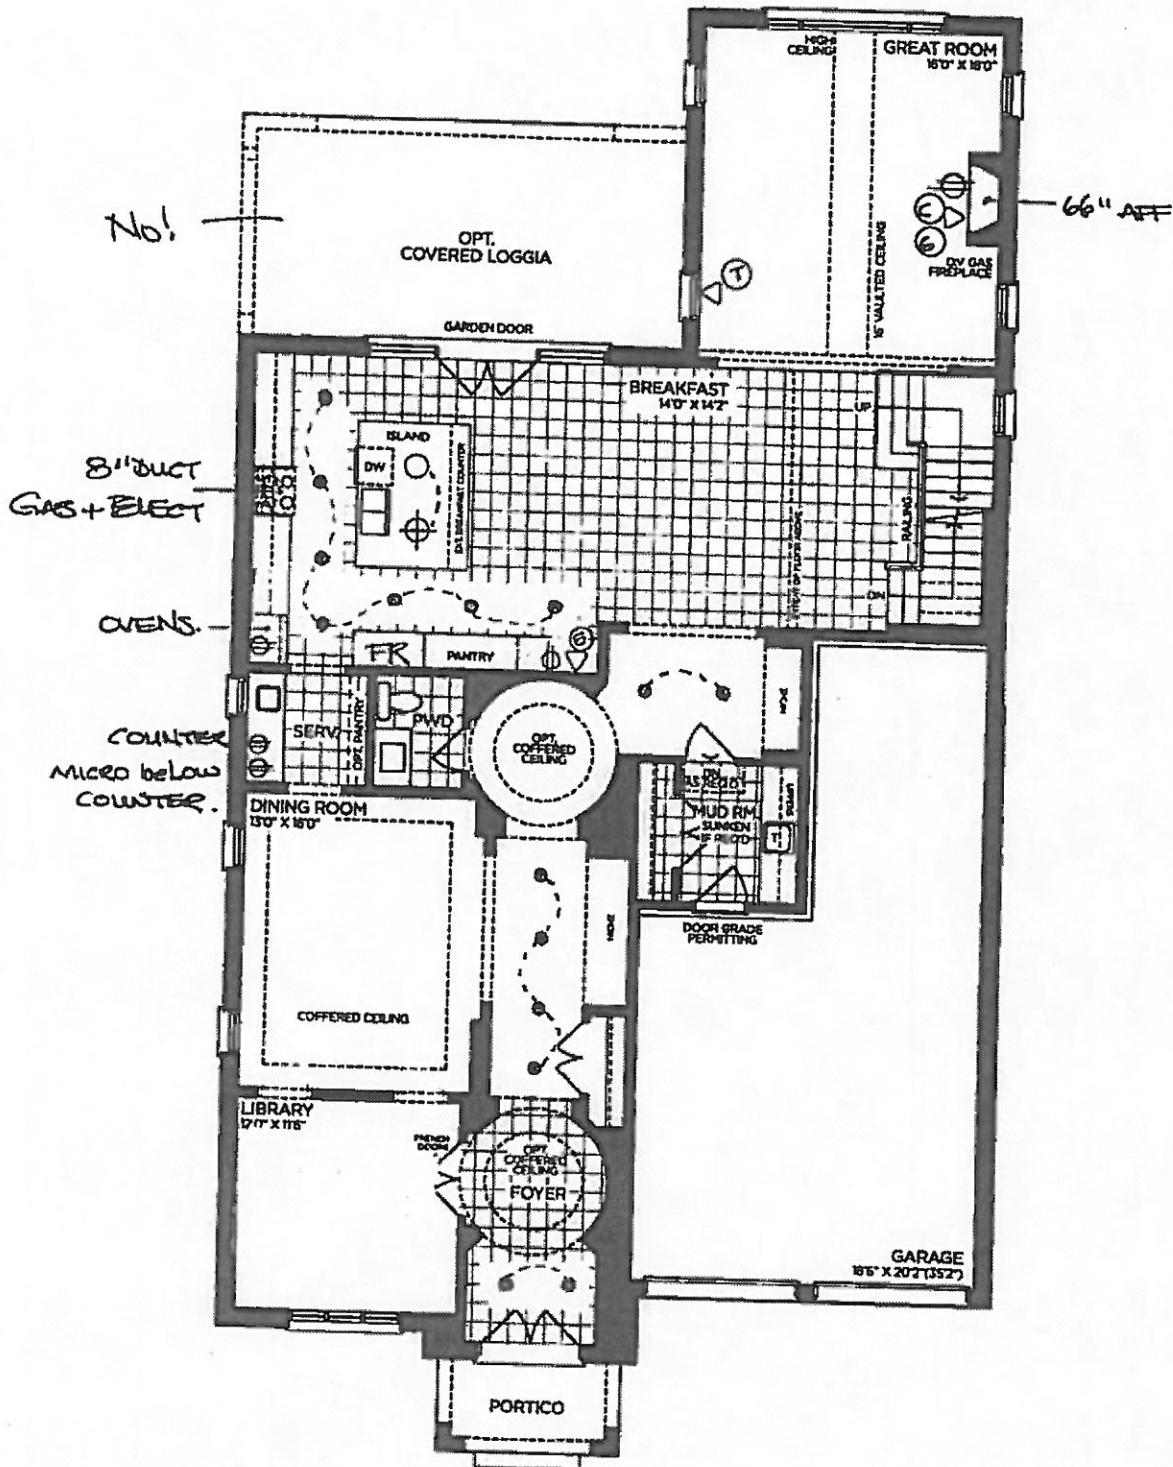

GROUND FLOOR | ELEV. A

VENDOR

PURCHASER

PURCHASER

GOLDPARK
WORTH MORE™

Prices, figures, illustrations, sizes, features and finishes are subject to change without notice. Areas and dimensions are approximate and actual usable floor space may vary from the stated area. Layout may be reverse of the unit purchased. E. & O.E. 5004

SCHEDULE 'F'




PV-109 *[Signature]*
 April 23 2020 *[Signature]*

The Beaumont

50' SERIES

→ Elevation A • 4,170 sq.ft.
 4,315 sq.ft. Opt. Elevator
 Elevation B • 4,165 sq.ft.
 4,315 sq.ft. Opt. Elevator
 Elevation C • 4,250 sq.ft.
 4,400 sq.ft. Opt. Elevator

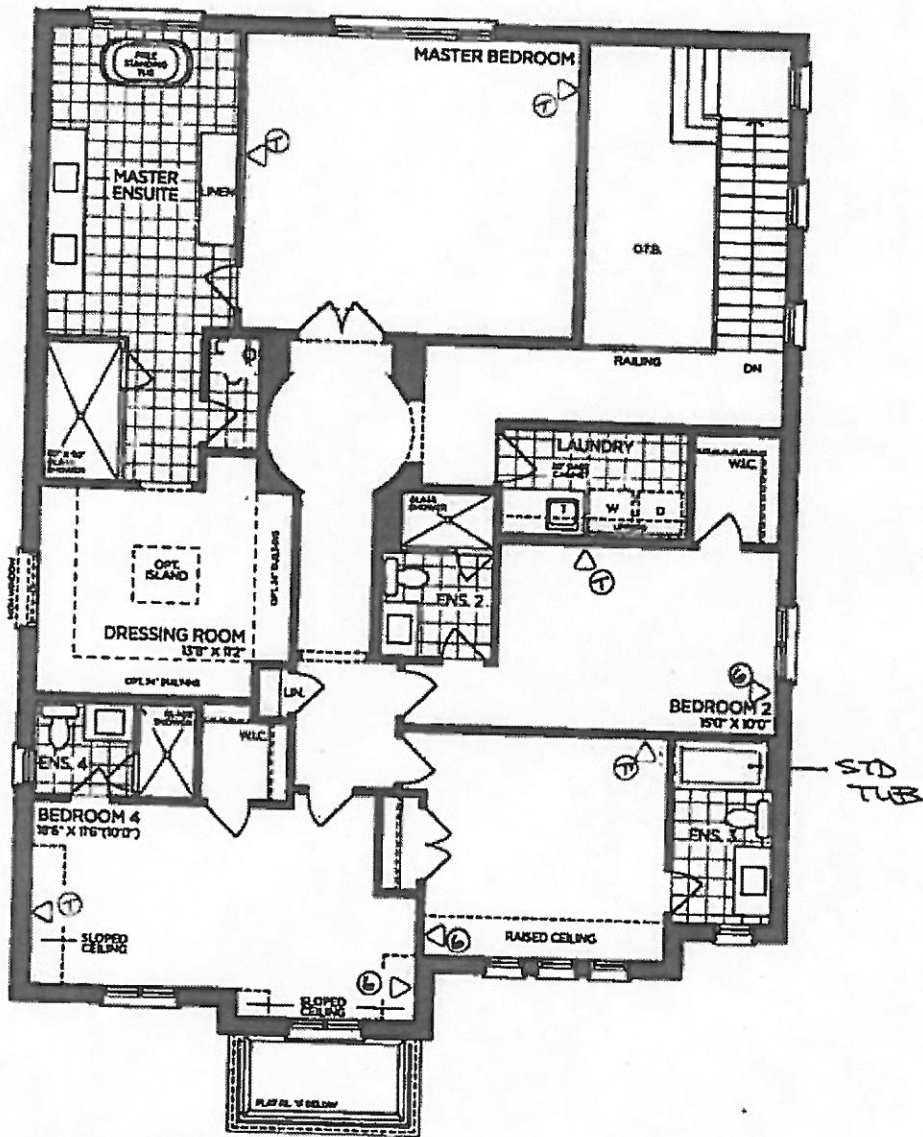

SECOND FLOOR | ELEV. A

VENDOR _____
 PURCHASER *[Signature]* _____
 PURCHASER _____

GOLDPARK
 WORTH MORE™

Prices, figures, illustrations, sizes, features and finishes are subject to change without notice. Areas and dimensions are approximate and actual usable floor space may vary from the stated area. Layout may be reverse of the unit purchased. E. & O.E. 5004