

GOLDPARK

WORTH MORE™

CONSTRUCTION SUMMARY

Lot: 111

Model: 40.07 A SUNCREST

Project/Phase: Pine Valley Forevergreen / 1

CONCRETE AND DRAIN		
Invoice	Qty.	Description
2209	1	.BACK-FLOW PREVENTER VALVE
NoCat		

CROWN MOULDING		
Invoice	Qty.	Description
2296	1	.GREAT ROOM - OPT. COFFERED CEILING AS PER PLAN
NoCat		

DRYWALL		
Invoice	Qty.	Description
2296	1	.GREAT ROOM - OPT. COFFERED CEILING AS PER PLAN
NoCat		
2296	1	.GREAT ROOM - OPT. WAFFLE CEILING, BEAM DETAIL AS PER PLAN (9 BOXES) OPTION # 1 CTR-B07
NoCat		

GOLDPARK

WORTH MORE™

CONSTRUCTION SUMMARY

Lot: 111

Model: 40.07 A SUNCREST

Project/Phase: Pine Valley Forevergreen / 1

ELECTRICAL		
Invoice	Qty.	Description
2296 72,289	4	.BREAKFAST: 4" E/S LED INTERIOR POT LIGHT - GROUND FLOOR - EACH
2296 72,278	1	.BREAKFAST: ADDITIONAL INTERIOR SWITCH FOR POTLIGHTS
2296 72,303	1	.KITCHEN: FIXTURE: UNDER CABINET FLUORESCENT LIGHT FIXTURES - DOES NOT INCLUDE (AND REQUIRES) LIGHT VALANCE

EXTERIOR COLOURS		
Invoice	Qty.	Description
2296 NoCat	1	EXTERIOR COLOUR PACKAGE # BR.1

FRAMING		
Invoice	Qty.	Description
2296 72,445	1	.GREAT ROOM - OPT. COFFERED CEILING AS PER PLAN
2296 72,444	1	.GREAT ROOM - OPT. WAFFLE CEILING, BEAM DETAIL AS PER PLAN (9 BOXES) OPTION # 1 CTR-B07

INTERIOR TRIM AND DOORS		
Invoice	Qty.	Description
2296 NoCat	1	.GREAT ROOM - OPT. COFFERED CEILING AS PER PLAN
2296 NoCat	1	.GREAT ROOM - OPT. WAFFLE CEILING, BEAM DETAIL AS PER PLAN (9 BOXES) OPTION # 1 CTR-B07

Page 3 of 4

Printed and Sent: 14-Jun-20

GOLDPARK

WORTH MORE™

CONSTRUCTION SUMMARY

Lot: 111

Model: 40.07 A SUNCREST

Project/Phase: Pine Valley Forevergreen / 1

NETWORK AND WIRING

Invoice	Qty.	Description
2296 72,259	1	.GREAT ROOM: CONDUIT PIPE - FOR WALL MOUNT TV - LOCATE APPROX. 66" A.F.F. ABOVE FIREPLACE, TERMINATING AT CABLE -SEE PLAN
2296 72,258	1	.GREAT ROOM: ADDITIONAL CAT6 ETHERNET OUTLET - EACH SEE PLAN FOR LOCATION
2296 72,261	1	KITCHEN: INSTALL VAC PAN UNDER KITCHEN SINK.
2296 72,260	1	.CONDUIT PIPE - FROM ATTIC TO BASEMENT - AT ELECTRICAL PANEL TO APPROX CENTER OF ATTIC

PAINT

Invoice	Qty.	Description
2296 NoCat	1	.GREAT ROOM - OPT. COFFERED CEILING AS PER PLAN
2296 NoCat	1	.GREAT ROOM - OPT. WAFFLE CEILING, BEAM DETAIL AS PER PLAN (9 BOXES) OPTION # 1 CTR-B07

PLUMBING

Invoice	Qty.	Description
2209 NoCat	1	.BACK-FLOW PREVENTER VALVE
2296 NoCat	1	.GARAGE: UPGRADE TO HOT/COLD HOSE BIB (FROM STANDARD COLD ONLY)

Page 4 of 4

Printed and Sent: 14-Jun-20


SCHEDULE 'F'



See attached
See attached
PV-111
April 24 2020

The Suncrest
40' SERIES

Elevation A • 2,520 sq.ft.
Elevation B • 2,535 sq.ft.

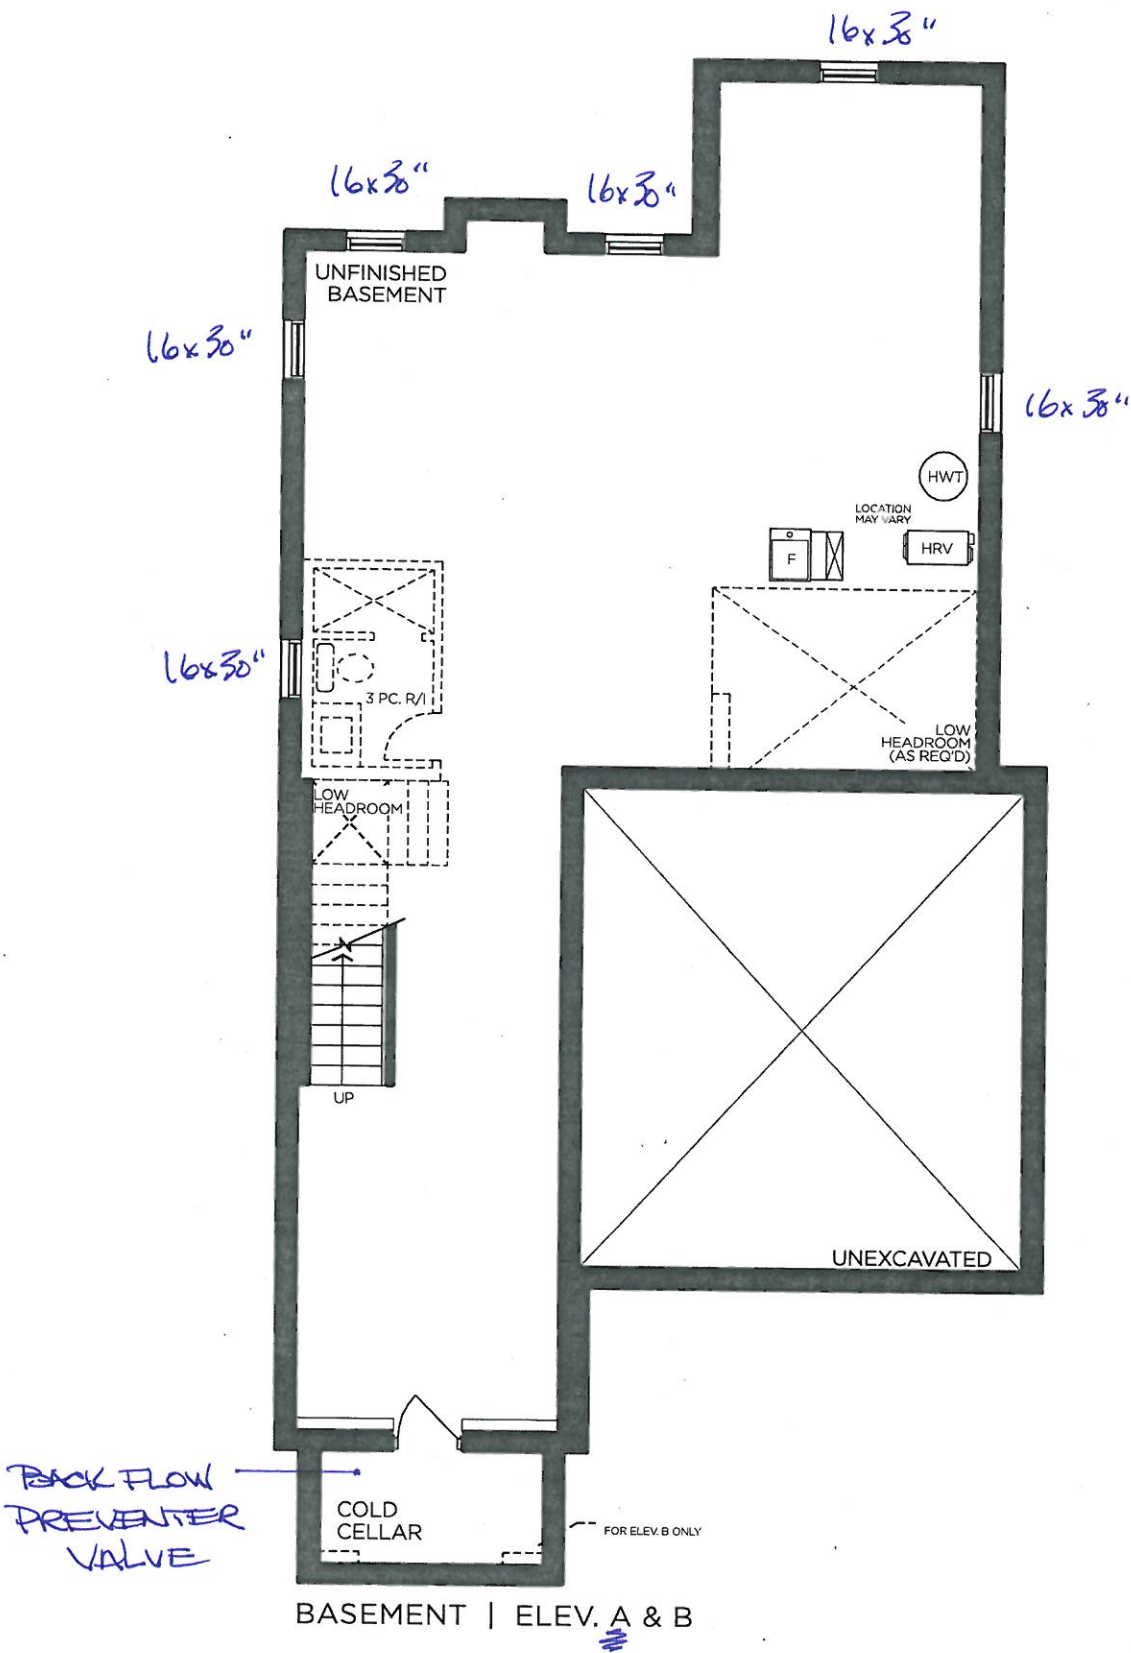

VENDOR

PURCHASER

PURCHASER

GOLDPARK
WORTH MORE™

Prices, figures, illustrations, sizes, features and finishes are subject to change without notice. Areas and dimensions are approximate and actual usable floor space may vary from the stated area. Layout may be reverse of the unit purchased. E. & O.E. 4007


SCHEDULE 'F'



PV-111
APRIL 24 2026
see attached
see attached

The
Suncrest
40' SERIES

→ Elevation A • 2,520 sq.ft.
Elevation B • 2,535 sq.ft.

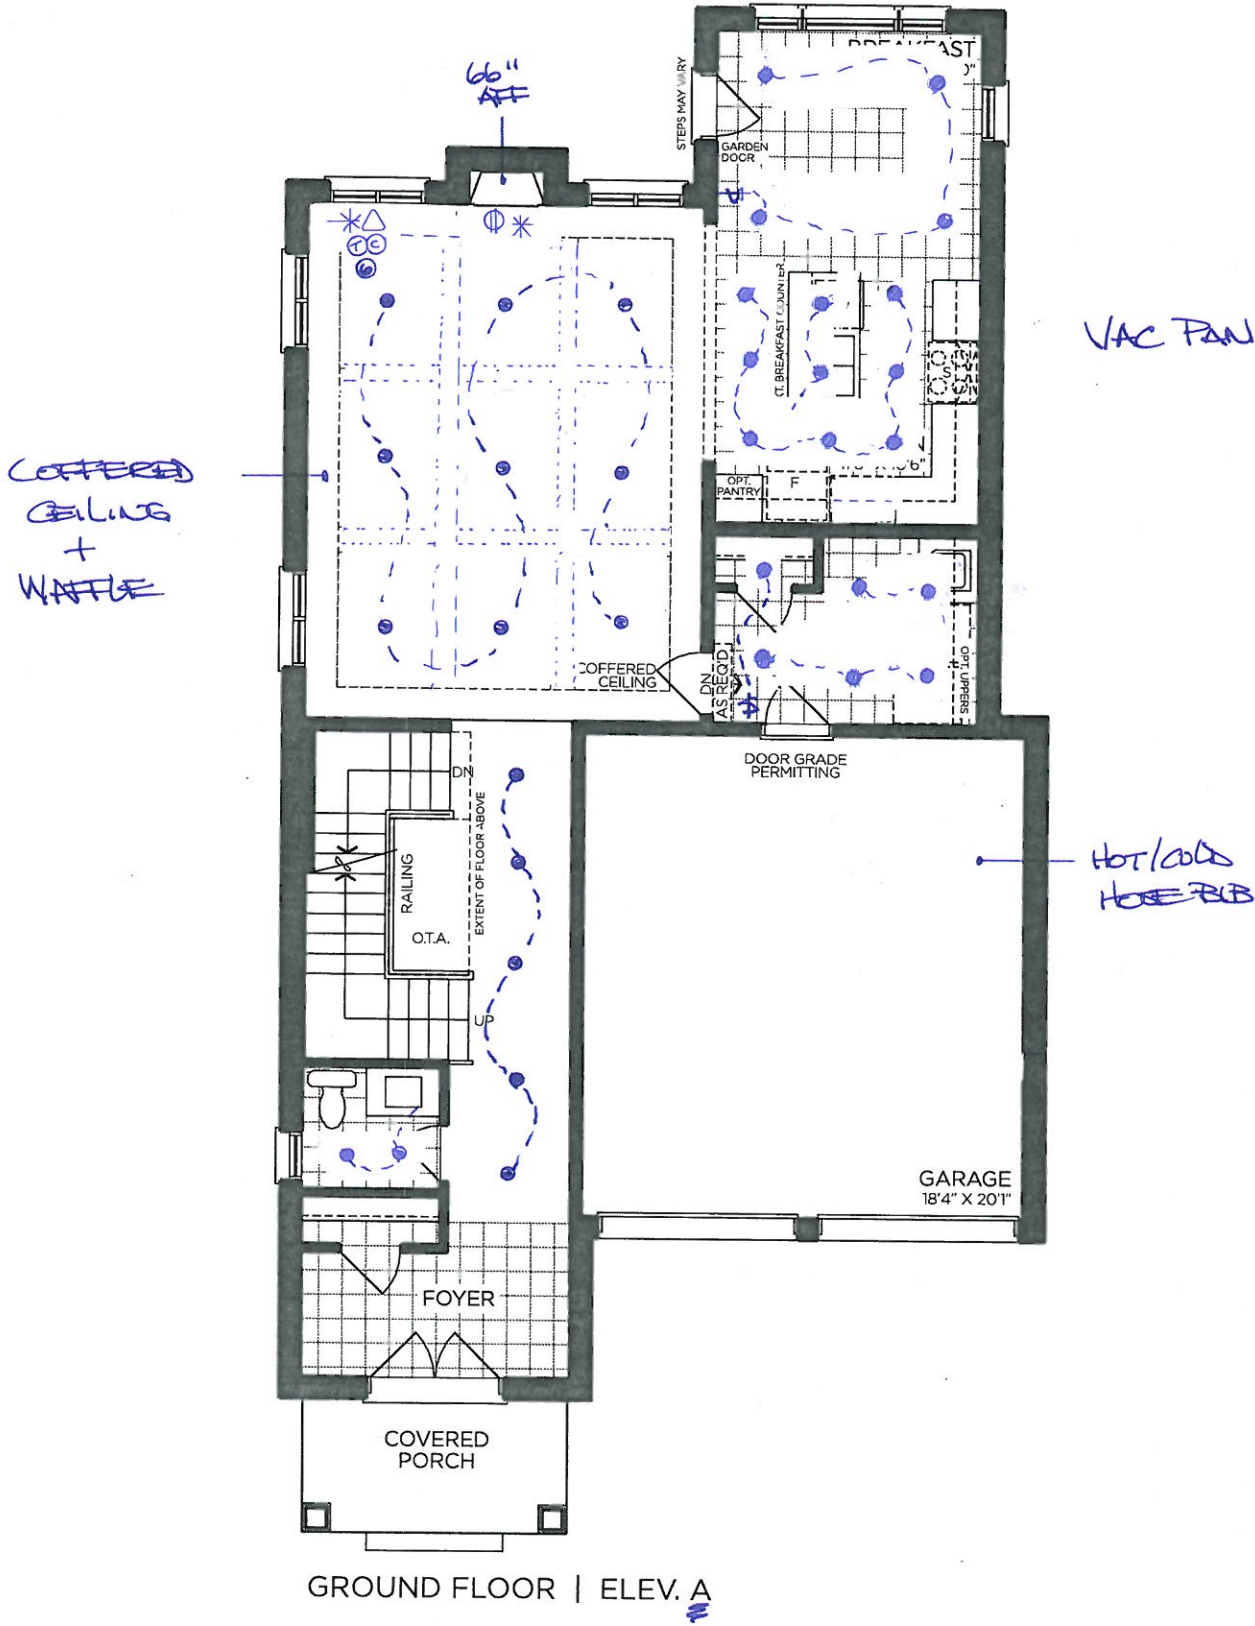

VENDOR

PURCHASER

PURCHASER

GOLDPARK
WORTH MORE™

Prices, figures, illustrations, sizes, features and finishes are subject to change without notice. Areas and dimensions are approximate and actual usable floor space may vary from the stated area. Layout may be reverse of the unit purchased. E. & O.E. 4007


SCHEDULE 'F'



PV- 111 ~~see attached~~ ~~see attached~~
APRIL 24 2020

The Suncrest
40' SERIES

Elevation A • 2,520 sq.ft.
Elevation B • 2,535 sq.ft.

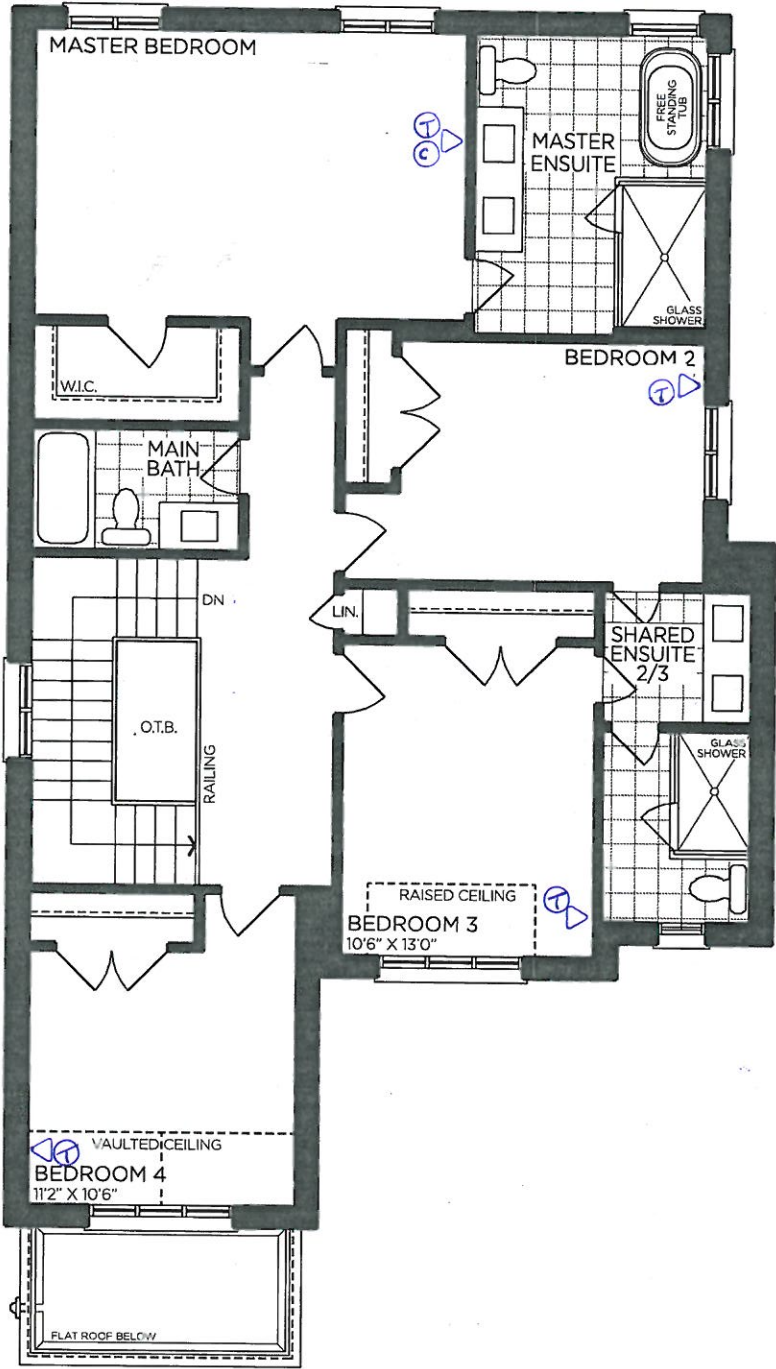

SECOND FLOOR | ELEV. A

GOLDPARK
WORTH MORE™

VENDOR

PURCHASER

PURCHASER

Prices, figures, illustrations, sizes, features and finishes are subject to change without notice. Areas and dimensions are approximate and actual usable floor space may vary from the stated area. Layout may be reverse of the unit purchased. E. & O.E. 4007




SCHEDULE 'F'

PV-111
April 24 2020

The Suncrest 40' SERIES

→ Elevation A • 2,520 sq.ft.
Elevation B • 2,535 sq.ft.

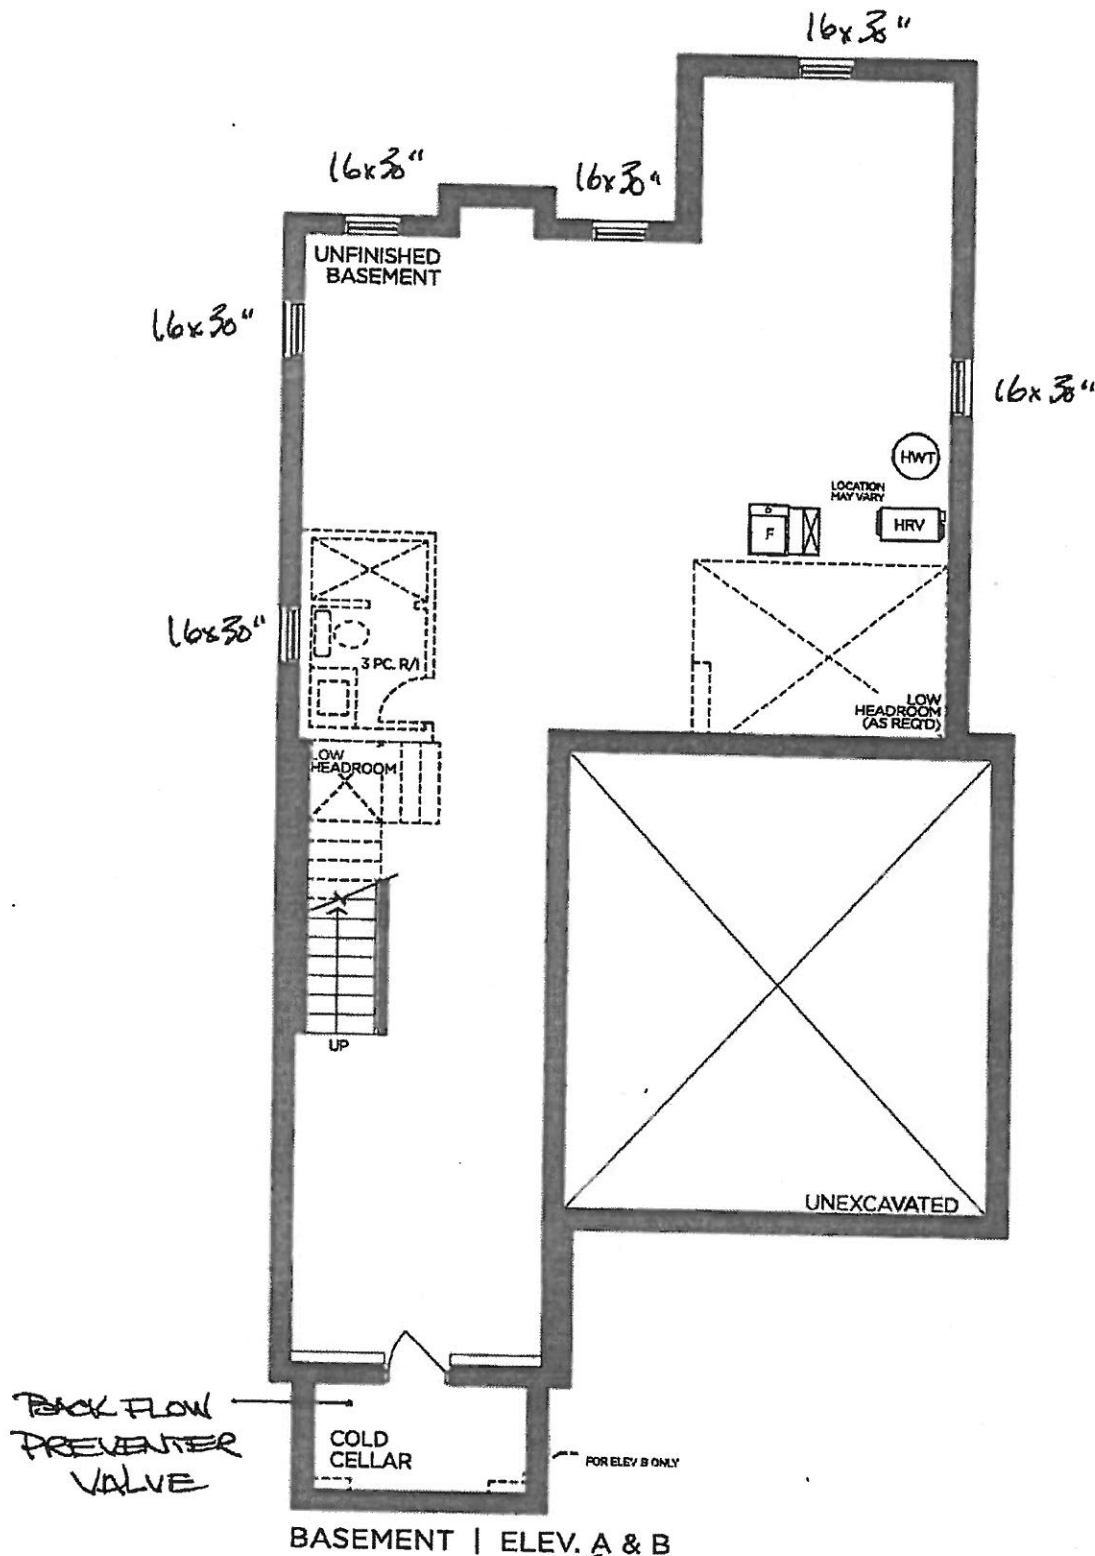

BASEMENT | ELEV. A & B

VENDOR

PURCHASER

PURCHASER

[Handwritten signature]

GOLDPARK
WORTH MORE™

Prices, figures, illustrations, sizes, features and finishes are subject to change without notice. Areas and dimensions are approximate and actual usable floor space may vary from the stated area. Layout may be reverse of the unit purchased. E. & O.E. 4007

SCHEDULE 'F'




FV-III
APRIL 24 2026




The
Suncrest
40' SERIES

→ Elevation A • 2,520 sq.ft.
Elevation B • 2,535 sq.ft.

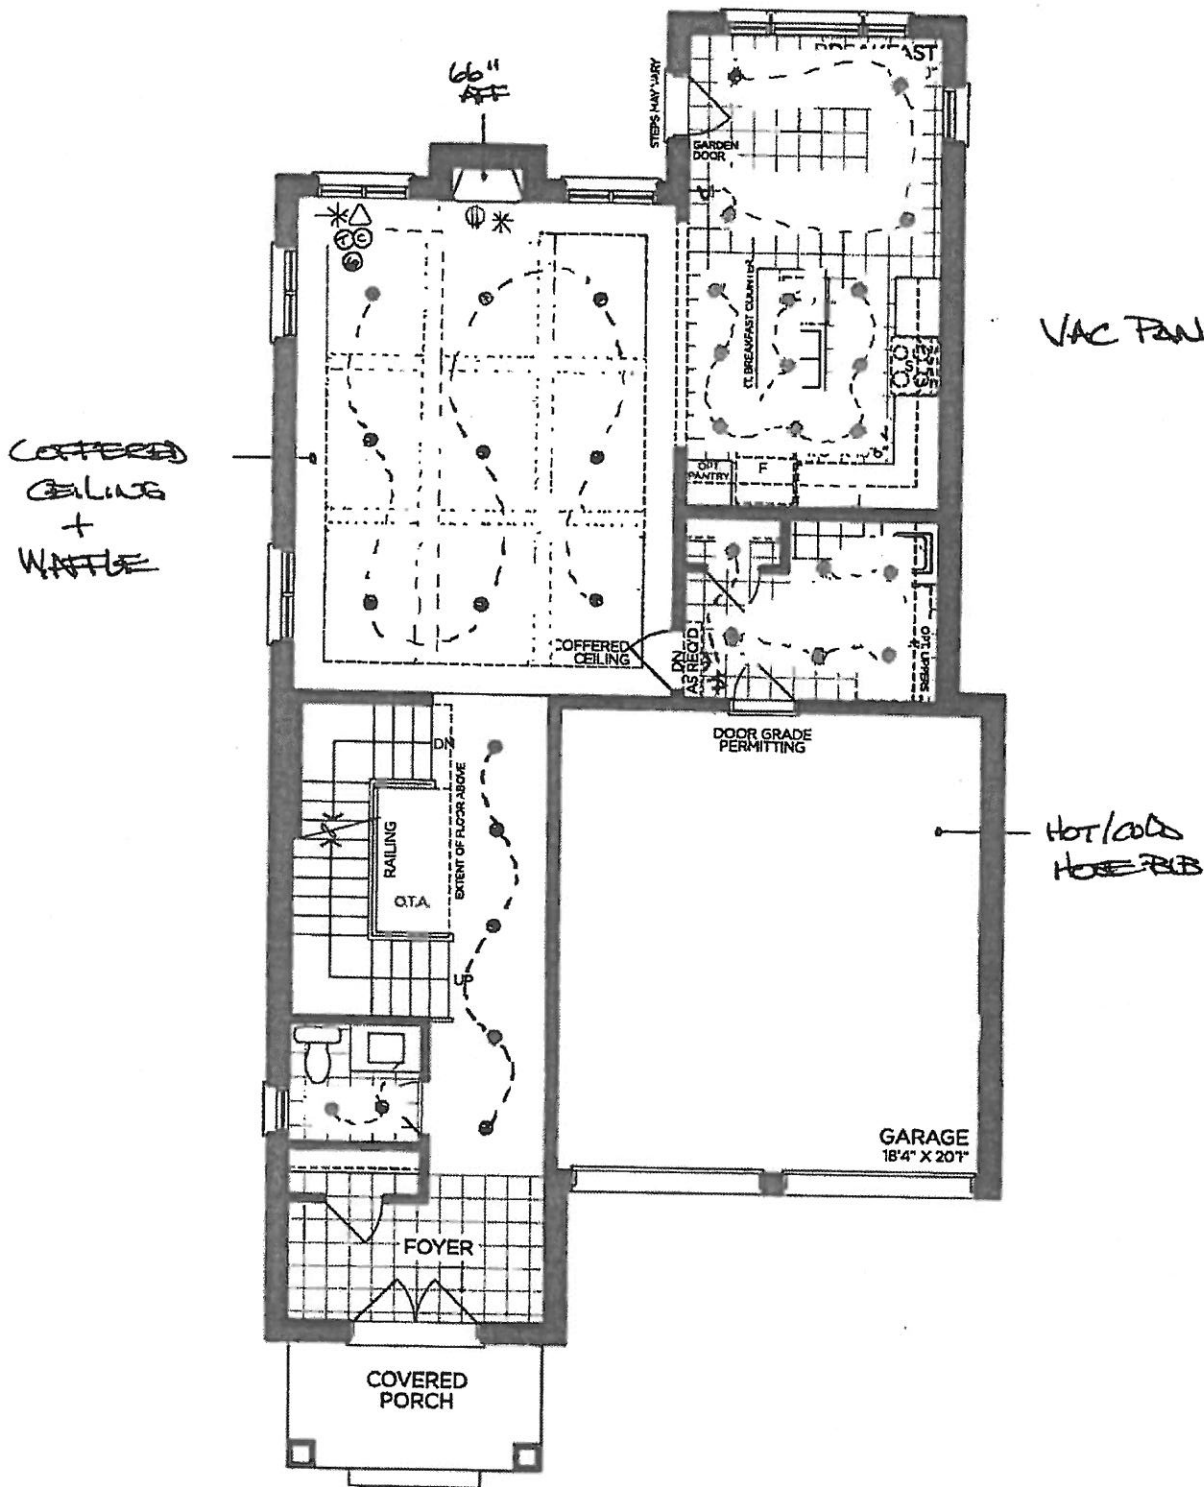

GROUND FLOOR | ELEV. A

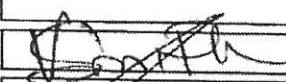

VENDOR _____
PURCHASER 
PURCHASER _____

GOLDPARK
WORTH MORE™

Prices, figures, illustrations, sizes, features and finishes are subject to change without notice. Areas and dimensions are approximate and actual usable floor space may vary from the stated area. Layout may be reverse of the unit purchased. E. & O.E. 4007


SCHEDULE 'F'






PV- III  
APRIL 24 2020

The
Suncrest
40' SERIES

→ Elevation A • 2,520 sq.ft.
Elevation B • 2,535 sq.ft.

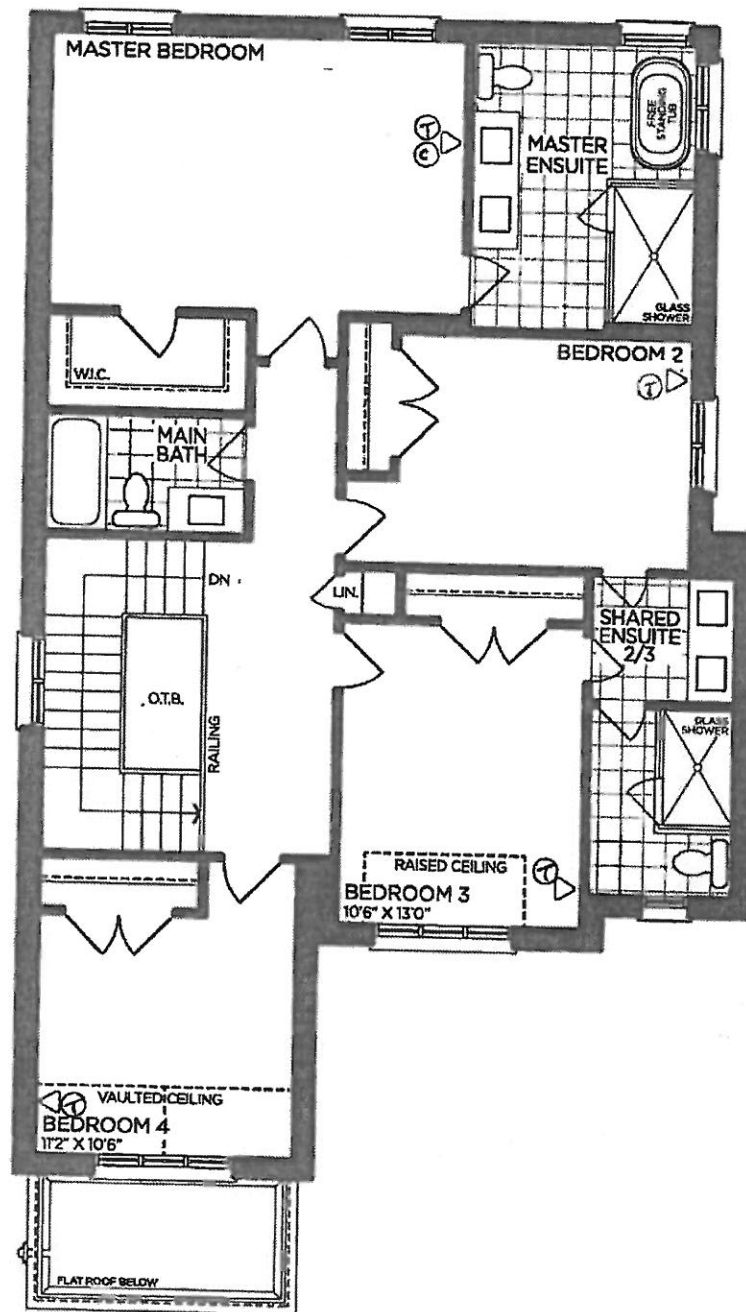

SECOND FLOOR | ELEV. A

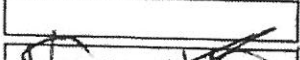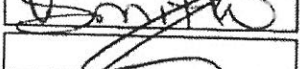VENDOR 
PURCHASER 
PURCHASER 

GOLDPARK
WORTH MORE™

Prices, figures, illustrations, sizes, features and finishes are subject to change without notice. Areas and dimensions are approximate and actual usable floor space may vary from the stated area. Layout may be reverse of the unit purchased. E. & O.E. 4007