

GOLDPARK

WORTH MORE™

CONSTRUCTION SUMMARY

Lot: 128

Model: 40.08 A HILLSDALE

Project/Phase: Pine Valley Forevergreen / 1

CONCRETE AND DRAIN

Invoice	Qty.	Description
2207	1	BACK-FLOW PREVENTER VALVE
NoCat		

ELECTRICAL

Invoice	Qty.	Description
2285 72,281	1	.GREAT ROOM: INTERIOR WALL OUTLET: ADDITIONAL 110V WALL INTERIOR RECEPTACLE ON EXISTING CIRCUIT FOR WALL MOUNTED TV - LOCATE APPROX. 66" A.F.F. ABOVE FIREPLACE
2285 72,667	1	.KITCHEN: ROUGH-IN FOR CAPPED CEILING OUTLET (FUTURE LIGHT FIXTURE) - EACH - LOCATE ABOVE ISLAND, USE SAME SWITCH AS STANDARD LIGHT. SEE PLAN FOR LOCATION
2285 72,307	1	.KITCHEN: FXITURE: RELOCATE STANDARD CEILING MOUNT FIXTURE - LOCATE ABOVE ISLAND, SEE PLAN FOR LOCATION
2285 72,289	6	.KITCHEN/BREAKFAST: 4" E/S LED INTERIOR POT LIGHT - GROUND FLOOR - EACH INCLUDED IN APS
2285 72,278	1	.KITCHEN: ADDITIONAL INTERIOR SWITCH FOR POTLIGHTS
2285 72,273	1	.KITCHEN: 110V WALL RECEPTACLE ON SEPARATE CIRCUIT - GAS FIRED APPLIANCE - FOR AUX. EQUIPMENT - NOT A STOVE PLUG FOR GAS COOKTOP

HVAC

Invoice	Qty.	Description
2285 72,224	1	.KITCHEN: GAS LINE ROUGH-IN - MAIN FLOOR FOR GAS RANGE- SEE PLAN FOR LOCATION

MISC.

Invoice	Qty.	Description
2207	1	BONUS PACKAGE: \$30,000.00 (INCLUDING TAXES) WORTH OF UPGRADES FROM GOLD PARK HOMES DÉCOR CENTRE IS BEING APPLIED TOWARD THIS ORDER. PURCHASER HAS A REMAINING AMOUNT OF \$29,237.25 (INCLUDING TAXES)
NoCat		

NETWORK AND WIRING

Invoice	Qty.	Description
2285 72,259	1	.GREAT ROOM: CONDUIT PIPE - FOR WALL MOUNT TV - LOCATE APPROX. 66" A.F.F. ABOVE FIREPLACE, TERMINATING AT CABLE - SEE PLAN FOR LOCATION

Page 1 of 2

Printed and Sent: 01-Jun-20



CONSTRUCTION SUMMARY

Lot: 128

Model: 40.08 A HILLSDALE

Project/Phase: Pine Valley Forevergreen / 1

PLUMBING

Invoice	Qty.	Description
2207	1	BACK-FLOW PREVENTER VALVE
NoCat		

SCHEDULE 'F'




PV-128
APRIL 13 2020

see attached see attached

The Hillsdale
40' SERIES

Elevation A • 2,745 sq.ft.
Elevation B • 2,760 sq.ft.

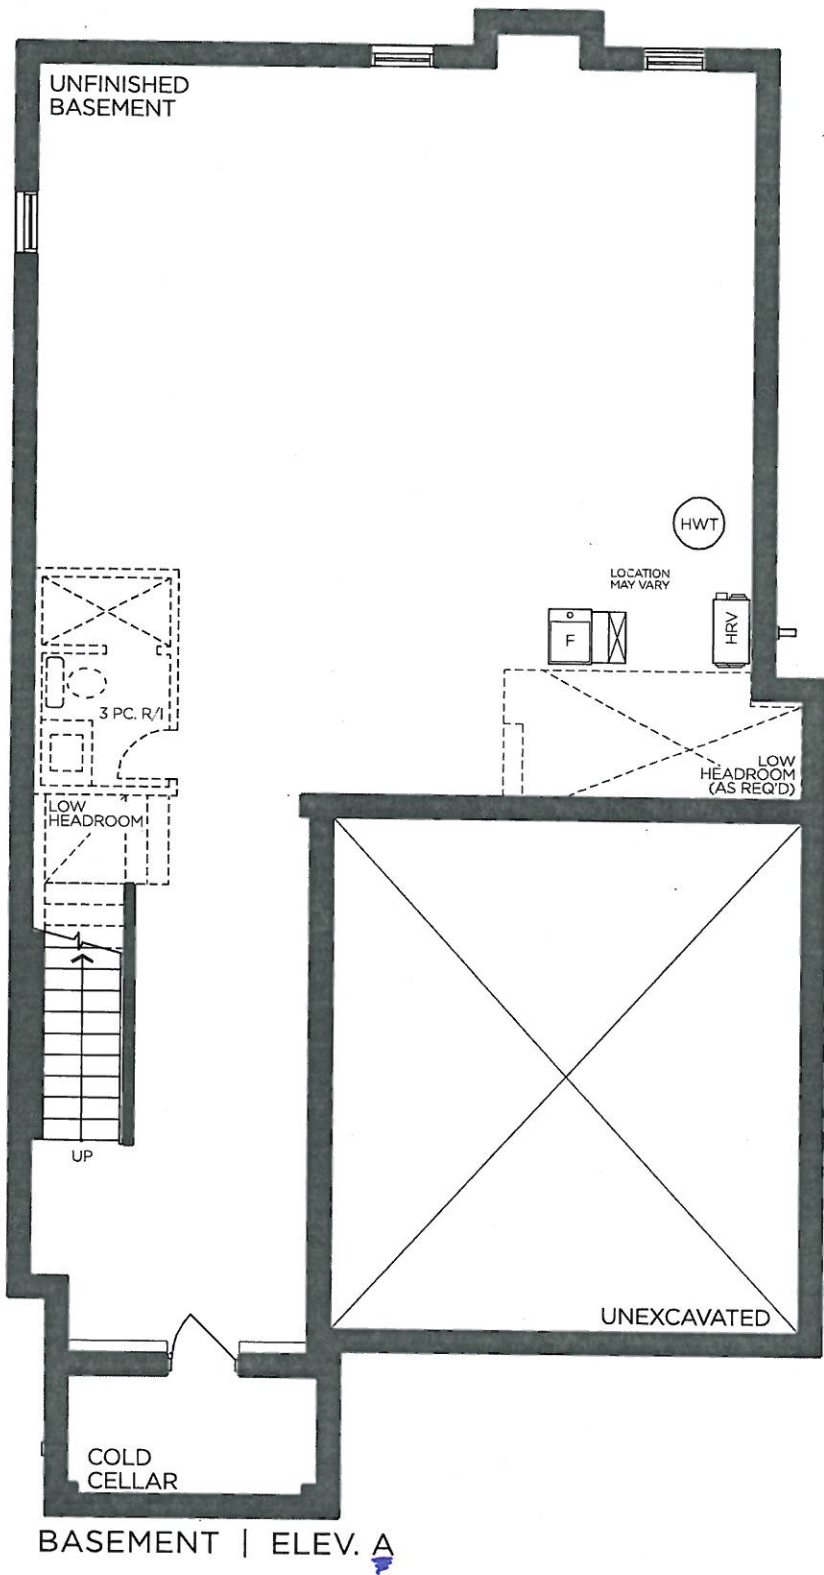

VENDOR

PURCHASER

PURCHASER

GOLDPARK
WORTH MORE™

Prices, figures, illustrations, sizes, features and finishes are subject to change without notice. Areas and dimensions are approximate and actual usable floor space may vary from the stated area. Layout may be reverse of the unit purchased. E. & O.E. 4008



SCHEDULE 'F'

PN-128
APRIL 13 2020

see attached
see attached


The Hillsdale

40' SERIES

→ Elevation A • 2,745 sq.ft.
Elevation B • 2,760 sq.ft.

RANGE
GAS + ELECT.

66" AFF.

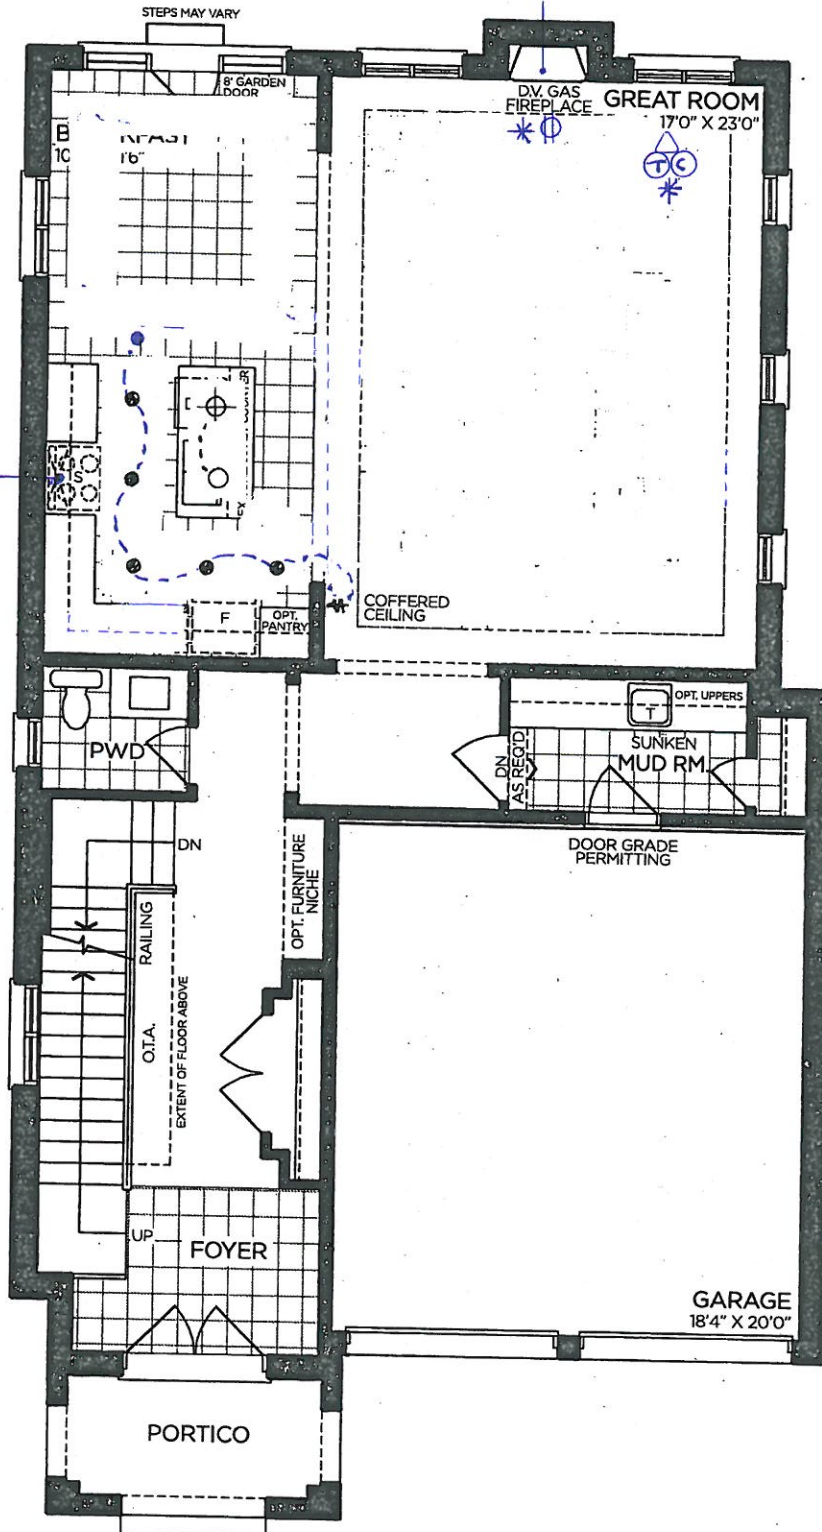

GROUND FLOOR | ELEV. A

VENDOR	
PURCHASER	
PURCHASER	

GOLDPARK
WORTH MORE™

Prices, figures, illustrations, sizes, features and finishes are subject to change without notice. Areas and dimensions are approximate and actual usable floor space may vary from the stated area. Layout may be reverse of the unit purchased. E. & O.E. 4008

SCHEDULE 'F'




PV-128
April 13 2020

see attached
see attached

The Hillsdale
40' SERIES

Elevation A • 2,745 sq.ft.
Elevation B • 2,760 sq.ft.

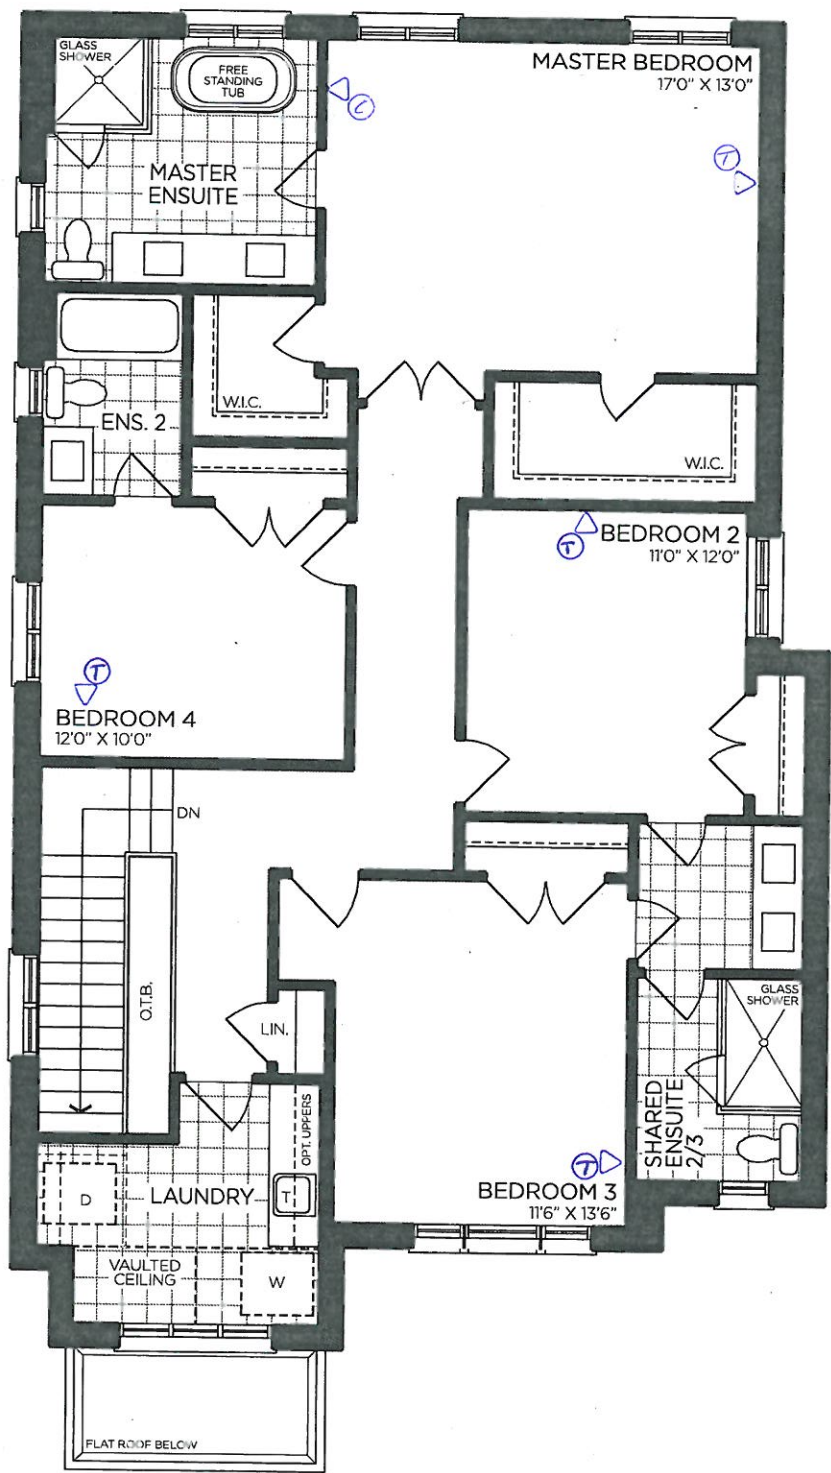

SECOND FLOOR | ELEV. A

VENDOR

PURCHASER

PURCHASER

GOLDPARK
WORTH MORE™

Prices, figures, illustrations, sizes, features and finishes are subject to change without notice. Areas and dimensions are approximate and actual usable floor space may vary from the stated area. Layout may be reverse of the unit purchased. E. & O.E. 4008

SCHEDULE 'F'




PV-12B
APRIL 19 2022

L.H.
B.S.

The
Hillsdale
40' SERIES

→ Elevation A - 2,745 sq.ft.
Elevation B - 2,760 sq.ft.

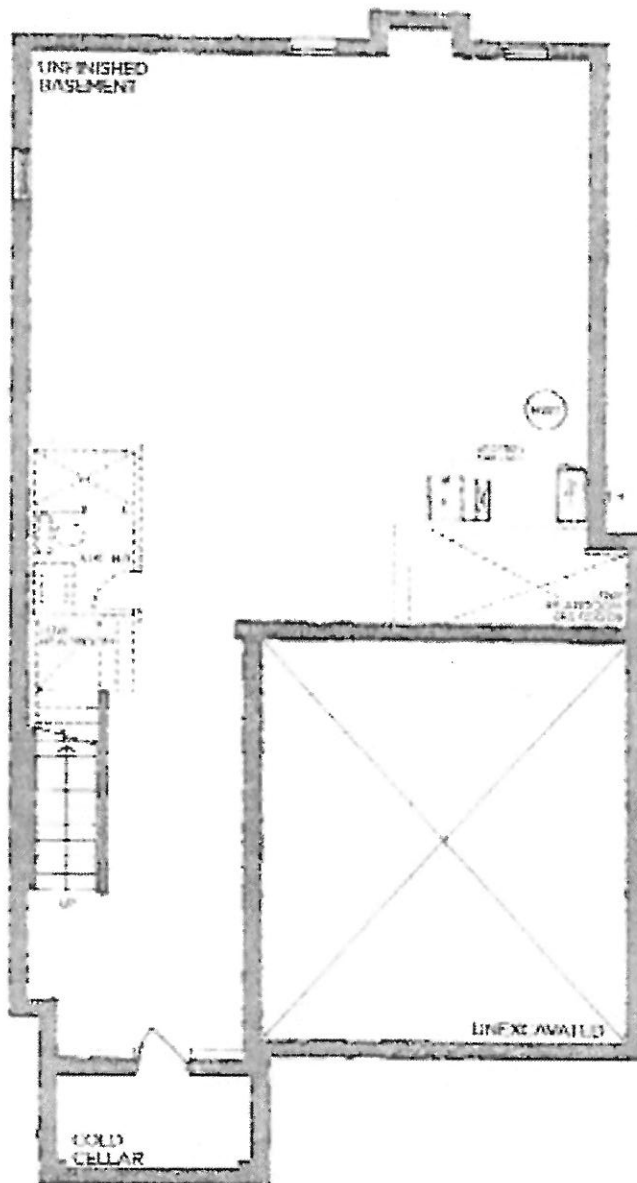

BASEMENT | ELEV A

VENDOR
PURCHASER
PURCHASER

GOLD

WORTH MORE

These figures are for informational purposes only and are not intended to be used as a basis for any financial or legal decision. The actual value of the property may vary from the stated value. Legal description of the property is located on page 4 of the deed.


SCHEDULE 'F'



FV-128
 April 13 2026
 L.H.
 B-S

The
Hillsdale
 40' SERIES
 Elevation A - 2,745 sq.ft.
 Elevation B - 2,760 sq.ft.

RANGE
 GAS & ELECT.

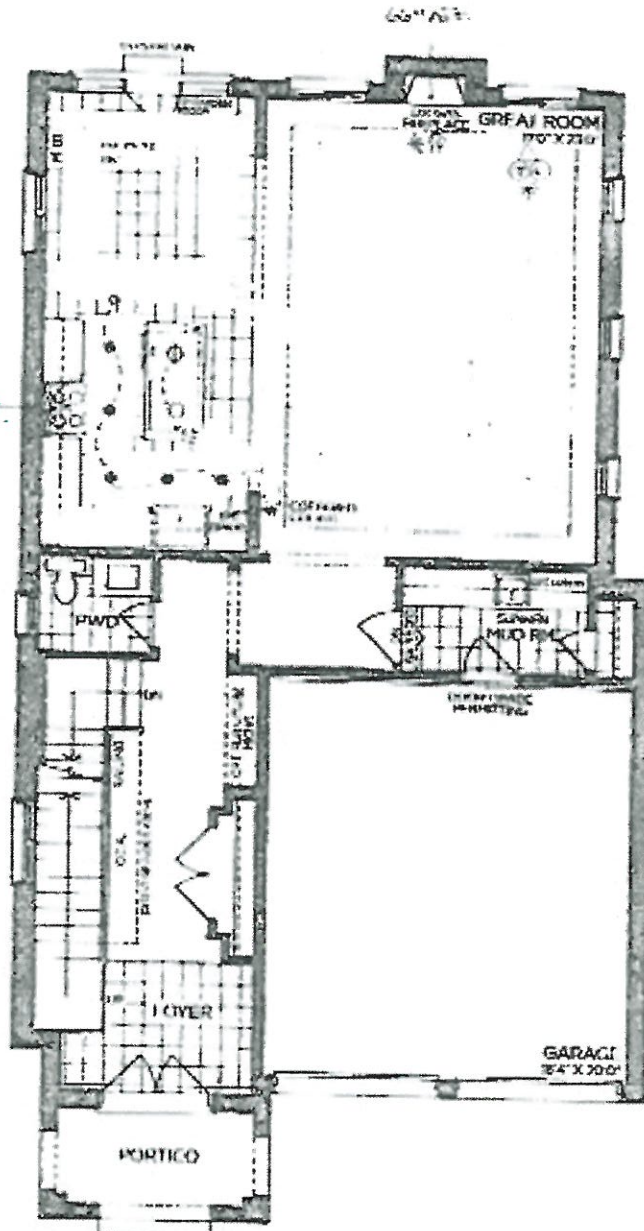

GROUND FLOOR | FLEV. A

VENDOR
 PURCHASER
 PURCHASER

GOLDPARK
 WORTH MORE

Notes: Figures, illustrations, plans, fixtures and finishes are subject to change without notice. Areas and dimensions are approximate and actual usable floor space may vary from the stated area. Layout may be reverse of the unit pictured. L & O.E. 4004

L.H.
B.S.

SECOND FLOOR | ELEV. A

Received 12 August 2003; revised 12 November 2003; accepted 12 November 2003
Published online 12 December 2003 in Wiley InterScience (www.interscience.wiley.com). DOI: 10.1002/anie.200300500