

GOLDPARK

WORTH MORE™

CONSTRUCTION SUMMARY

Lot: 129

Model: 40.02 B VALLEYVIEW

Project/Phase: Pine Valley Forevergreen / 1

FRAMING

Invoice	Qty.	Description
2326 72,631	1	MASTER ENSUITE: SHOWER NICHE [SHAMPOO SHELF] - COMPLETE WITH MATCHING MARBLE JAMBS ON 4 SIDES, STANDARD TILE, APPROX. 12 X 18 INSTALLED VERTICALLY
2326 72,385	1	.GREAT ROOM - OPT. COFFERED CEILING - AS PER PLAN
2326 72,387	1	.GREAT ROOM - OPT. WAFFLE CEILING, BEAM DETAIL AS PER PLAN (6 BOXES) OPTION # 1 - CTR-B07
2326 72,384	1	.BREAKFAST ROOM OPT. COFFERED CEILING - AS PER PLAN
2326 NoCat	1	.**CUSTOM LAYOUT** DELETE CLOSET AT LAUNDRY ROOM - LEAVE OPEN SPACE
2326 NoCat	1	.GREAT ROOM: DO *NOT* INSTALL STANDARD CAST STONE MANTLE - LEAVE JUST PAINTED DRYWALL

INTERIOR TRIM AND DOORS

Invoice	Qty.	Description
2326 NoCat	1	.GREAT ROOM: DO *NOT* INSTALL STANDARD CAST STONE MANTLE - LEAVE JUST PAINTED DRYWALL
2326 NoCat	1	.GREAT ROOM - OPT. COFFERED CEILING - AS PER PLAN
2326 NoCat	1	.GREAT ROOM - OPT. WAFFLE CEILING, BEAM DETAIL AS PER PLAN (6 BOXES) OPTION # 1 - CTR-B07
2326 NoCat	1	.BREAKFAST ROOM OPT. COFFERED CEILING - AS PER PLAN
2326 NoCat	1	.**CUSTOM LAYOUT** DELETE CLOSET AT LAUNDRY ROOM - LEAVE OPEN SPACE

MISC.

Invoice	Qty.	Description

Page 3 of 5

Printed and Sent: 14-Jun-20

GOLDPARK

WORTH MORE™

CONSTRUCTION SUMMARY

Lot: 129

Model: 40.02 B VALLEYVIEW

Project/Phase: Pine Valley Forevergreen / 1

PLUMBING		
Invoice	Qty.	Description
2203	1	.BACK-FLOW PREVENTER VALVE
NoCat		

PLUMBING FIXTURES		
Invoice	Qty.	Description
2326	1	.MASTER ENSUITE: UPGRADE TO MOEN '90*' POSI-TEMP 3-FUNCTION RAIN SHOWER (from ceiling) + HAND SHOWER AND SLIDE BAR - CHROME #7S2712EP/3372/TS4172/62320/S3879EP/A721
NoCat		

SCHEDULE 'F'




PV-129 *see attached*
MAR 16 2020

PV-129
MAY 5 2020 *5858*

The Valleyview
40' SERIES

Elevation A • 3,145 sq.ft.
→ Elevation B • 3,170 sq.ft.

STD 16x30" *STD 16x30"*

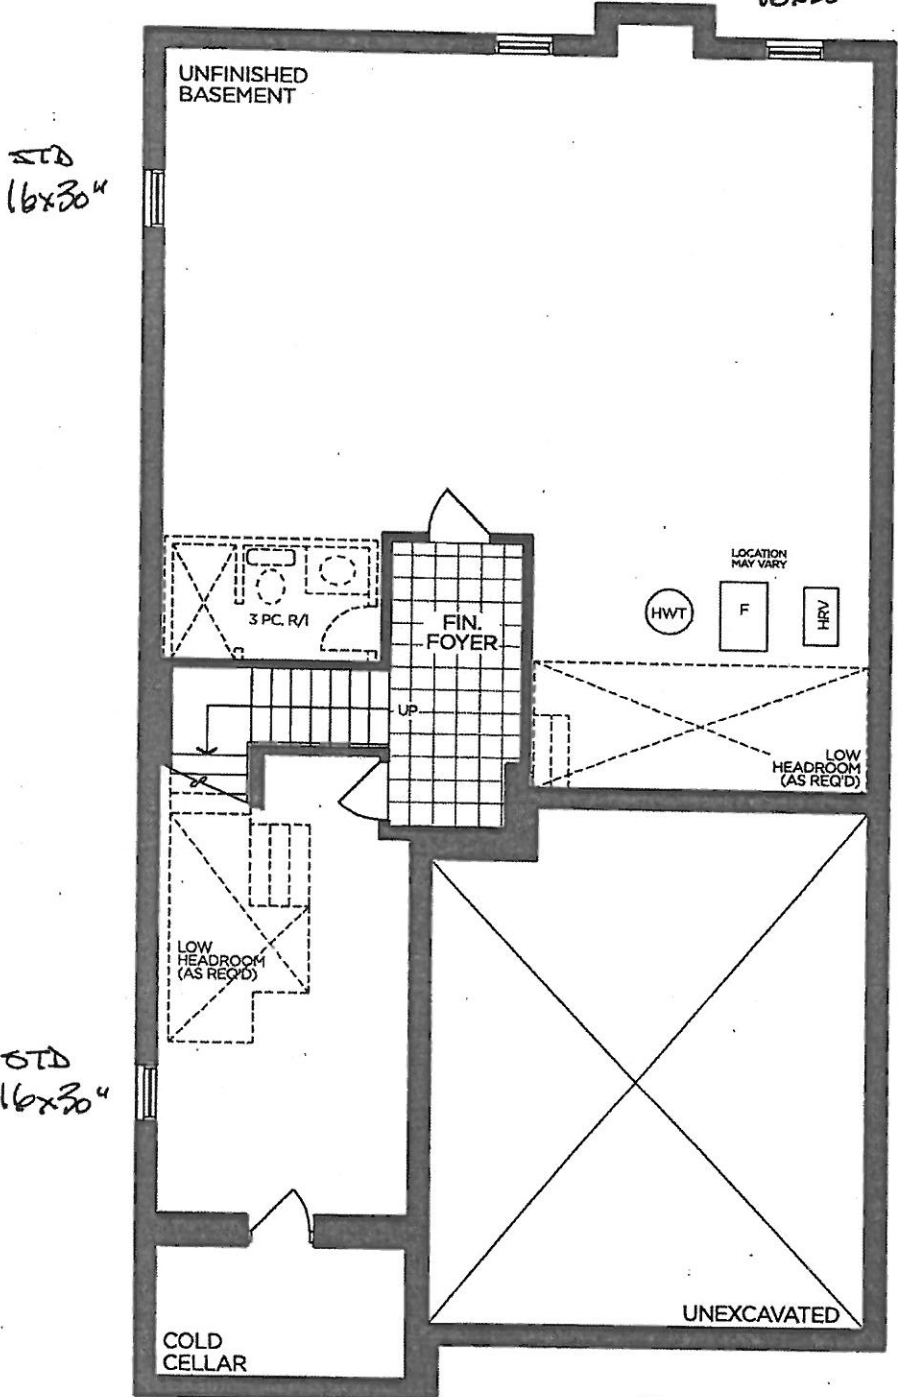

BASEMENT | ELEV. A

*BACK-FLOW
PREVENTER VALVE*

VENDOR

PURCHASER

PURCHASER

GOLDPARK
WORTH MORE™

Prices, figures, illustrations, sizes, features and finishes are subject to change without notice. Areas and dimensions are approximate and actual usable floor space may vary from the stated area. Layout may be reverse of the unit purchased. E. & O.E. 4002




SCHEDULE 'F'

PV-129 *see email*
MARCH 16 2020

PV-129
MAY 5 2020 *SG SG*

The Valleyview 40' SERIES

Elevation A • 3,145 sq.ft.
→ Elevation B • 3,170 sq.ft.

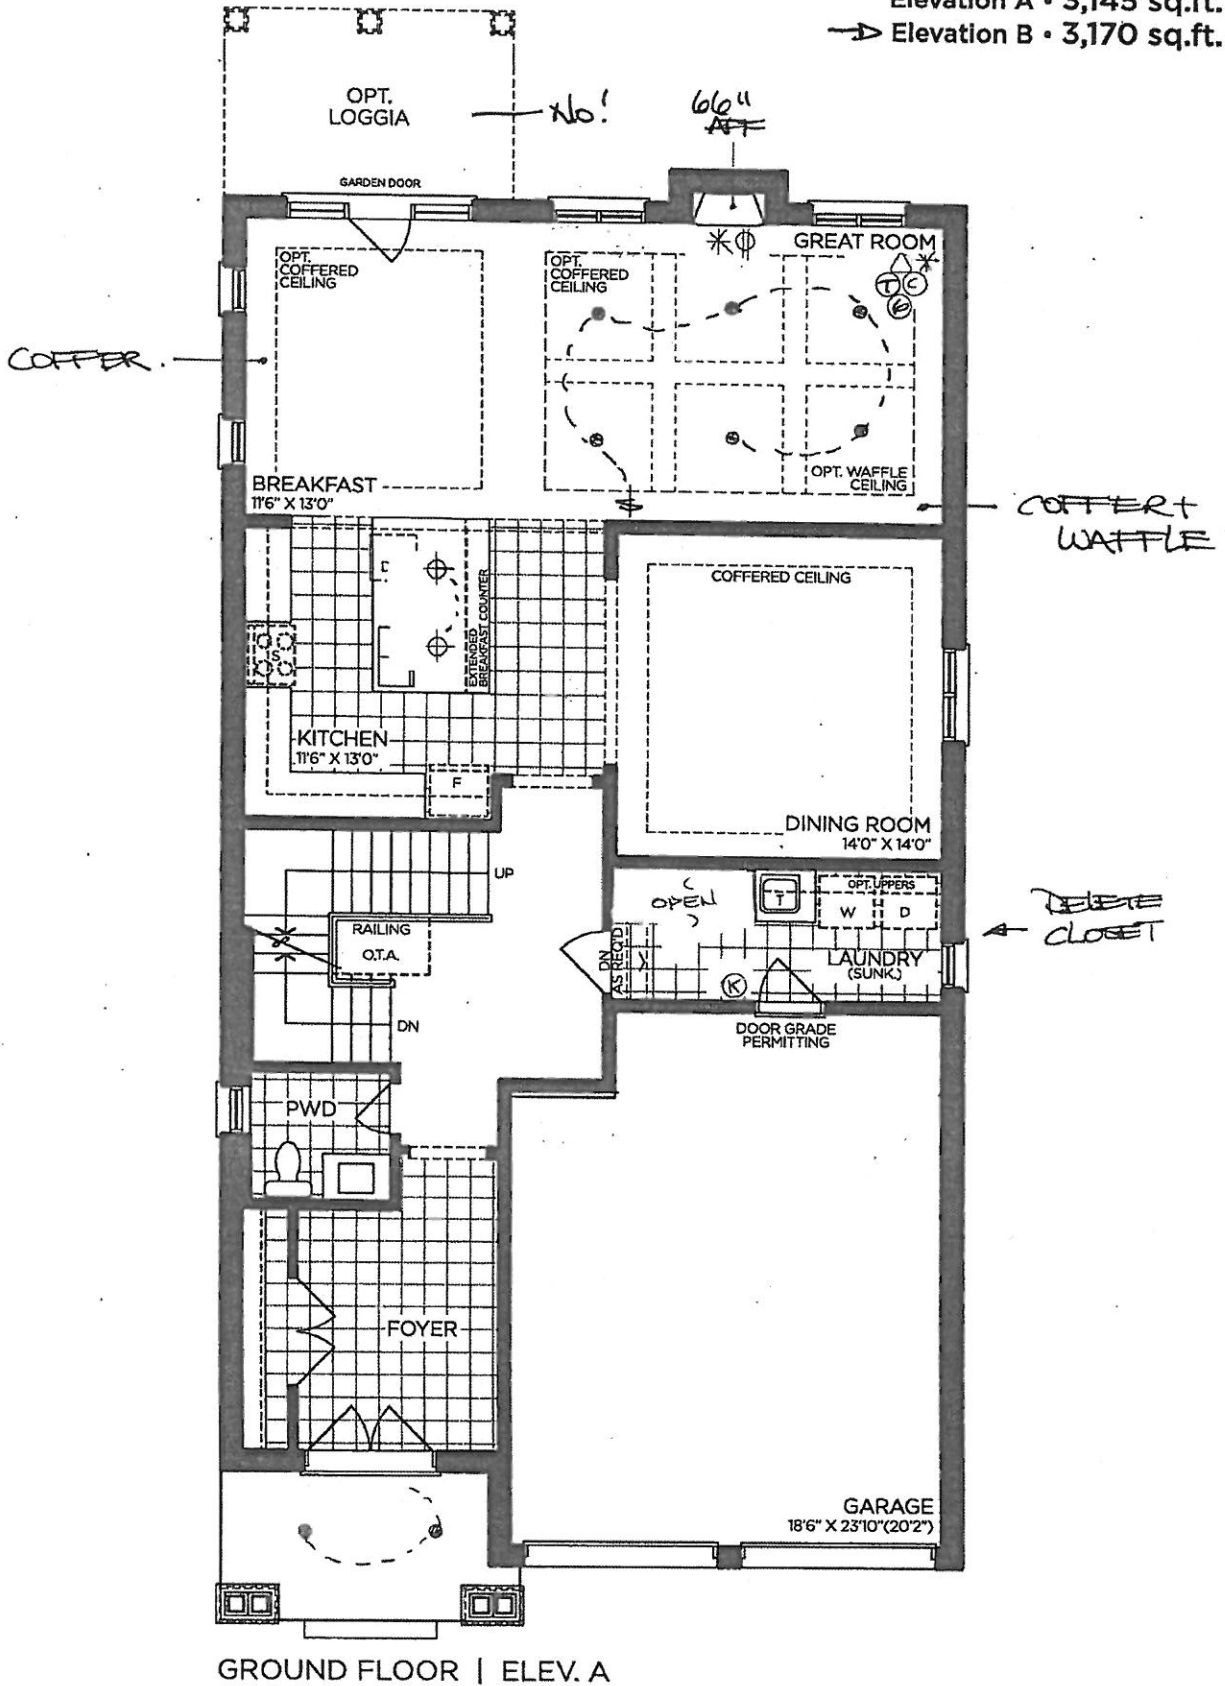

GROUND FLOOR | ELEV. A

VENDOR

PURCHASER

PURCHASER


GOLDPARK
WORTH MORE™

Prices, figures, illustrations, sizes, features and finishes are subject to change without notice. Areas and dimensions are approximate and actual usable floor space may vary from the stated area. Layout may be reverse of the unit purchased. E. & O.E. 4002

SCHEDULE 'F'



PV-129 ^{see annex}
MAR 16 2020
PV-129 MAY 5 2020 ⁵⁰⁵⁰
The Valleyview 40' SERIES
Elevation A • 3,145 sq.ft.
→ Elevation B • 3,170 sq.ft.

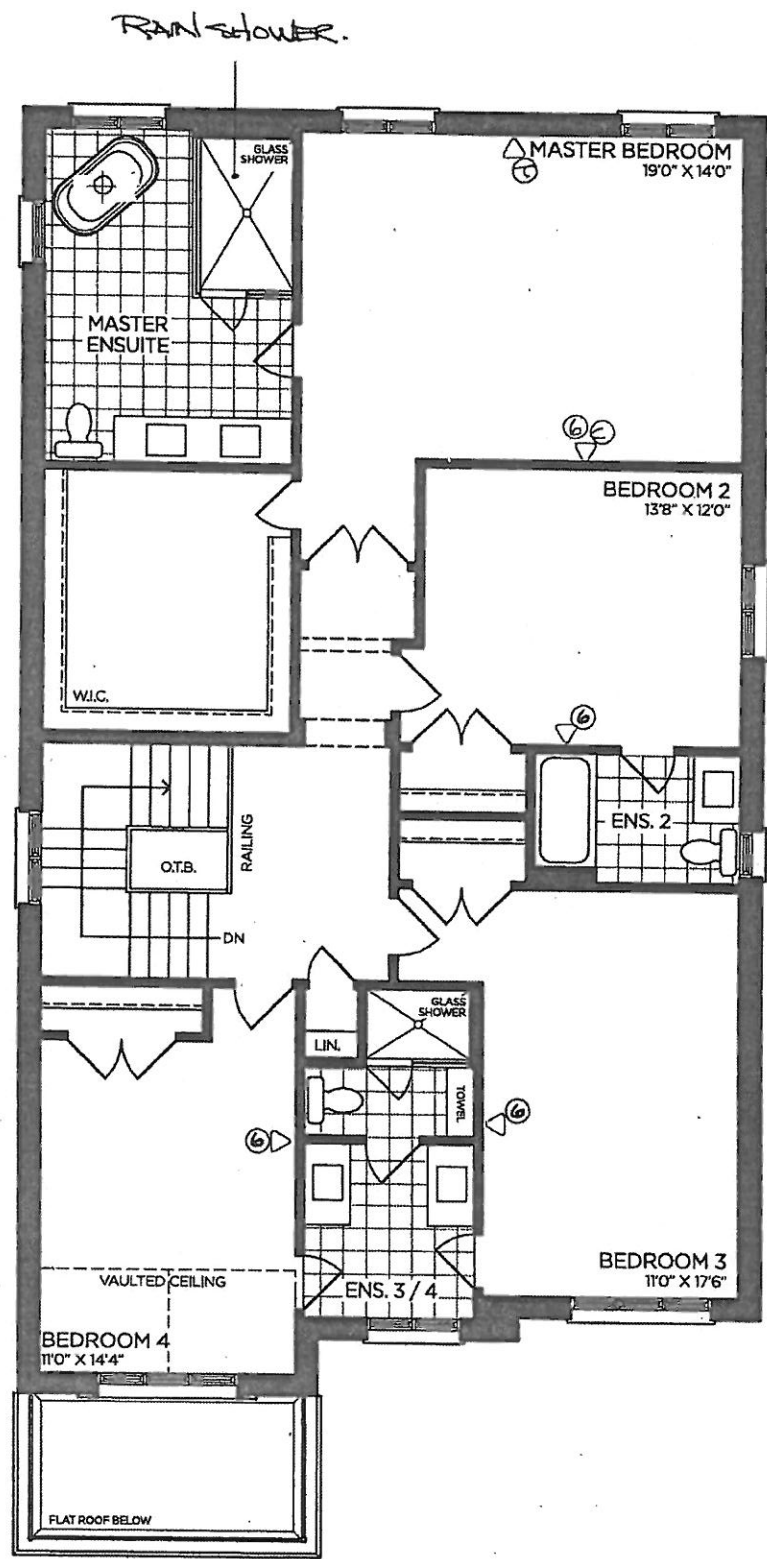

SECOND FLOOR | ELEV. A

VENDOR

PURCHASER

PURCHASER

GOLDPARK
WORTH MORE™



Prices, figures, illustrations, sizes, features and finishes are subject to change without notice. Areas and dimensions are approximate and actual usable floor space may vary from the stated area. Layout may be reverse of the unit purchased. E. & O.E. 4002

PLUMBING UPGRADES



POSI-TEMP SHOWER ONLY* W/ 3 FUNCTION TRANSFER
VALVE/TRIM AND SLIDE BAR WITH HAND SHOWER

MOEN - 90 DEGREE

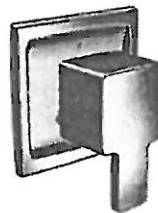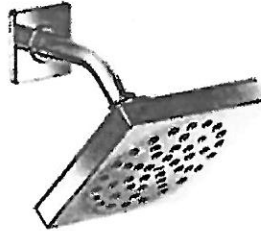

☒ CHROME

☐ BRUSHED NICKEL

☐ MATTE BLACK

☐ from WALL

☒ from CEILING

MODEL TS2712EP / 3372 / TS4172 / 62320 / S3879EP / A721

Lot# 129

Room: MASTER ENSUITE

Signature:

OSG

Date: MAY 5 2020

Signature:

OSG