

CERAMIC		
Invoice	Qty.	Description
2267 NoCat	1	.***REVISED LAYOUT*** MOVE REAR GARAGE WALL APPROX 3' (SQUARE OFF REAR OF GARAGE) TO CREATE LARGER LAUNDRY ROOM. MOVE DOOR FROM GARAGE TO HOUSE CLOSER TO EXTERIOR WALL. SEE PLAN FOR LOCATION. [COMPLETE WITH STANDARD LEVEL FINISHES]
2347 NoCat	1	.**CUSTOM LAYOUT** REVISE LAYOUT OF POWDER ROOM. INTERIOR OF POWDER ROOM TO BE APPROX. 4'X7'. REDUCE FOYER CLOSET TO ACCOMMODATE, INSTALL LARGER CLOSET DOORS - SEE ATTACHED SKETCH
2347 NoCat	1	.***CUSTOM LAYOUT** DELETE CLOSET AT LAUNDRY
2347 NoCat	1	.MASTER ENSUITE: ADD APPROX. 30" WIDE, FULL HEIGHT NIBB WALL AT END OF VANITY SEPARATING VANITY/TOILET
2347 NoCat	1	.MASTER ENSUITE: REPOSITION TUB TO BE CENTERED BELOW REAR WINDOW - SEE PLAN FOR LOCATION
2347 NoCat	1	.MASTER ENSUITE: SHOWER NICHE [SHAMPOO SHELF] - COMPLETE WITH MATCHING MARBLE JAMBS ON 4 SIDES, STANDARD TILE, APPROX. 12 X 18 INSTALLED VERTICALLY

SCHEDULE 'F'




PV-142 *see attached see attached*
APRIL 3 2020

The Valleyview

40' SERIES

→ Elevation A • 3,145 sq.ft.
Elevation B • 3,170 sq.ft.

REUSED
APRIL 22 2020 *see attached see attached*

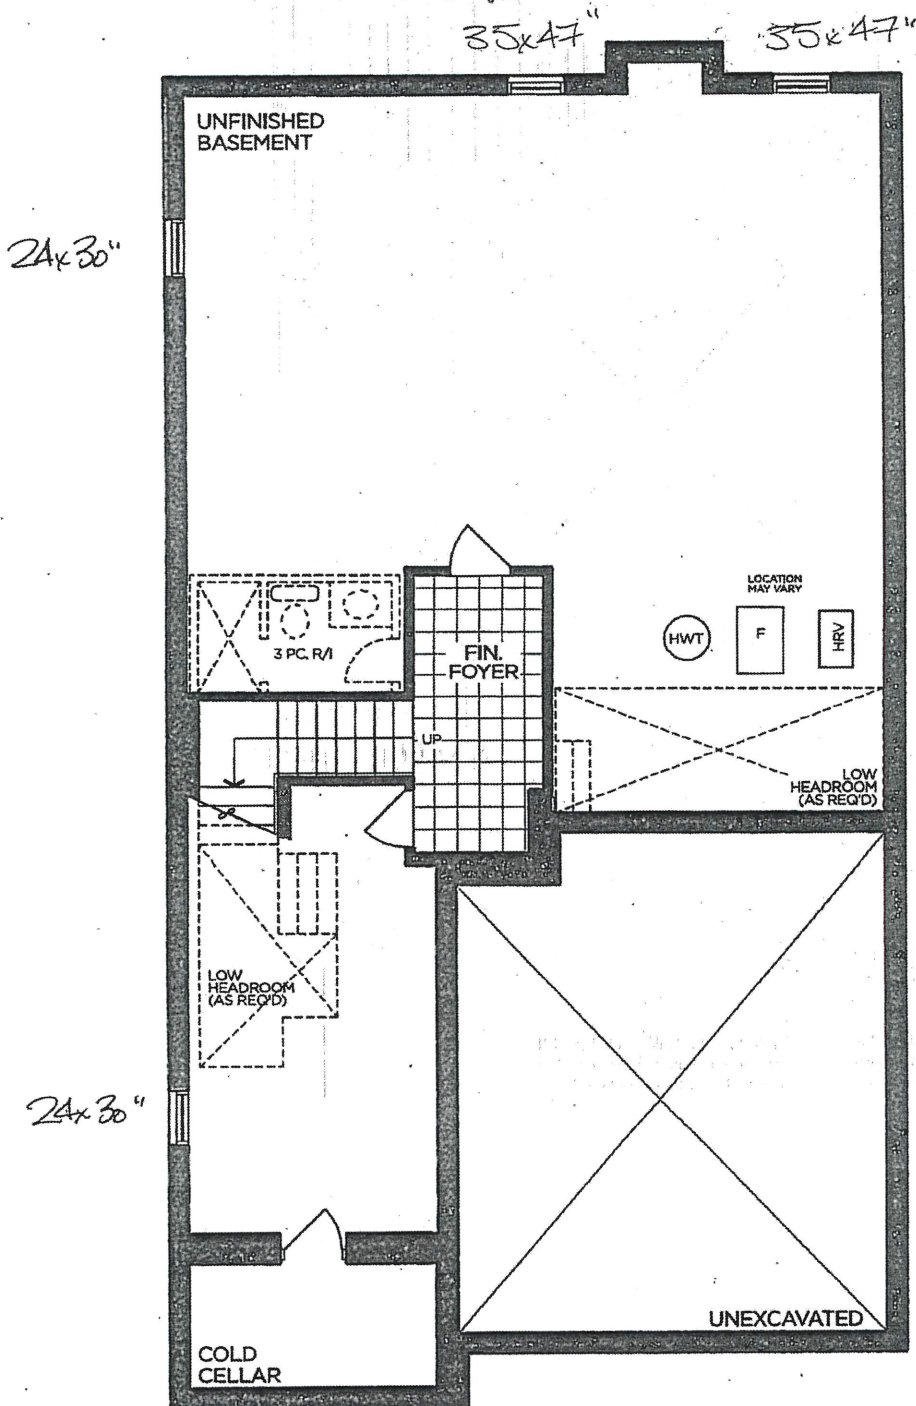

BASEMENT | ELEV. A

VENDOR	<input type="text"/>
PURCHASER	<input type="text"/>
PURCHASER	<input type="text"/>

GOLDPARK
WORTH MORE™


Prices, figures, illustrations, sizes, features and finishes are subject to change without notice. Areas and dimensions are approximate and actual usable floor space may vary from the stated area. Layout may be reverse of the unit purchased. E. & O.E. 4002

SCHEDULE 'F'



The Valleyview 40' SERIES

Elevation A - 3,145 sq.ft.
Elevation B - 3,170 sq.ft.

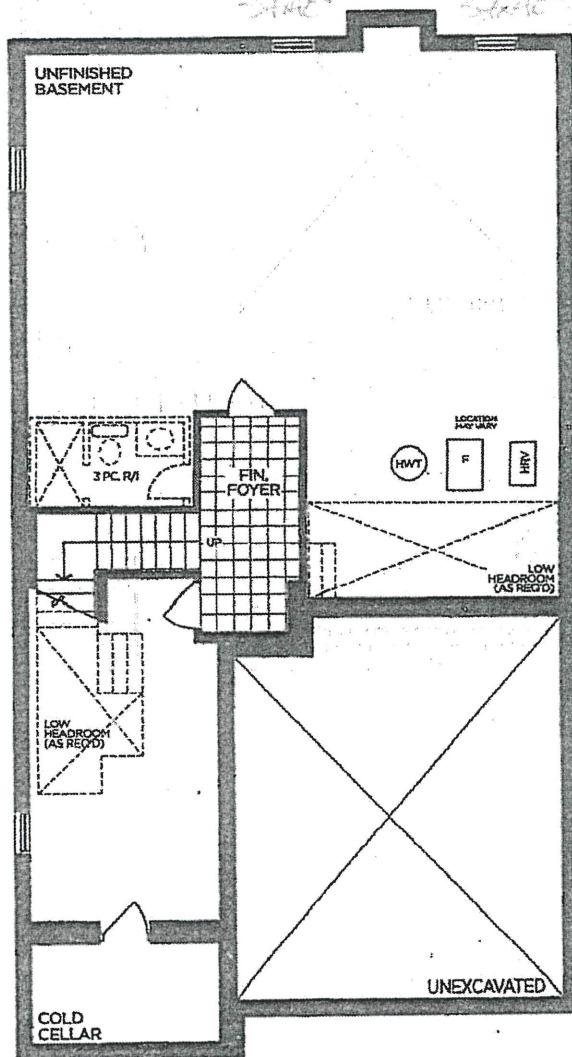

BASEMENT | ELEV. A

VENDOR

--

PURCHASER

PURCHASER

--

GOLDPARK
WORTH MORE

Prices, figures, illustrations, sizes, features and finishes are subject to change without notice. Areas and dimensions are approximate and actual usable floor space may vary from the stated area. Layout may be reverse of the unit purchased. E. & Q.E. 4002

SCHEDULE 'F'




PV-142.
MAY 21 2026

See attached

The Valleyview
40' SERIES

Elevation A • 3,145 sq.ft.
Elevation B • 3,170 sq.ft.

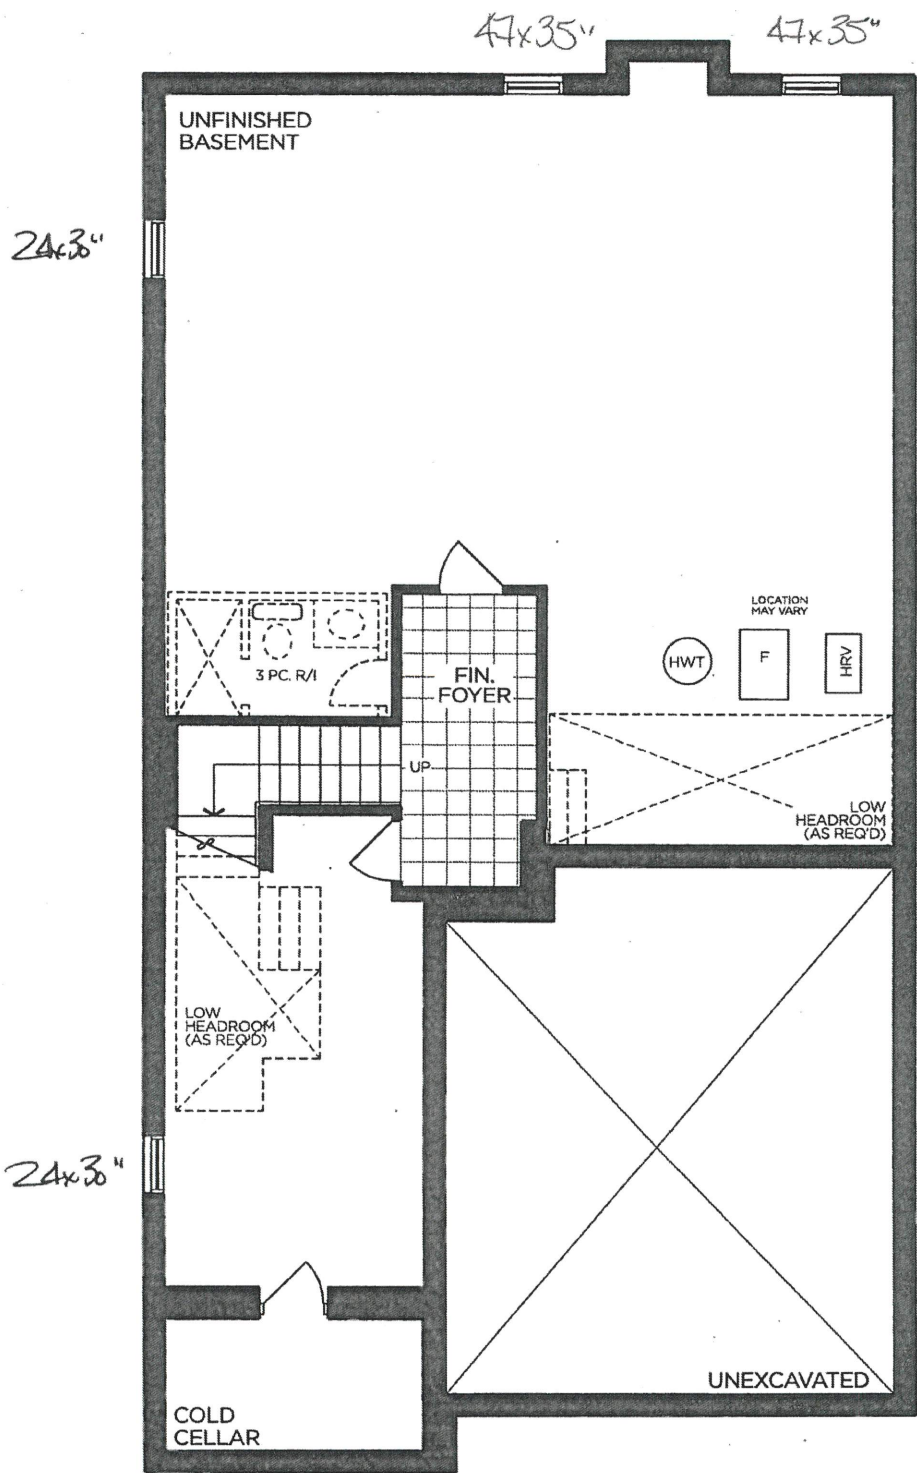

BASEMENT | ELEV. A

VENDOR

PURCHASER

PURCHASER

GOLDPARK
WORTH MORE™

Prices, figures, illustrations, sizes, features and finishes are subject to change without notice. Areas and dimensions are approximate and actual usable floor space may vary from the stated area. Layout may be reverse of the unit purchased. E. & O.E. 4002

SCHEDULE 'F'




PV-142
April 3 2020
MAY 21 2020

See attached.

The Valleyview

40' SERIES

Elevation A • 3,145 sq.ft.
Elevation B • 3,170 sq.ft.

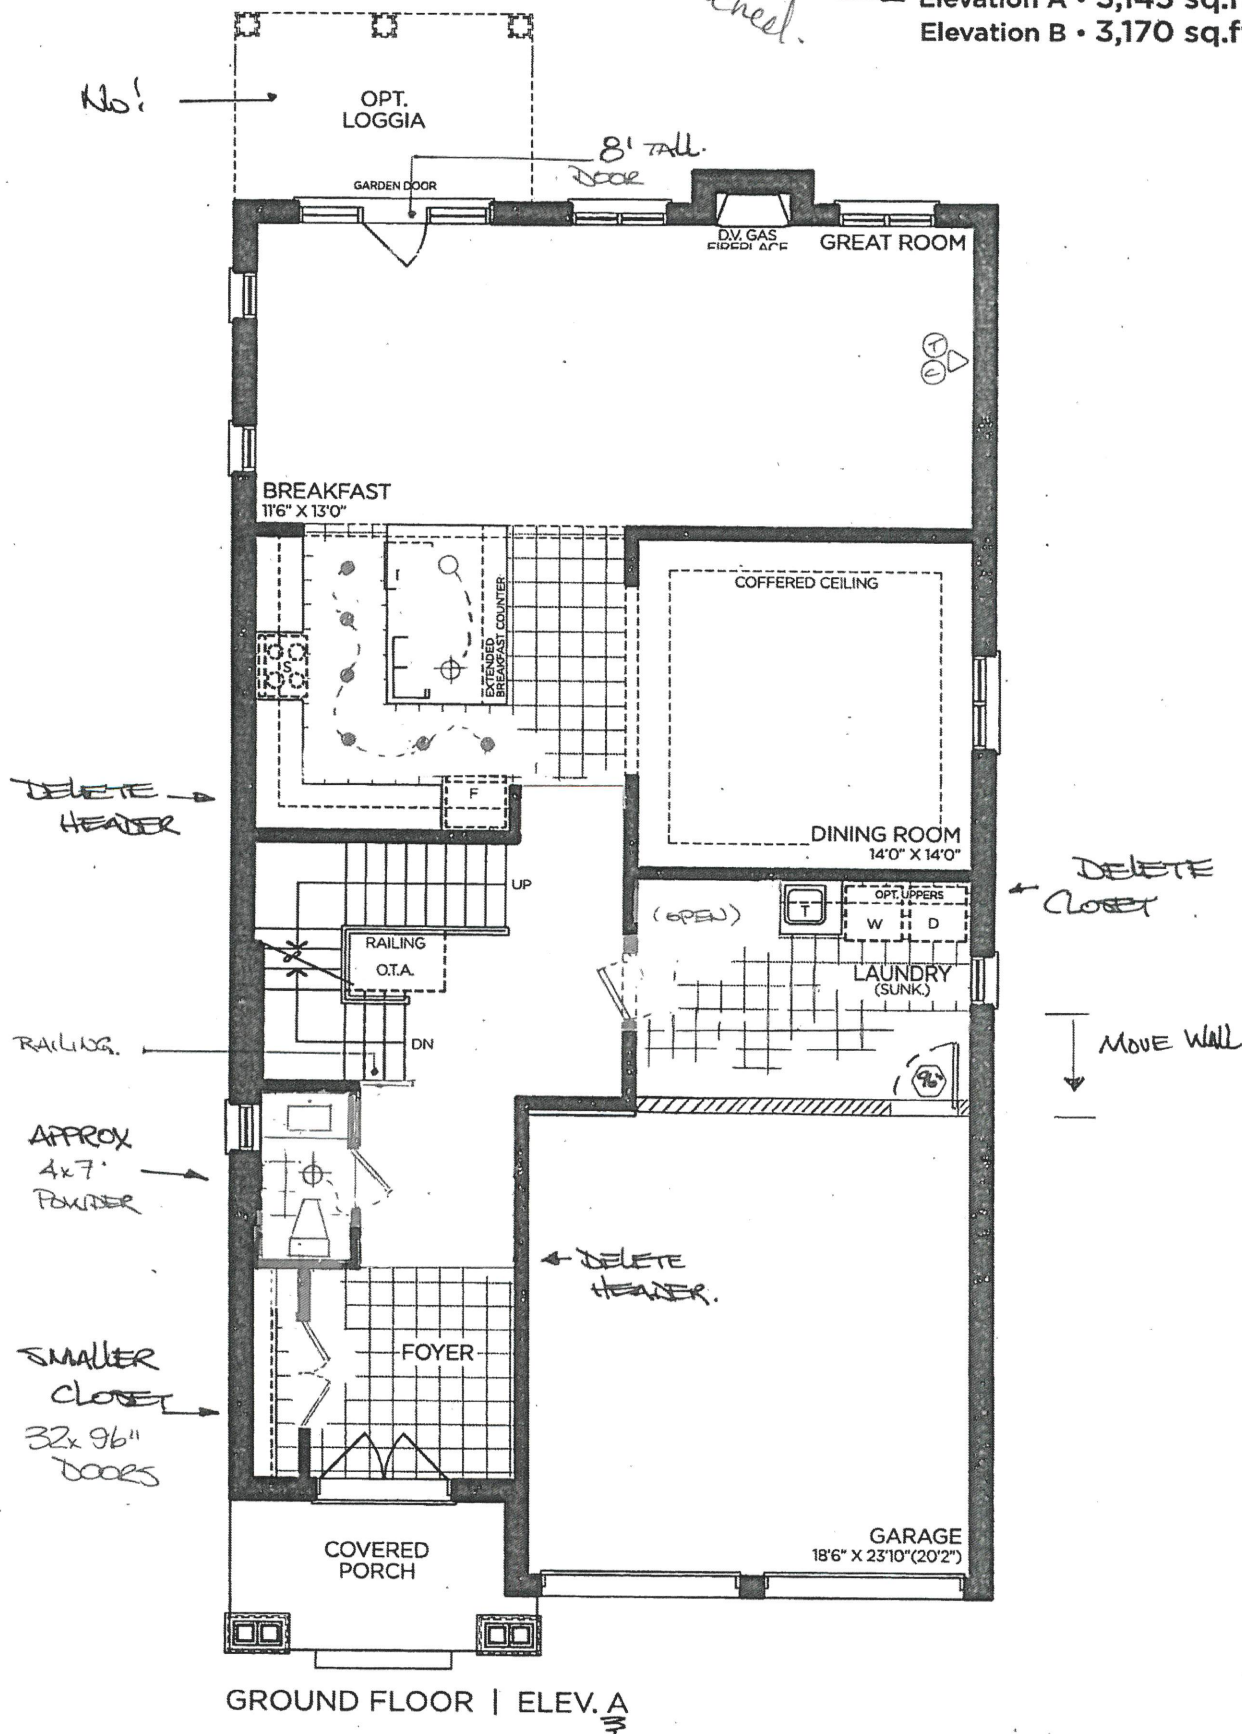

VENDOR

PURCHASER

PURCHASER

GOLDPARK
WORTH MORE™

Prices, figures, illustrations, sizes, features and finishes are subject to change without notice. Areas and dimensions are approximate and actual usable floor space may vary from the stated area. Layout may be reverse of the unit purchased. E. & O.E. 4002



SCHEDULE 'F'

PV-142

MAY 21 2020


See attached.

The Valleyview

40' SERIES

→ Elevation A • 3,145 sq.ft.

Elevation B • 3,170 sq.ft.

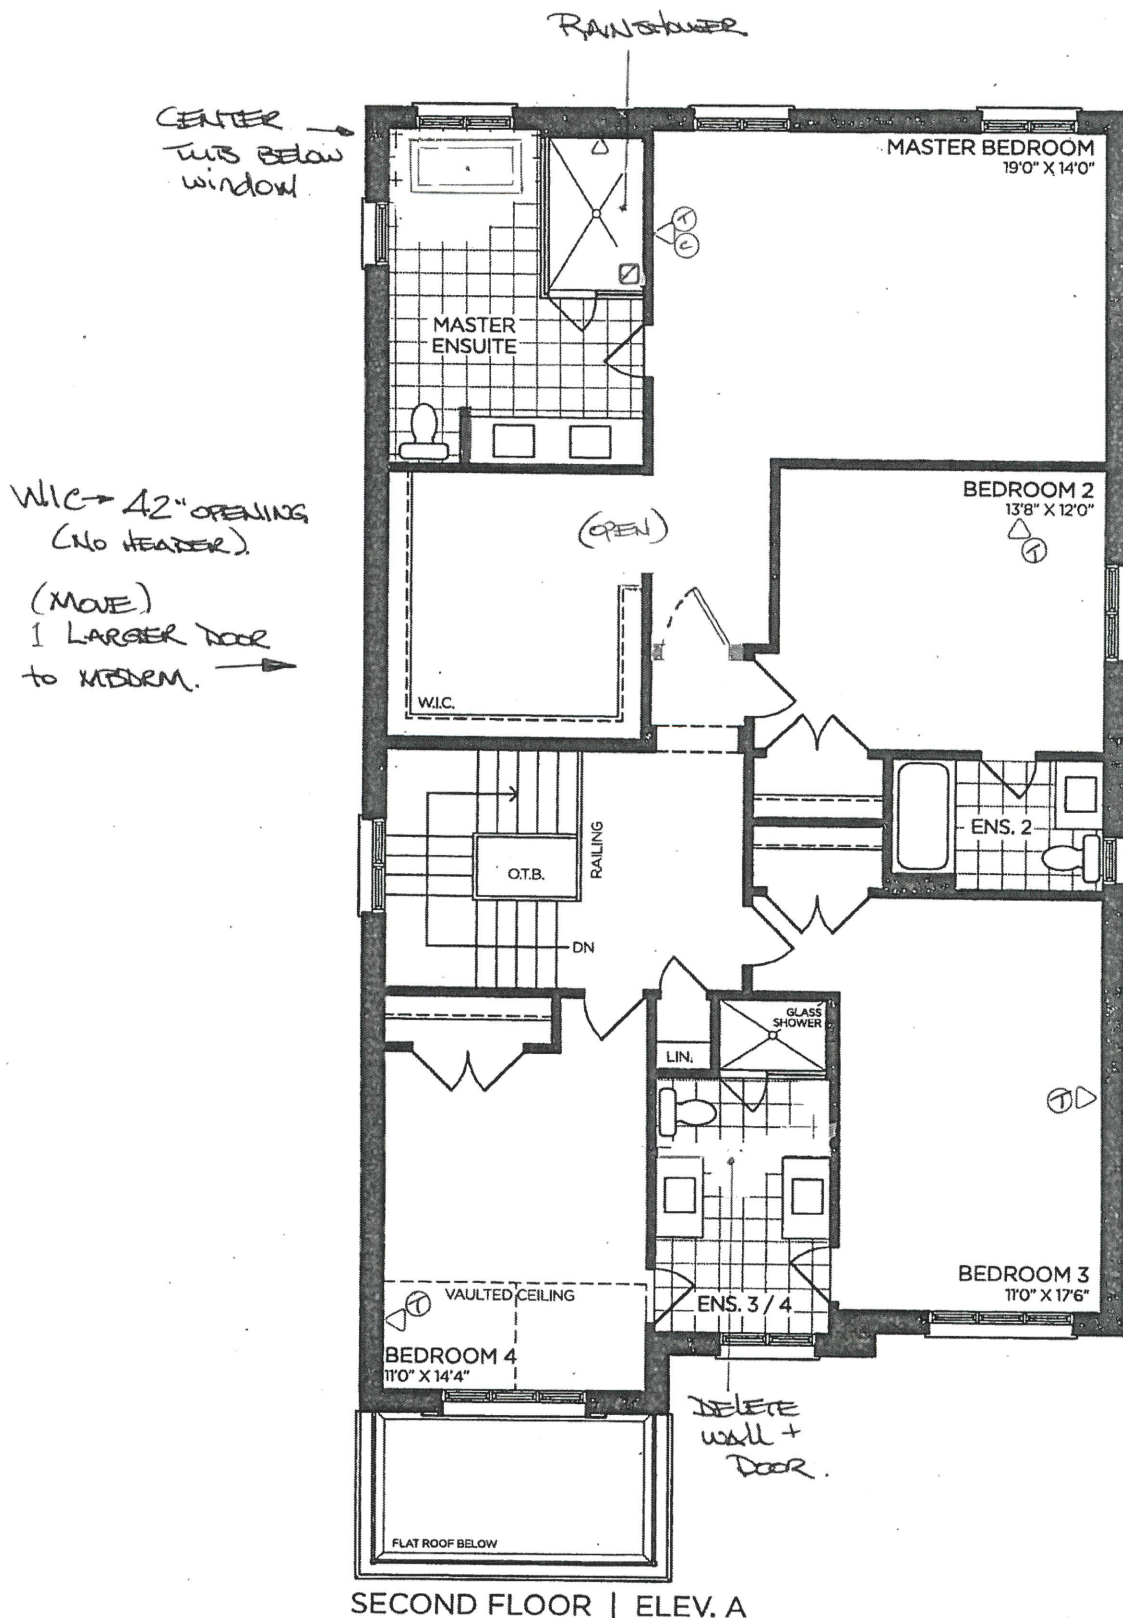

VENDOR

PURCHASER

PURCHASER

GOLDPARK

WORTH MORE™





Prices, figures, illustrations, sizes, features and finishes are subject to change without notice. Areas and dimensions are approximate and actual usable floor space may vary from the stated area. Layout may be reverse of the unit purchased. E. & O.E. 4002

PLUMBING UPGRADES



POSI-TEMP SHOWER ONLY* W/ 3 FUNCTION TRANSFER VALVE/TRIM AND SLIDE BAR WITH HAND SHOWER

MOEN - 90 DEGREE

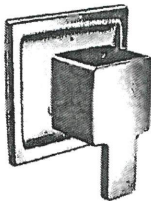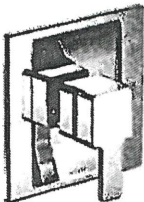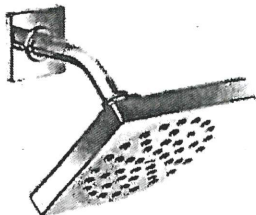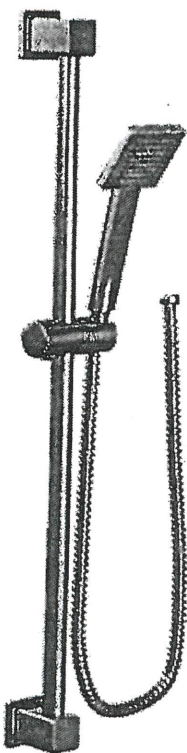

☒ CHROME

☐ from WALL

☐ BRUSHED NICKEL

☒ from CEILING

MODEL TS2712EP / 3372 / TS4172 / 62320 / S3879EP / A721

Lot# 142.

Room: MASTER ENSUITE

Signature: See attached.

Date: MAY 21 2020

Signature:


SCHEDULE T



PL-142
APR 21 2022

The
Valleyview
40' SERIES

Elevation A • 3,145 sq.ft.
Elevation B • 3,170 sq.ft.

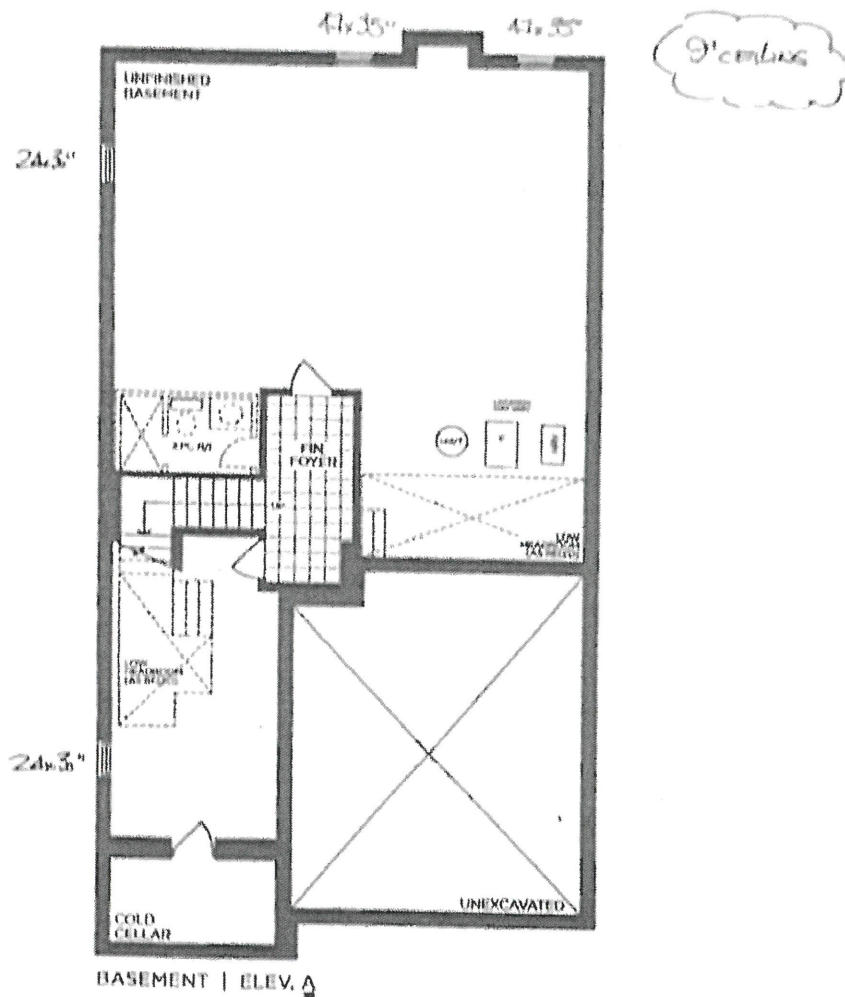

VENDOR _____
PURCHASER _____
PURCHASER _____

GOLDPARK
WORTH MORE®

Prices, figures, illustrations, sizes, features and fixtures are subject to change without notice. Areas and dimensions are approximate and actual inside floor space may vary from the stated area. Layout may be revised at the discretion of the architect. E. & C.E. 4002

SCHEDULE 'F'


PINE VALLEY
18400000000

PV-142
April 8 2022

MAY 21 2022 (W)

The
Valleyview
40' SERIES

Elevation A • 3,145 sq.ft.
Elevation B • 3,170 sq.ft.

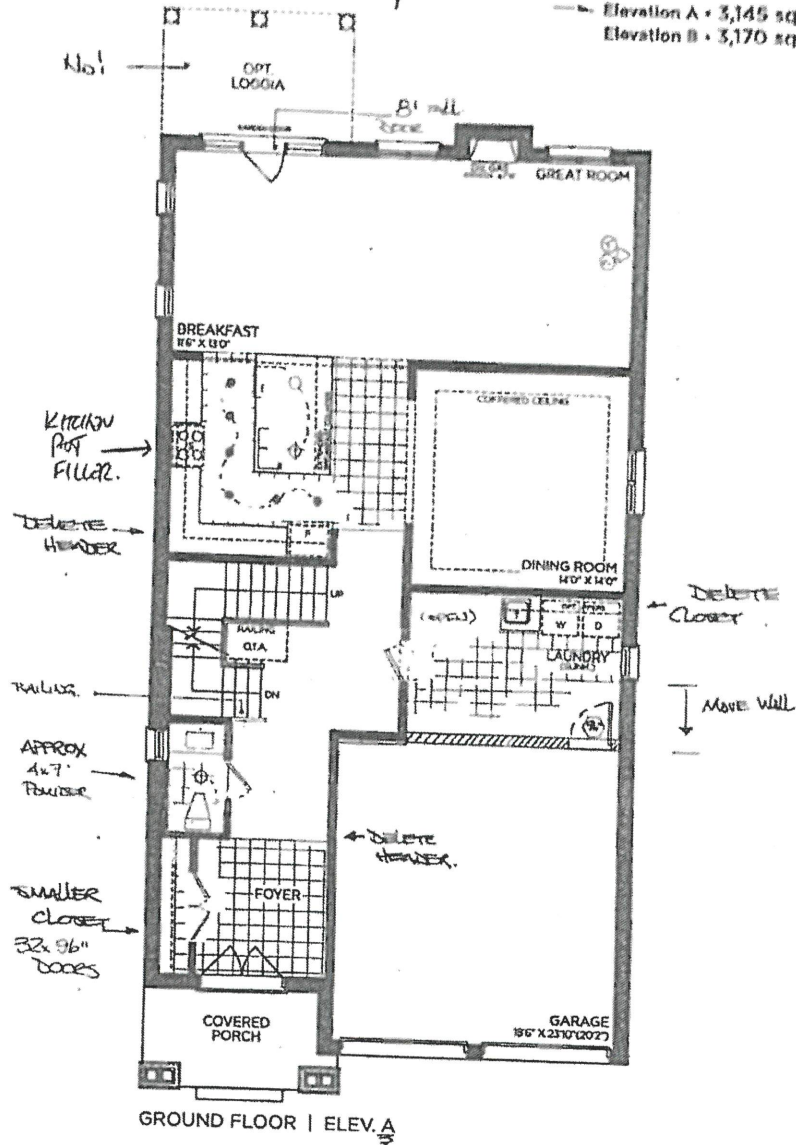

VENDOR
PURCHASER
PURCHASER

GOLDPARK
WORTH MORE™


Prices, figures, illustrations, sizes, features and finishes are subject to change without notice. Areas and dimensions are approximate and actual usable floor space may vary from the stated area. Layout may be reverse of the unit purchased. E. & O.E. 4002

SCHEDULE T



PV-142
N/A 21 2020

The
Valleyview
40' SERIES
Elevation A • 3,145 sq.ft.
Elevation B • 3,170 sq.ft.

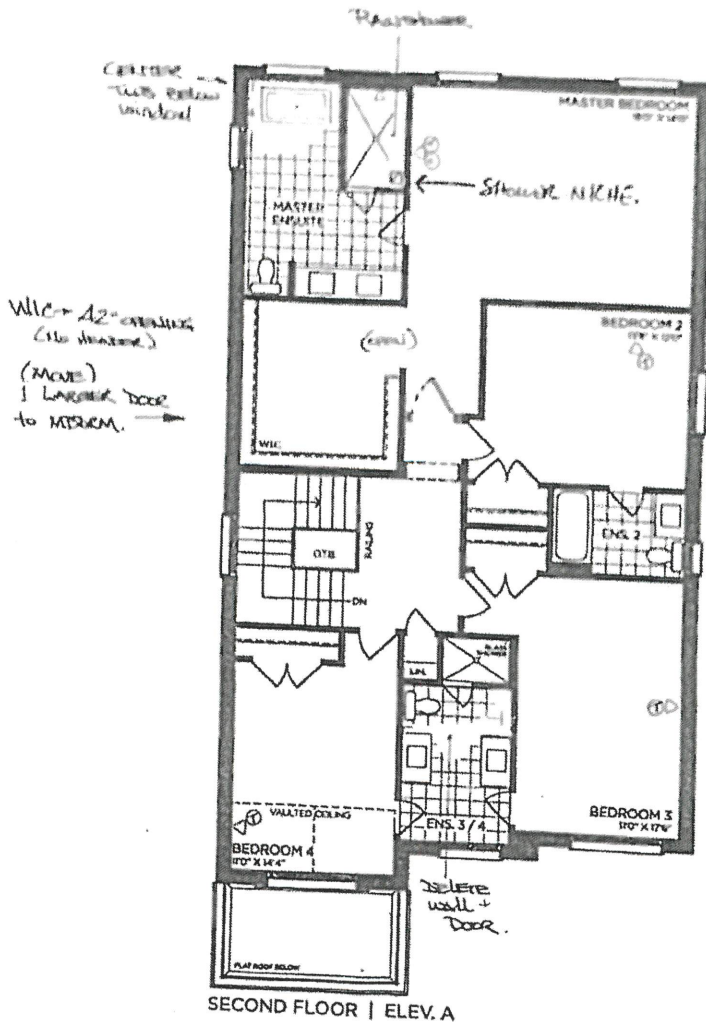

SECOND FLOOR | ELEV. A

VENDOR _____
PURCHASER _____
PURCHASER _____

GOLDPARK
WORTH MORE™




Prices, figures, illustrations, sizes, features and finishes are subject to change without notice. Areas and dimensions are approximate and actual usable floor space may vary from the stated area. Layout may be reverse of the unit purchased. E & O.E. 4002

PLUMBING UPGRADES



POST-TEMP SHOWER ONLY* W/ 3 FUNCTION TRANSFER
VALVE/TRIM AND SLIDE BAR WITH HAND SHOWER

MOEN - 90 DEGREE

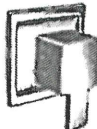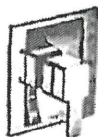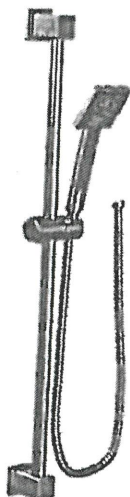



☒ CHROME

☐ from WALL

☐ BRUSHED NICKEL

☒ from CEILING

MODEL TS2712EP / 3372 / TS4172 / 62320 / S3879EP / A721

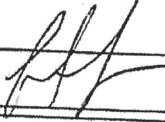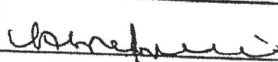Lot# 142.	Signature: 
Room: MASTER ENSUITE	Signature: 
Date: MAY 21 2020	

GOLDPARK
GOLDPARK.COM