

GOLDPARK

WORTH MORE™

CONSTRUCTION SUMMARY

Lot: 116

Model: 40.03 B BROOKSIDE

Project/Phase: Pine Valley Forevergreen / 1

CERAMIC

Invoice	Qty.	Description
2392 35508 15Jun20 NoCat	1	.SHOWER NICHE [SHAMPOO SHELF] - COMPLETE WITH MATCHING MARBLE JAMBS ON 4 SIDES, STANDARD TILE, APPROX. 12 X 18 INSTALLED VERTICALLY - MUST SPECIFY LOCATION

CONCRETE AND DRAIN

Invoice	Qty.	Description
2262 32004 15Jun20 NoCat	1	.BACK-FLOW PREVENTER VALVE

CROWN MOULDING

Invoice	Qty.	Description
2392 35489 15Jun20 NoCat	1	.GREAT ROOM - OPT. COFFERED CEILING AS PER PLAN
2392 35496 15Jun20 NoCat	1	.STUDY - OPT. COFFERED CEILING AS PER PLAN

ryDiscipline.rpt 06May20

Page 1 of 8

Printed and Sent: 15-Jun-20

GOLDPARK

WORTH MORE™

CONSTRUCTION SUMMARY

Lot: 116

Model: 40.03 B BROOKSIDE

Project/Phase: Pine Valley Forevergreen / 1

INTERIOR TRIM AND DOORS

Invoice	Qty.	Description
2392 35490 15Jun20 NoCat	1	.GREAT ROOM - OPT. COFFERED CEILING AS PER PLAN
2392 35493 15Jun20 NoCat	1	.GREAT ROOM - OPT. WAFFLE CEILING , BEAM DETAIL AS PER PLAN (6 BOXES) OPTION # 1 CTR-B07
2392 35497 15Jun20 NoCat	1	.STUDY - OPT. COFFERED CEILING AS PER PLAN
2392 35500 15Jun20 NoCat	1	.STUDY- OPT. WAFFLE CEILING , BEAM DETAIL AS PER PLAN (4 BOXES) OPTION # 1 CTR-B07
2392 35503 15Jun20 NoCat	1	.STUDY - OPT. 8 FOOT HIGH DOUBLE FRENCH DOORS WITH FLAT CLEAR GLASS COMPLETE WITH BUILDERS STANDARD OFFERINGS
2392 35509 15Jun20 NoCat	16	.INCREASE HEIGHT OF DOOR TO 8FT SECOND FLOOR - PER DOOR
2392 35513 15Jun20 NoCat	1	.MASTER BEDROOM - OPT. 10 FOOT TRAY CEILING

NETWORK AND WIRING

Invoice	Qty.	Description
2392 35421 15Jun20	1	.GREAT ROOM: CONDUIT PIPE - FOR WALL MOUNT TV - LOCATE APPROX. 66" A.F.F. ABOVE FIREPLACE, TERMINATING AT CABLE LOCATION SEE PLAN

ryDiscipline.rpt 06May20

Page 6 of 8

Printed and Sent: 15-Jun-20


SCHEDULE 'F'



JUNE 15 2020
PV-116
APRIL 1 2020

The Brookside
40' SERIES

Elevation A • 3,380 sq.ft.
Elevation B • 3,350 sq.ft.

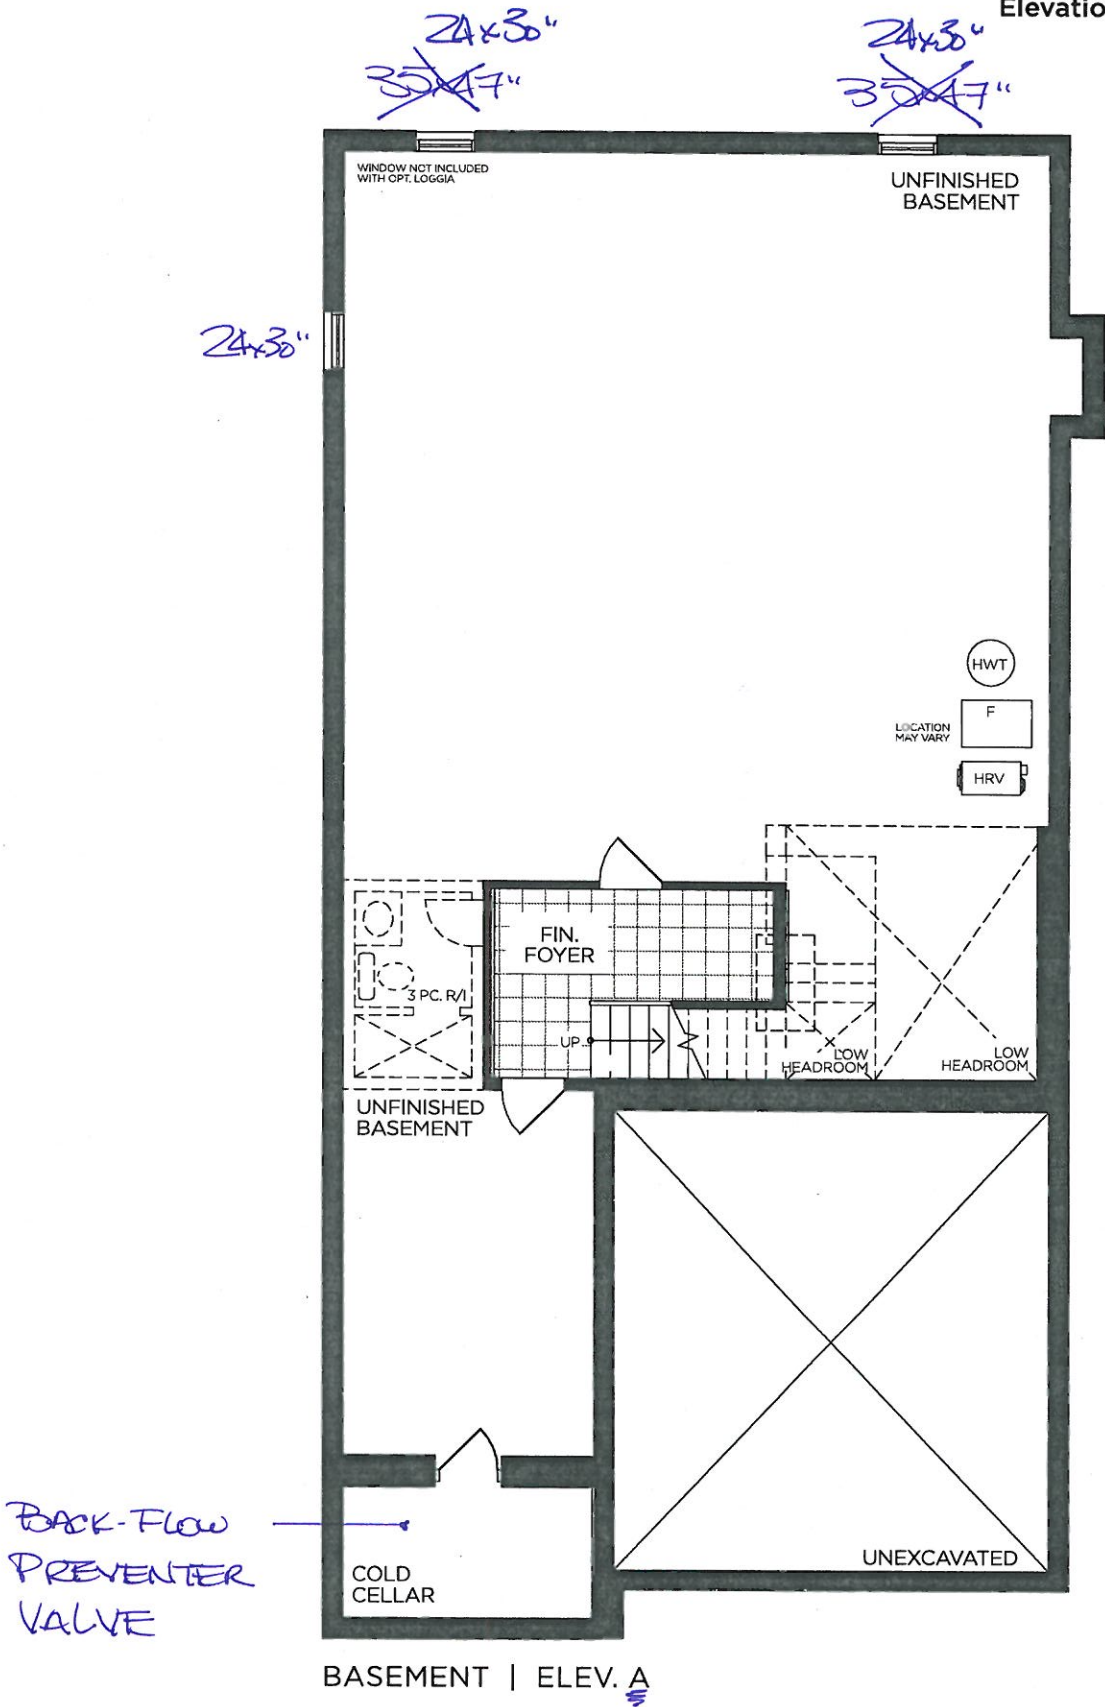

VENDOR

PURCHASER

PURCHASER

GOLDPARK
WORTH MORE™

Prices, figures, illustrations, sizes, features and finishes are subject to change without notice. Areas and dimensions are approximate and actual usable floor space may vary from the stated area. Layout may be reverse of the unit purchased. E. & O.E. 4003




SCHEDULE 'F'

JUNE 15 2020
PV-116
APRIL 1 2020

The Brookside
40' SERIES

Elevation A • 3,380 sq.ft.
Elevation B • 3,350 sq.ft.

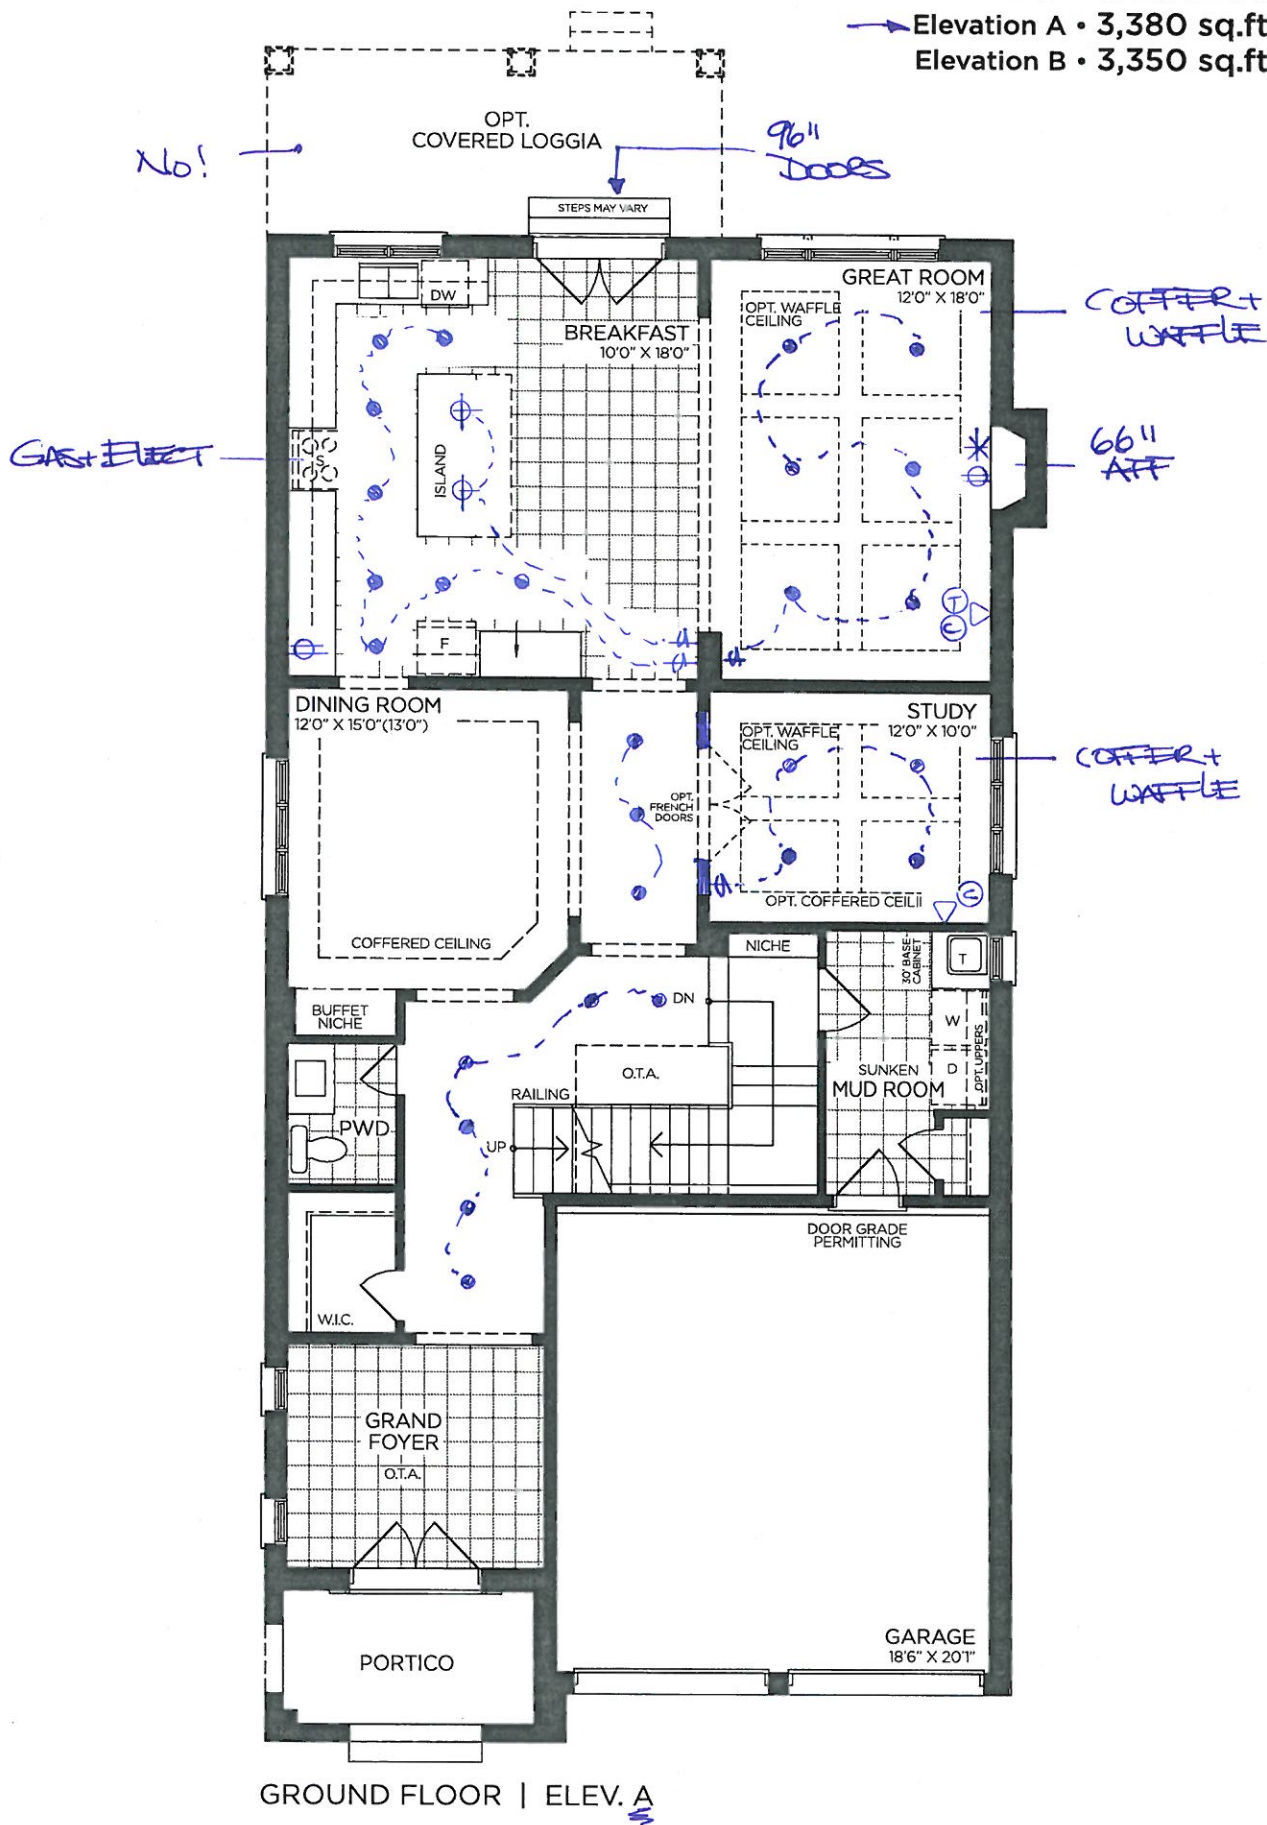

VENDOR

PURCHASER

PURCHASER

GOLDPARK
WORTH MORE™


Prices, figures, illustrations, sizes, features and finishes are subject to change without notice. Areas and dimensions are approximate and actual usable floor space may vary from the stated area. Layout may be reverse of the unit purchased. E. & O.E. 4003

SCHEDULE 'F'

The Brookside
40' SERIES

Elevation A • 3,380 sq.ft.
Elevation B • 3,350 sq.ft.

JUNE 15 2020
PV-116
April 1 2020

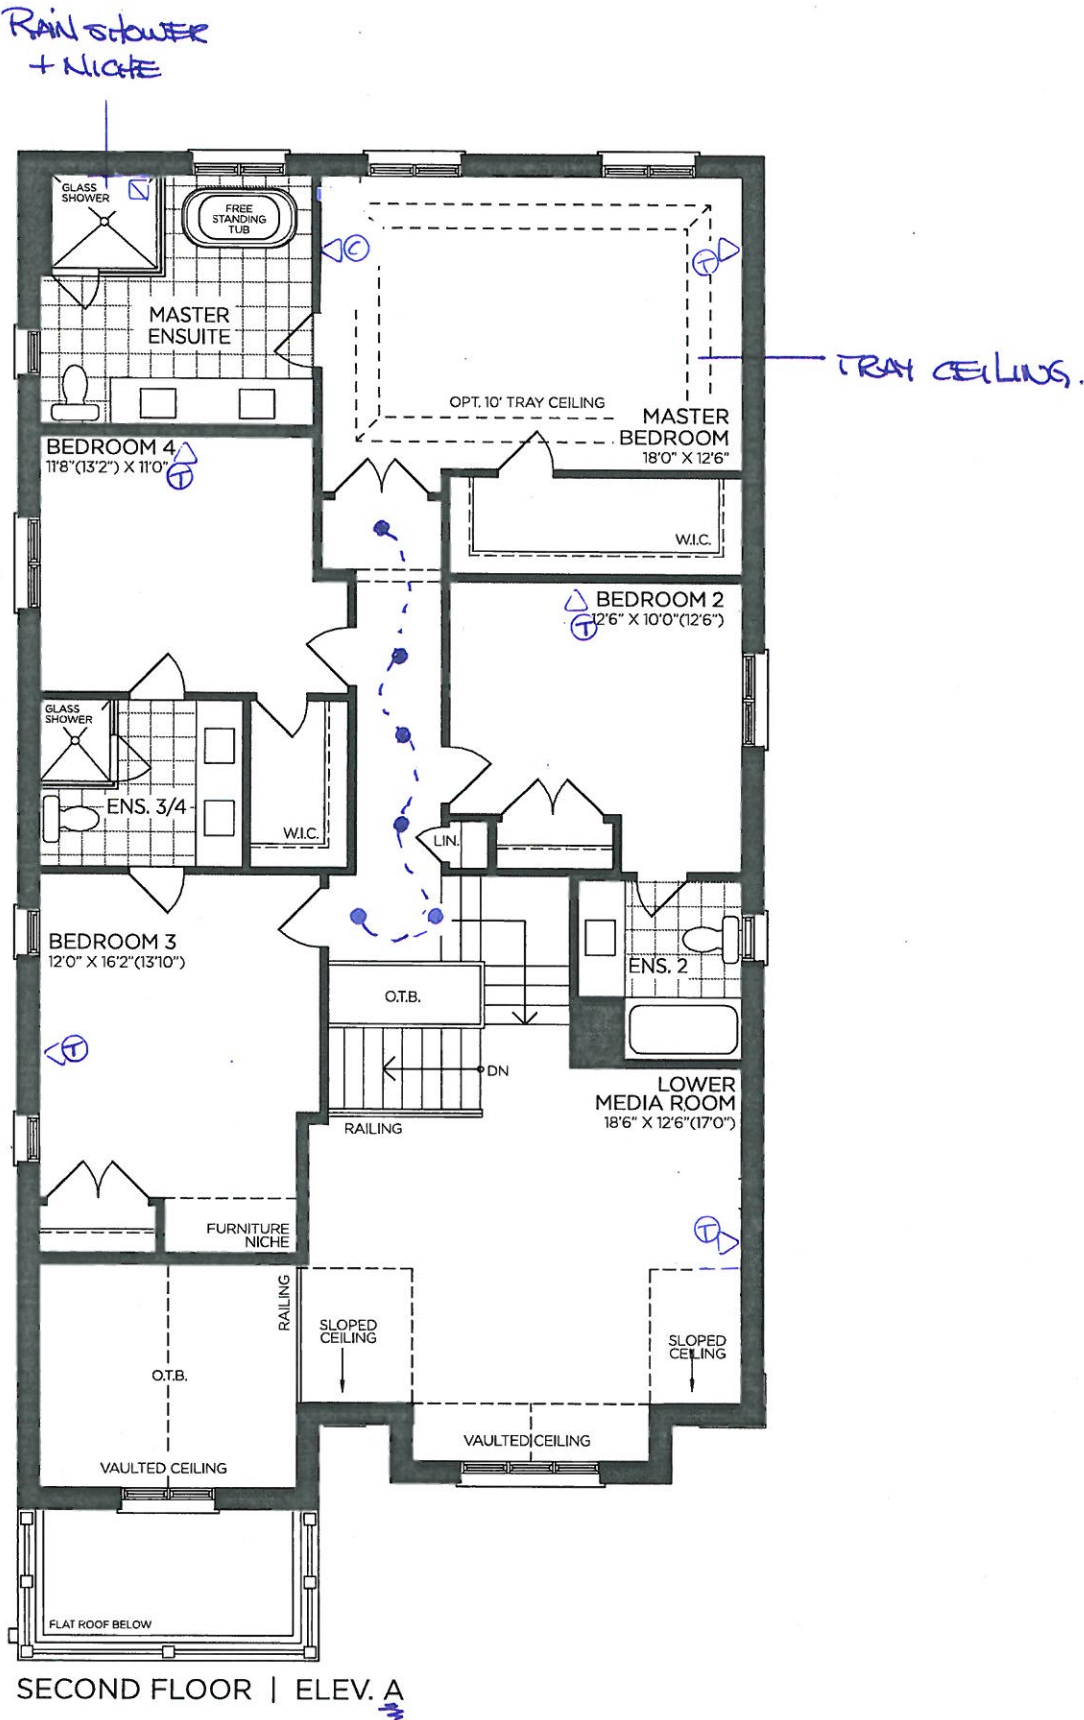

SECOND FLOOR | ELEV. A

VENDOR	
PURCHASER	
PURCHASER	

GOLDPARK
WORTH MORE™

Prices, figures, illustrations, sizes, features and finishes are subject to change without notice. Areas and dimensions are approximate and actual usable floor space may vary from the stated area. Layout may be reverse of the unit purchased. E. & O.E. 4003

POSI-TEMP SHOWER ONLY* W/3 FUNCTION TRANSFER VALVE
TRIM AND SLIDE BAR W/HAND SHOWER

MOEN - ARRIS



- ☒ CHROME
- ☐ BRUSHED NICKEL
- ☐ MATTE BLACK
- ☐ from WALL
- ☒ from CEILING

MODEL TS22002EP / 3372 / TS23005 / 62320 / 3887EP / A725

Lot# 116	
Room: MASTER ENSUITE	Signature:
Date: JUNE 15 2020	Signature: