



DRYWALL

Invoice	Qty.	Description
2374  19Jun20 NoCat	3	.BREAKFAST ROOM: UPGRADE EXTERIOR GARDEN DOOR ASSEMBLY TO 96" TALL
2374  19Jun20 NoCat	1	.BREAKFAST: - OPT. COFFERED CEILING AS PER PLAN
2374  19Jun20 NoCat	1	.BREAKFAST ROOM: - OPT. WAFFLE CEILING, BEAM DETAIL AS PER PLAN (6 BOXES) OPTION # 1 CTR-B07
2374  19Jun20 NoCat	1	.GREAT ROOM - OPT. COFFERED CEILING AS PER PLAN
2374  19Jun20 NoCat	1	.GREAT ROOM - OPT. WAFFLE CEILING, BEAM DETAIL AS PER PLAN (9 BOXES) OPTION # 1 CTR-B07
2374  19Jun20 NoCat	1	.LIBRARY PART. OPT. GROUND FLOOR - OPT. COFFERED CEILING DETAIL AS PER PLAN
2374  19Jun20 NoCat	1	.LIBRARY PART. OPT. GROUND FLOOR - OPT.WAFFLE CEILING DETAIL, BEAM DETAIL AS PER PLAN (4 BOXES) OPTION # 1 CTR-B07
2374  19Jun20 NoCat	1	.MASTER BEDROOM - OPT. 10 FOOT TRAY CEILING AS PER PLAN







GOLDPARK

WORTH MORE™

CONSTRUCTION SUMMARY

Lot: 131

Model: 42.04 A BROOKVALLEY

Project/Phase: Pine Valley Forevergreen / 1

GLASS AND MIRROR

Invoice	Qty.	Description
2374  19Jun20 NoCat	1	MASTER ENSUITE: ADD 2ND SEPARATE SHOWER

HVAC

Invoice	Qty.	Description
2374 72,224 19Jun20	1	KITCHEN: GAS LINE ROUGH-IN - MAIN FLOOR FOR APPLIANCE - SEE PLAN

INTERIOR TRIM AND DOORS

Invoice	Qty.	Description
2374  19Jun20 NoCat	1	.BREAKFAST: - OPT. COFFERED CEILING AS PER PLAN
2374  19Jun20 NoCat	1	.BREAKFAST ROOM: - OPT. WAFFLE CEILING, BEAM DETAIL AS PER PLAN (6 BOXES) OPTION # 1 CTR-B07
2374  19Jun20 NoCat	1	.GREAT ROOM - OPT. COFFERED CEILING AS PER PLAN
2374  19Jun20 NoCat	1	.GREAT ROOM - OPT. WAFFLE CEILING, BEAM DETAIL AS PER PLAN (9 BOXES) OPTION # 1 CTR-B07
2374  19Jun20 NoCat	1	.LIBRARY PART. OPT. GROUND FLOOR - OPT. COFFERED CEILING DETAIL AS PER PLAN
2374  19Jun20 NoCat	1	.LIBRARY PART. OPT. GROUND FLOOR - OPT.WAFFLE CEILING DETAIL, BEAM DETAIL AS PER PLAN (4 BOXES) OPTION # 1 CTR-B07
2374  19Jun20 NoCat	1	.MASTER BEDROOM - OPT. 10 FOOT TRAY CEILING AS PER PLAN


NETWORK AND WIRING

Invoice	Qty.	Description
2374 72,259 19Jun20	1	.GREAT ROOM: CONDUIT PIPE - FOR WALL MOUNT TV - LOCATE APPROX 66" A.F.F. ABOVE FIREPLACE, THRU BASEMENT TERMINATING AT CABLE LOCATION - SEE PLAN FOR LOCATION

DisciplineMS.rpt 26jun20

Page 6 of 8  
Printed and Sent: 22-Jul-20





CONSTRUCTION SUMMARY

Lot: 131

Model: 42.04 A BROOKVALLEY

Project/Phase: Pine Valley Forevergreen / 1

PLUMBING FIXTURES		
Invoice	Qty.	Description
2374  19Jun20 NoCat	1	MOEN `ARRIS` POSI-TEMP 3-FUNCTION RAIN SHOWER (from ceiling) + HAND SHOWER + SLIDE BAR - CHROME #TS22002EP/3372/TS23005/62320/3887EP/A725

WINDOWS - BASEMENT		
Invoice	Qty.	Description
2261 72,351 19Jun20	1	.BASEMENT WINDOWS - UPGRADE BASEMENT WINDOW SIZE TO 30 " X 24" - 8" FRAME
2374 72,672 19Jun20	-2	** DELETE BASEMENT WINDOWS - EGRESS BASEMENT WINDOW 47 " X 35" - 8" FRAME  DELETE FROM ORDER PE#2261
2374 72,351 19Jun20	2	.BASEMENT WINDOWS - UPGRADE BASEMENT WINDOW SIZE TO 30 " X 24" - 8" FRAME

WINDOWS AND DOORS		
Invoice	Qty.	Description
2374  19Jun20 NoCat	3	.BREAKFAST ROOM: UPGRADE EXTERIOR GARDEN DOOR ASSEMBLY TO 96" TALL




SCHEDULE 'F'



PV-131  
April 1 2020  
\*REVISED\* June 18 2020

The Brookvalley  
42' SERIES

Elevation A • 3,665 sq.ft.  
Elevation B • 3,705 sq.ft.

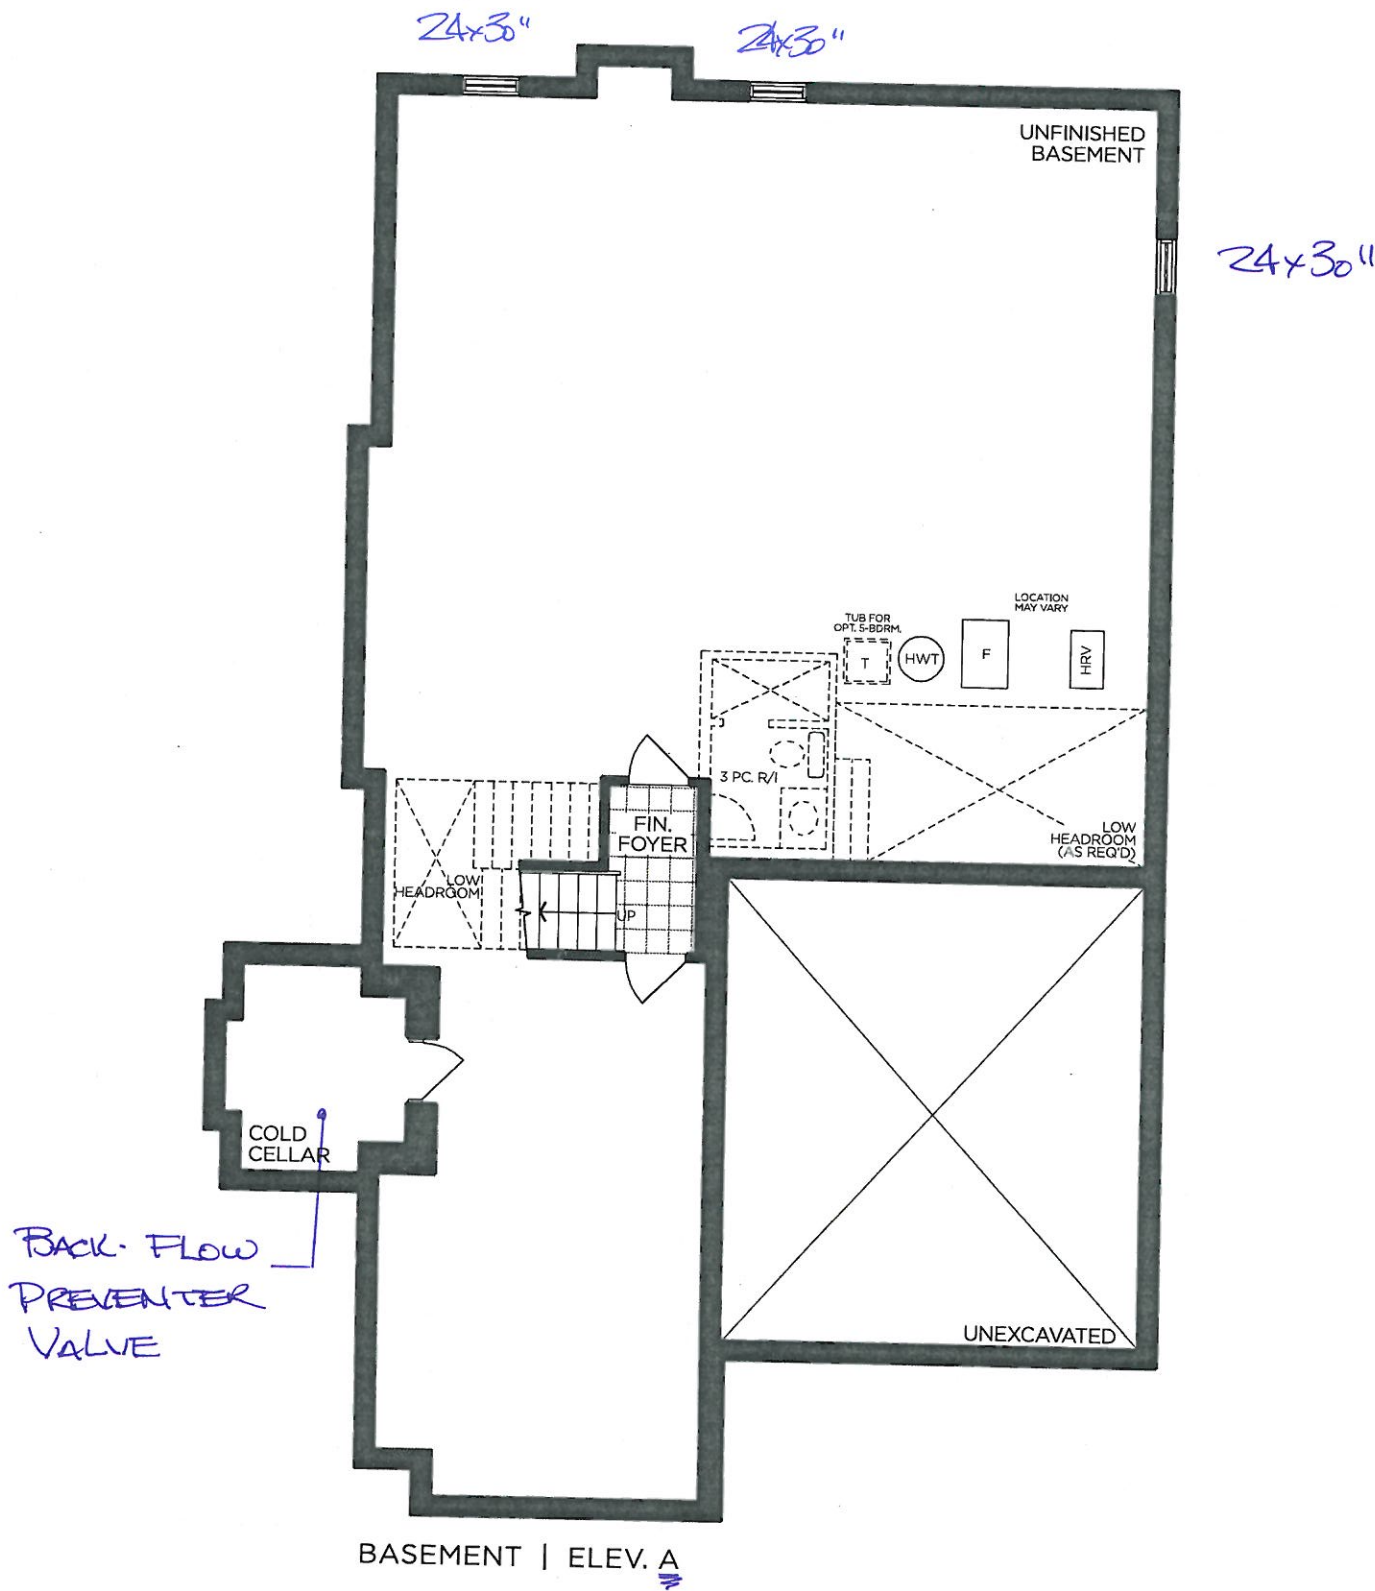

VENDOR

PURCHASER

PURCHASER

GOLDPARK  
WORTH MORE™

Prices, figures, illustrations, sizes, features and finishes are subject to change without notice. Areas and dimensions are approximate and actual usable floor space may vary from the stated area. Layout may be reverse of the unit purchased. E. & O.E. 4204


# SCHEDULE 'F'



TV-131  
APRIL 1 2020  
JUNE 18 2020

## The Brookvalley 42' SERIES

Elevation A • 3,665 sq.ft.  
Elevation B • 3,705 sq.ft.

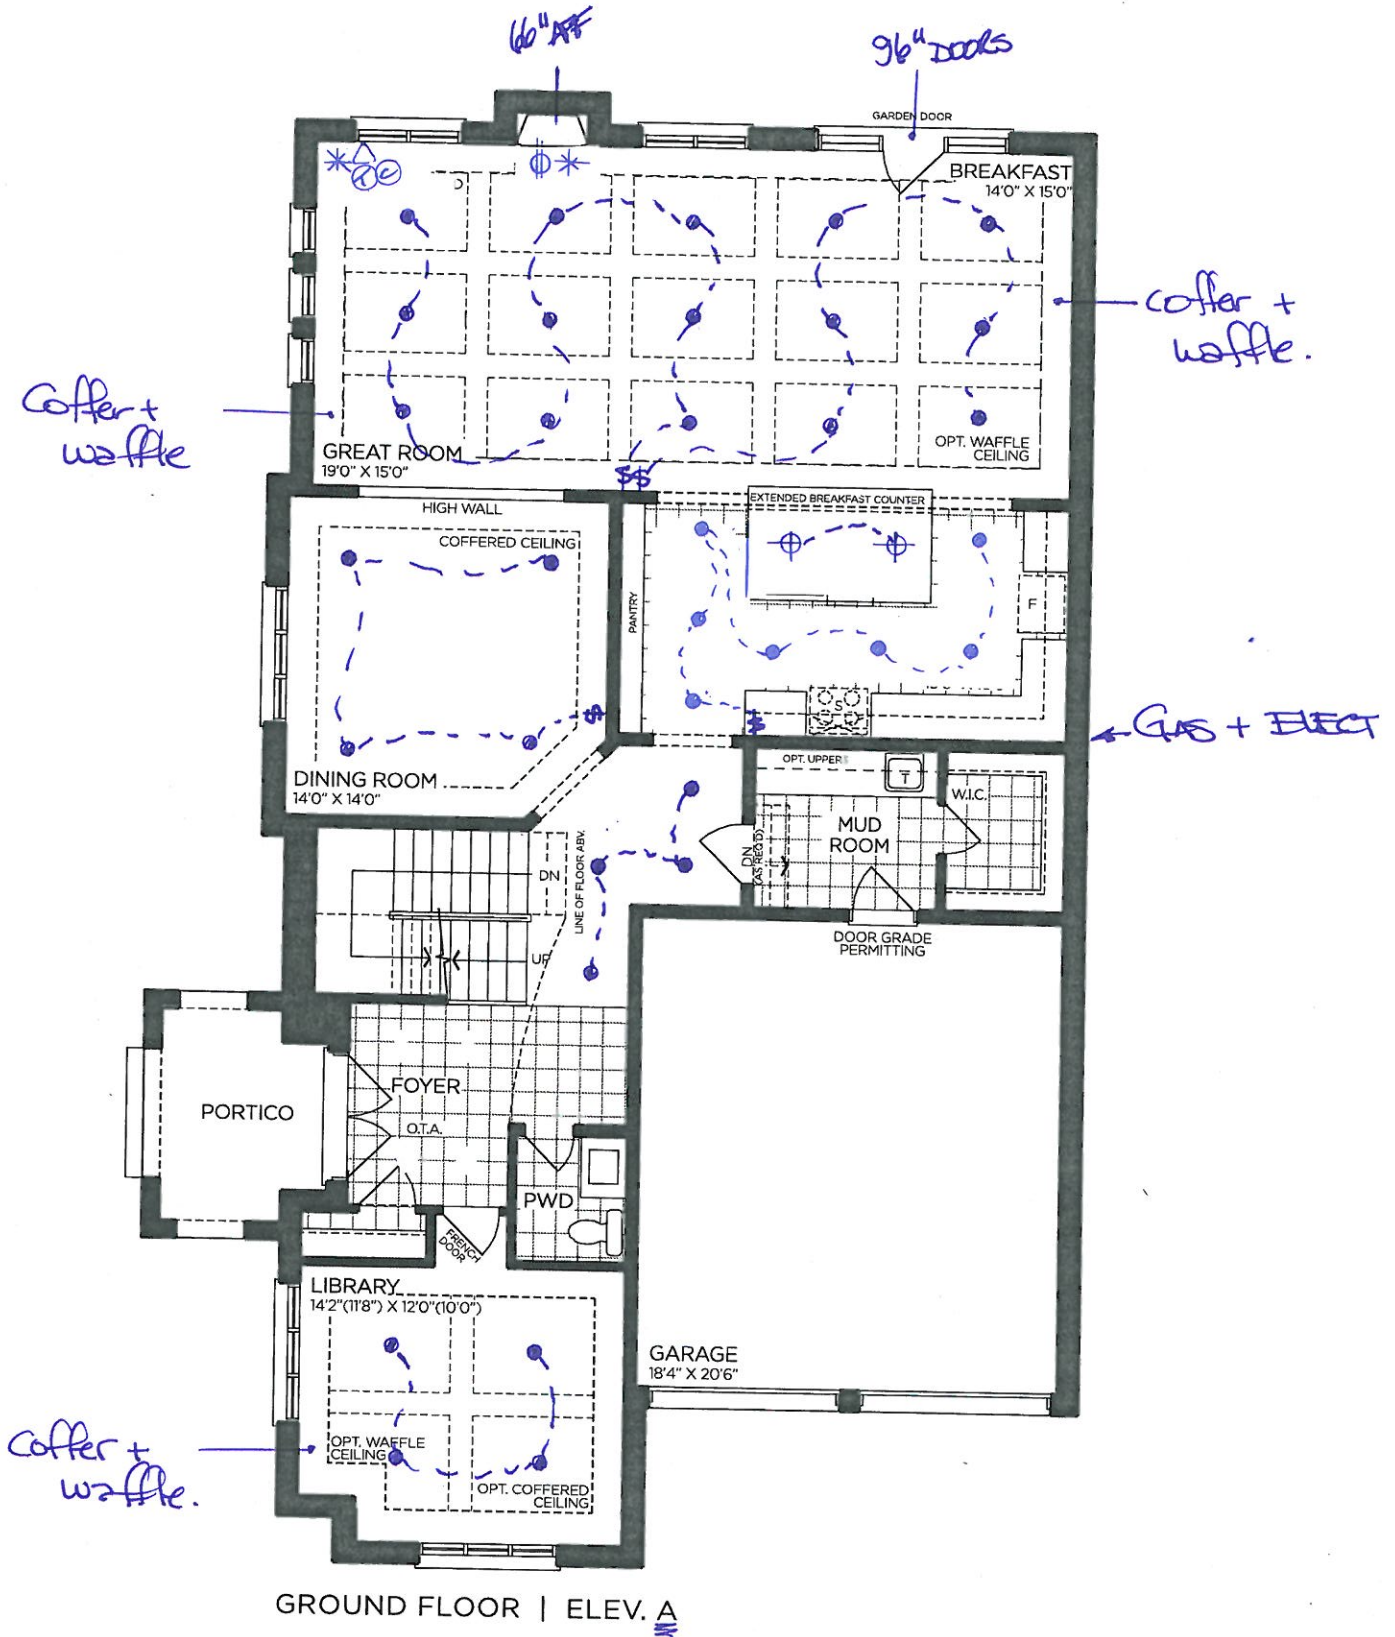

VENDOR

PURCHASER

PURCHASER

**GOLDPARK**  
WORTH MORE™

Prices, figures, illustrations, sizes, features and finishes are subject to change without notice. Areas and dimensions are approximate and actual usable floor space may vary from the stated area. Layout may be reverse of the unit purchased. E. & O.E. 4204


SCHEDULE 'F'



PV-131  
April 1 2020  
June 18 2020

The Brookvalley  
42' SERIES

Elevation A • 3,665 sq.ft.  
Elevation B • 3,705 sq.ft.

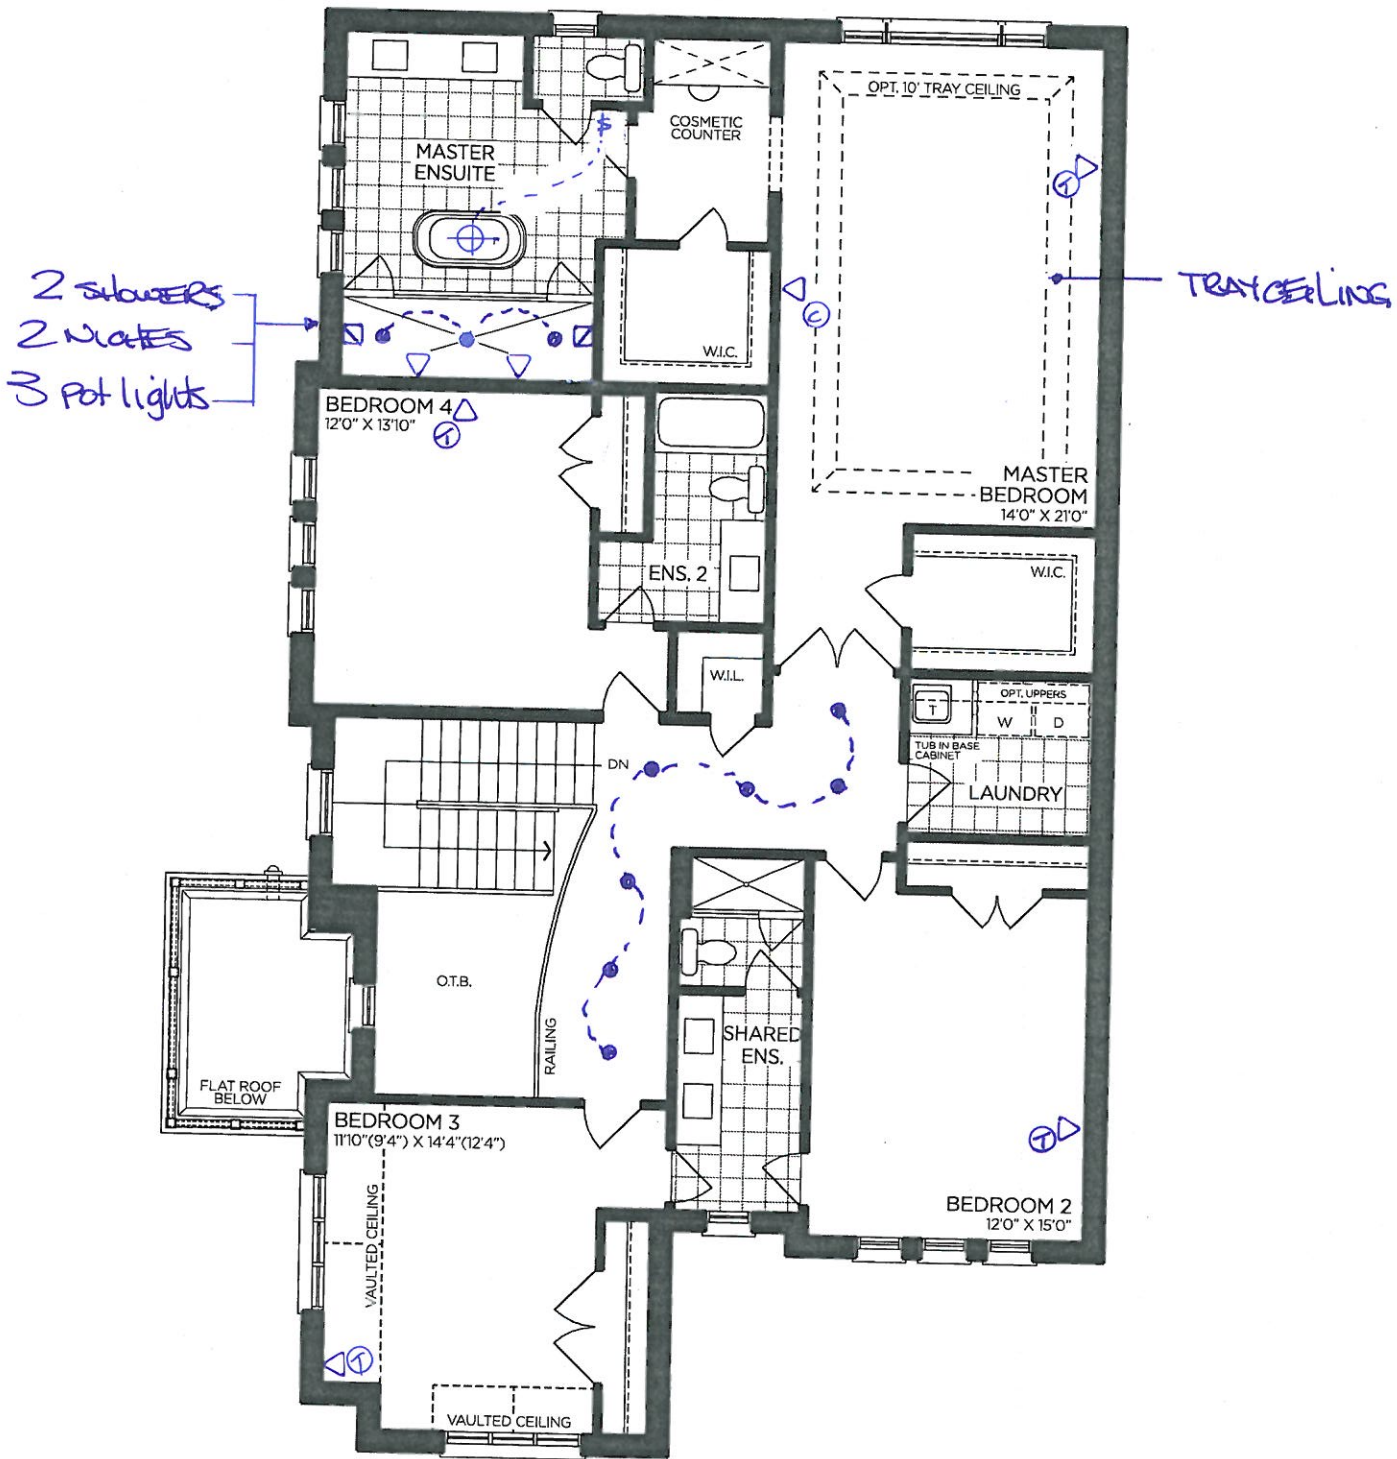

SECOND FLOOR | ELEV. A

VENDOR

PURCHASER

PURCHASER

GOLDPARK  
WORTH MORE™

Prices, figures, illustrations, sizes, features and finishes are subject to change without notice. Areas and dimensions are approximate and actual usable floor space may vary from the stated area. Layout may be reverse of the unit purchased. E. & O.E. 4204