

GOLDPARK

WORTH MORE™

CONSTRUCTION SUMMARY

Lot: 130

Model: 40.02 A VALLEYVIEW

Project/Phase: Pine Valley Forevergreen / 1

CERAMIC		
Invoice	Qty.	Description
2358	1	**CUSTOM LAYOUT** MASTER ENSUITE: REVERSE LOCATION OF VANITY/SHOWER. VANITY TO BE ON WALL BACKING BEDROOM, SHOWER TO BE APPROX 42X80" & HAVE GLASS AT FRONT ONLY
22Jul20 NoCat		

CONCRETE AND DRAIN		
Invoice	Qty.	Description
2288	1	BACK-FLOW PREVENTER VALVE
22Jul20 NoCat		

CROWN MOULDING		
Invoice	Qty.	Description
2358	1	.BREAKFAST ROOM - OPT. COFFERED CEILING AS PER PLAN
22Jul20 NoCat		
2358	1	.GREAT ROOM - OPT. COFFERED CEILING AS PER PLAN
22Jul20 NoCat		

DRYWALL		
Invoice	Qty.	Description
2358	1	.BREAKFAST ROOM - OPT. COFFERED CEILING AS PER PLAN
22Jul20 NoCat		
2358	1	.GREAT ROOM - OPT. COFFERED CEILING AS PER PLAN
22Jul20 NoCat		
2358	1	**CUSTOM LAYOUT** LAUNDRY ROOM: DELETE CLOSET, CREATE OPEN SPACE - LEAVE NIBB WALL AT CABINETRY
22Jul20 NoCat		
2358	1	**CUSTOM LAYOUT** DELETE CLOSET AT BEDROOM 3 - COMBINE REACH IN CLOSETS TO CREATE 1 WALK-IN CLOSET ACCESSIBLE FROM BEDROOM 2- SEE PLAN FOR LOCATION
22Jul20 NoCat		
2358	1	**CUSTOM LAYOUT** MASTER ENSUITE: ADD WATER CLOSET (approx 36x66" inside), COMPLETE WITH PARTITION WALLS, DOOR, LIGHT AND FAN - CENTER TOILET IN WATER CLOSET
22Jul20 NoCat		
2358	1	.FOYER: REDUCE SIZE OF DOUBLE DOOR CLOSET, LEAVING APPROX 60" OPEN SPACE BESIDE - SEE PLAN FOR LOCATION
22Jul20 NoCat		

DisciplineMS.rpt 26jun20

Page 1 of 7
Printed and Sent: 22-Jul-20

**Lot: 130****Model: 40.02 A VALLEYVIEW****Project/Phase: Pine Valley Forevergreen / 1**

ELECTRICAL

Invoice	Qty.	Description
2358 72,289 22Jul20	4	.BREAKFAST ROOM: 4" E/S LED INTERIOR POT LIGHT - GROUND FLOOR - EACH
2358 72,278 22Jul20	1	.BREAKFAST: ADDITIONAL INTERIOR SWITCH FOR POTLIGHTS **SEE PLAN FOR PREFERRED SWITCH LOCATION
2358 72,280 22Jul20	1	.KITCHEN: CEILING OUTLET: ADDITIONAL REINFORCED CEILING OUTLET - LOCATE APPROX CENTERED ABOVE ISLAND - USE SAME SWITCH AS STANDARD LIGHT
2358 22Jul20 NoCat	1	**CUSTOM LAYOUT** MASTER ENSUITE: ADD WATER CLOSET (approx 36x66" inside), COMPLETE WITH PARTITION WALLS, DOOR, LIGHT AND FAN - CENTER TOILET IN WATER CLOSET
2358 22Jul20 NoCat	1	**CUSTOM LAYOUT** MASTER ENSUITE: REVERSE LOCATION OF VANITY/SHOWER. VANITY TO BE ON WALL BACKING BEDROOM, SHOWER TO BE APPROX 42X80" & HAVE GLASS AT FRONT ONLY

EXTERIOR COLOURS

Invoice	Qty.	Description
2358	1	EXTERIOR COLOUR PACKAGE # BR.4
22Jul20 NoCat		

FORMING

Invoice	Qty.	Description
2288 22Jul20 NoCat	2	.BASEMENT WINDOWS - UPGRADE BASEMENT WINDOW SIZE TO 30 " X 24" - 8" FRAME
2312 72,672 22Jul20	2	**DELETE** BASEMENT WINDOWS - EGRESS BASEMENT WINDOW 47 " X 35" - 8" FRAME DELETE FROM PREVIOUS ORDER
2312 22Jul20 NoCat	2	.BASEMENT WINDOWS - UPGRADE BASEMENT WINDOW SIZE TO 30 " X 24" - 8" FRAME (REAR WINDOWS)



CONSTRUCTION SUMMARY

Lot: 130

Model: 40.02 A VALLEYVIEW

Project/Phase: Pine Valley Forevergreen / 1

WINDOWS AND DOORS

Invoice	Qty.	Description
2358 22Jul20 NoCat	1	.BREAKFAST ROOM: UPGRADE EXTERIOR GARDEN DOOR ASSEMBLY TO 8`
2358 22Jul20 NoCat	1	.BREAKFAST ROOM: UPGRADE EXTERIOR GARDEN DOOR ASSEMBLY TO 8`

SCHEDULE 'F'




PV-130
JUNE 8 2020

See
attach.

The Valleyview 40' SERIES

→ Elevation A • 3,145 sq.ft.
Elevation B • 3,170 sq.ft.

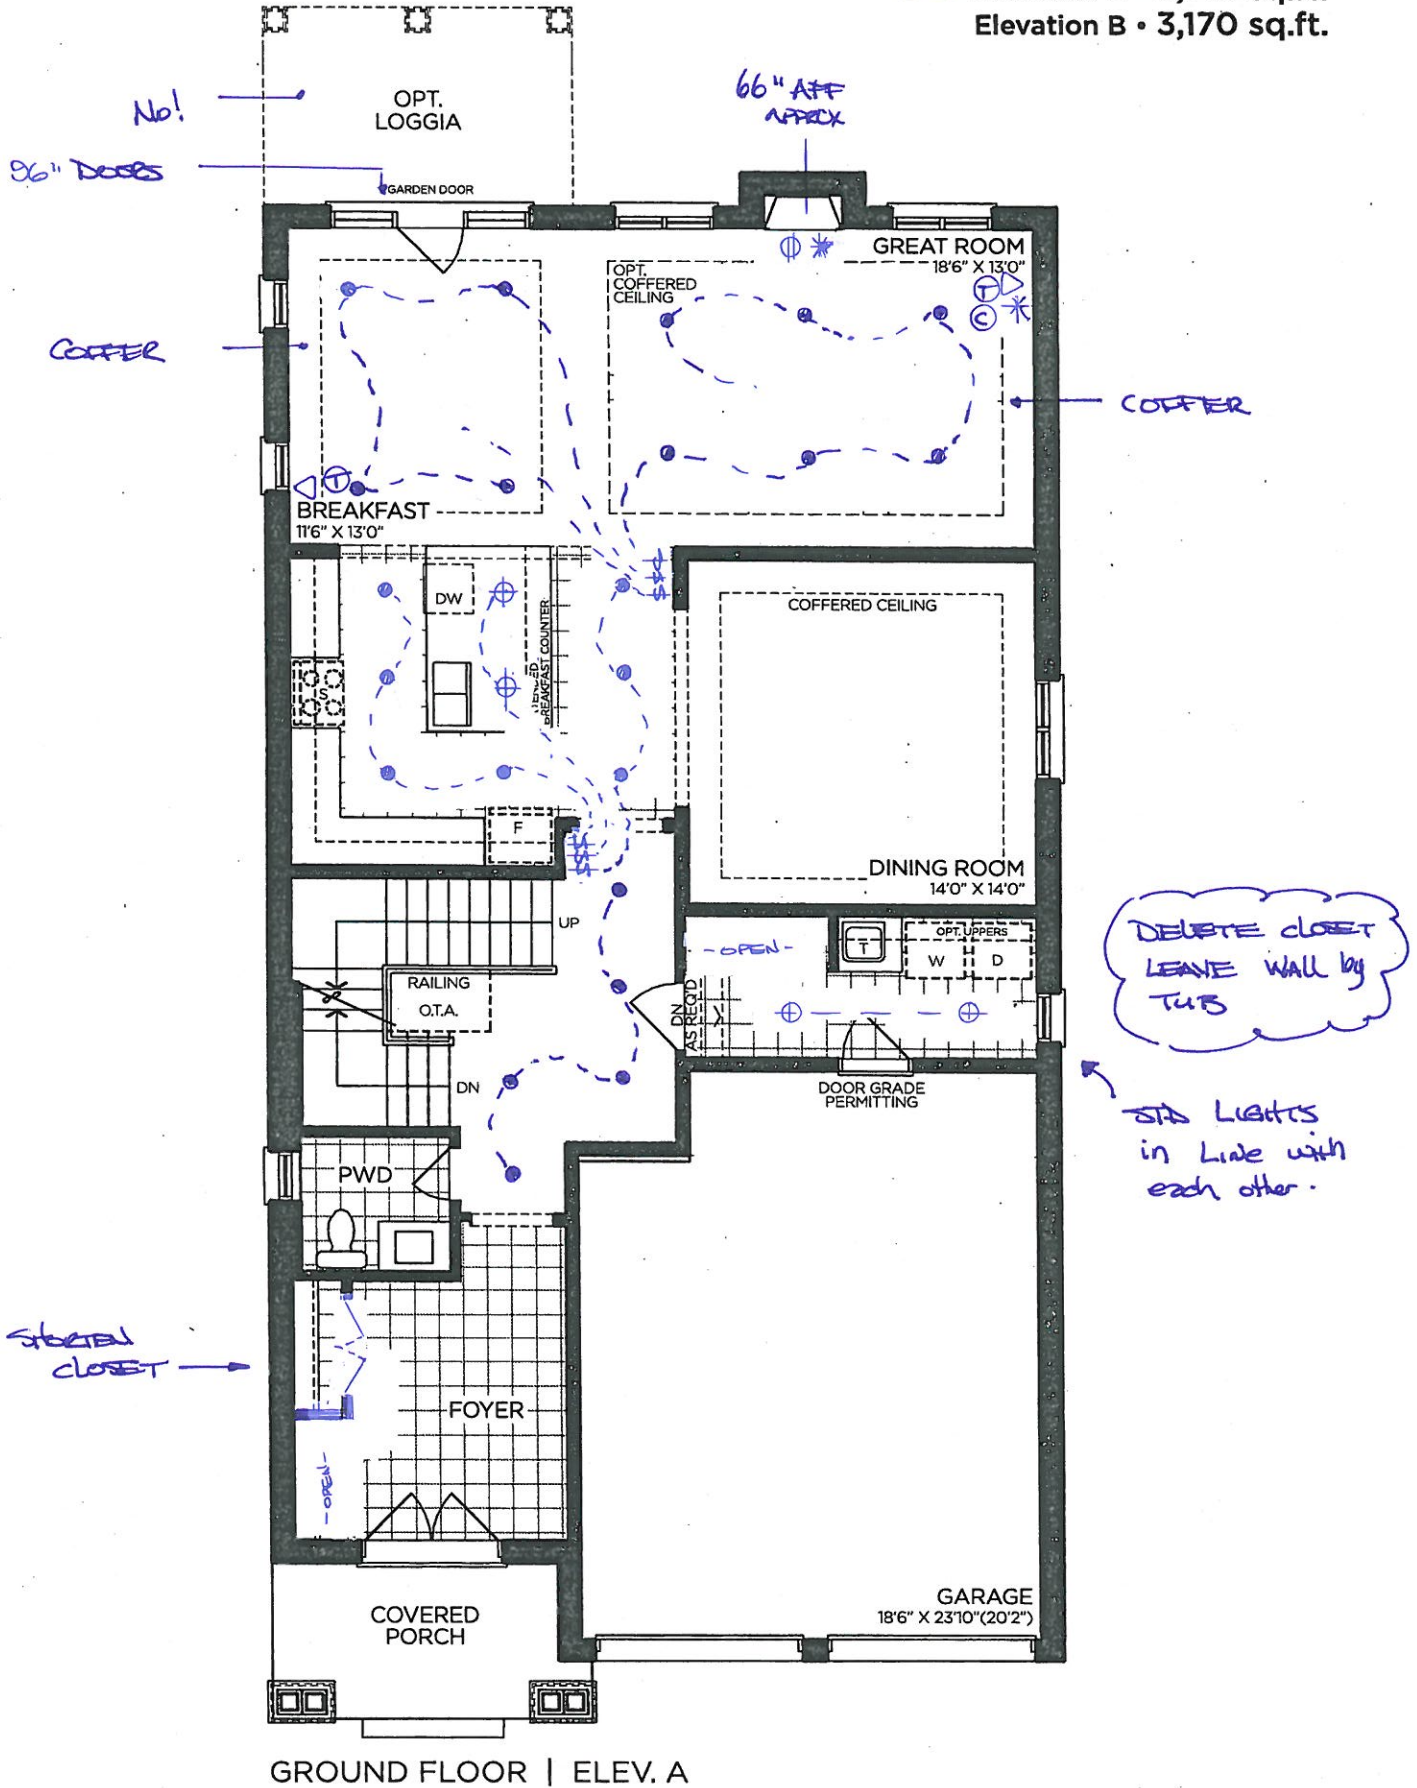

VENDOR

PURCHASER

PURCHASER

GOLDPARK
WORTH MORE™

Prices, figures, illustrations, sizes, features and finishes are subject to change without notice. Areas and dimensions are approximate and actual usable floor space may vary from the stated area. Layout may be reverse of the unit purchased. E. & O.E. 4002

SCHEDULE 'F'




PV-130
JUNE 8 2020
See attach

The Valleyview 40' SERIES

→ Elevation A • 3,145 sq.ft.
Elevation B • 3,170 sq.ft.

*RELOCATE ↓
MAKE VANITY
SMALLER.*

*ADD: WATER CLOSET
Approx 36x66"
(CENTER TOILET).
RELOCATE
SHOWER APPROX
42x80"*

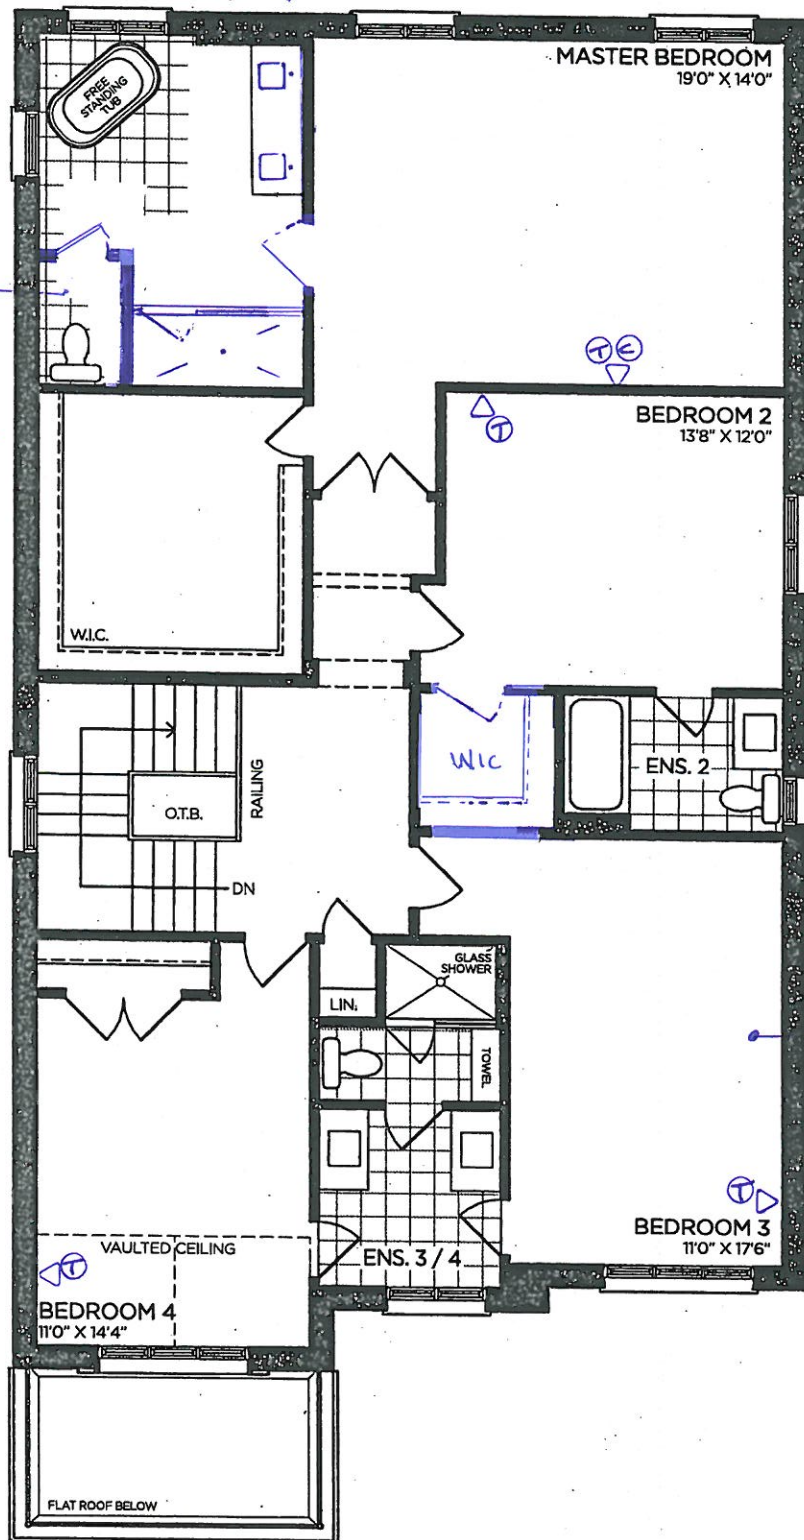

SECOND FLOOR | ELEV. A

VENDOR	
PURCHASER	
PURCHASER	

GOLDPARK
WORTH MORE™

Prices, figures, illustrations, sizes, features and finishes are subject to change without notice. Areas and dimensions are approximate and actual usable floor space may vary from the stated area. Layout may be reverse of the unit purchased. E. & O.E. 4002

SCHEDULE 'F'




PV-130
JUNE 8 2020
See attach

The Valleyview

40' SERIES

→ Elevation A • 3,145 sq.ft.
Elevation B • 3,170 sq.ft.

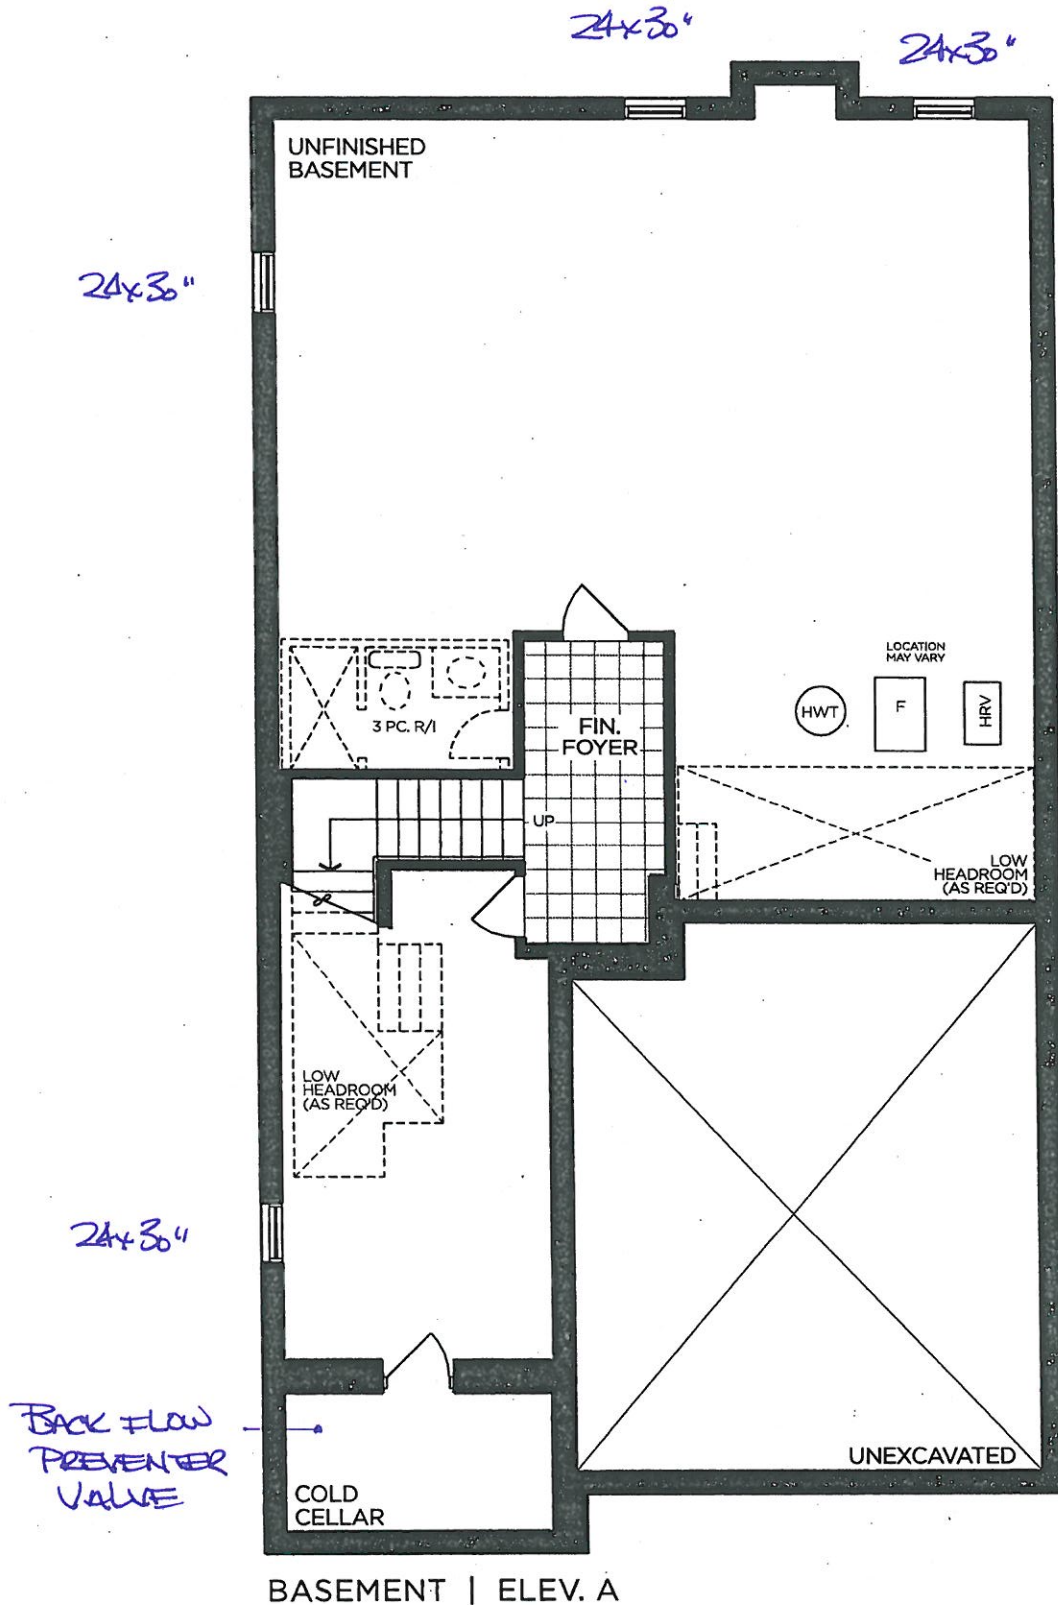

VENDOR

PURCHASER

PURCHASER

GOLDPARK

WORTH MORE™

Prices, figures, illustrations, sizes, features and finishes are subject to change without notice. Areas and dimensions are approximate and actual usable floor space may vary from the stated area. Layout may be reverse of the unit purchased. E. & O.E. 4002


SCHEDULE 'F'



PL-130
JUNE 8 2022

The Valleyview 40' SERIES

→ Elevation A • 3,145 sq.ft.
Elevation B • 3,170 sq.ft.

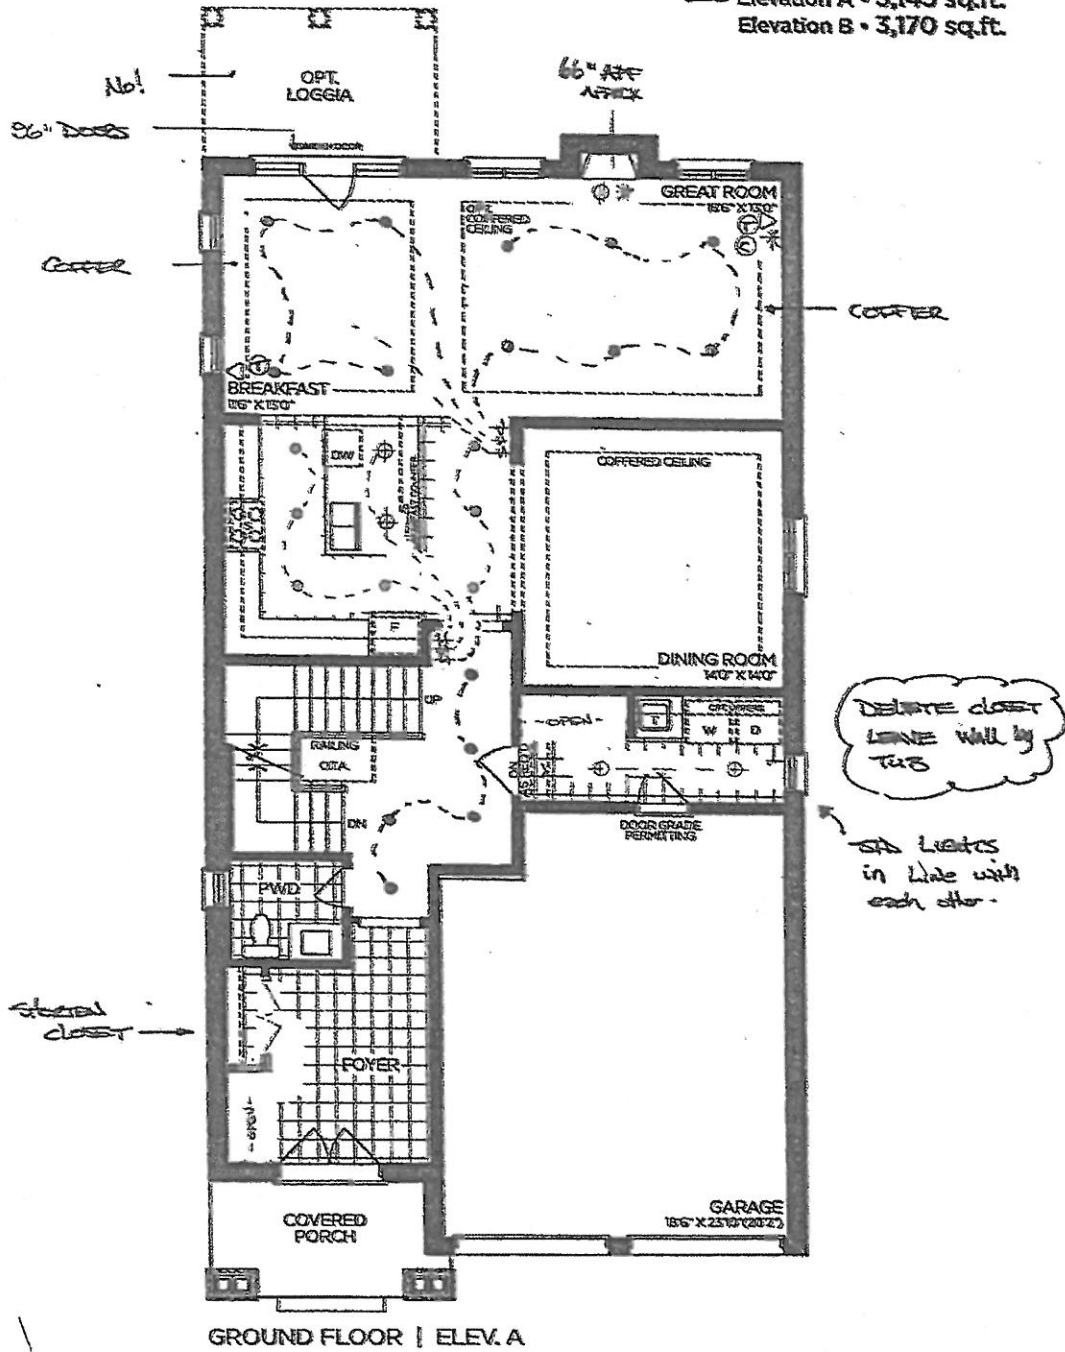

VENDOR
PURCHASER
PURCHASER

GOLDPARK
WORTH MORE™

Prices, figures, illustrations, sizes, features and finishes are subject to change without notice. Areas and dimensions are approximate and actual usable floor space may vary from the stated area. Layout may be reverse of the unit purchased. E & O.E. 4002



SCHEDULE 'F'


PV-130
JUNE 8 2020

The Valleyview 40' SERIES

→ Elevation A • 3,145 sq.ft.
Elevation B • 3,170 sq.ft.

RELOCATE ↓
MAKE VANITY
SMALLER.

ADD WATER CLOSET
APPROX 35x46"
(CONVERT TOILET).
RELOCATE
SHOWER APPROX
42x80" →

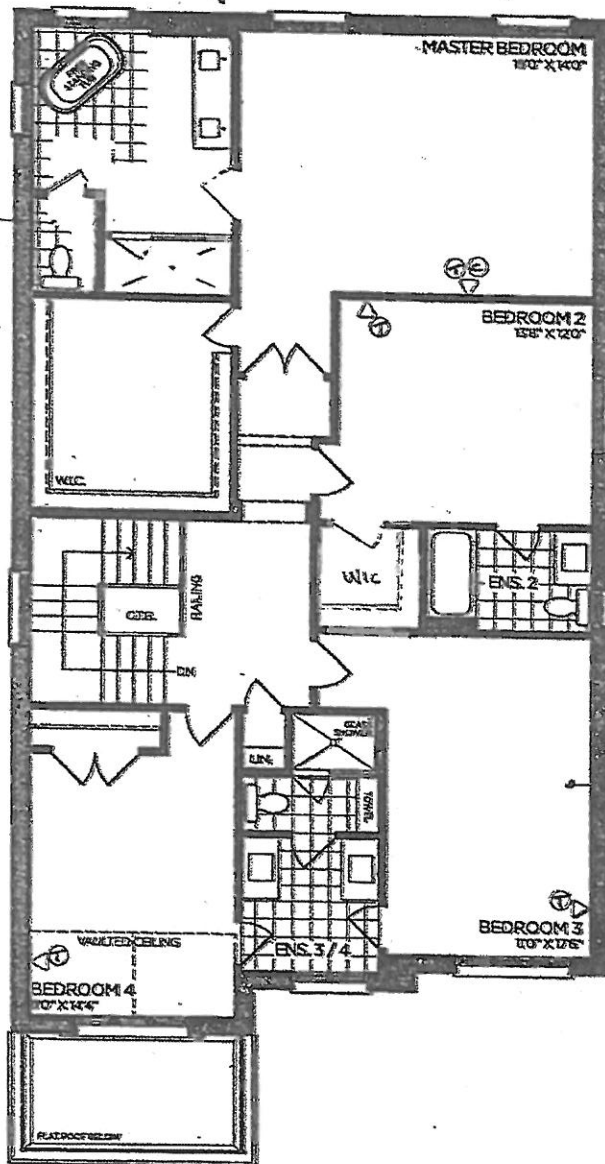

SECOND FLOOR | ELEV. A

VENDOR
PURCHASER
PURCHASER

GOLDPARK
WORTH MORE

Prices, figures, illustrations, sizes, features and finishes are subject to change without notice. Areas and dimensions are approximate and actual usable floor space may vary from the stated area. Layout may be reverse of the unit purchased. E. & O.E. 4002




SCHEDULE F

PV-130

June 8 2020

The Valleyview
40' SERIES

→ Elevation A • 3,145 sq.ft.
Elevation B • 3,170 sq.ft.

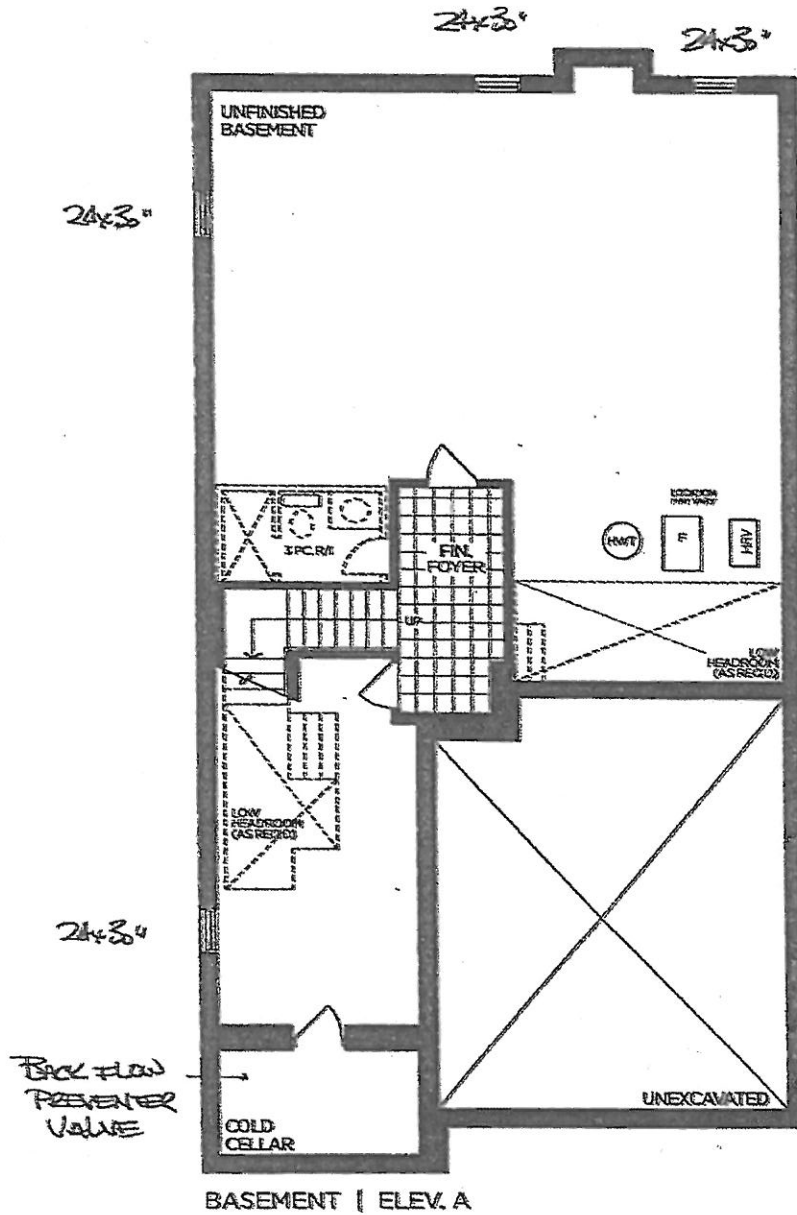

BASEMENT | ELEV. A

VENDOR _____
PURCHASER *BA* _____
PURCHASER *BA* _____

GOLDPARK
WORTH MORE

Prices, figures, illustrations, sizes, features and finishes are subject to change without notice. Areas and dimensions are approximate and actual usable floor space may vary from the stated area. Layout may be reverse of the unit purchased. E. & O.E. 4032