

GOLDPARK

WORTH MORE™

CONSTRUCTION SUMMARY

Lot: 120

Model: 40.02 B VALLEYVIEW

Project/Phase: Pine Valley Forevergreen / 1

CONCRETE AND DRAIN		
Invoice	Qty.	Description
2225	1	.BACK-FLOW PREVENTER VALVE
23Jul20 NoCat		

CROWN MOULDING		
Invoice	Qty.	Description
2376	1	.MASTER BEDROOM - OPT. 10 FOOT TRAY CEILING AS PER PLAN
23Jul20 NoCat		

DRYWALL		
Invoice	Qty.	Description
2376	1	.MASTER BEDROOM - OPT. 10 FOOT TRAY CEILING AS PER PLAN
23Jul20 NoCat		

ELECTRICAL		
Invoice	Qty.	Description
2295 72,307 23Jul20	1	.KITCHEN: FIXTURE: RELOCATE STANDARD CEILING MOUNT FIXTURE TO ABOVE ISLAND - SEE PLAN FOR LOCATION
2295 72,289 23Jul20	6	.KITCHEN: MAIN FLOOR: 4" E/S LED INTERIOR POT LIGHT - GROUND FLOOR - EACH (INCLUDES 1 SWITCH) INCLUDED IN APS

EXTERIOR COLOURS		
Invoice	Qty.	Description
2376	1	EXTERIOR COLOUR PACKAGE # BR.1
23Jul20 NoCat		

FORMING		
Invoice	Qty.	Description
2225	1	.OPTIONAL BASEMENT SERVICE STAIR
23Jul20 NoCat		
2225	1	.BASEMENT WINDOWS - EGRESS BASEMENT WINDOW 47 " X 35" - 8" FRAME
23Jul20 NoCat		

DisciplineMS.rpt 26jun20

Page 1 of 3
Printed and Sent: 23-Jul-20

**Lot: 120****Model: 40.02 B VALLEYVIEW****Project/Phase: Pine Valley Forevergreen / 1**

FRAMING

Invoice	Qty.	Description
2225 23Jul20 NoCat	1	.OPTIONAL BASEMENT SERVICE STAIR
2225 23Jul20 NoCat	1	.BASEMENT WINDOWS - EGRESS BASEMENT WINDOW 47 " X 35" - 8" FRAME
2376 72,403 23Jul20	1	.MASTER BEDROOM - OPT. 10 FOOT TRAY CEILING AS PER PLAN

INTERIOR TRIM AND DOORS

Invoice	Qty.	Description
2376 23Jul20 NoCat	1	.MASTER BEDROOM - OPT. 10 FOOT TRAY CEILING AS PER PLAN

NETWORK AND WIRING

Invoice	Qty.	Description
2295 72,260 23Jul20	1	CONDUIT PIPE - FROM ATTIC TO BASEMENT - FROM ELECTRICAL PANEL IN BASEMENT TO APPROX. CENTER OF ATTIC

PAINT

Invoice	Qty.	Description
2376	1	.MASTER BEDROOM - OPT. 10 FOOT TRAY CEILING AS PER PLAN
23Jul20 NoCat		

PLUMBING

Invoice	Qty.	Description
2225 23Jul20 NoCat	1	.BACK-FLOW PREVENTER VALVE

STAIRS AND RAILINGS

Invoice	Qty.	Description
2225	1	.OPTIONAL BASEMENT SERVICE STAIR
23Jul20 NoCat		

WINDOWS - BASEMENT

Invoice	Qty.	Description
2225 72,672 23Jul20	1	.BASEMENT WINDOWS - EGRESS BASEMENT WINDOW 47 " X 35" - 8" FRAME



CONSTRUCTION SUMMARY

Lot: 120

Model: 40.02 B VALLEYVIEW

Project/Phase: Pine Valley Forevergreen / 1

WINDOWS AND DOORS

Invoice	Qty.	Description
2295 23Jul20 NoCat	1	THRU OUT: UPGRADE WINDOWS TO BLACK INTERIOR

SCHEDULE 'F'



The Valleyview
40' SERIES

Elevation A • 3,145 sq.ft.

Elevation B • 3,170 sq.ft.


JUNE 19 2020

JUNE 4 2020

PV-120
MARKED 17 2020

See attached.

No!

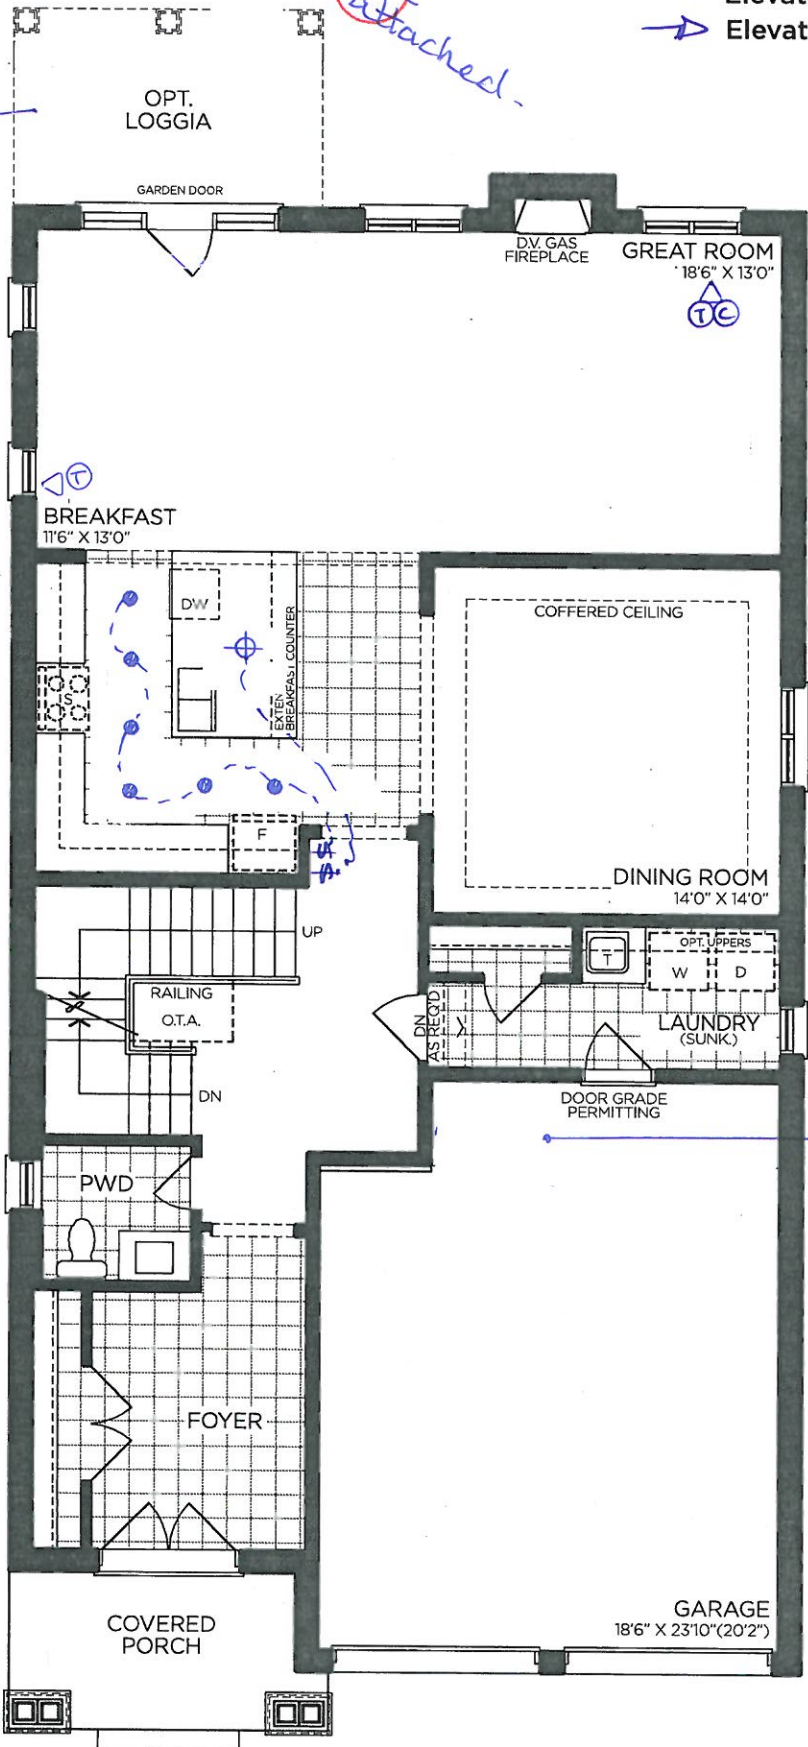

GROUND FLOOR | ELEV. A

Black
Interior
Windows

SERVICE
STAIRS.

VENDOR

PURCHASER

PURCHASER

GOLDPARK
WORTH MORE™

Prices, figures, illustrations, sizes, features and finishes are subject to change without notice. Areas and dimensions are approximate and actual usable floor space may vary from the stated area. Layout may be reverse of the unit purchased. E. & O.E. 4002


SCHEDULE 'F'



The Valleyview
40' SERIES

Elevation A • 3,145 sq.ft.
Elevation B • 3,170 sq.ft.

PV-120
March 17 2020 *see attached*
June 4 2020 *see attached*
June 19 2020 *see attached*

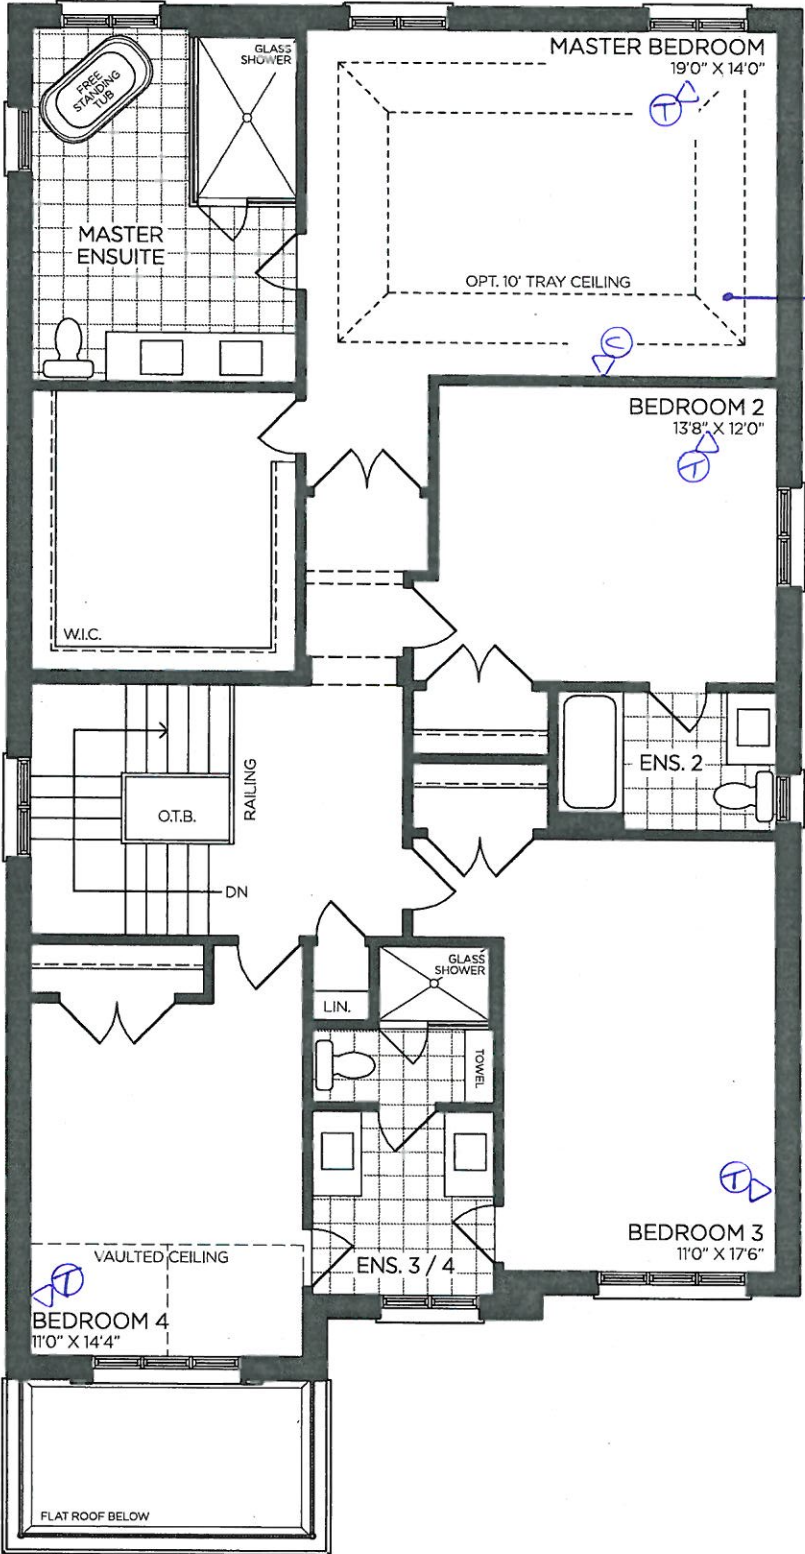

SECOND FLOOR | ELEV. A

VENDOR

PURCHASER

PURCHASER

GOLDPARK
WORTH MORE™

Prices, figures, illustrations, sizes, features and finishes are subject to change without notice. Areas and dimensions are approximate and actual usable floor space may vary from the stated area. Layout may be reverse of the unit purchased. E. & O.E. 4002

SCHEDULE 'F'




PV-120 ~~see attached~~
MAR 17 2020

JUNE 4 2020 ~~see attached~~
JUNE 19 2020 ~~see attached~~


The Valleyview
40' SERIES

Elevation A • 3,145 sq.ft.
→ Elevation B • 3,170 sq.ft.


YES!

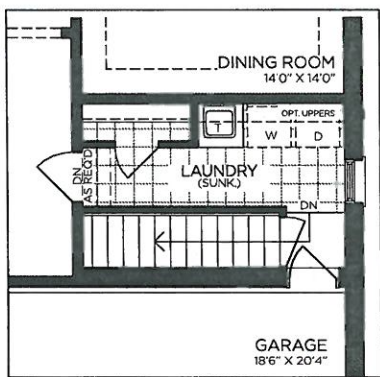


PART. GROUND FLOOR
OPT. SERVICE STAIR

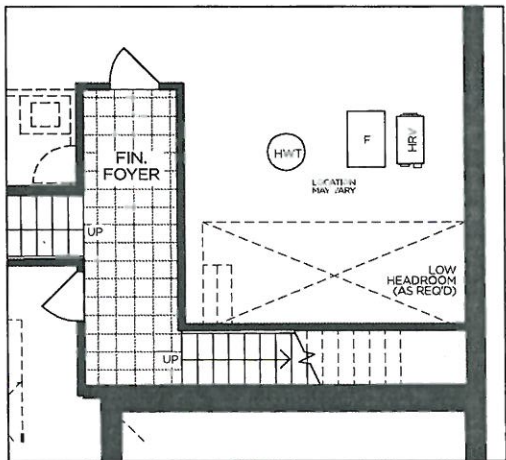


PART. BASEMENT
OPT. SERVICE STAIR

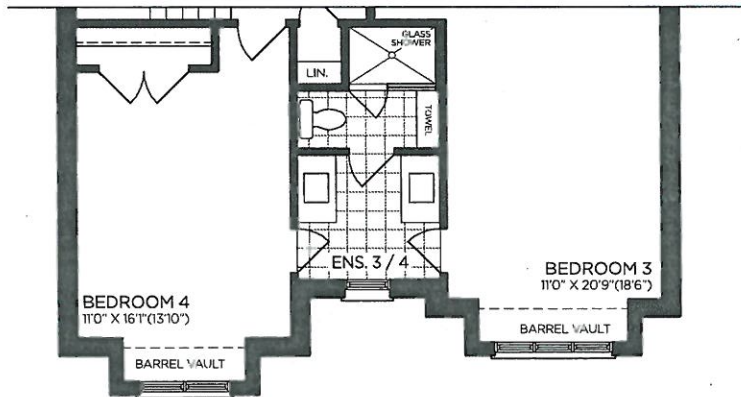

→ PART. SECOND FLOOR | ELEV. B

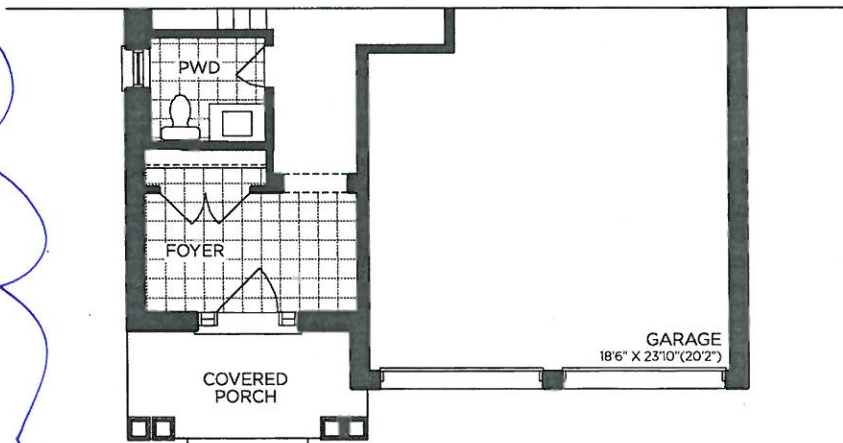

→ PART. GROUND FLOOR | ELEV. B

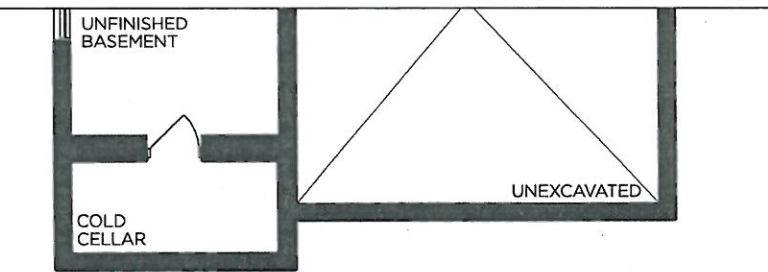

→ PART. BASEMENT | ELEV. B

VENDOR

PURCHASER

PURCHASER

GOLDPARK
WORTH MORE™

Prices, figures, illustrations, sizes, features and finishes are subject to change without notice. Areas and dimensions are approximate and actual usable floor space may vary from the stated area. Layout may be reverse of the unit purchased. E. & O.E. 4002

SCHEDULE 'F'




The Valleyview
40' SERIES

Elevation A • 3,145 sq.ft.
Elevation B • 3,170 sq.ft.

PV-120
MAY 17 2020
JUNE 4 2020
JUNE 19 2020

see attached
see attached
Look out 30x48"

36x48"

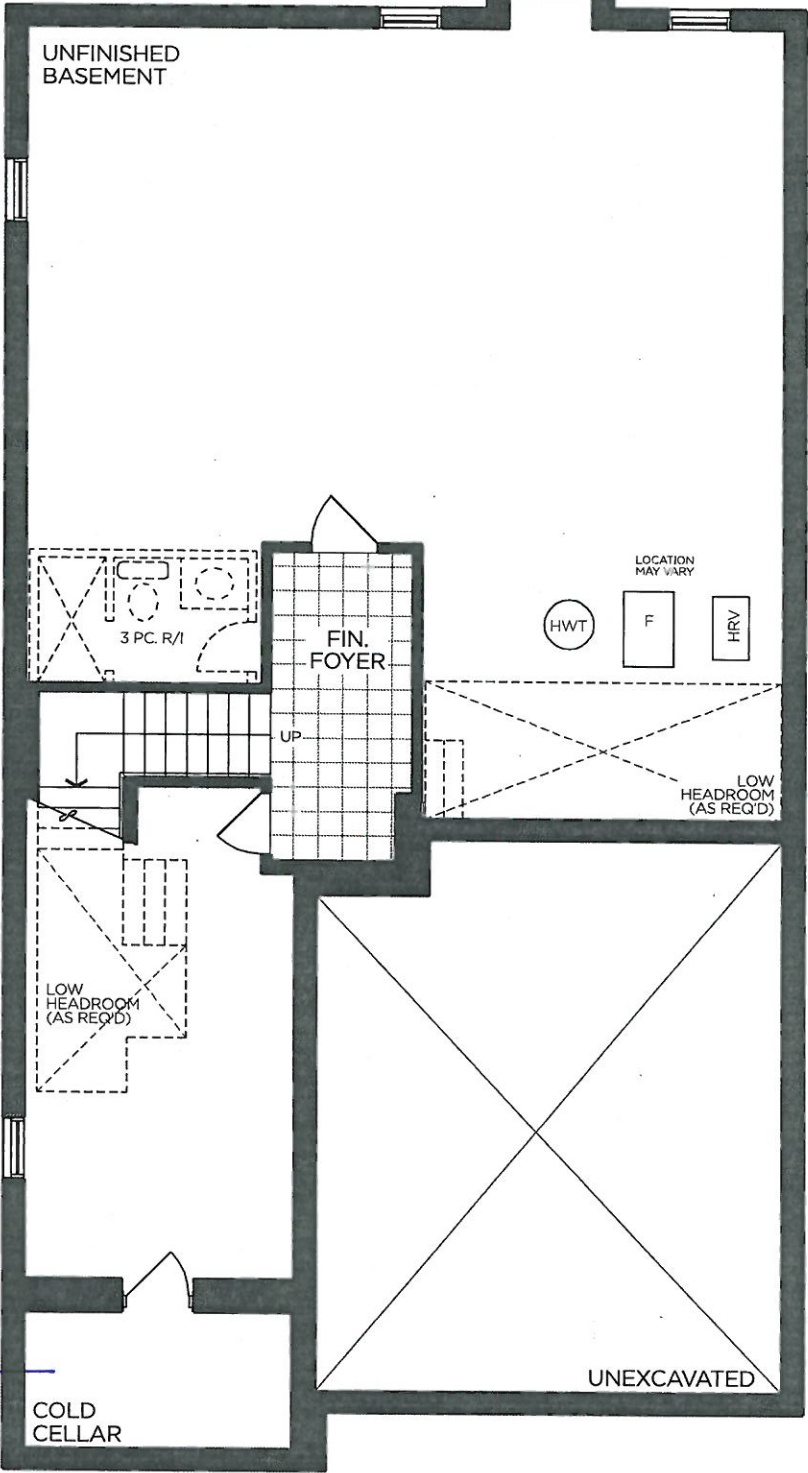

BASEMENT | ELEV. A

VENDOR

PURCHASER

PURCHASER

GOLDPARK
WORTH MORE™

Prices, figures, illustrations, sizes, features and finishes are subject to change without notice. Areas and dimensions are approximate and actual usable floor space may vary from the stated area. Layout may be reverse of the unit purchased. E. & O.E. 4002

SCHEDULE 'F'

PINE VALLEY
FOREVERGREEN

JUNE 19 2020

PV-120

MAILED 17 2020

JUNE 4 2020


Set attached.

The
Valleyview
40' SERIES

Elevation A • 3,145 sq.ft.

→ Elevation B • 3,170 sq.ft.

Black
Interior
Windows

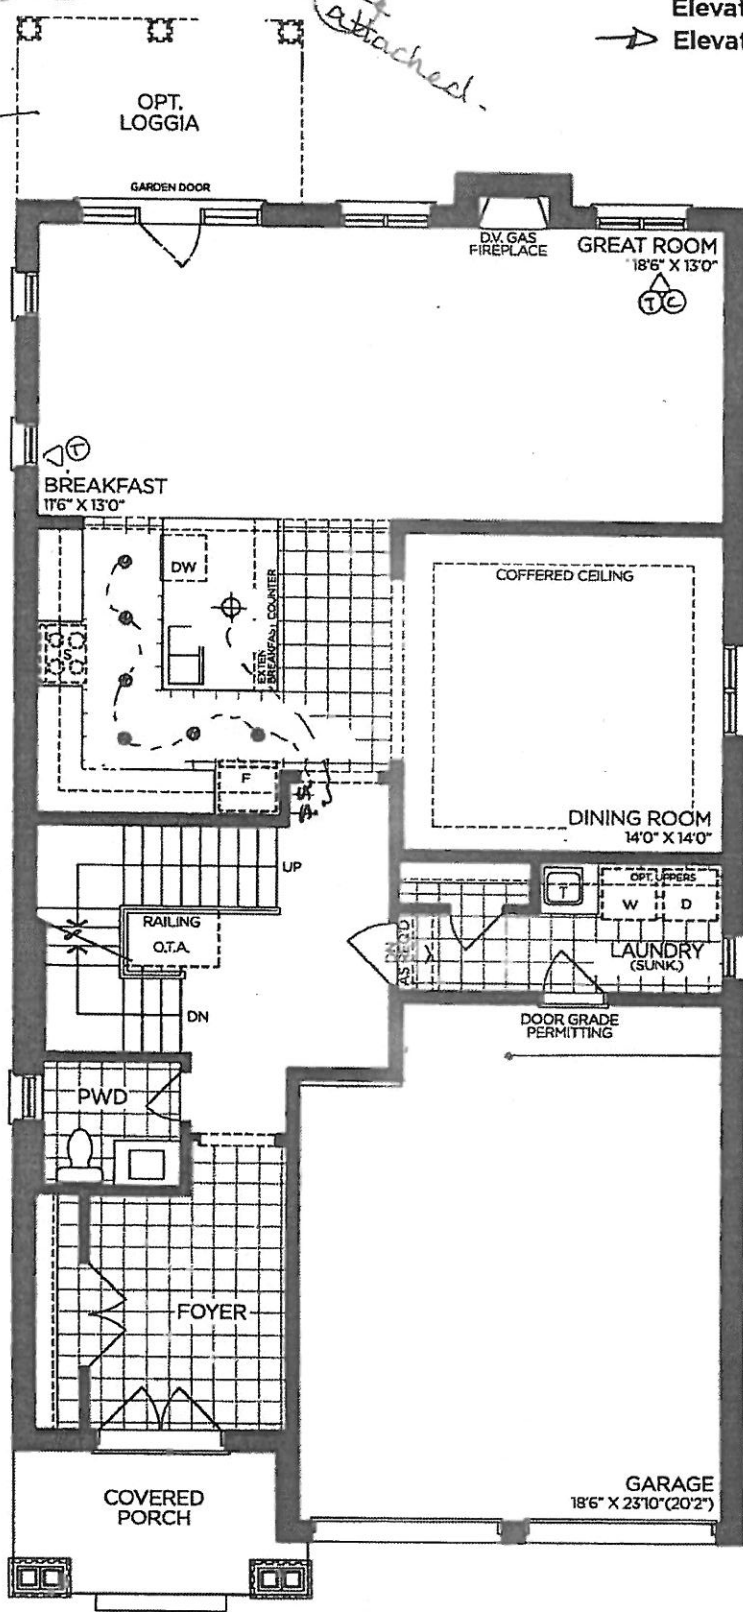

GROUND FLOOR | ELEV. A

SERVICE
STAIRS.

VENDOR

PURCHASER

PURCHASER

GOLDPARK
WORTH MORE™

Prices, figures, illustrations, sizes, features and finishes are subject to change without notice. Areas and dimensions are approximate and actual usable floor space may vary from the stated area. Layout may be reverse of the unit purchased. E. & O.E. 4002


SCHEDULE 'F'



PV-120
March 17 2020 *See attached*
June 4 2020 *See attached*
June 19 2020 *See attached*

The Valleyview
40' SERIES

Elevation A • 3,145 sq.ft.
→ Elevation B • 3,170 sq.ft.

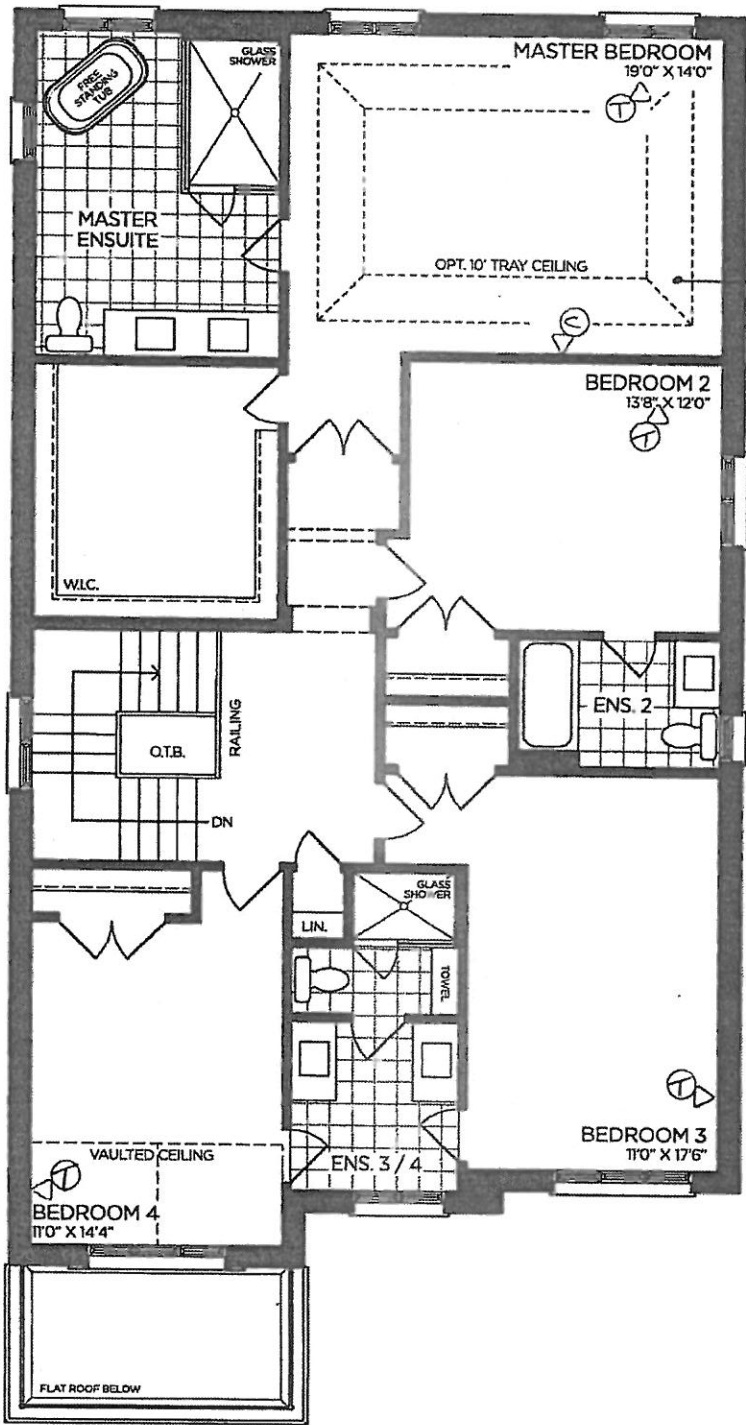

SECOND FLOOR | ELEV. A

VENDOR	<input type="text"/>
PURCHASER	<input type="text"/>
PURCHASER	<input type="text"/>

GOLDPARK
WORTH MORE™

Prices, figures, illustrations, sizes, features and finishes are subject to change without notice. Areas and dimensions are approximate and actual usable floor space may vary from the stated area. Layout may be reverse of the unit purchased. E. & O.E. 4002

SCHEDULE 'F'



PV-120 *see attached*
MAR 17 2020


JUNE 4 2020 *see attached*

JUNE 19 2020 *see attached*


The Valleyview
40' SERIES

Elevation A • 3,145 sq.ft.
→ Elevation B • 3,170 sq.ft.


YES!

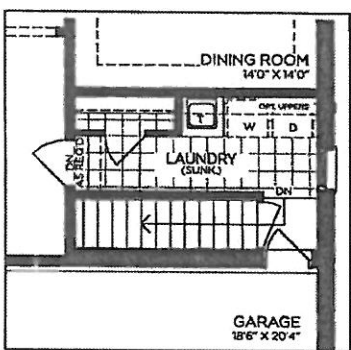


PART. GROUND FLOOR
OPT. SERVICE STAIR

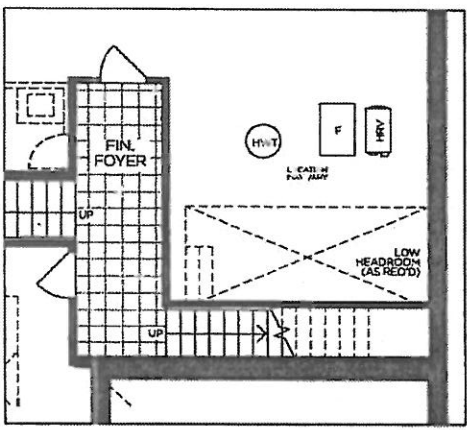


PART. BASEMENT
OPT. SERVICE STAIR

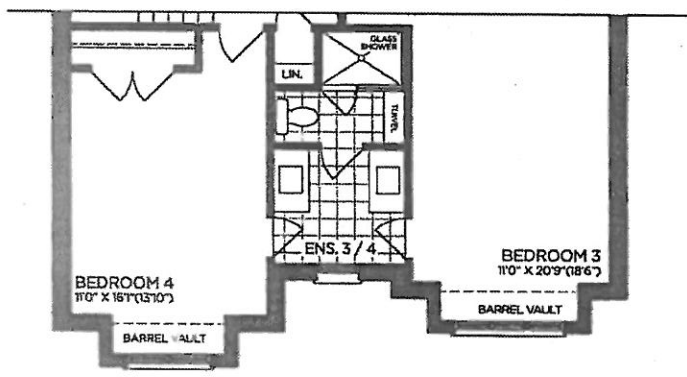

→ PART. SECOND FLOOR | ELEV. B

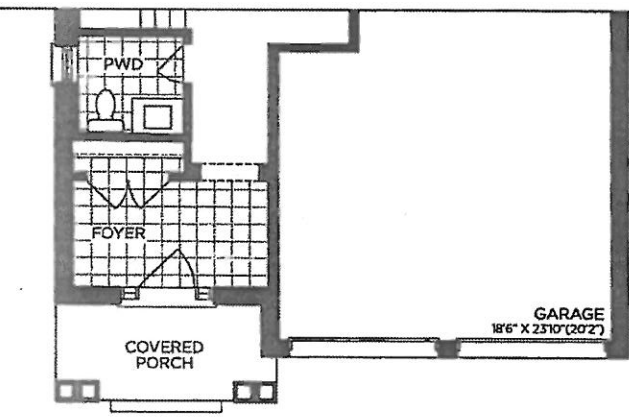

→ PART. GROUND FLOOR | ELEV. B

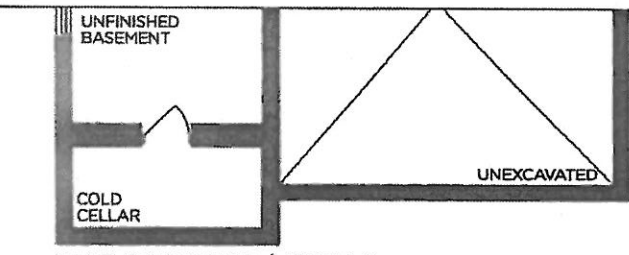

→ PART. BASEMENT | ELEV. B

VENDOR

PURCHASER

PURCHASER

GOLDPARK
WORTH MORE™

Prices, figures, illustrations, sizes, features and finishes are subject to change without notice. Areas and dimensions are approximate and actual usable floor space may vary from the stated area. Layout may be reverse of the unit purchased. E. & O.E. 4002

SCHEDULE 'F'



The
Valleyview
40' SERIES

Elevation A • 3,145 sq.ft.

→ Elevation B • 3,170 sq.ft.

PV-120

MAR 17 2020

JUNE 4 2020

JUNE 19 2020

see attached

see attached


18' CA

Look out 30x48"

36x48"

STD
16x30"

Backflow
PREVENTER
VALVE

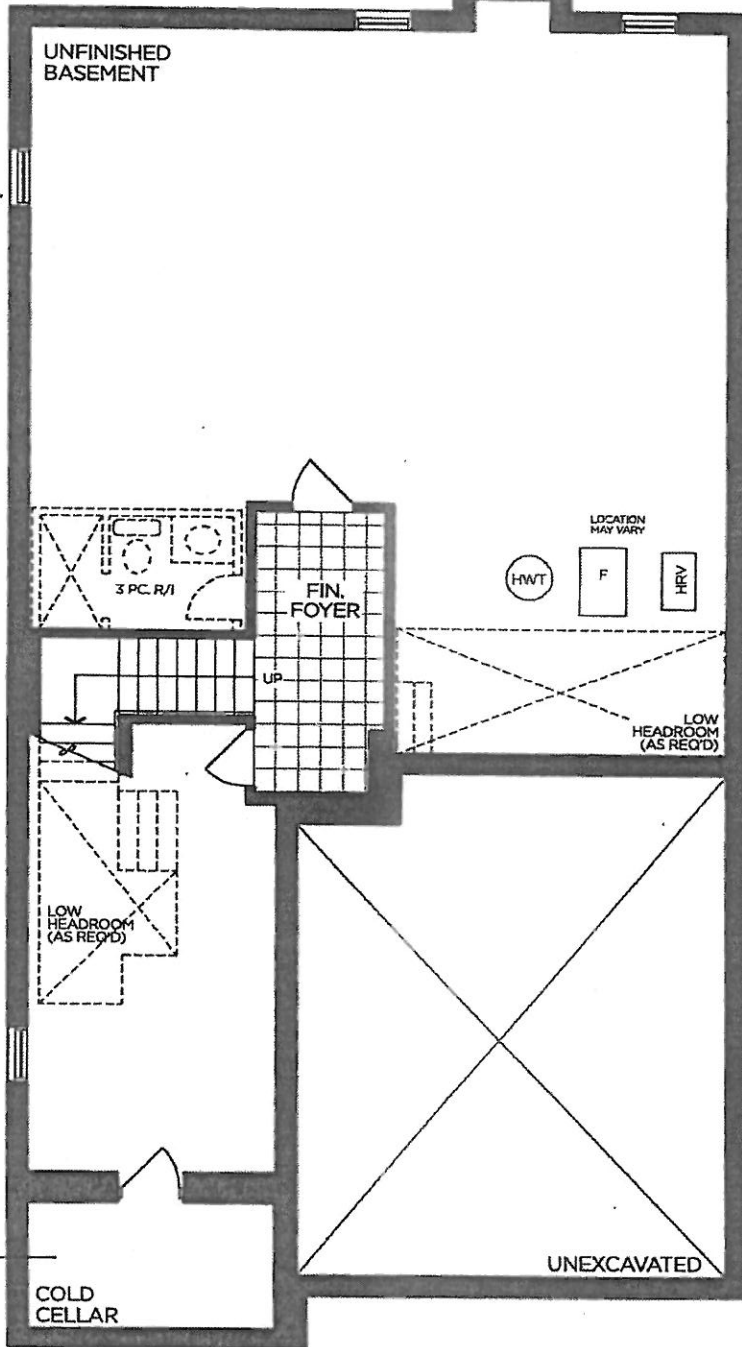

BASEMENT | ELEV. A

VENDOR
PURCHASER
PURCHASER

GOLDPARK
WORTH MORE™

Prices, figures, illustrations, sizes, features and finishes are subject to change without notice. Areas and dimensions are approximate and actual usable floor space may vary from the stated area. Layout may be reverse of the unit purchased. E. & O.E. 4002