

SCHEDULE 'F'



PV-15 *see attached*
APRIL 9 2020


PV-15
MAY 5. 2020 *WS*

The Lilac

40' SERIES

→ Elevation A • 3,425 sq.ft.
Elevation B • 3,385 sq.ft.

24x30"
~~*35x47*~~

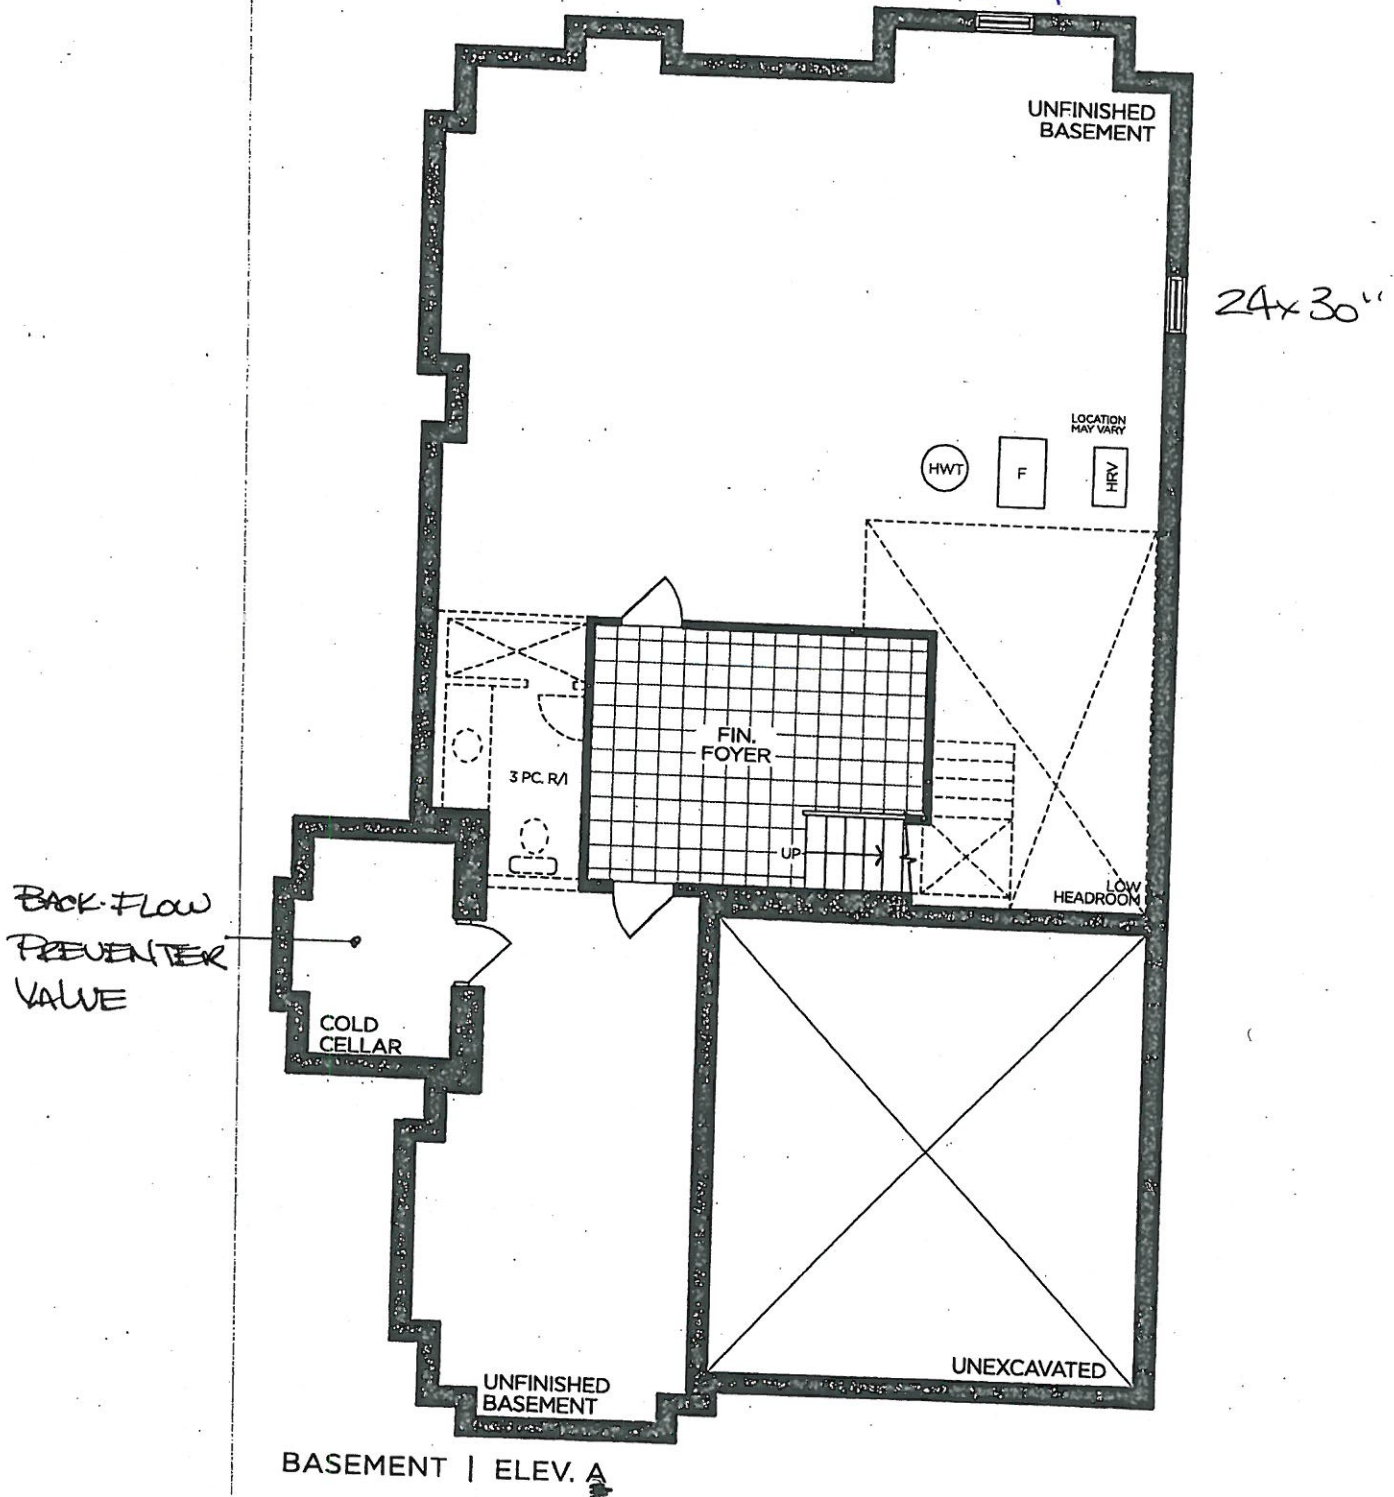

BASEMENT | ELEV. A

VENDOR	
PURCHASER	
PURCHASER	

GOLDPARK
WORTH MORE™

Prices, figures, illustrations, sizes, features and finishes are subject to change without notice. Areas and dimensions are approximate and actual usable floor space may vary from the stated area. Layout may be reverse of the unit purchased. E. & O.E. 4006

PINE VALLEY
FOREVERGREEN

PV-15
MAY 5 2020

See
attached

The Lilac


40' SERIES

→ Elevation A • 3,425 sq.ft.
Elevation B • 3,385 sq.ft.

No PHONE
THRU OUT

COFFER +
WAFLE

9' DOORS
ON MAIN
FLOOR

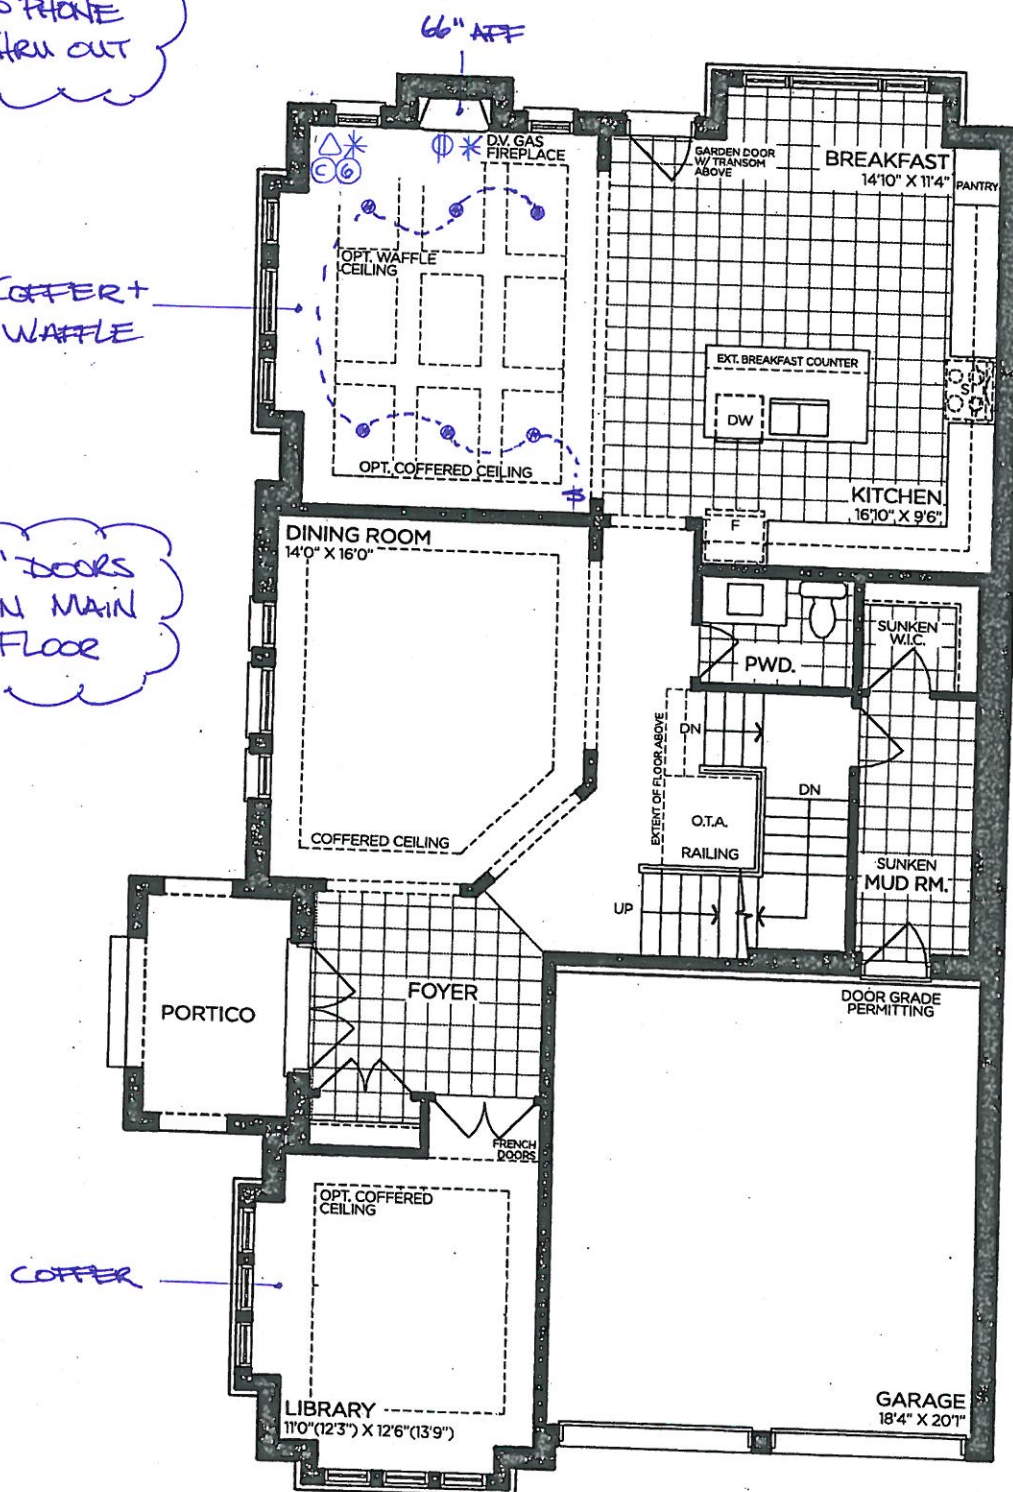

GROUND FLOOR | ELEV. A

[REDACTED]

[REDACTED]

--

GOLDPARK
WORTH MORE™

Prices, figures, illustrations, sizes, features and finishes are subject to change without notice. Areas and dimensions are approximate and actual usable floor space may vary from the stated area. Layout may be reverse of the unit purchased. E. & O.E. 4006



SCHEDULE 'F'

PV-15. *see attached*
April 9, 2020

PV-15
May 5, 2020 *(WS)*

The Lilac

40' SERIES

→ Elevation A • 3,425 sq.ft.
Elevation B • 3,385 sq.ft.


8' doors
on 2nd
floor

RAIN SHOWER
BENCH

TRAY CEILING.
- YES!

SUN TUNNEL

FRAMELESS GLASS
SHOWER

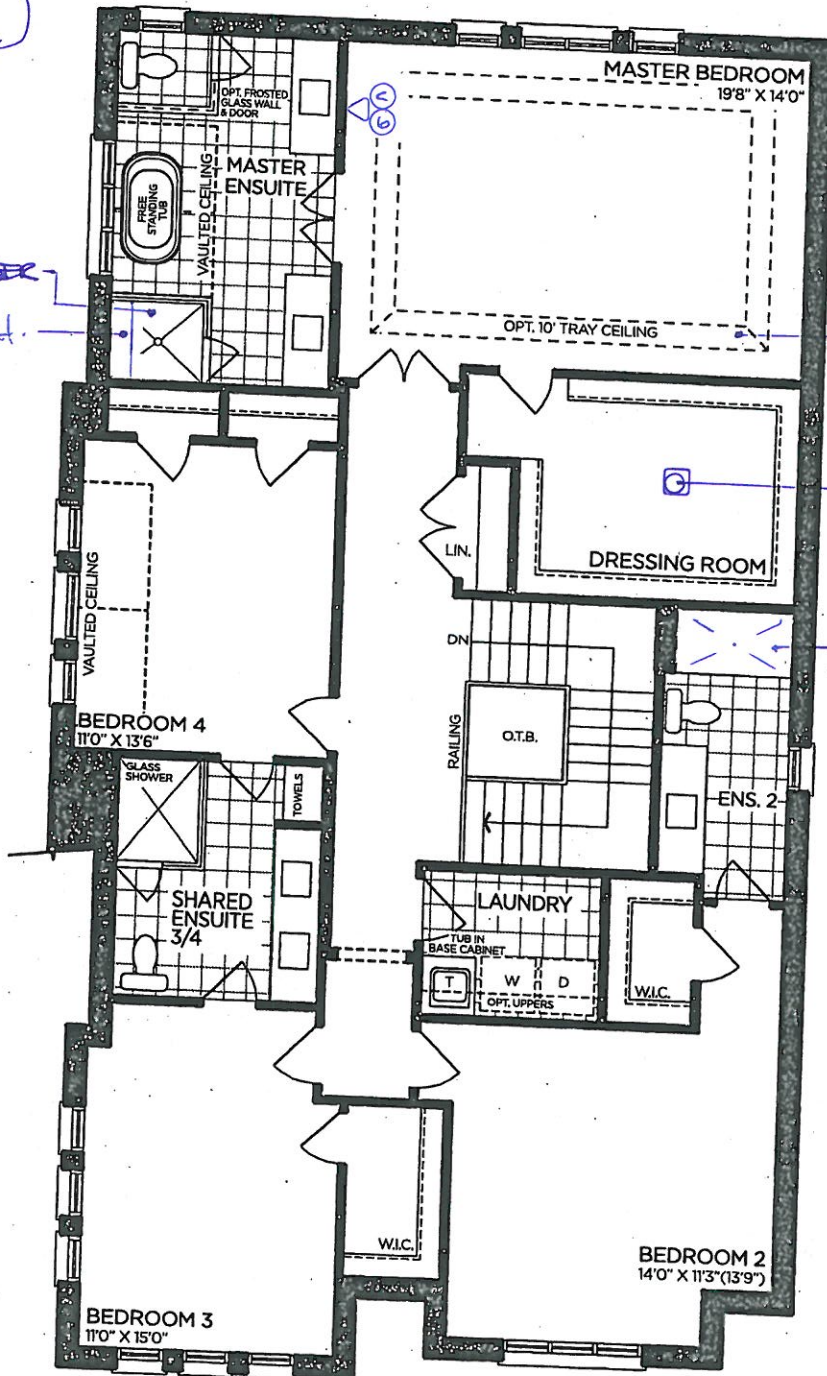

SECOND FLOOR | ELEV. A

VENDOR	
PURCHASER	
PURCHASER	

GOLDPARK
WORTH MORE™

Prices, figures, illustrations, sizes, features and finishes are subject to change without notice. Areas and dimensions are approximate and actual usable floor space may vary from the stated area. Layout may be reverse of the unit purchased. E. & O.E. 4006



PINE VALLEY
FOREVERGREEN

PLUMBING UPGRADES

POSI-TEMP SHOWER ONLY* W/3 FUNCTION TRANSFER VALVE TRIM AND SLIDE BAR W/HAND SHOWER

MOEN - ARRIS



- ☒ CHROME
☐ BRUSHED NICKEL
☐ MATTE BLACK

- ☐ from WALL
☒ from CEILING

MODEL TS22002EP / 3372 / TS23005 / 62320 / 3887EP / A725

Lot#

15

Room:

MASTER ENSUITE

Signature:

(W.S)

Date:

MAY 5 2020

Signature:

GOLDPARK
WORTH MORE