

**Lot: 147****Model: 40.02 A VALLEYVIEW****Project/Phase: Pine Valley Forevergreen / 1**

DRYWALL

Invoice	Qty.	Description
2294 24Jul20 NoCat	1	.PINE VALLEY MODEL 40.02 VALLEYVIEW ELEV A - 9 FOOT BASEMENT CEILING HEIGHT IN LIEU OF STANDARD 8 FOOT CEILING.
2294 24Jul20 NoCat	4	.BASEMENT WINDOWS - UPGRADE BASEMENT WINDOW SIZE TO 30 " X 24" - 8" FRAME (QTY:4)

ELECTRICAL

Invoice	Qty.	Description
2324 72,281 24Jul20	1	.GREAT ROOM: INTERIOR WALL OUTLET: ADDITIONAL 110V WALL INTERIOR RECEPTACLE ON EXISTING CIRCUIT FOR WALL MOUNTED TV - LOCATE APPROX. 66" A.F.F. ABOVE FIREPLACE.
2324 72,273 24Jul20	1	.KITCHEN: 110V WALL RECEPTACLE ON SEPARATE CIRCUIT - GAS FIRED RANGE - FOR AUX. EQUIPMENT - NOT A STOVE PLUG
2324 72,294 24Jul20	1	.SIDE ELEVATION (GARAGE SIDE): IN ADDITION TO STANDARD HOLIDAY GFI, ADD AN ADDITIONAL ON GARAGE SIDE OF HOUSE. LOCATED APPROX 18" FROM FRONT CORNER. ADDITIONAL EXTERIOR GFI RECEPTACLE WITH COVER AND SWITCH FOR HOLIDAY LIGHTS
2324 72,289 24Jul20	6	.DINING ROOM: 4" E/S LED INTERIOR POT LIGHT - GROUND FLOOR - EACH INCLUDED IN APS
2324 24Jul20 NoCat	1	.DINING ROOM: DELETE STANDARD CEILING LIGHT

EXTERIOR COLOURS

Invoice	Qty.	Description
2294	1	EXTERIOR COLOUR PACKAGE # BR.2
24Jul20 NoCat		

FORMING

Invoice	Qty.	Description
2294 24Jul20 NoCat	1	.PINE VALLEY MODEL 40.02 VALLEYVIEW ELEV A - 9 FOOT BASEMENT CEILING HEIGHT IN LIEU OF STANDARD 8 FOOT CEILING.
2294 24Jul20 NoCat	4	.BASEMENT WINDOWS - UPGRADE BASEMENT WINDOW SIZE TO 30 " X 24" - 8" FRAME (QTY:4)

GOLDPARK

WORTH MORE™

CONSTRUCTION SUMMARY

Lot: 147

Model: 40.02 A VALLEYVIEW

Project/Phase: Pine Valley Forevergreen / 1

FRAMING		
Invoice	Qty.	Description
2294 72,193 24Jul20	1	.PINE VALLEY MODEL 40.02 VALLEYVIEW ELEV A - 9 FOOT BASEMENT CEILING HEIGHT IN LIEU OF STANDARD 8 FOOT CEILING.
2294 24Jul20 NoCat	4	.BASEMENT WINDOWS - UPGRADE BASEMENT WINDOW SIZE TO 30 " X 24" - 8" FRAME (QTY:4)

HVAC		
Invoice	Qty.	Description
2294 24Jul20 NoCat	1	.PINE VALLEY MODEL 40.02 VALLEYVIEW ELEV A - 9 FOOT BASEMENT CEILING HEIGHT IN LIEU OF STANDARD 8 FOOT CEILING.
2324 72,224 24Jul20	1	.KITCHEN: GAS LINE ROUGH-IN - MAIN FLOOR FOR GAS RANGE - SEE PLAN FOR LOCATION

INTERIOR TRIM AND DOORS		
Invoice	Qty.	Description
2294 24Jul20 NoCat	1	.PINE VALLEY MODEL 40.02 VALLEYVIEW ELEV A - 9 FOOT BASEMENT CEILING HEIGHT IN LIEU OF STANDARD 8 FOOT CEILING.
2294 24Jul20 NoCat	4	.BASEMENT WINDOWS - UPGRADE BASEMENT WINDOW SIZE TO 30 " X 24" - 8" FRAME (QTY:4)

NETWORK AND WIRING		
Invoice	Qty.	Description
2324 72,258 24Jul20	1	.GREAT ROOM / DINING ROOM / MASTER BEDROOM / BEDROOM 4: ADDITIONAL CAT6 ETHERNET OUTLET - EACH SEE PLAN FOR LOCATION PACKAGE PRICE
2324 72,259 24Jul20	1	.GREAT ROOM CONDUIT PIPE - FOR WALL MOUNT TV - LOCATE APPROX. 66" A.F.F. ABOVE FIREPLACE, THRU TO BASEMENT & TERMINATING AT CABLE - SEE PLAN FOR LOCATION
2324 72,260 24Jul20	1	.CONDUIT PIPE - FROM ATTIC TO BASEMENT - FROM BASEMENT AT ELECTRICAL PANET TO APPROX CENTER OF ATTIC
2324 72,261 24Jul20	1	.KITCHEN: INSTALL VAC PAN UNDER KITCHEN SINK
2324 24Jul20 NoCat	1	.**NOTE** LOCATE STANDARD PHONE IN DINING ROOM INSTEAD OF KITCHEN

DisciplineMS.rpt 26jun20

Page 2 of 3
Printed and Sent: 24-Jul-20

**Lot: 147****Model: 40.02 A VALLEYVIEW****Project/Phase: Pine Valley Forevergreen / 1**

PAINT

Invoice	Qty.	Description
2294 24Jul20 NoCat	1	.PINE VALLEY MODEL 40.02 VALLEYVIEW ELEV A - 9 FOOT BASEMENT CEILING HEIGHT IN LIEU OF STANDARD 8 FOOT CEILING.

PLUMBING

Invoice	Qty.	Description
2324	1	.MASTER ENSUITE: UPGRADE SHOWER FAUCET TO MOEN '90*' POSI-TEMP RAIN SHOWER (from ceiling) + HAND SHOWER WITH SLIDE BAR - CHROME #TS2712EP/3372/TS4172/62320/S3879EP/A721
24Jul20 NoCat		

PLUMBING FIXTURES

Invoice	Qty.	Description
2324	1	.MASTER ENSUITE: UPGRADE SHOWER FAUCET TO MOEN '90*' POSI-TEMP RAIN SHOWER (from ceiling) + HAND SHOWER WITH SLIDE BAR - CHROME #TS2712EP/3372/TS4172/62320/S3879EP/A721
24Jul20 NoCat		

WINDOWS - BASEMENT

Invoice	Qty.	Description
2294 72,351 24Jul20	4	.BASEMENT WINDOWS - UPGRADE BASEMENT WINDOW SIZE TO 30 " X 24" - 8" FRAME (QTY:4)


SCHEDULE 'F'



TV-147
MAY 1 2020
See attached

The Valleyview
40' SERIES

Elevation A • 3,145 sq.ft.
Elevation B • 3,170 sq.ft.

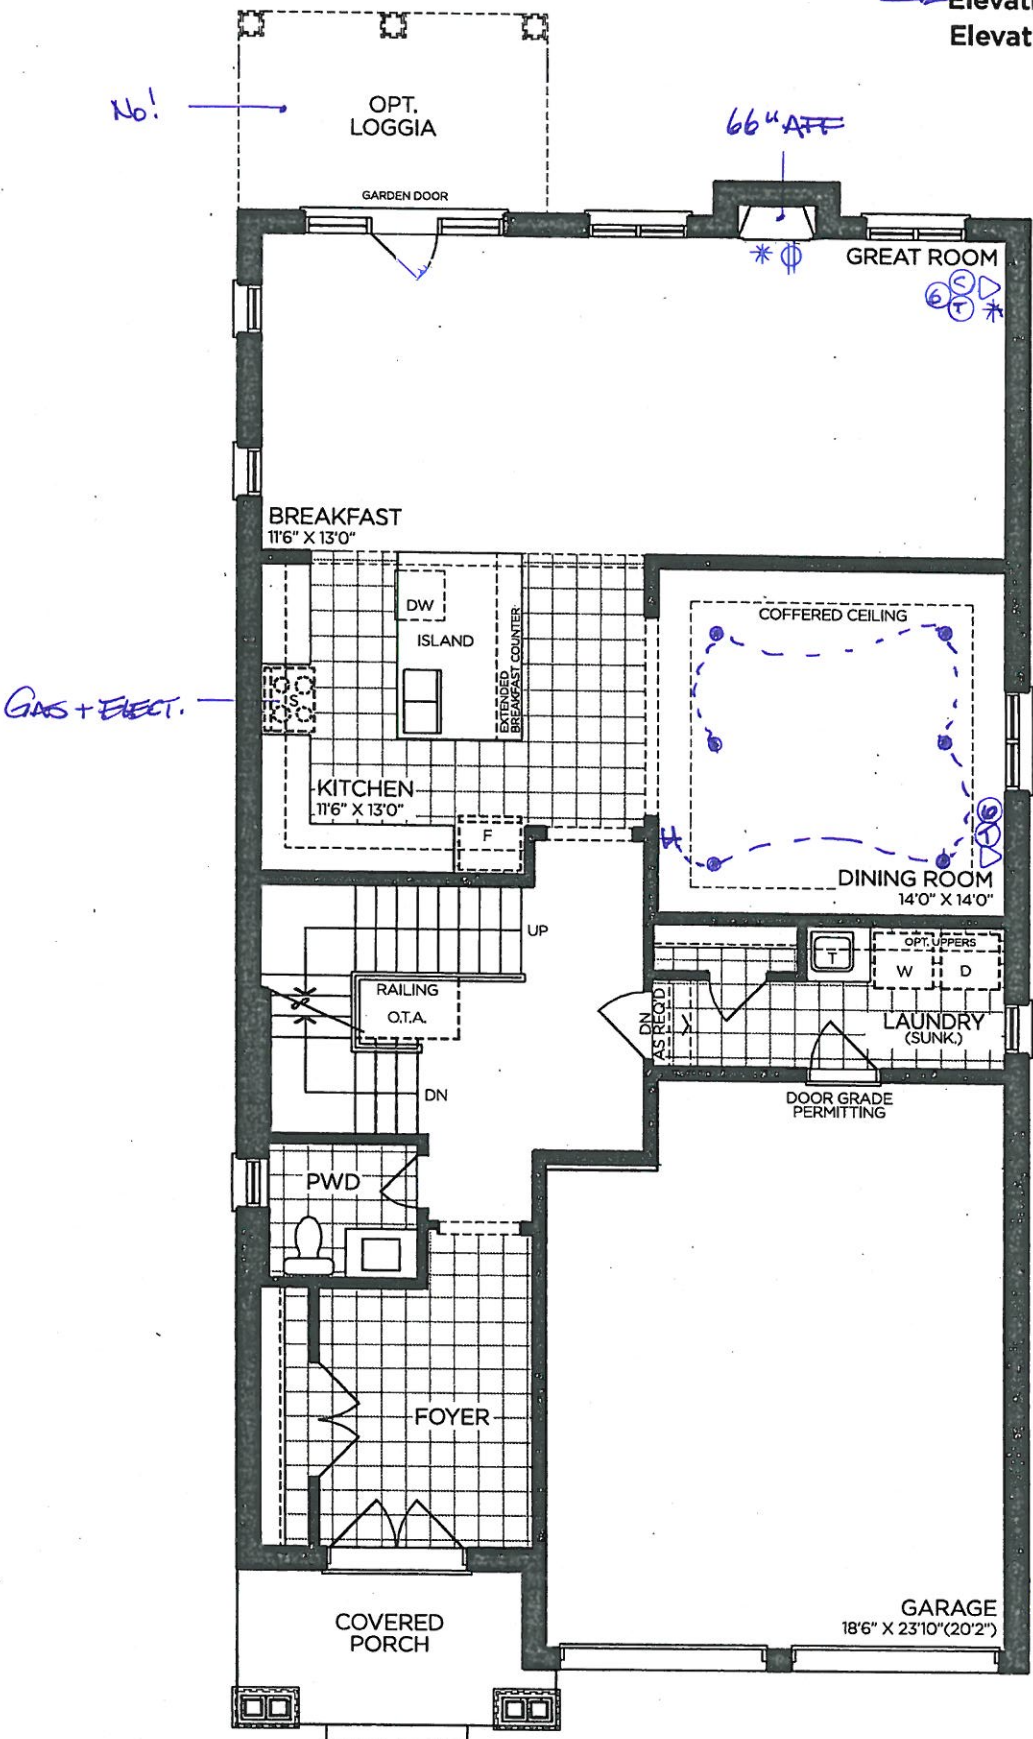

GROUND FLOOR | ELEV. A

VENDOR

PURCHASER

PURCHASER

GOLDPARK
WORTH MORE™

Prices, figures, illustrations, sizes, features and finishes are subject to change without notice. Areas and dimensions are approximate and actual usable floor space may vary from the stated area. Layout may be reverse of the unit purchased. E. & O.E. 4002


SCHEDULE 'F'



PV-147 ~~see sketch~~
MAY 1 2020

The Valleyview
40' SERIES

Elevation A • 3,145 sq.ft.
Elevation B • 3,170 sq.ft.

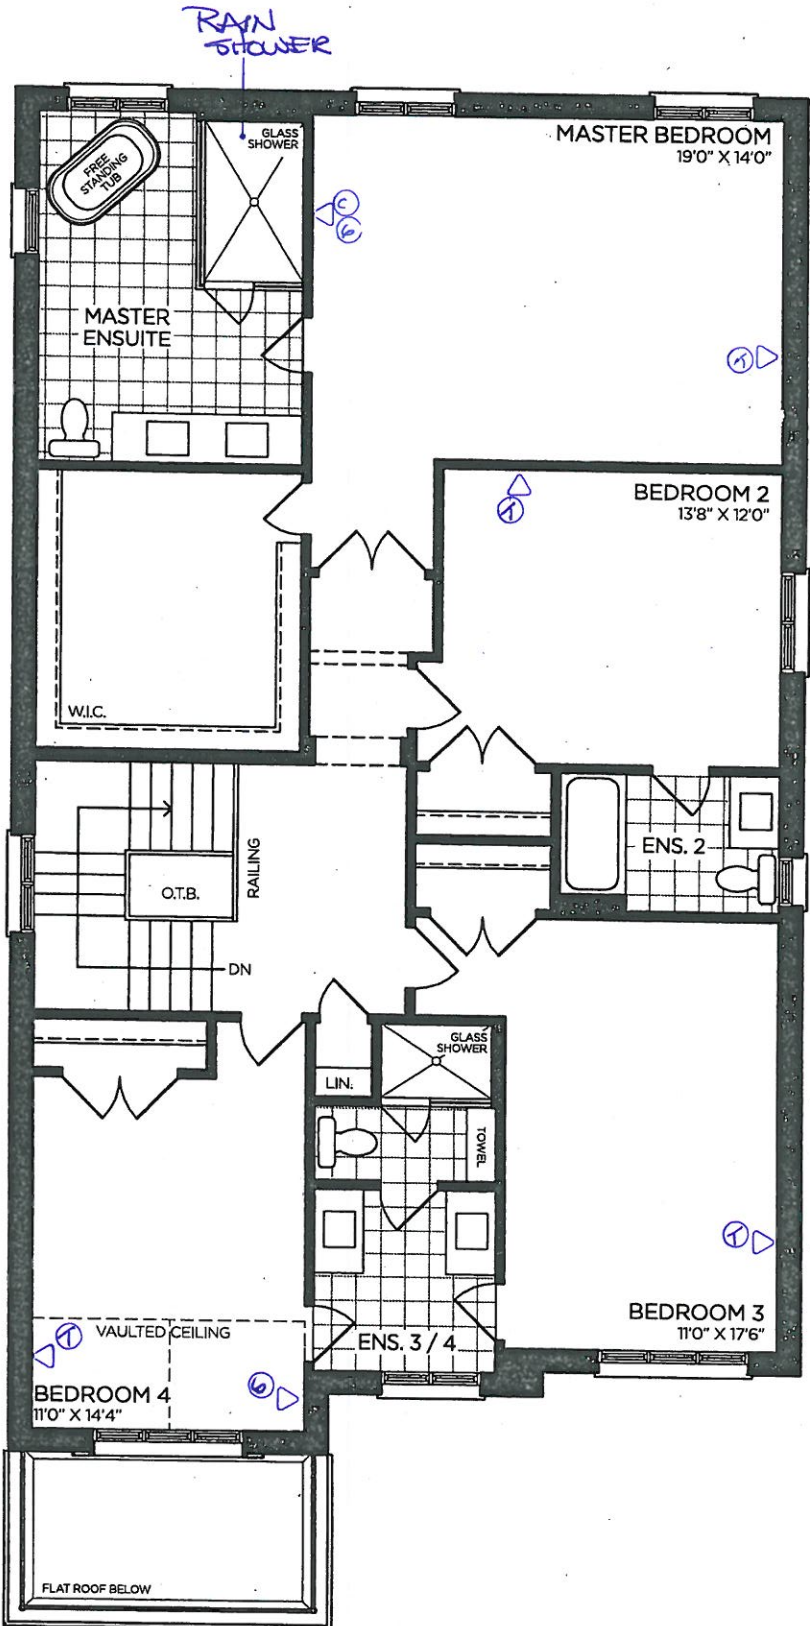

SECOND FLOOR | ELEV. A

VENDOR

PURCHASER

PURCHASER

GOLDPARK
WORTH MORE™

Prices, figures, illustrations, sizes, features and finishes are subject to change without notice. Areas and dimensions are approximate and actual usable floor space may vary from the stated area. Layout may be reverse of the unit purchased. E. & O.E. 4002


SCHEDULE 'F'



The Valleyview
40' SERIES

→ Elevation A • 3,145 sq.ft.
Elevation B • 3,170 sq.ft.

PV-147 *see sketch*
MAY 1 2020

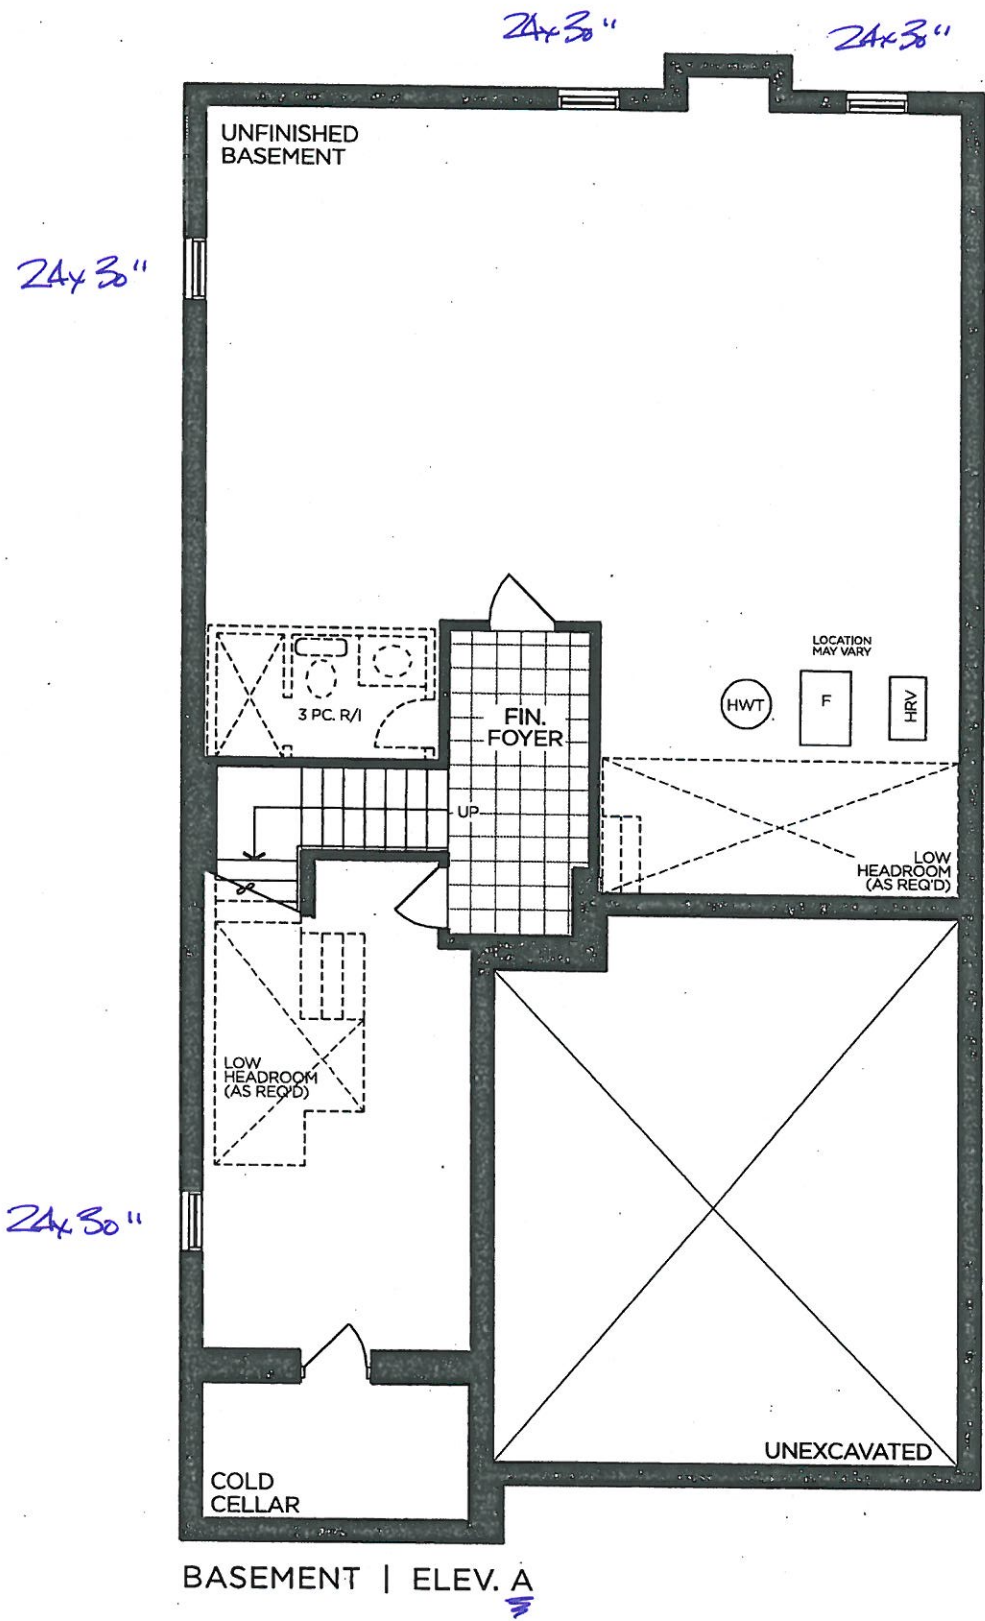

VENDOR

PURCHASER

PURCHASER

GOLDPARK
WORTH MORE™


Prices, figures, illustrations, sizes, features and finishes are subject to change without notice. Areas and dimensions are approximate and actual usable floor space may vary from the stated area. Layout may be reverse of the unit purchased. E. & O.E. 4002



PLUMBING UPGRADES

POSI-TEMP SHOWER ONLY* W/ 3 FUNCTION TRANSFER
VALVE/TRIM AND SLIDE BAR WITH HAND SHOWER

MOEN - 90 DEGREE

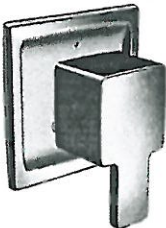

☒ CHROME

☐ BRUSHED NICKEL

☐ MATTE BLACK - N/A

☐ from WALL

☒ from CEILING

MODEL TS2712EP / 3372 / TS4172 / 62320 / S3879EP / A721

Lot#
147

Room:
MASTER ENSUITE

Signature:
[Signature]

Date:
MAY 1 2020

Signature:
[Signature]

SCHEDULE 'F'




PV-147
MAY 1 2020

(m)
(m)

The Valleyview

40' SERIES

Elevation A • 3,145 sq.ft.
Elevation B • 3,170 sq.ft.

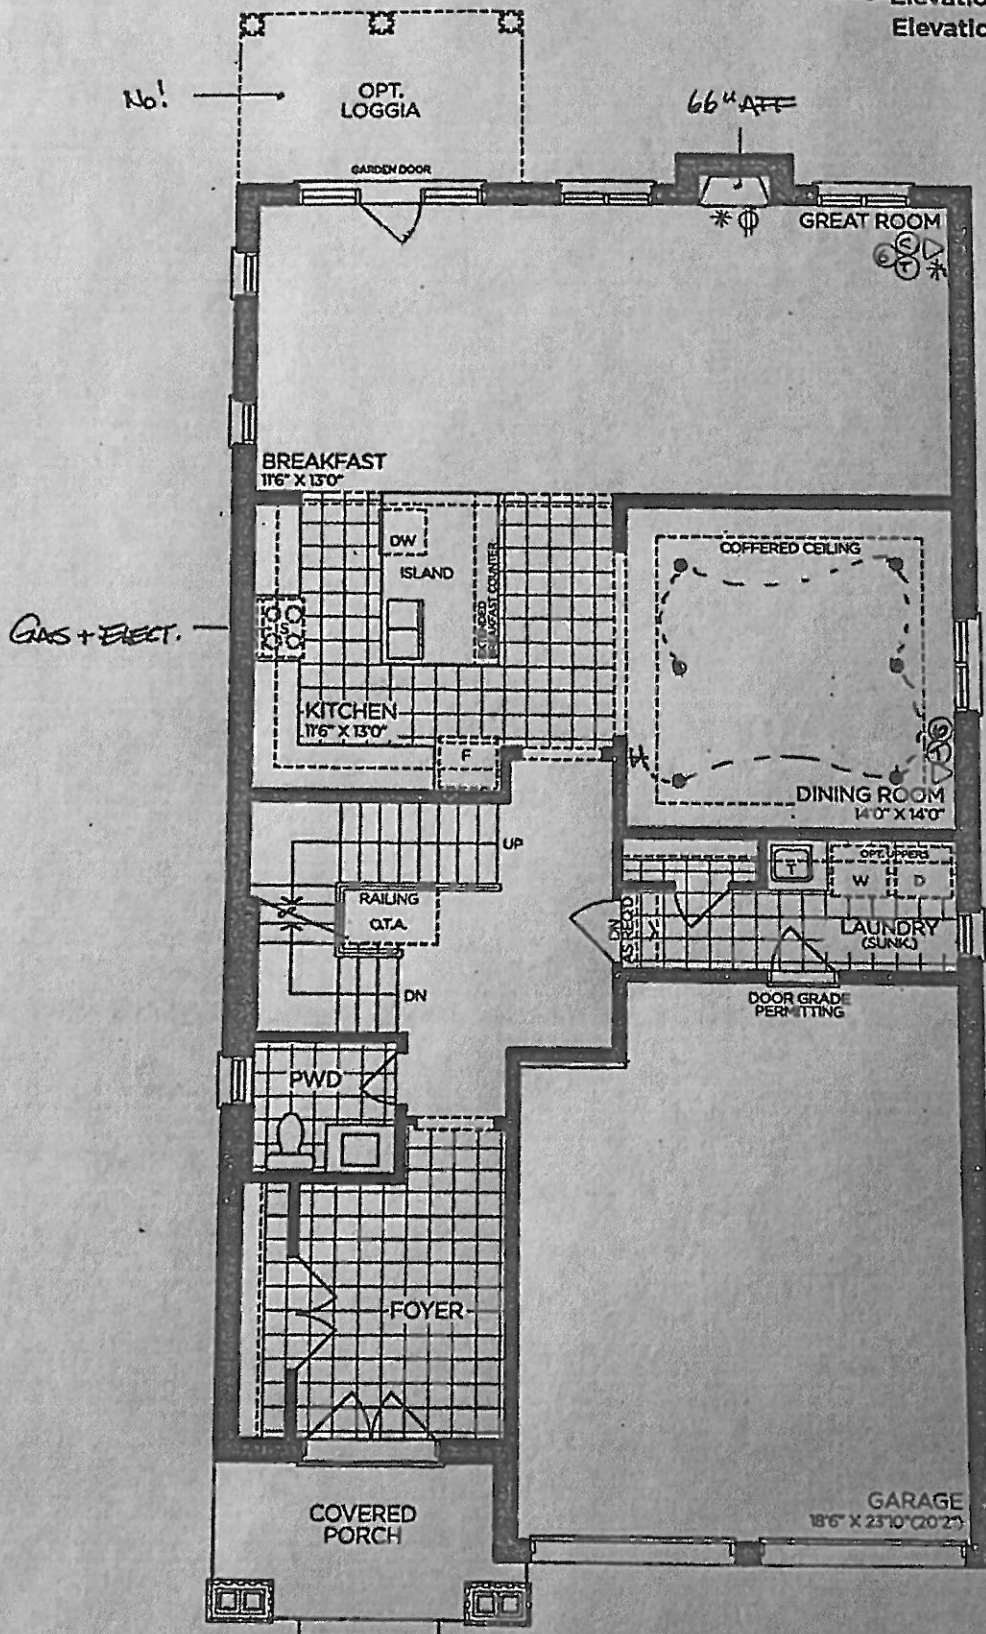

GROUND FLOOR | ELEV. A

VENDOR

PURCHASER

PURCHASER

GOLDPARK
WORTH MORE™

Prices, figures, illustrations, sizes, features and finishes are subject to change without notice. Areas and dimensions are approximate and actual usable floor space may vary from the stated area. Layout may be reverse of the unit purchased. E. & O.E. 4002

SCHEDULE 'F'




PV-147 (MD) (MD)
MAY 1 2020

The Valleyview

40' SERIES

→ Elevation A • 3,145 sq.ft.
Elevation B • 3,170 sq.ft.

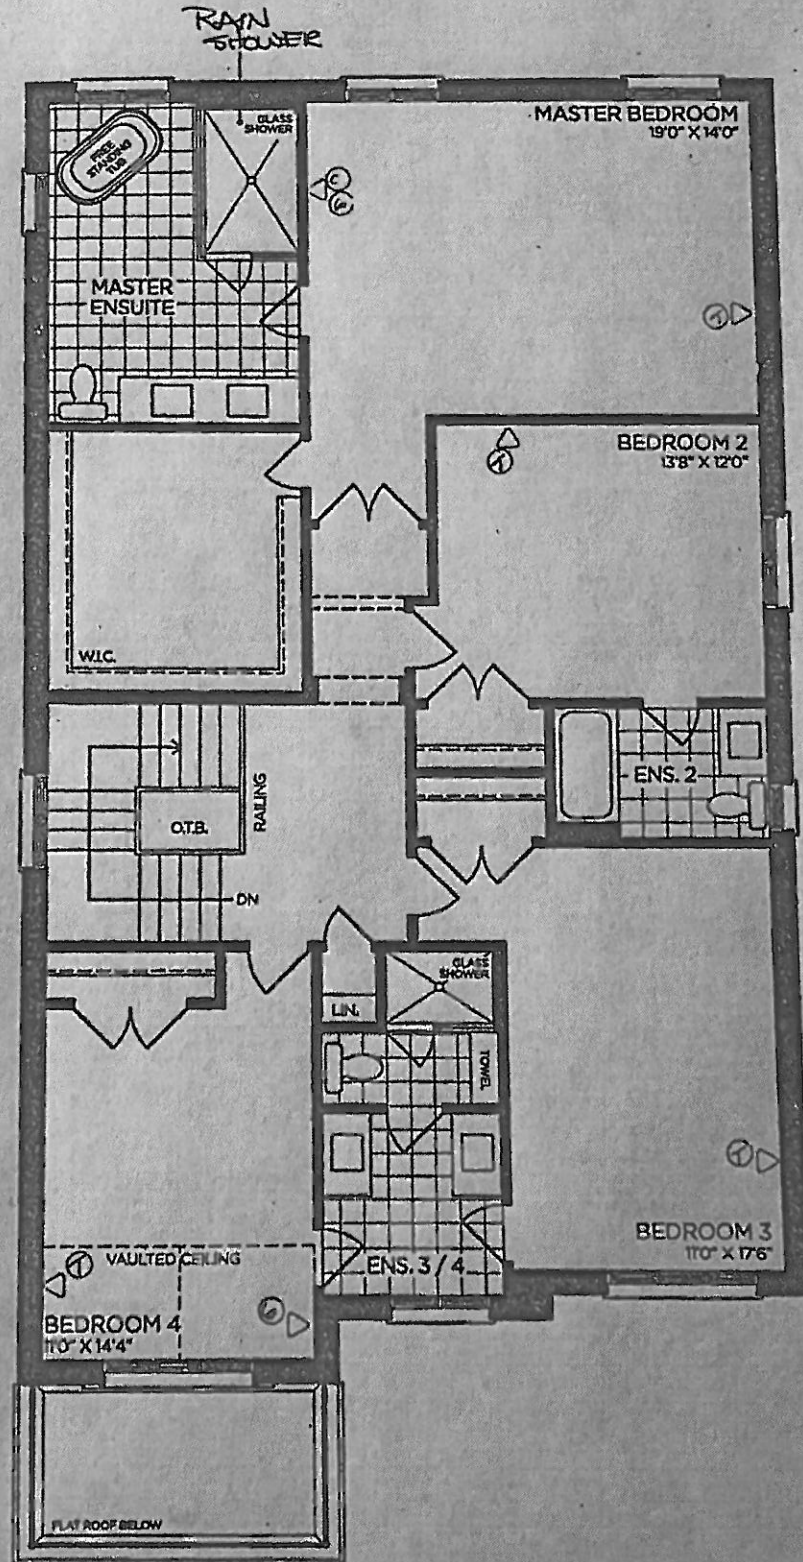

SECOND FLOOR | ELEV. A

VENDOR
PURCHASER
PURCHASER

GOLDPARK
WORTH MORE™


Prices, figures, illustrations, sizes, features and finishes are subject to change without notice. Areas and dimensions are approximate and actual usable floor space may vary from the stated area. Layout may be reverse of the unit purchased. E. & O.E. 4002

SCHEDULE 'F'



PV-147 ^{MD}
 MAY 1 2020 ^{MD}

The
Valleyview
 40' SERIES
 → Elevation A • 3,145 sq.ft.
 Elevation B • 3,170 sq.ft.

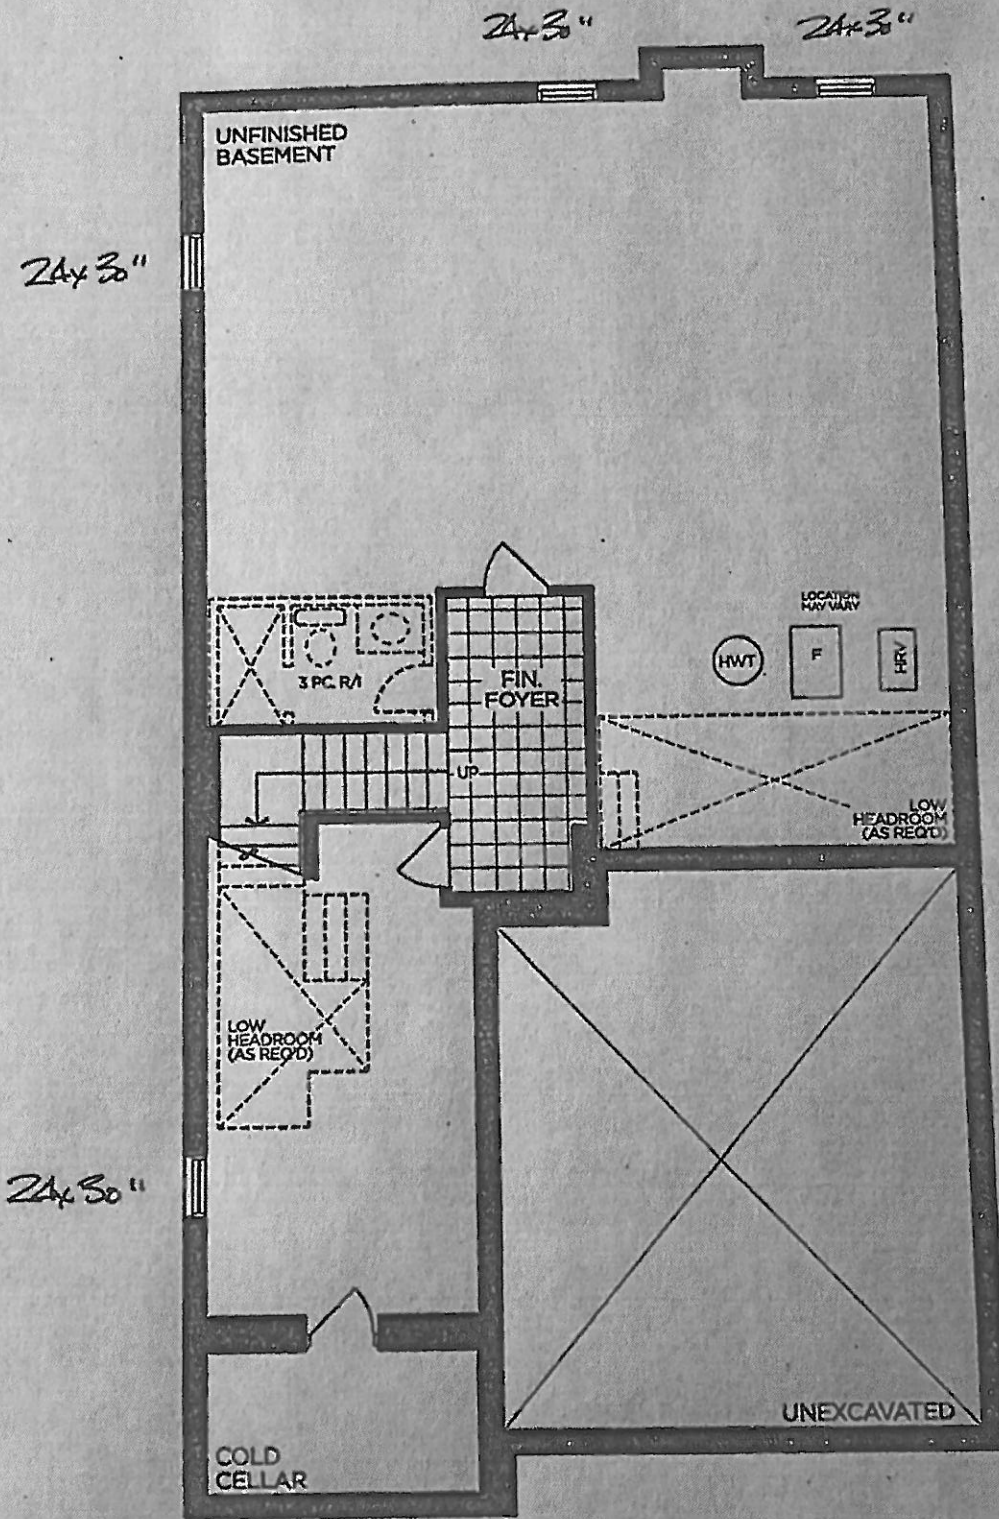

BASEMENT | ELEV. A

VENDOR

PURCHASER

PURCHASER

GOLDPARK
 WORTH MORE™




Prices, figures, illustrations, sizes, features and finishes are subject to change without notice. Areas and dimensions are approximate and actual usable floor space may vary from the stated area. Layout may be reverse of the unit purchased. E. & O.E. 4002



PLUMBING UPGRADES

POSI-TEMP SHOWER ONLY* W/ 3 FUNCTION TRANSFER
VALVE/TRIM AND SLIDE BAR WITH HAND SHOWER

MOEN - 90 DEGREE

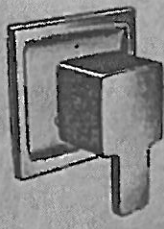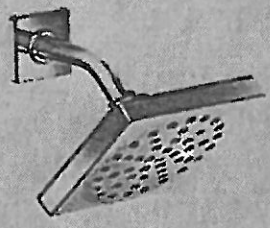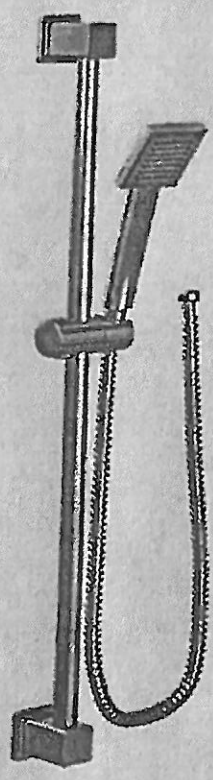

- ☒ CHROME
- ☐ BRUSHED NICKEL
- ☐ MATTE BLACK - N/A

- ☐ from WALL
- ☒ from CEILING

MODEL TS2712EP / 3372 / TS4172 / 62320 / S3879EP / A721

Lot#
147

Room: MASTER ENSUITE	Signature: <i>M. DiGiacca</i>
-------------------------	----------------------------------

Date: MAY 1 2020	Signature: <i>M. DiGiacca</i>
---------------------	----------------------------------