

GOLDPARK

WORTH MORE™

CONSTRUCTION SUMMARY

Lot: 157

Model: 40.03 B BROOKSIDE

Project/Phase: Pine Valley Forevergreen / 1

CONCRETE AND DRAIN		
Invoice	Qty.	Description
2286	1	.BACK-FLOW PREVENTER VALVE
24Jul20 NoCat		

DRYWALL		
Invoice	Qty.	Description
2334	1	.DELETE KITCHEN BULKHEAD, IF POSSIBLE, SITE APPROVAL REQUIRED
24Jul20 NoCat		
2334	1	.STUDY - OPT. 8 FOOT HIGH DOUBLE FRENCH DOORS WITH FLAT CLEAR GLASS COMPLETE WITH BUILDERS STANDARD OFFERINGS
24Jul20 NoCat		

ELECTRICAL		
Invoice	Qty.	Description
2334 72,281 24Jul20	1	.GREAT ROOM: INTERIOR WALL OUTLET: ADDITIONAL 110V WALL INTERIOR RECEPTACLE ON EXISTING CIRCUIT FOR WALL MOUNTED TV - LOCATE APPROX. 66" A.F.F. ABOVE FIREPLACE
2334 72,281 24Jul20	1	.MEDIA ROOM: INTERIOR WALL OUTLET: ADDITIONAL 110V WALL INTERIOR RECEPTACLE ON EXISTING CIRCUIT FOR WALL MOUNTED TV - LOCATE APPROX. 42" A.F.F.
2334 72,665 24Jul20	1	.KITCHEN: 240v WALL RECEPTACLE ON SEPARATE CIRCUIT FOR BUILT-INS. - APPROX. LOCATION AS PER ATTACHED DRAWINGS
2334 72,273 24Jul20	1	.KITCHEN: 110V WALL RECEPTACLE ON SEPARATE CIRCUIT - GAS FIRED COOKTOP - FOR AUX. EQUIPMENT - NOT A STOVE PLUG
2334 72,270 24Jul20	1	.KITCHEN: INTERIOR WALL OUTLET: 110V WALL RECEPTACLE ON SEPARATE CIRCUIT - FOR GARBURATOR - GARBURATOR NOT INCLUDED
2334 72,307 24Jul20	1	.KITCHEN: FIXTURE: RELOCATE STANDARD CEILING MOUNT FIXTURE - LOCATE APPROX CENTER ABOVE ISLAND
2334 72,667 24Jul20	2	.KITCHEN: ROUGH-IN FOR CAPPED CEILING OUTLET (FUTURE LIGHT FIXTURE) - EACH LOCATE APPROX CENTERED ABOVE ISLAND USE SAME SWITCH AS STANDARD
2334 72,268 24Jul20	1	.DINING ROOM: INTERIOR WALL OUTLET: 110V WALL INTERIOR RECEPTACLE ON EXISTING CIRCUIT LOCATE IN BUFFET NICHE, APPROX 42" A.F.F.

DisciplineMS.rpt 26jun20

Page 1 of 5
Printed and Sent: 24-Jul-20

GOLDPARK

WORTH MORE™

CONSTRUCTION SUMMARY

Lot: 157

Model: 40.03 B BROOKSIDE

Project/Phase: Pine Valley Forevergreen / 1

FORMING

Invoice	Qty.	Description
2286 24Jul20 NoCat	1	.BASEMENT WINDOWS - UPGRADE BASEMENT WINDOW SIZE TO 30 " X 24" - 8" FRAME
2405 72,672 24Jul20	-2	*DELETE* BASEMENT WINDOWS - EGRESS BASEMENT WINDOW 47 " X 35" - 8" FRAME from order pe-2286 DUE TO SITE CONDITION
2405 24Jul20 NoCat	2	.BASEMENT WINDOWS - UPGRADE BASEMENT WINDOW SIZE TO 30 " X 24" - 8" FRAME

FRAMING

Invoice	Qty.	Description
2286 24Jul20 NoCat	1	.BASEMENT WINDOWS - UPGRADE BASEMENT WINDOW SIZE TO 30 " X 24" - 8" FRAME
2334 72,690 24Jul20	1	.DELETE KITCHEN BULKHEAD, IF POSSIBLE, SITE APPROVAL REQUIRED
2334 72,402 24Jul20	1	.STUDY - OPT. 8 FOOT HIGH DOUBLE FRENCH DOORS WITH FLAT CLEAR GLASS COMPLETE WITH BUILDERS STANDARD OFFERINGS
2405 24Jul20 NoCat	2	*DELETE* BASEMENT WINDOWS - EGRESS BASEMENT WINDOW 47 " X 35" - 8" FRAME

HVAC

Invoice	Qty.	Description
2334 72,224 24Jul20	1	KITCHEN: GAS LINE ROUGH-IN - MAIN FLOOR FOR GAS COOKTOP

INTERIOR TRIM AND DOORS

Invoice	Qty.	Description
2334 24Jul20 NoCat	1	.DELETE KITCHEN BULKHEAD, IF POSSIBLE, SITE APPROVAL REQUIRED
2334 24Jul20 NoCat	1	.STUDY - OPT. 8 FOOT HIGH DOUBLE FRENCH DOORS WITH FLAT CLEAR GLASS COMPLETE WITH BUILDERS STANDARD OFFERINGS

DisciplineMS.rpt 26jun20

Page 3 of 5
Printed and Sent: 24-Jul-20

**Lot: 157****Model: 40.03 B BROOKSIDE****Project/Phase: Pine Valley Forevergreen / 1**

KITCHEN AND BATH CABINETRY

Invoice	Qty.	Description
2334	1	.DELETE KITCHEN BULKHEAD, IF POSSIBLE, SITE APPROVAL REQUIRED
24Jul20 NoCat		

NETWORK AND WIRING

Invoice	Qty.	Description
2334 72,259 24Jul20	1	GREAT ROOM: CONDUIT PIPE - FOR WALL MOUNT TV - LOCATE APPROX. 66" A.F.F. ABOVE FIREPLACE, THRU BASEMENT AND TERMINATING AT CABLE LOCATION - SEE PLAN
2334 72,264 24Jul20	1	MUD ROOM: ROUGH - IN FOR EXTRA SECURITY KEY PAD

PAINT

Invoice	Qty.	Description
2334 24Jul20 NoCat	1	.DELETE KITCHEN BULKHEAD, IF POSSIBLE, SITE APPROVAL REQUIRED
2334 24Jul20 NoCat	1	.STUDY - OPT. 8 FOOT HIGH DOUBLE FRENCH DOORS WITH FLAT CLEAR GLASS COMPLETE WITH BUILDERS STANDARD OFFERINGS

PLUMBING

Invoice	Qty.	Description
2286 24Jul20 NoCat	1	.BACK-FLOW PREVENTER VALVE
2334 72,332 24Jul20	1	KITCHEN: ROUGH-IN 1/4" COLD WATER LINE TO FRIDGE
2334 72,334 24Jul20	1	DINING ROOM SIDE OF HOUSE: ADDITIONAL HOSE BIB - COLD WATER SUPPLY ONLY SEE PLAN FOR LOCATION



CONSTRUCTION SUMMARY

Lot: 157

Model: 40.03 B BROOKSIDE

Project/Phase: Pine Valley Forevergreen / 1

WINDOWS - BASEMENT

Invoice	Qty.	Description
2286 72,672 24Jul20	2	.DELETE BASEMENT WINDOWS - EGRESS BASEMENT WINDOW 47 " X 35" - 8" FRAME REAR ONLY
2286 72,351 24Jul20	1	.BASEMENT WINDOWS - UPGRADE BASEMENT WINDOW SIZE TO 30 " X 24" - 8" FRAME SIDE ONLY
2405 72,351 24Jul20	2	.BASEMENT WINDOWS - UPGRADE BASEMENT WINDOW SIZE TO 30 " X 24" - 8" FRAME

SCHEDULE 'F'




7V-157 *see attach*
April 13 2020
MAY 11 2020 *see attached*

The Brookside

40' SERIES

Elevation A • 3,380 sq.ft.

→ Elevation B • 3,350 sq.ft.

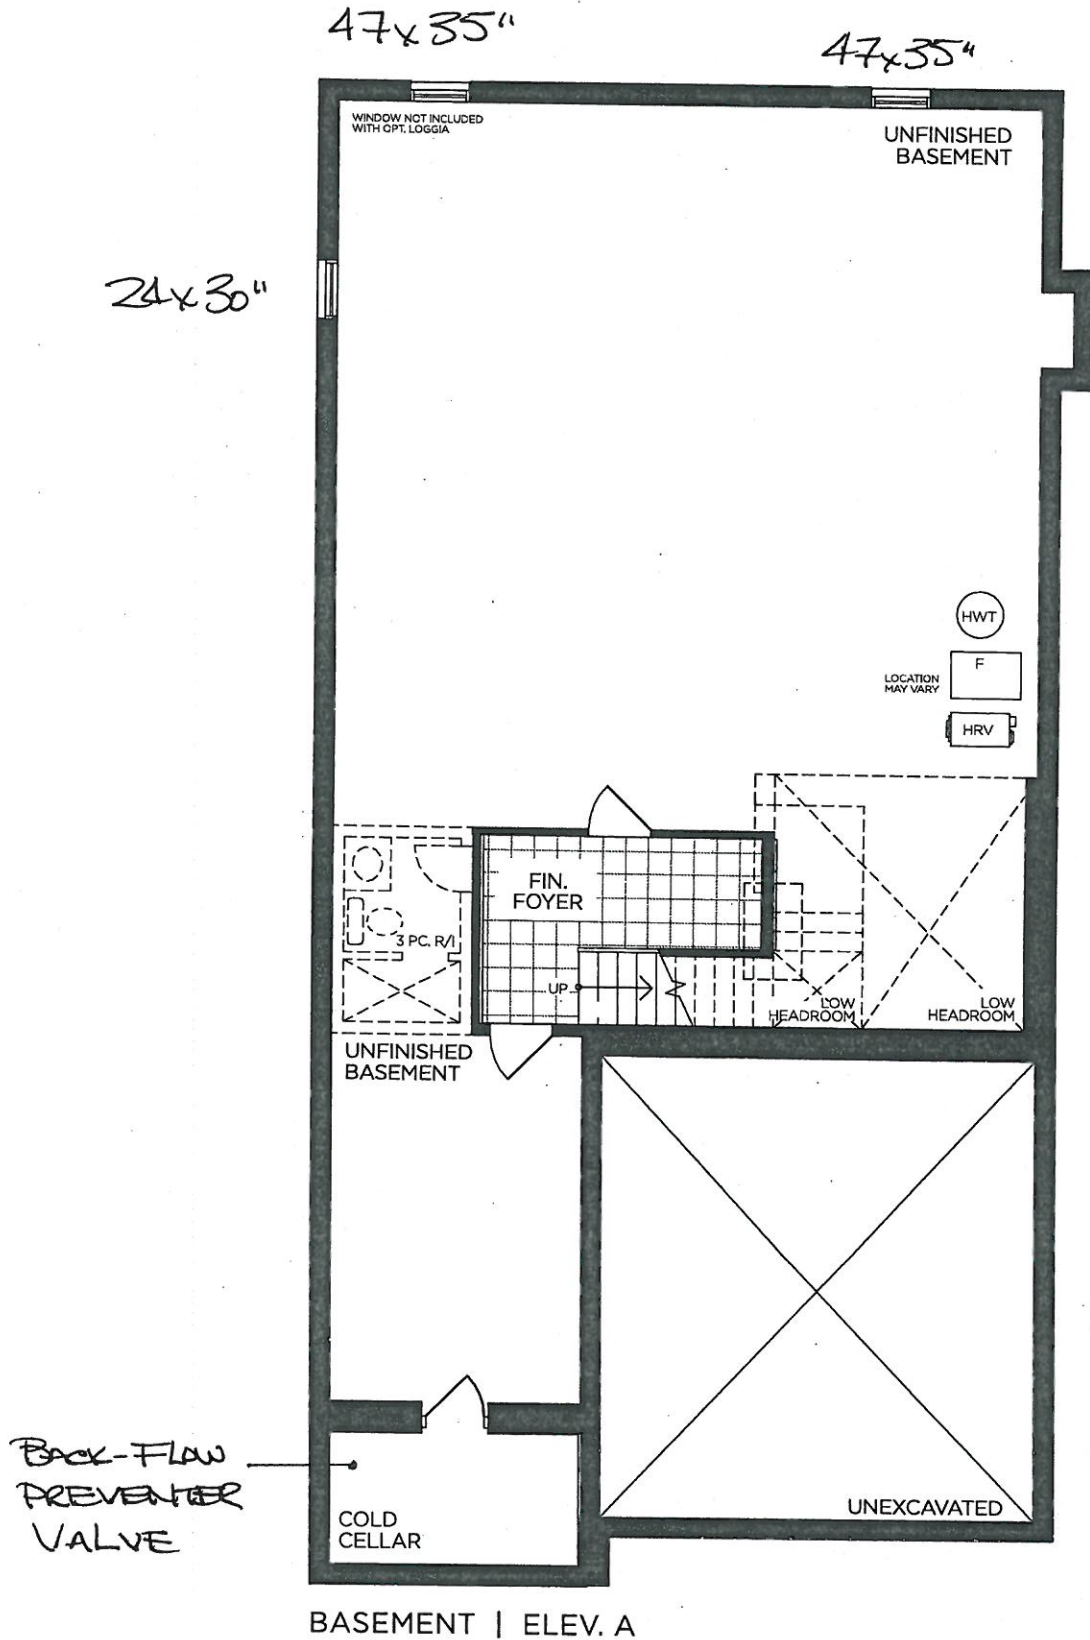

BASEMENT | ELEV. A

VENDOR

PURCHASER

PURCHASER

GOLDPARK
WORTH MORE™

Prices, figures, illustrations, sizes, features and finishes are subject to change without notice. Areas and dimensions are approximate and actual usable floor space may vary from the stated area. Layout may be reverse of the unit purchased. E. & O.E. 4003



SCHEDULE 'F'


PN-157
APRIL 13 2020
MAY 11 2020 *(see attached)*

The Brookside

40' SERIES

Elevation A • 3,380 sq.ft.

→ Elevation B • 3,350 sq.ft.

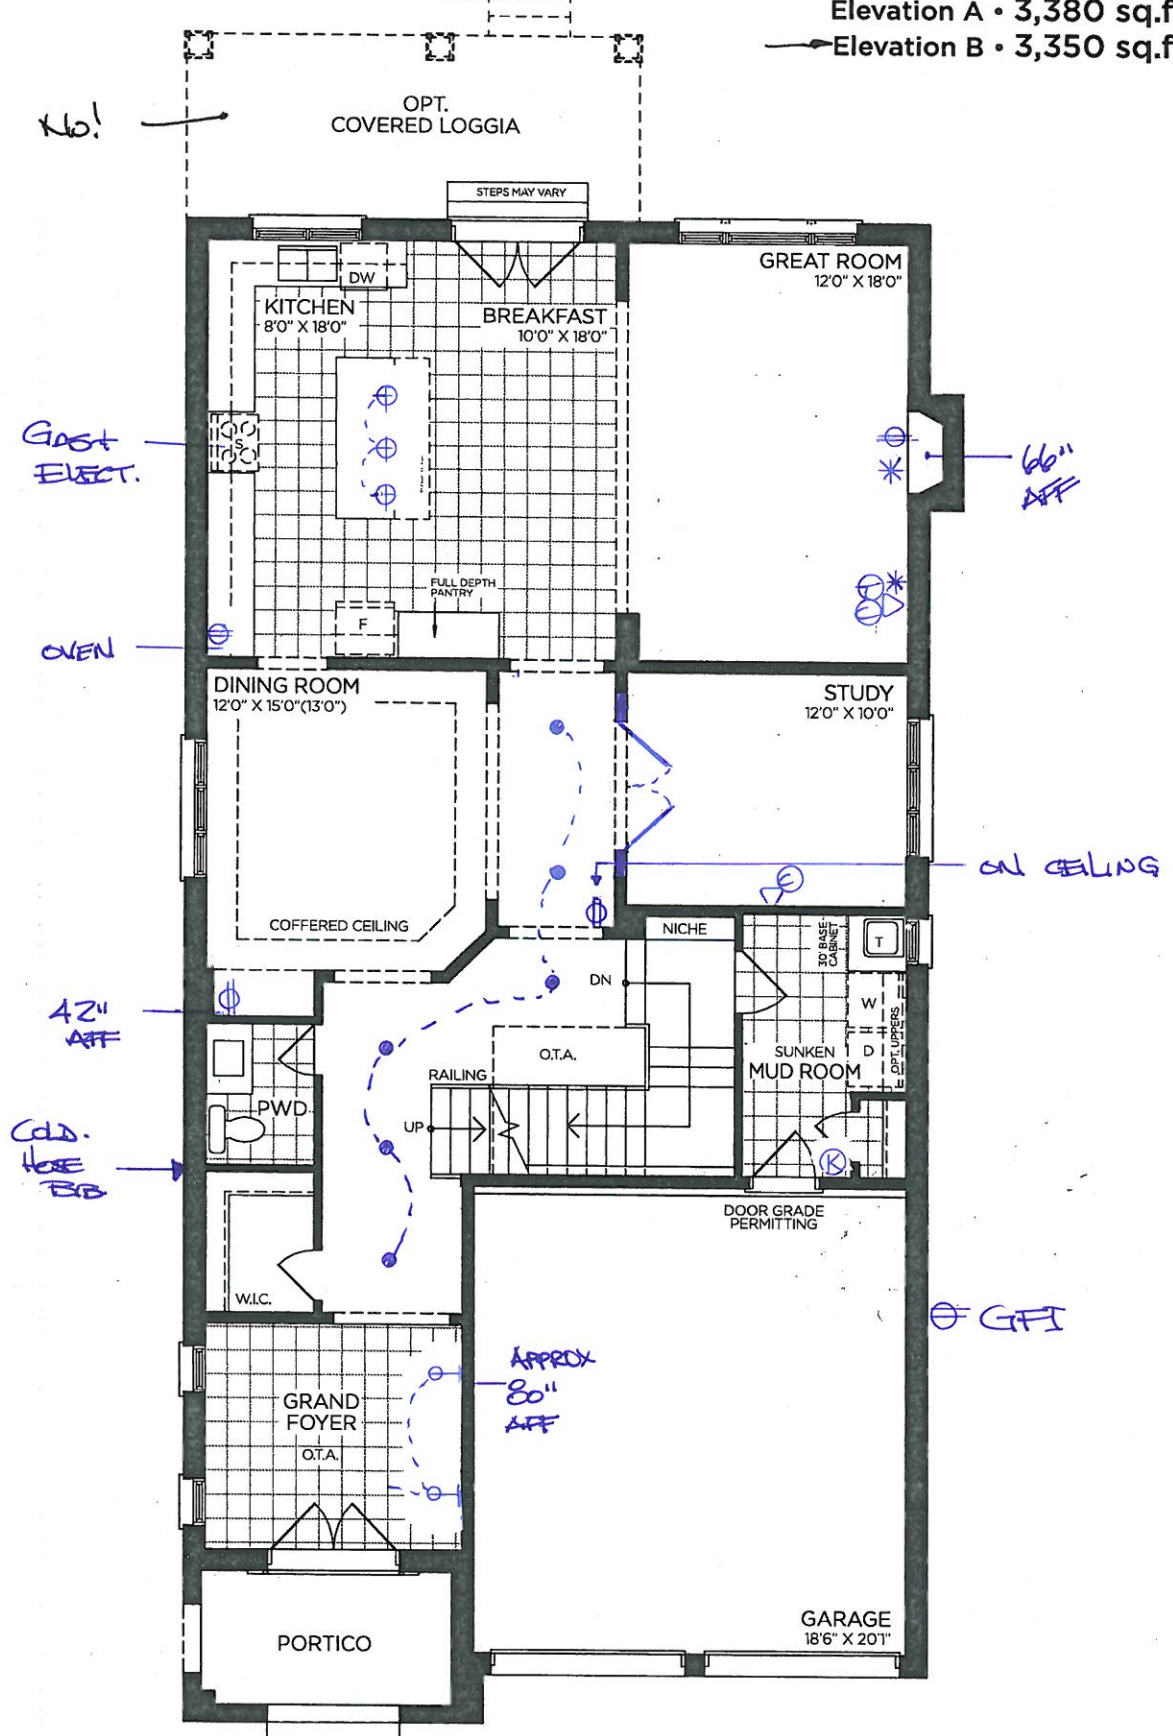

GROUND FLOOR | ELEV. A

VENDOR	
PURCHASER	
PURCHASER	

GOLDPARK

WORTH MORE™

Prices, figures, illustrations, sizes, features and finishes are subject to change without notice. Areas and dimensions are approximate and actual usable floor space may vary from the stated area. Layout may be reverse of the unit purchased. E. & O.E. 4003


SCHEDULE 'F'



see attached
PV-157
April 13 2020
see attached
MAY 11 2020

The Brookside
40' SERIES

Elevation A • 3,380 sq.ft.
→ Elevation B • 3,350 sq.ft.

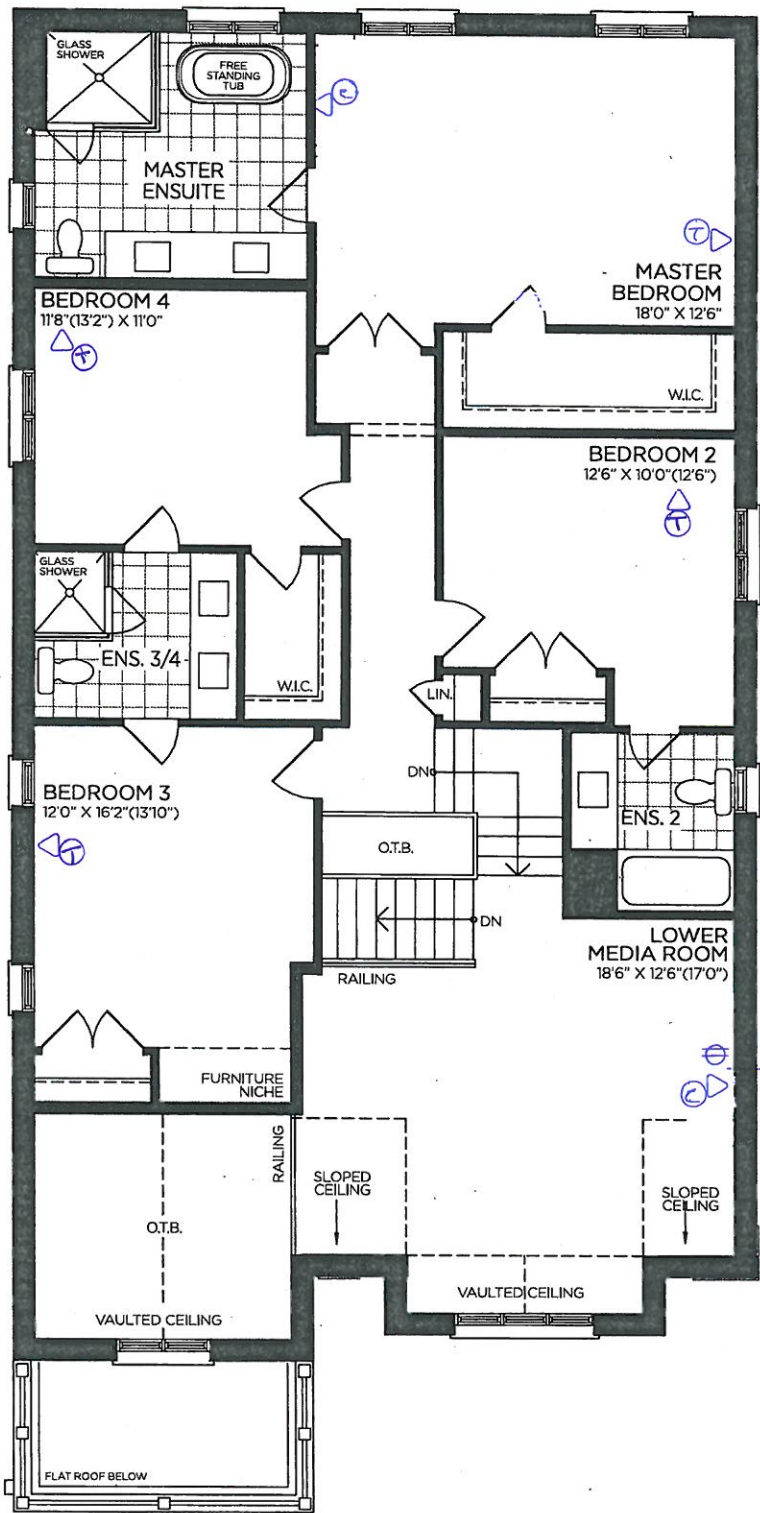

SECOND FLOOR | ELEV. A

VENDOR	
PURCHASER	
PURCHASER	

GOLDPARK
WORTH MORE™

Prices, figures, illustrations, sizes, features and finishes are subject to change without notice. Areas and dimensions are approximate and actual usable floor space may vary from the stated area. Layout may be reverse of the unit purchased. E. & O.E. 4003


SCHEDULE 'F'




PV-157 ~~See attached~~
MAY 11 2020

The Brookside
40' SERIES


Elevation A • 3,380 sq.ft.
→ Elevation B • 3,350 sq.ft.

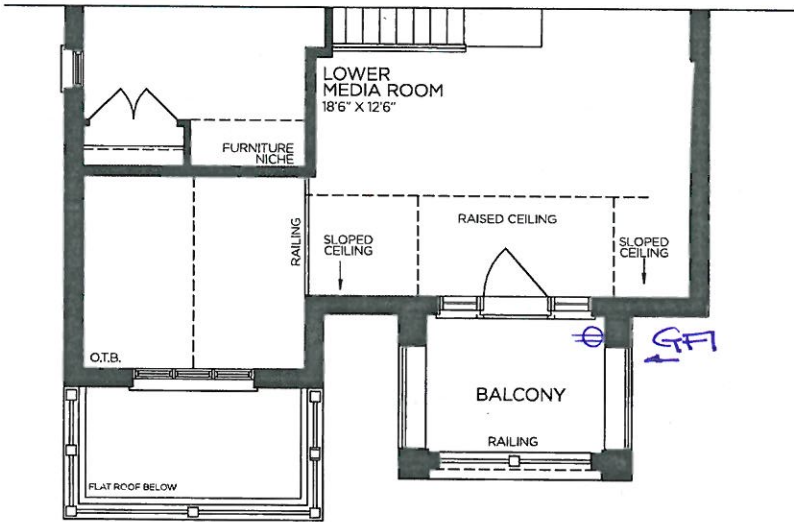


→ PART. SECOND FLOOR | ELEV. B

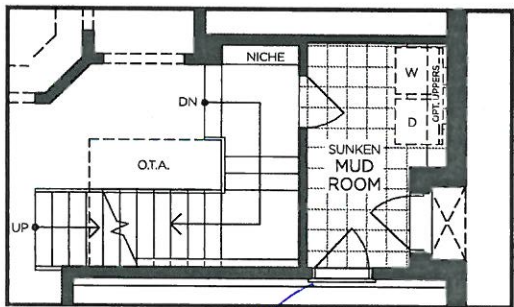

PART. OPT. GROUND FLOOR
W/ OPT. SIDE ENTRANCE | ELEV. A
(ELEV. B SIMILAR)

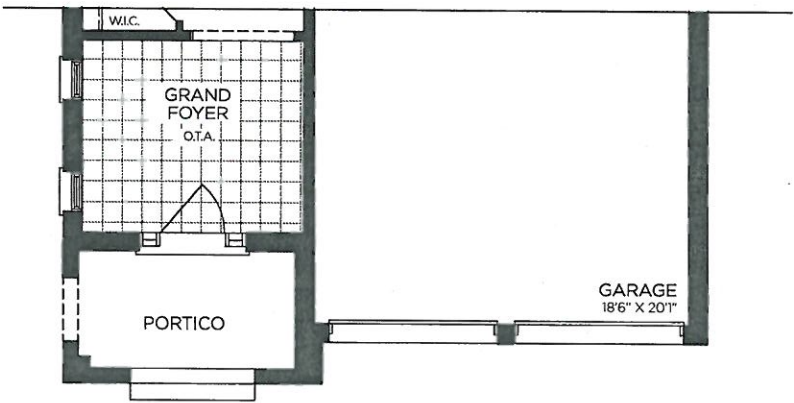

→ PART. GROUND FLOOR | ELEV. B

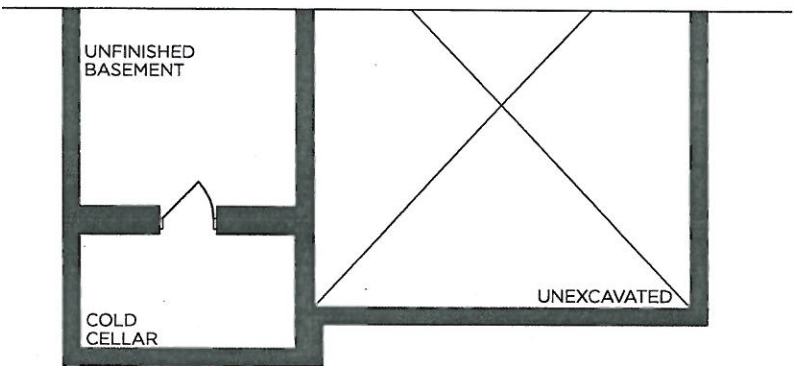

→ PART. BASEMENT | ELEV. B

VENDOR

PURCHASER

PURCHASER

GOLDPARK
WORTH MORE™

Prices, figures, illustrations, sizes, features and finishes are subject to change without notice. Areas and dimensions are approximate and actual usable floor space may vary from the stated area. Layout may be reverse of the unit purchased. E. & O.E. 4003

SCHEDULE 'F'




7V-157 *see sketch*
April 13 2020
MAY 11 2020

The
Brookside
40' SERIES
Elevation A • 3,380 sq.ft.
Elevation B • 3,350 sq.ft.

47x35"

may 11, 2020
47x35"

24x30"

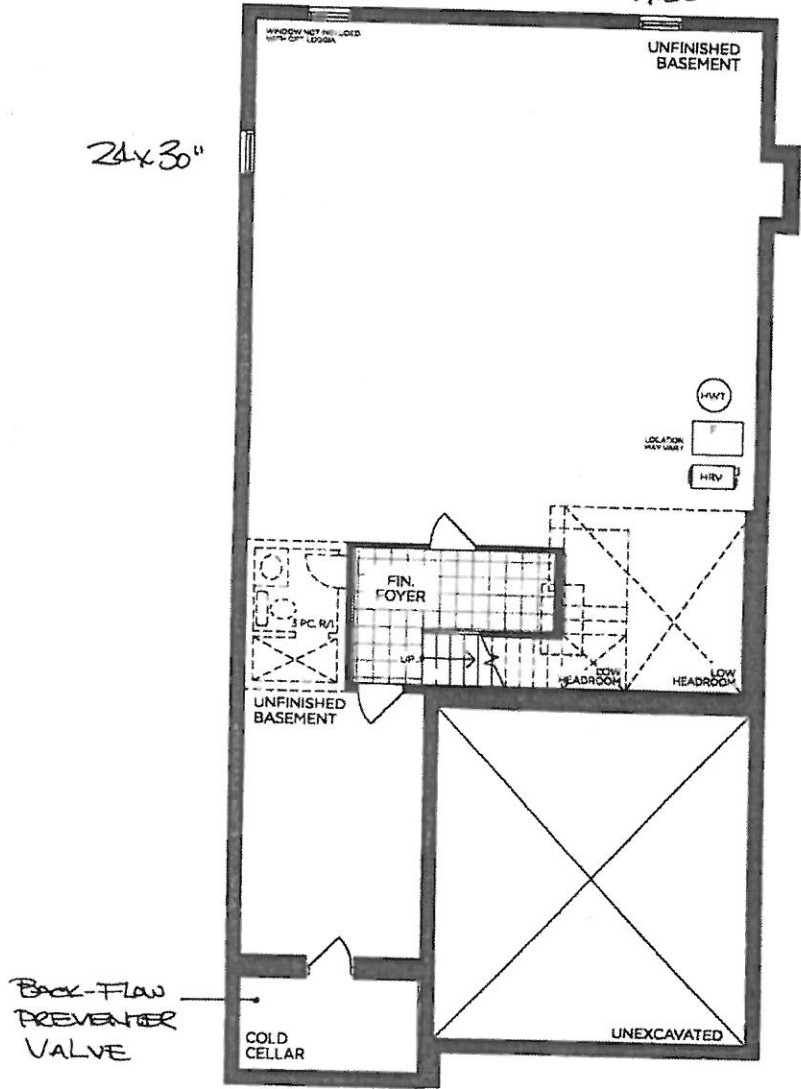

BASEMENT | ELEV. A

VENDOR
PURCHASER
PURCHASER

GOLDPARK
WORTH MORE™


Prices, figures, illustrations, sizes, features and finishes are subject to change without notice. Areas and dimensions are approximate and actual usable floor space may vary from the stated area. Layout may be reverse of the unit purchased E & OE 4003



SCHEDULE 'F'

see sketch
PV-157
APRIL 13 2020
MAY 11 2020

The Brookside
40' SERIES
Elevation A • 3,380 sq.ft.
Elevation B • 3,350 sq.ft.

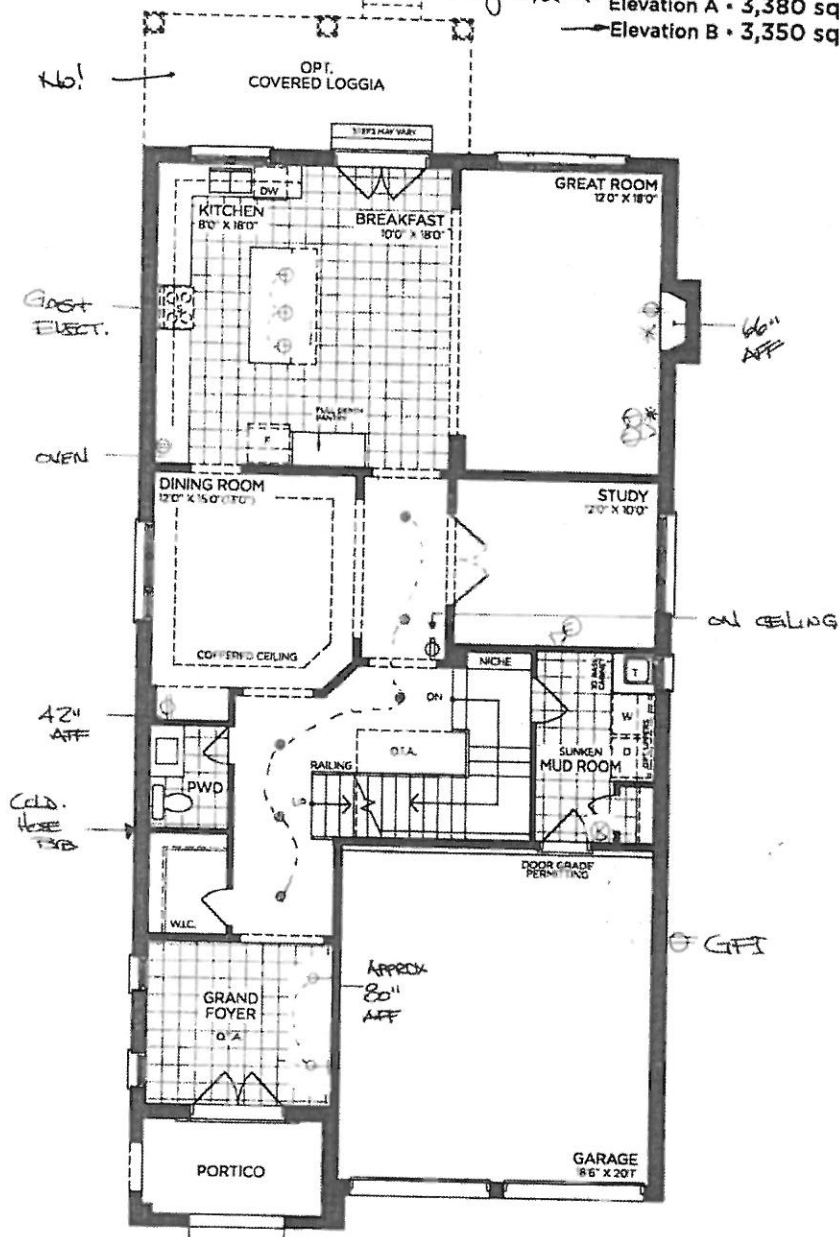

GROUND FLOOR | ELEV. A

VENDOR

PURCHASER

PURCHASER

GOLDPARK
WORTH MORE™


Prices, figures, illustrations, sizes, features and finishes are subject to change without notice. Areas and dimensions are approximate and actual usable floor space may vary from the stated area. Layout may be reverse of the unit purchased. E. & O.E. 4003

SCHEDULE 'F'



PV-157
 April 13 2020
 May 11 2020
 May 11 2020

The Brookside
 40' SERIES
 Elevation A • 3,380 sq.ft.
 Elevation B • 3,350 sq.ft.

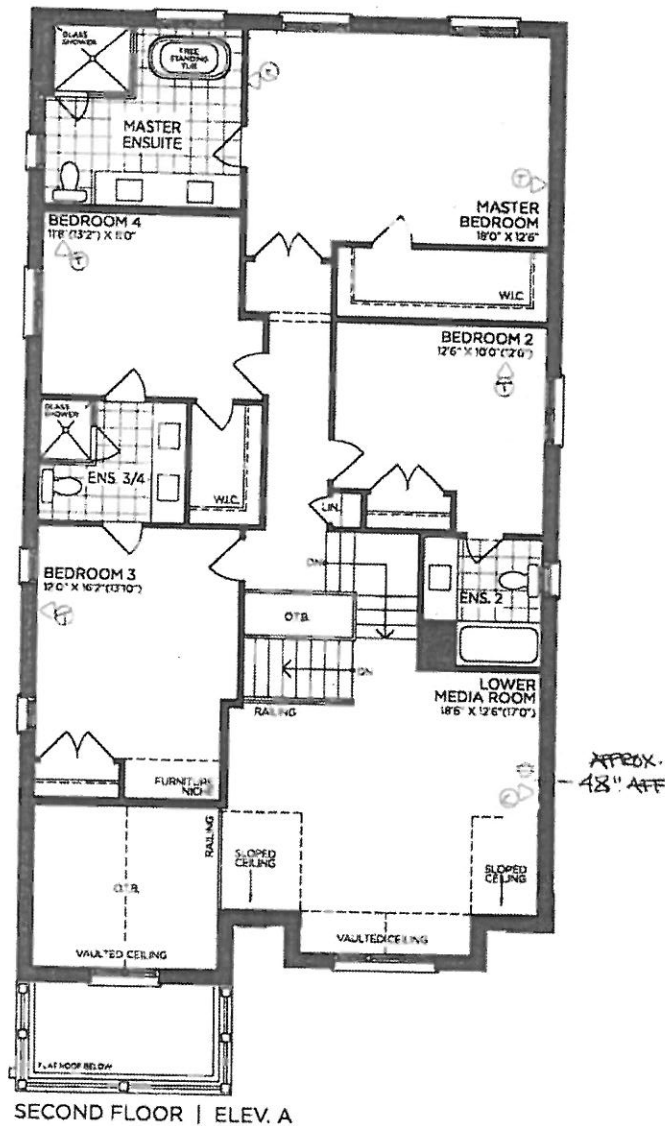

VENDOR

PURCHASER

PURCHASER


GOLDPARK
 WORTH MORE

Prices, figures, illustrations, sizes, features and finishes are subject to change without notice. Areas and dimensions are approximate and actual usable floor space may vary from the stated area. Layout may be reverse of the unit purchased. E. & O. E. 4003


SCHEDULE 'F'




PV-157
 MAY 11 2020
 MAY 11, 2020
The Brookside
 40' SERIES
 Elevation A • 3,380 sq.ft.
 Elevation B • 3,350 sq.ft.

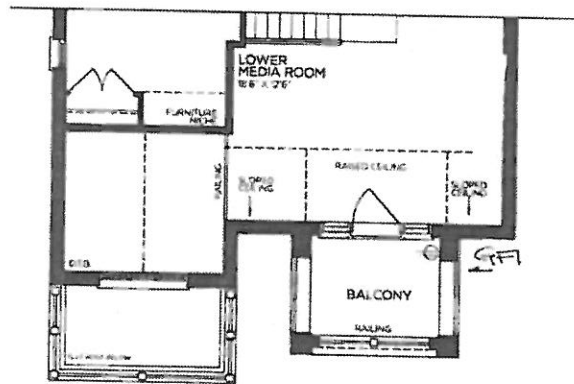


PART. SECOND FLOOR | ELEV. B

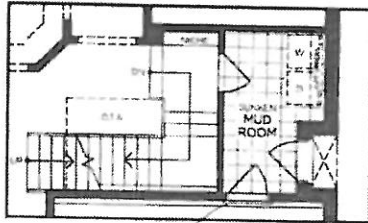

PART. OPT. GROUND FLOOR
W/ OPT. SIDE ENTRANCE | ELEV. A
(ELEV. B SIMILAR)

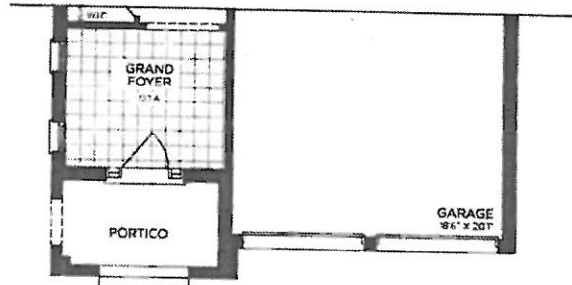

PART. GROUND FLOOR | ELEV. B

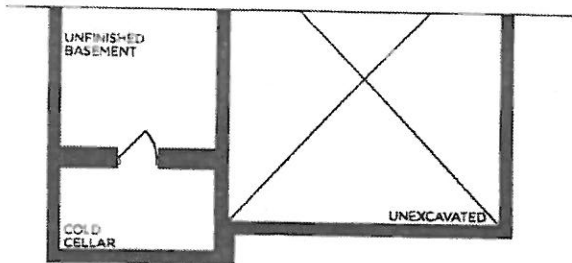

PART. BASEMENT | ELEV. B

VENDOR
 PURCHASER
 PURCHASER

GOLDPARK
WORTH MORE™

Prices, figures, illustrations, sizes, features and finishes are subject to change without notice. Areas and dimensions are approximate and actual usable floor space may vary from the stated area. Layout may be reverse of the unit purchased. E. & O.E. 4003