

**Lot: 134****Model: 40.03 A BROOKSIDE****Project/Phase: Pine Valley Forevergreen / 1**

ELECTRICAL

Invoice	Qty.	Description
2393 72,273 24Jul20	1	.KITCHEN: 110V WALL RECEPTACLE ON SEPARATE CIRCUIT - GAS FIRED APPLIANCE - FOR AUX. EQUIPMENT - NOT A STOVE PLUG
2393 72,289 24Jul20	6	.KITCHEN: 4" E/S LED INTERIOR POT LIGHT - GROUND FLOOR - EACH INCLUDED IN APS - INCLUDES 1 SWITCH
2393 72,289 24Jul20	2	.KITCHEN: 4" E/S LED INTERIOR POT LIGHT - GROUND FLOOR - EACH SAME SWITCH AS STANDARD
2393 72,310 24Jul20	2	.UPPER HALL: UPGRADE STANDARD CEILING MOUNT FIXTURE TO (1) LED POT LIGHT - SECOND FLOOR - SEE PLAN
2393 72,290 24Jul20	3	.UPPER HALL: 4" E/S LED INTERIOR POT LIGHT (INSULATED CEILING) - SECOND FLOOR - EACH USE SAME SWITCH AS STANDARD

FORMING

Invoice	Qty.	Description
2260 72,678 24Jul20	2	.DELETE BASEMENT WINDOWS - EGRESS BASEMENT WINDOW 47 " X 35" - 10" FRAME (PINEVALLEY 50 FOOT LOTS ONLY)
2260 24Jul20 NoCat	1	.BASEMENT WINDOWS - UPGRADE BASEMENT WINDOW SIZE TO 30 " X 24" - 10" FRAME (PINEVALLEY 50 FOOT LOTS ONLY)
2393 72,678 24Jul20	-2	.DELETE BASEMENT WINDOWS - EGRESS BASEMENT WINDOW 47 " X 35" - 10" FRAME (PINEVALLEY 50 FOOT LOTS ONLY) DELETE FROM ORDER PE#2260
2393 24Jul20 NoCat	2	.BASEMENT WINDOWS - UPGRADE BASEMENT WINDOW SIZE TO 30 " X 24" - 8" FRAME

**Lot: 134****Model: 40.03 A BROOKSIDE****Project/Phase: Pine Valley Forevergreen / 1**

PAINT

Invoice	Qty.	Description
2393 24Jul20 NoCat	1	.GREAT ROOM - OPT. COFFERED CEILING AS PER PLAN
2393 24Jul20 NoCat	1	.GREAT ROOM - OPT. WAFFLE CEILING , BEAM DETAIL AS PER PLAN (6 BOXES) OPTION # 1 CTR-B07
2393 24Jul20 NoCat	1	.STUDY- OPT. WAFFLE CEILING , BEAM DETAIL AS PER PLAN (4 BOXES) OPTION # 1 CTR-B07
2393 24Jul20 NoCat	1	.MASTER BEDROOM - OPT. 10 FOOT TRAY CEILING
2393 24Jul20 NoCat	16	.2ND FLOOR: INCREASE HEIGHT OF DOOR TO 8FT SECOND FLOOR - PER DOOR

PLUMBING

Invoice	Qty.	Description
2393	1	.MASTER ENSUITE: MOEN `ARRIS` POSI-TEMP 3-FUNCTION RAIN SHOWER (from ceiling) + HAND SHOWER + SLIDE BAR - CHROME #TS22002EP/3372/TS23005/62320/3887EP/A725
24Jul20 NoCat		

WINDOWS - BASEMENT

Invoice	Qty.	Description
2260 72,675 24Jul20	1	.BASEMENT WINDOWS - UPGRADE BASEMENT WINDOW SIZE TO 30 " X 24" - 10" FRAME (PINEVALLEY 50 FOOT LOTS ONLY)
2393 72,351 24Jul20	2	.BASEMENT WINDOWS - UPGRADE BASEMENT WINDOW SIZE TO 30 " X 24" - 8" FRAME

WINDOWS AND DOORS

Invoice	Qty.	Description
2393	1	.BREAKFAST ROOM: UPGRADE EXTERIOR FRENCH DOOR ASSEMBLY TO 96" HEIGHT
24Jul20 NoCat		



SCHEDULE 'F'

June 15 2026

PV-13A


March 30 2026

The Brookside

40' SERIES

Elevation A • 3,380 sq.ft.

Elevation B • 3,350 sq.ft.

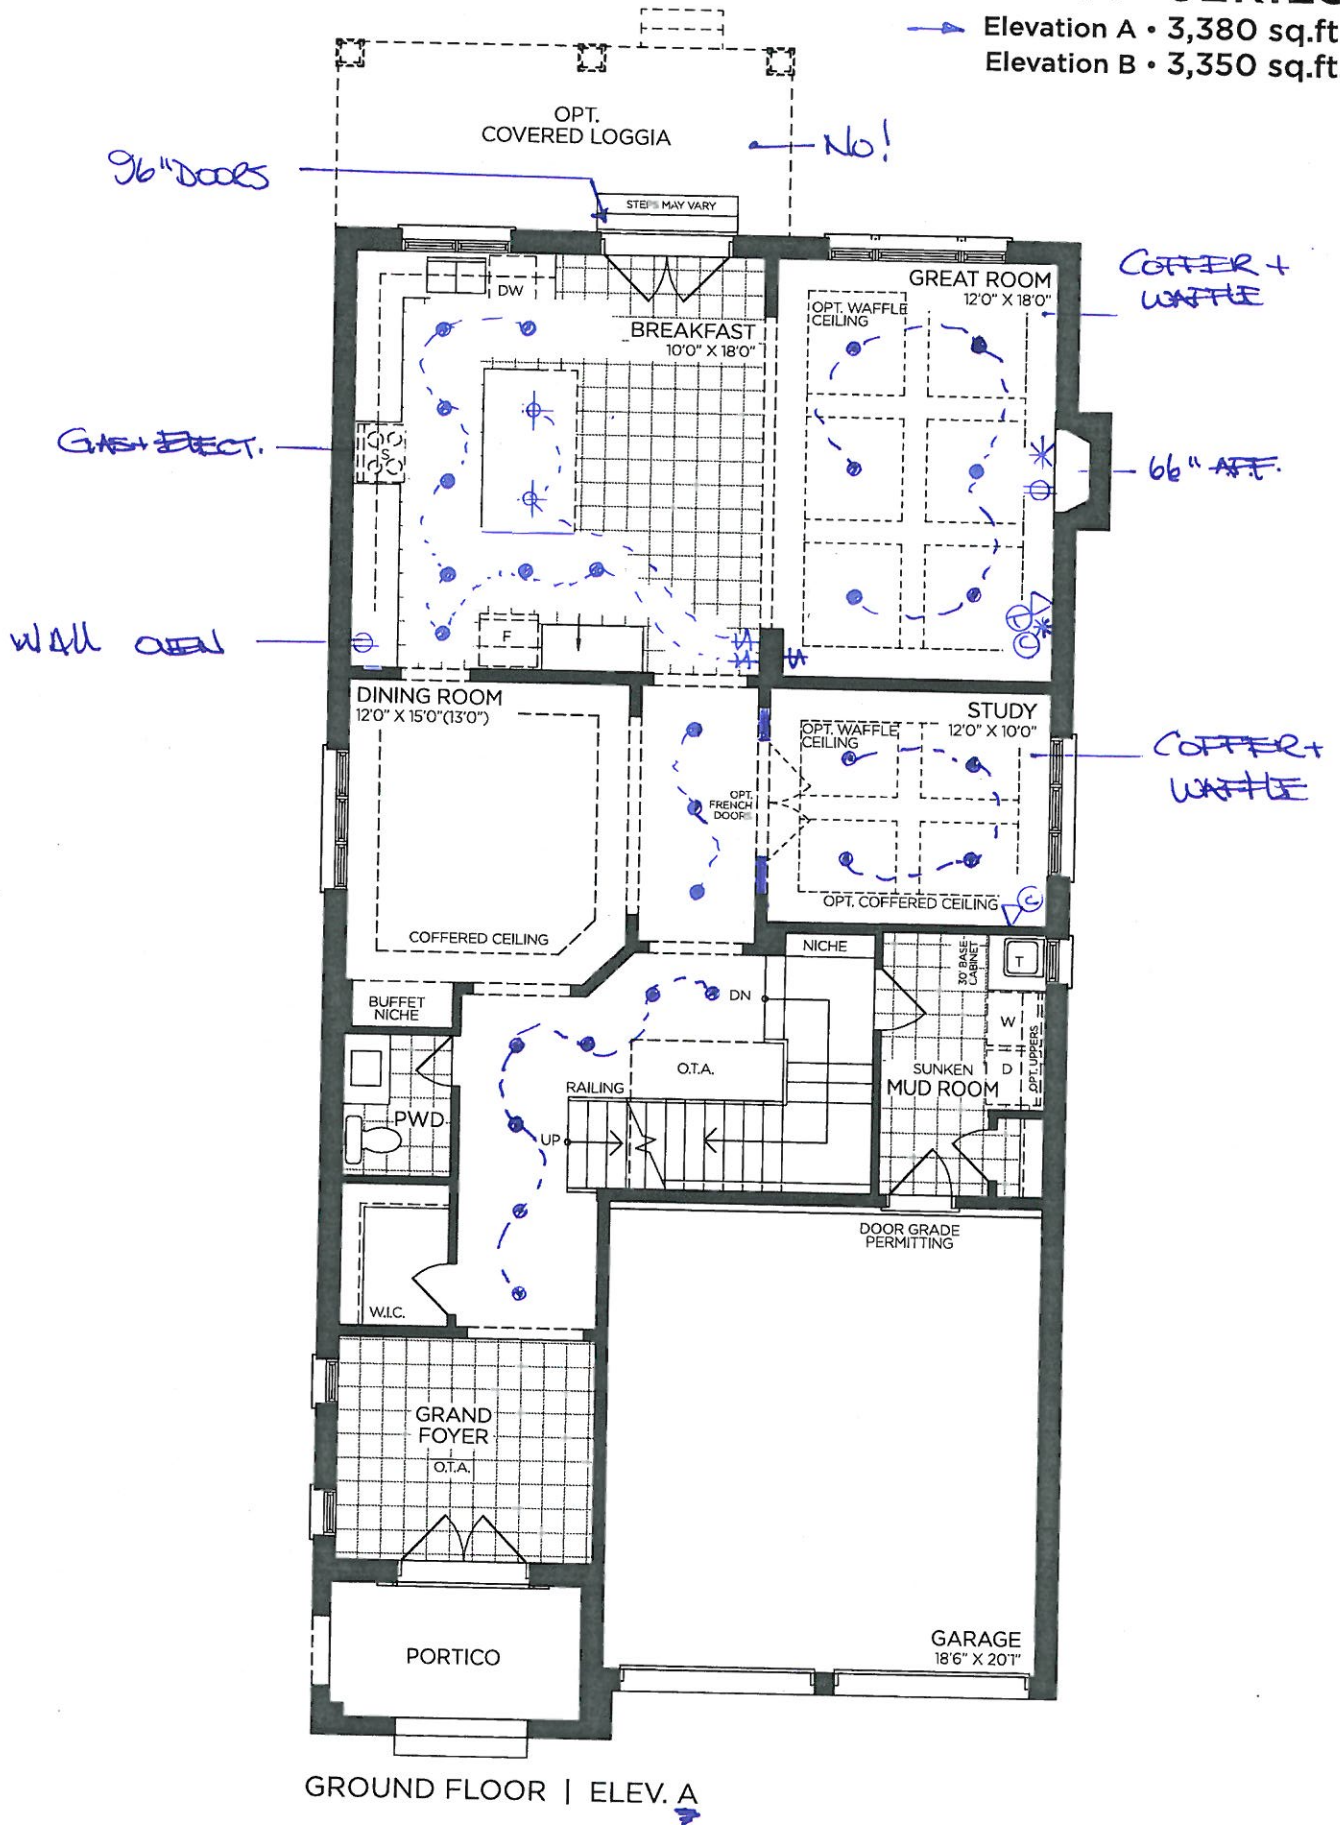

VENDOR

PURCHASER

PURCHASER

GOLDPARK
WORTH MORE™

Prices, figures, illustrations, sizes, features and finishes are subject to change without notice. Areas and dimensions are approximate and actual usable floor space may vary from the stated area. Layout may be reverse of the unit purchased. E. & O.E. 4003


SCHEDULE 'F'



PV-134
 March 30 2020
 June 15 2020

The Brookside 40' SERIES

→ Elevation A • 3,380 sq.ft.
 Elevation B • 3,350 sq.ft.

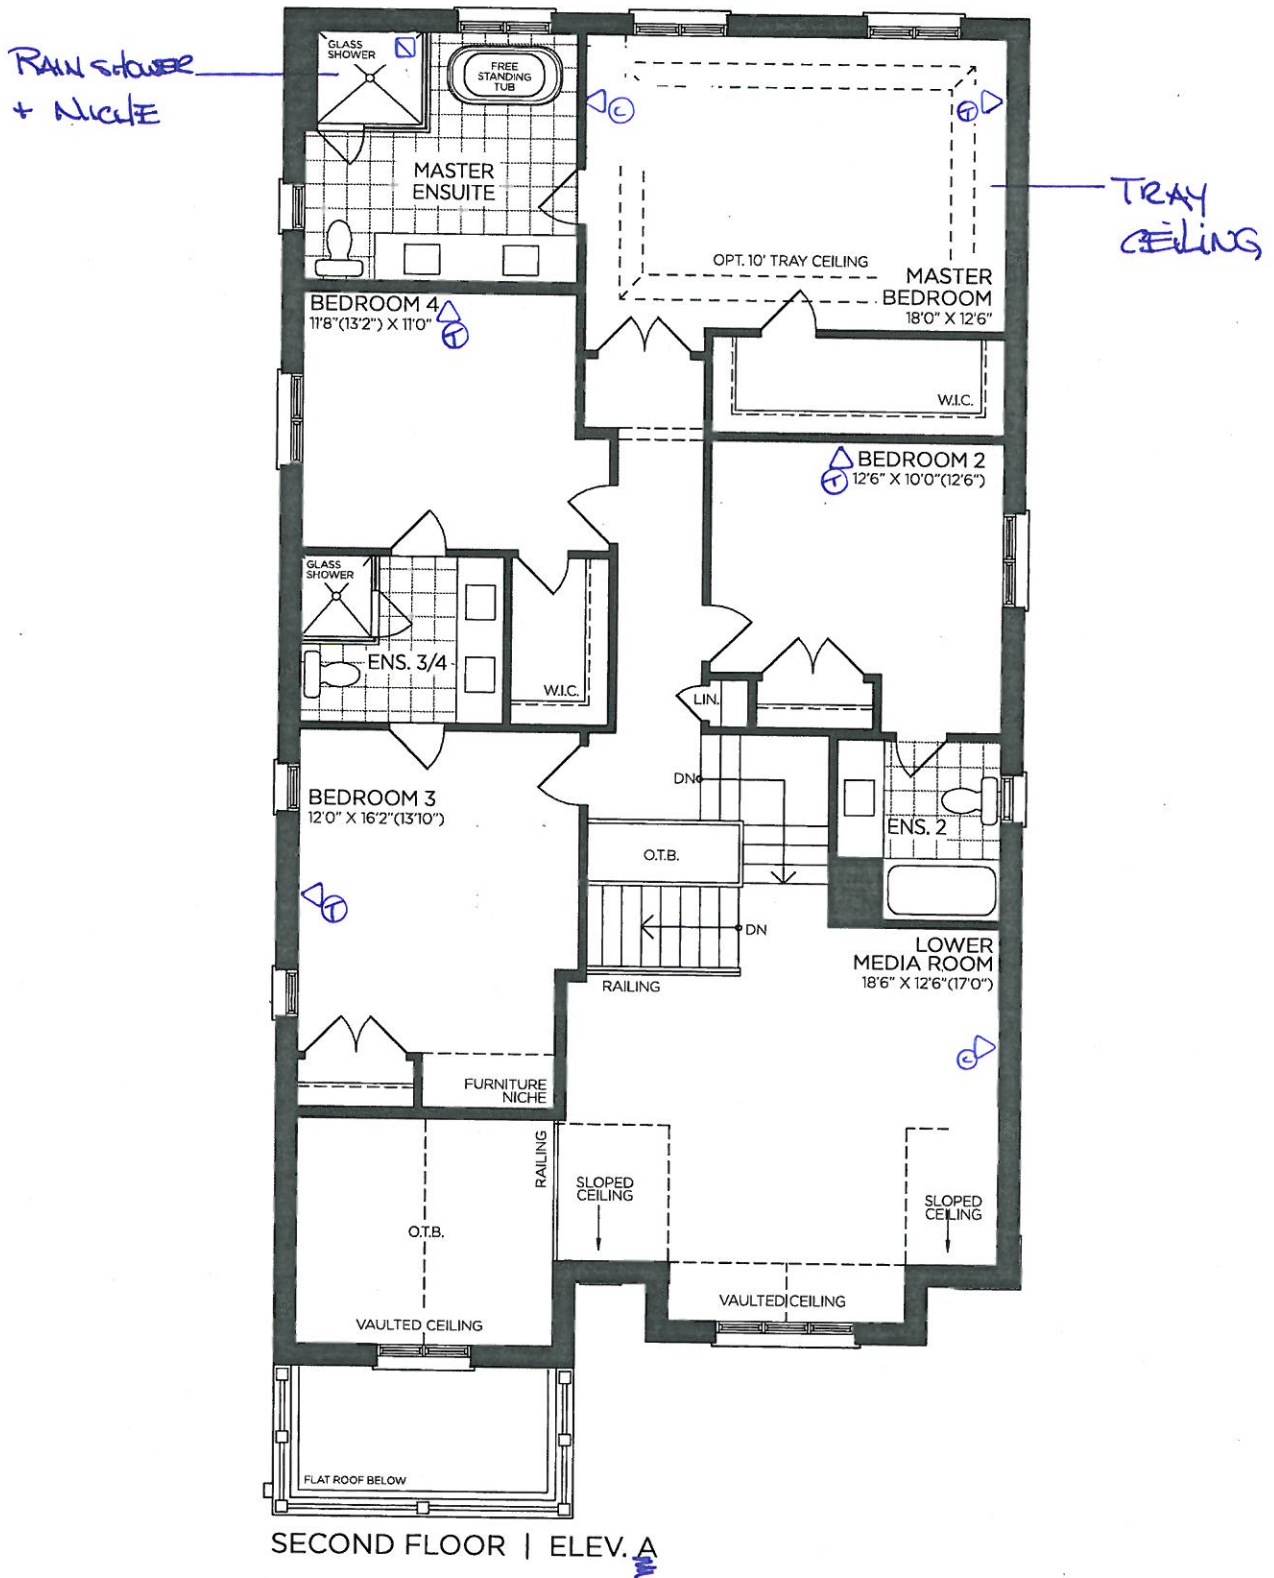

VENDOR

PURCHASER

PURCHASER

GOLDPARK
 WORTH MORE™

Prices, figures, illustrations, sizes, features and finishes are subject to change without notice. Areas and dimensions are approximate and actual usable floor space may vary from the stated area. Layout may be reverse of the unit purchased. E. & O.E. 4003

SCHEDULE 'F'



June 15 2020
PV-134.
March 30 2020


The Brookside
40' SERIES

→ Elevation A • 3,380 sq.ft.
Elevation B • 3,350 sq.ft.

24x30"
~~35x47~~

24x30"
~~35x47~~

24x30"

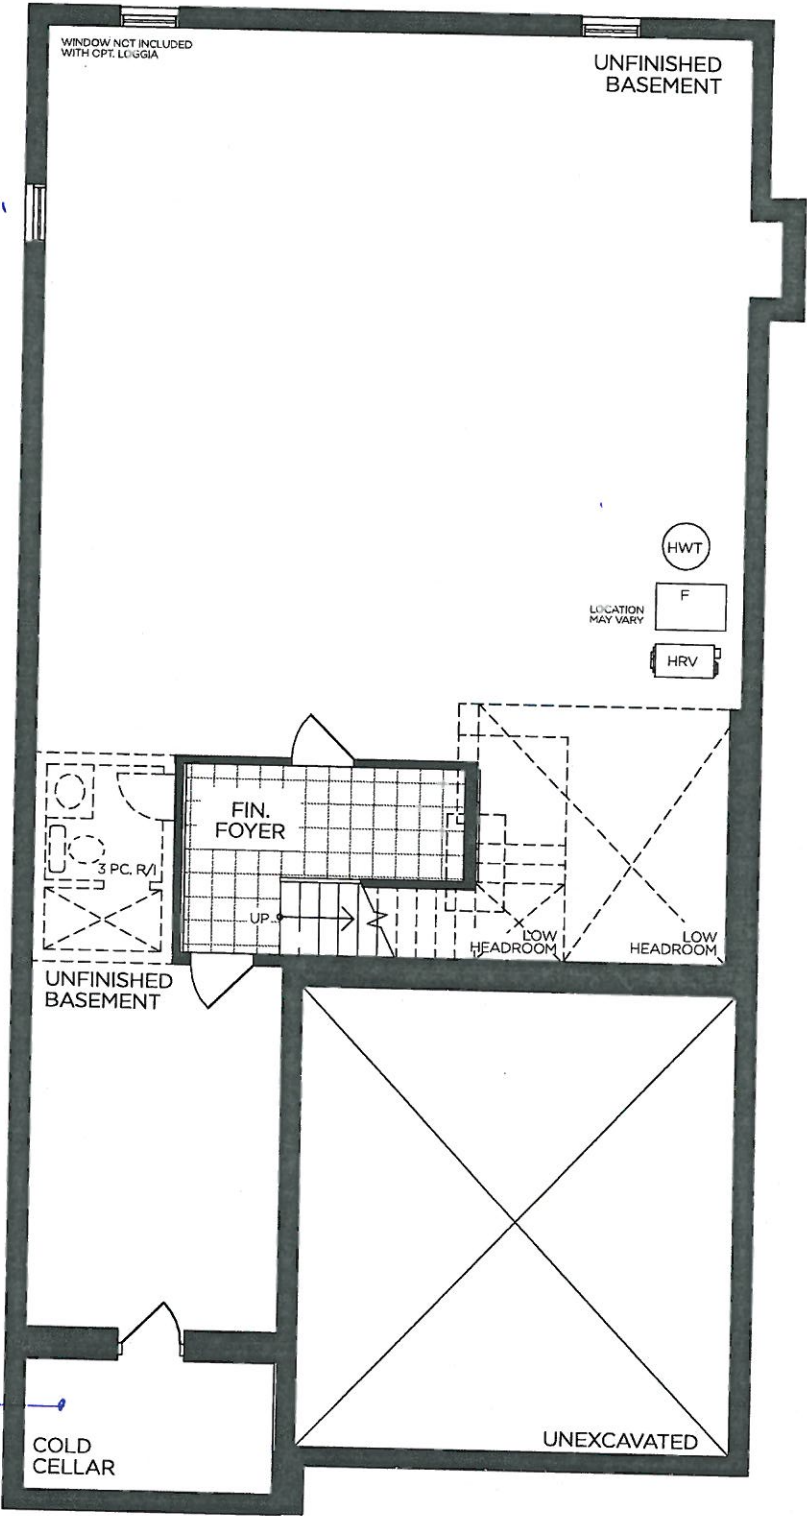

BASEMENT | ELEV. A

VENDOR

PURCHASER

PURCHASER

GOLDPARK
WORTH MORE™

Prices, figures, illustrations, sizes, features and finishes are subject to change without notice. Areas and dimensions are approximate and actual usable floor space may vary from the stated area. Layout may be reverse of the unit purchased. E. & O.E. 4003