

GOLDPARK

WORTH MORE™

CONSTRUCTION SUMMARY

Lot: 107

Model: 50.05 A KNIGHTSWOOD

Project/Phase: Pine Valley Forevergreen / 1

INTERIOR TRIM AND DOORS

Invoice	Qty.	Description
2378 27Jul20 NoCat	1	.LIBRARY - OPT. COFFERED CEILING AS PER PLAN
2378 27Jul20 NoCat	1	.LIBRARY - OPT. WAFFLE CEILING, BEAM DETAIL AS PER PLAN (6 BOXES) OPTION # 1 CTR-B07
2378 27Jul20 NoCat	1	.GREAT ROOM: UPGRADE MAIN FLOOR LINEAR 1 SIDED FIREPLACE - JADE SERIES 42" LINEAR DIRECT VENT GAS FIREPLACE, INCLUDES ELECTRICAL NOT INCLUSIVE OF MANTEL SURROUND [INCLUDES REQUIRED EXHAUST GRILL - APPROX 20" FROM CEILING]
2378 27Jul20 NoCat	27	.INCREASE HEIGHT OF DOOR TO 8FT SECOND FLOOR - PER DOOR

NETWORK AND WIRING

Invoice	Qty.	Description
2378 72,259 27Jul20	1	.GREAT ROOM: CONDUIT PIPE - FOR WALL MOUNT TV - LOCATE ABOVE FIREPLACE, APPROX 66" A.F.F. THRU BASEMENT TERMINATING AT CABLE LOCATION .

PAINT

Invoice	Qty.	Description
2378 27Jul20 NoCat	1	.LIBRARY - OPT. COFFERED CEILING AS PER PLAN
2378 27Jul20 NoCat	1	.LIBRARY - OPT. WAFFLE CEILING, BEAM DETAIL AS PER PLAN (6 BOXES) OPTION # 1 CTR-B07
2378 27Jul20 NoCat	27	.INCREASE HEIGHT OF DOOR TO 8FT SECOND FLOOR - PER DOOR

PLUMBING

Invoice	Qty.	Description
2378 27Jul20 NoCat	1	.MASTER ENSUITE: MOEN `ARRIS` 3 FUNCTION RAIN SHOWER (from ceiling) + HAND SHOWER + SLIDE BAR #TS22002EP / 3372 / TS23005 / 62320 / 3887EP / A725 `MATTE BLACK`
2253 27Jul20 NoCat	1	.BACK-FLOW PREVENTER VALVE

DisciplineMS.rpt 26jun20

Page 5 of 6
Printed and Sent: 27-Jul-20

GOLDPARK

WORTH MORE™

CONSTRUCTION SUMMARY

Lot: 107

Model: 50.05 A KNIGHTSWOOD

Project/Phase: Pine Valley Forevergreen / 1

WINDOWS - BASEMENT

Invoice	Qty.	Description
2253 72,675 27Jul20	4	UPGRADE BASEMENT WINDOW SIZE TO 30 " X 24" - 10" FRAME (PINEVALLEY 50 FOOT LOTS ONLY)
2253 72,678 27Jul20	1	.BASEMENT WINDOWS - EGRESS BASEMENT WINDOW 47 " X 35" - 10" FRAME (PINEVALLEY 50 FOOT LOTS ONLY)

WINDOWS AND DOORS

Invoice	Qty.	Description
2378 27Jul20 NoCat	1	.**GREAT ROOM & CABANA** UPGRADE TO 8` EXTERIOR GARDEN DOOR ASSEMBLY

DisciplineMS.rpt 26jun20

Page 6 of 6
Printed and Sent: 27-Jul-20

SCHEDULE 'F'




PV-107
MAR 30 2020

JUNE 8 2020

The Knightswood 50' SERIES

→ Elevation A • 4,445 sq.ft.
4,475 sq.ft. Opt. Elevator / 4,575 sq.ft. Opt. Service Stairs
Elevation B • 4,440 sq.ft.
4,475 sq.ft. Opt. Elevator / 4,575 sq.ft. Opt. Service Stairs
Elevation C • 4,525 sq.ft.
4,560 sq.ft. Opt. Elevator / 4,660 sq.ft. Opt. Service Stairs

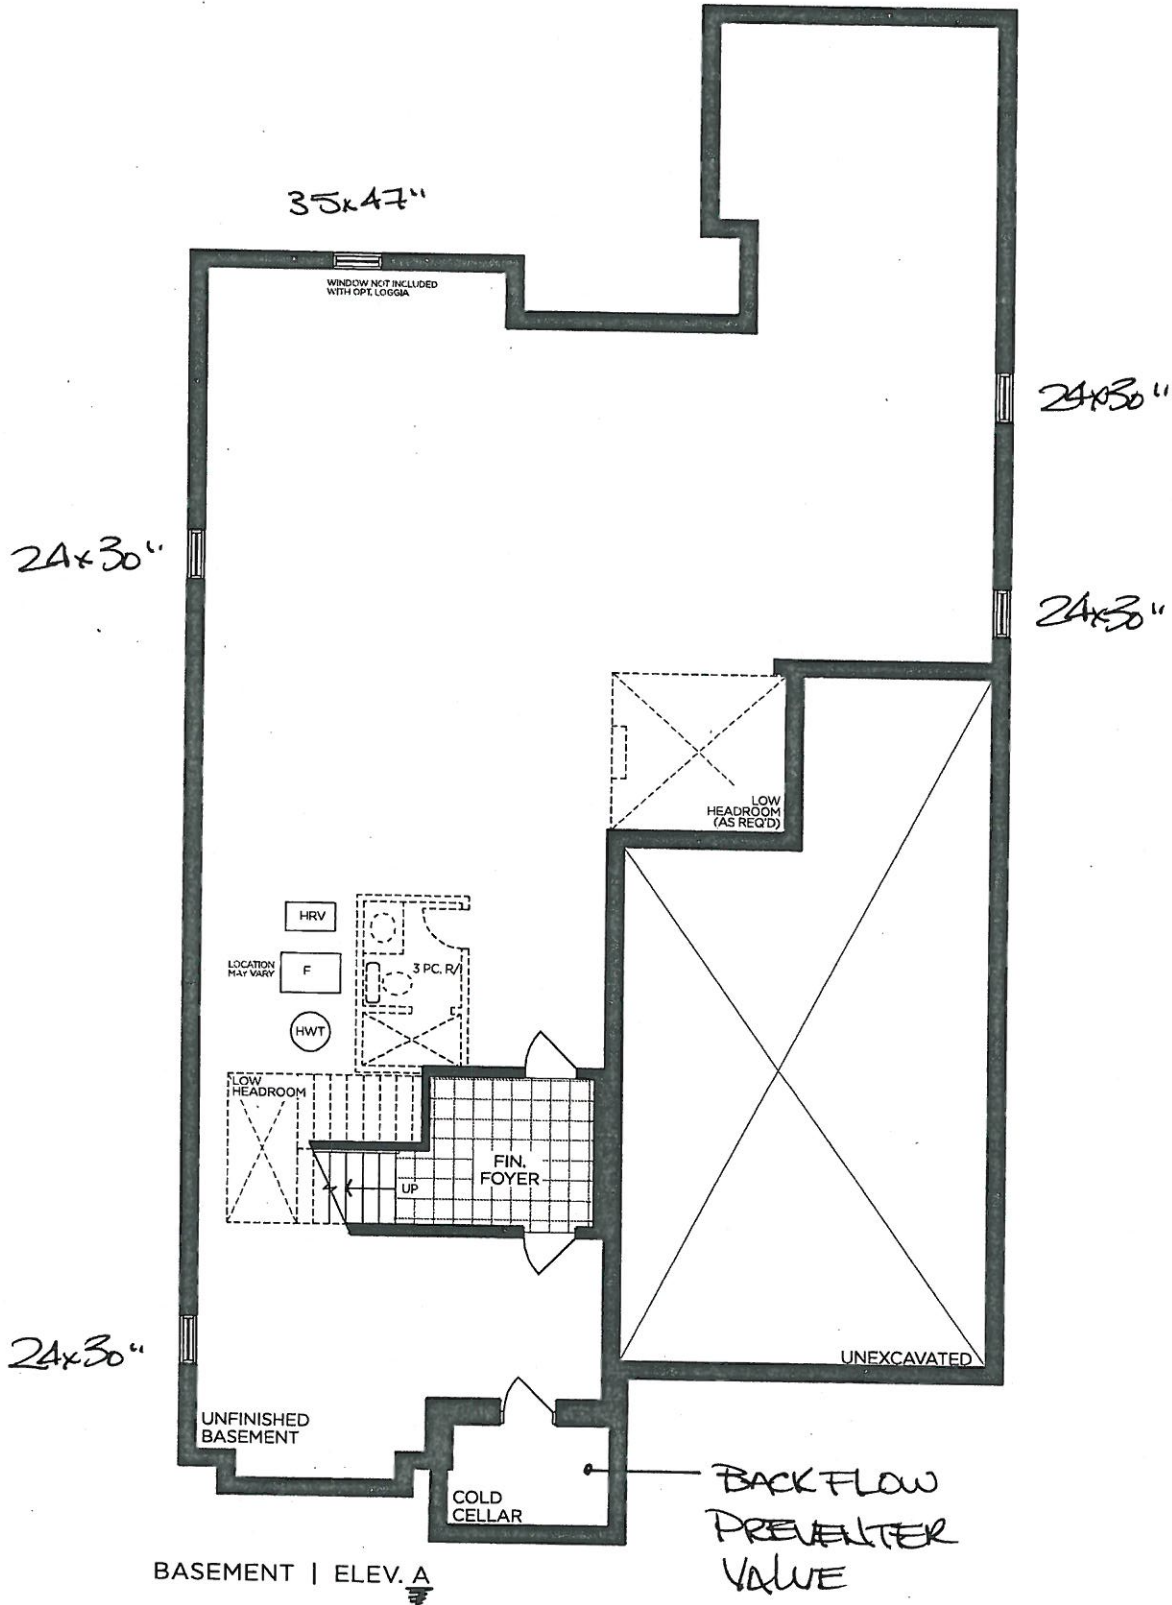

VENDOR
PURCHASER
PURCHASER

GOLDPARK
WORTH MORE™

Prices, figures, illustrations, sizes, features and finishes are subject to change without notice. Areas and dimensions are approximate and actual usable floor space may vary from the stated area. Layout may be reverse of the unit purchased. E. & O.E. 5005

SCHEDULE 'F'




PV-107
MAR 30 2020

JUNE 8 2020

The Knightswood 50' SERIES

→ Elevation A • 4,445 sq.ft.
4,475 sq.ft. Opt. Elevator / 4,575 sq.ft. Opt. Service Stairs
Elevation B • 4,440 sq.ft.
4,475 sq.ft. Opt. Elevator / 4,575 sq.ft. Opt. Service Stairs
Elevation C • 4,525 sq.ft.
4,560 sq.ft. Opt. Elevator / 4,660 sq.ft. Opt. Service Stairs

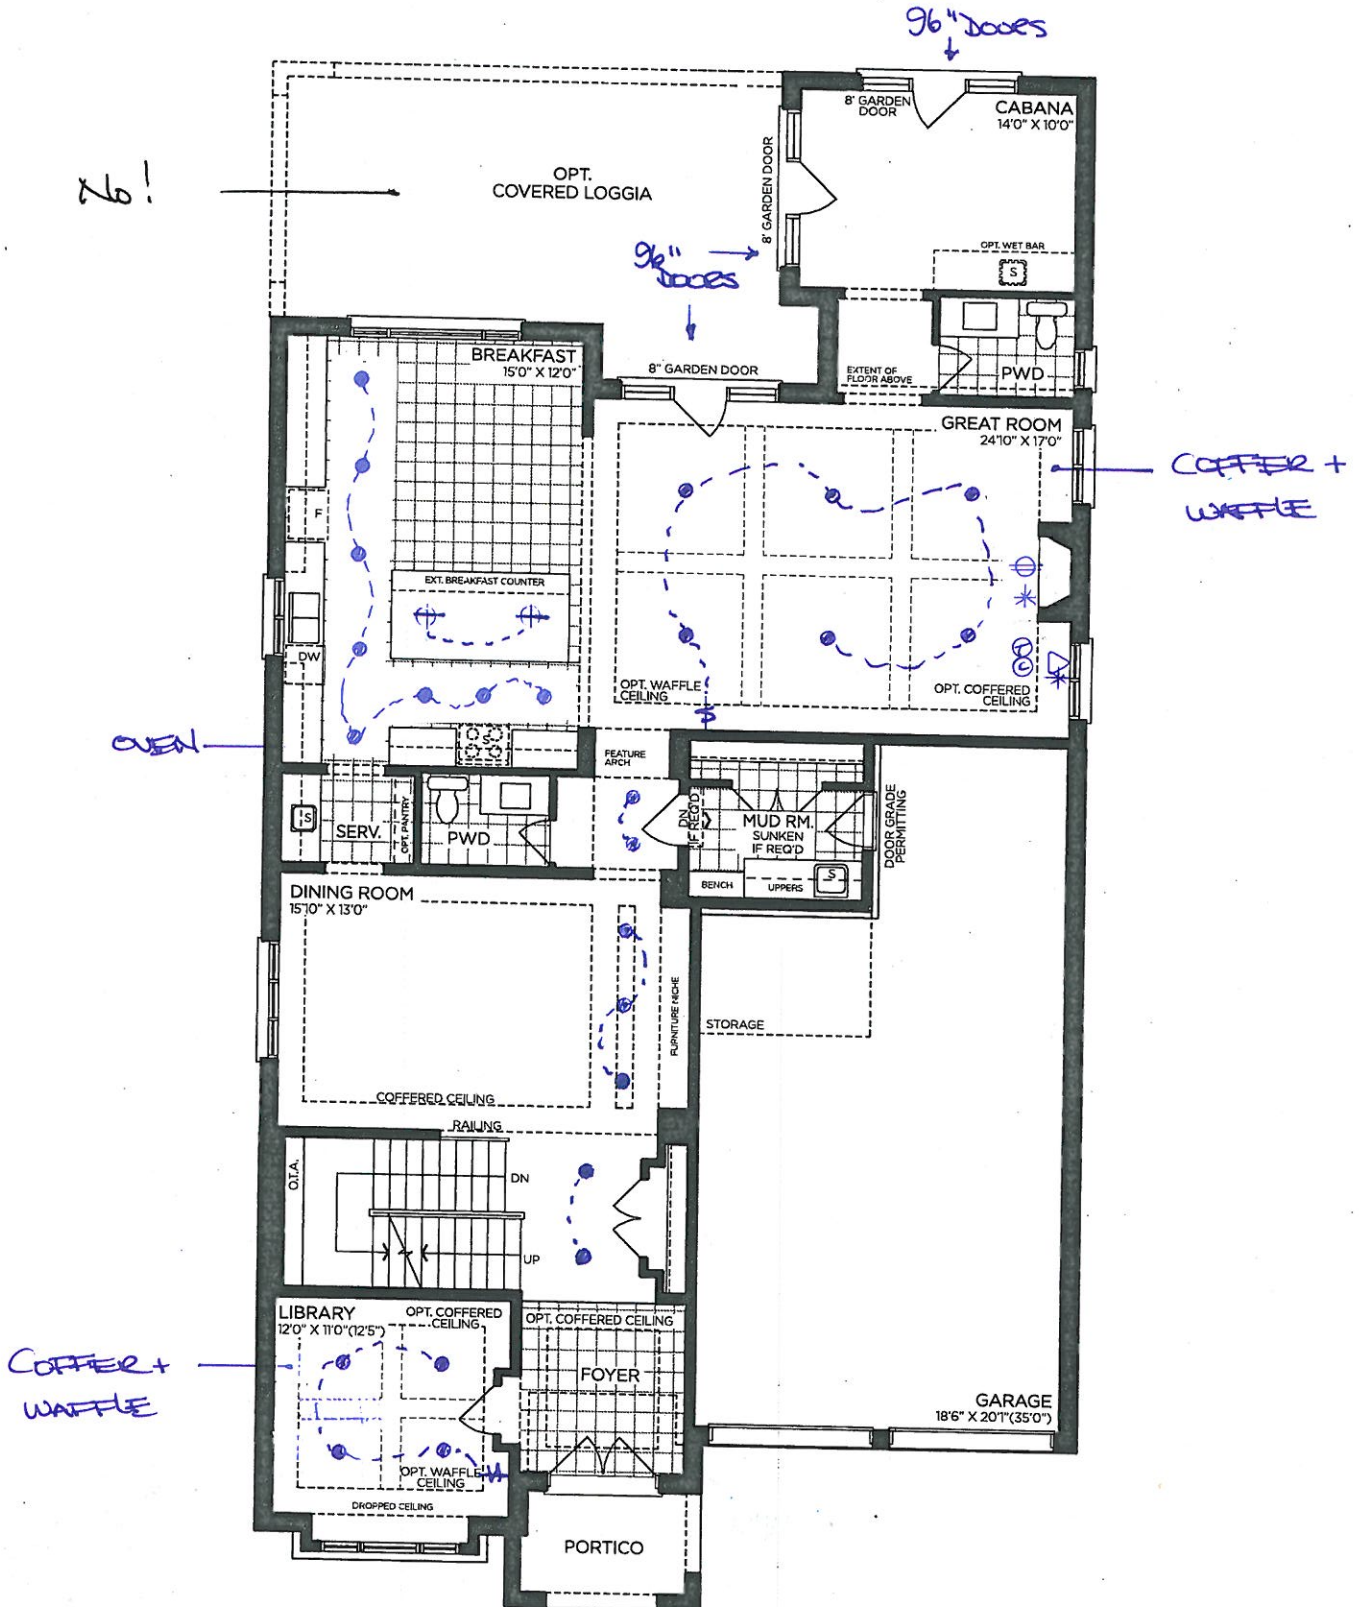

GROUND FLOOR | ELEV. A

VENDOR

PURCHASER

PURCHASER

GOLDPARK
WORTH MORE™

Prices, figures, illustrations, sizes, features and finishes are subject to change without notice. Areas and dimensions are approximate and actual usable floor space may vary from the stated area. Layout may be reverse of the unit purchased. E. & O.E. 5005

SCHEDULE 'F'




PV-107
March 30 2020

JUNE 8 2020

8' Doors
Then cut

The Knightswood 50' SERIES

→ Elevation A • 4,445 sq.ft.
4,475 sq.ft. Opt. Elevator / 4,575 sq.ft. Opt. Service Stairs
Elevation B • 4,440 sq.ft.
4,475 sq.ft. Opt. Elevator / 4,575 sq.ft. Opt. Service Stairs
Elevation C • 4,525 sq.ft.
4,560 sq.ft. Opt. Elevator / 4,660 sq.ft. Opt. Service Stairs

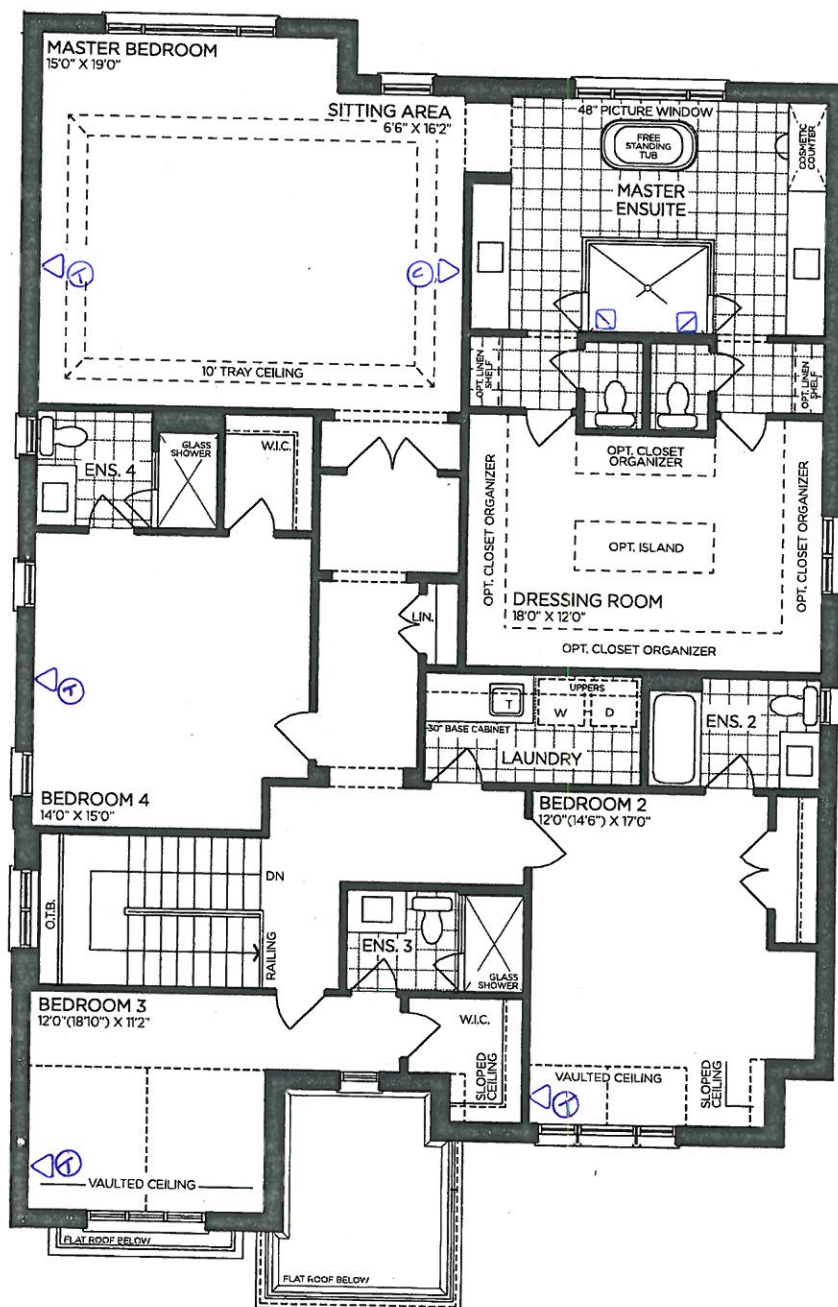

← Rain shower
+ shower niche

SECOND FLOOR | ELEV. A

VENDOR

PURCHASER

PURCHASER

GOLDPARK
WORTH MORE™

Prices, figures, illustrations, sizes, features and finishes are subject to change without notice. Areas and dimensions are approximate and actual usable floor space may vary from the stated area. Layout may be reverse of the unit purchased. E. & O.E. 5005

PLUMBING UPGRADES

POSI-TEMP SHOWER ONLY* W/3 FUNCTION TRANSFER VALVE
TRIM AND SLIDE BAR W/HAND SHOWER

MOEN - ARRIS



☐ CHROME

☐ from WALL

☐ BRUSHED NICKEL

☒ from CEILING

☒ MATTE BLACK

MODEL TS22002EP / 3372 / TS23005 / 62320 / 3887EP / A725

Lot#

107

Room:

MASTER ENSUITE

Signature:

Date:

JUNE 8 2020

Signature: