

GOLDPARK

WORTH MORE™

CONSTRUCTION SUMMARY

Lot: 135

Model: 38-8 Elev.B CORELLI OPT - GFA1

Project/Phase: Brampton Encore / 2

CENTRAL VAC AND WIRING

Invoice	Qty.	Description
2409 28,792 28Jul20	1	.KITCHEN: INSTALL VAC PAN UNDER KITCHEN SINK
2409 28,797 28Jul20	2	UPPER HALL AND GROUND FLOOR HALLWAY: ROUGH-IN FOR EXTRA SECURITY KEY PAD
2409 28,800 28Jul20	1	FAMILY ROOM: CONDUIT PIPE- LOCATE APPROX 66" A.F.F. ABOVE FIREPLACE, TERMINATE AT CABLE LOCATION

CERAMIC

Invoice	Qty.	Description
2411 28,859 28Jul20	1	**DELETE**SHOWER STALL SHAMPOO SHELF *DELETE FROM ORDER PE.2409

CONCRETE AND DRAIN

Invoice	Qty.	Description
2409 28Jul20 NoCat	1	BACK FLOW PREVENTER VALVE

DisciplineMS.rpt 26jun20

Page 1 of 7
Printed and Sent: 28-Jul-20

**Lot: 135****Model: 38-8 Elev.B CORELLI OPT - GFA1****Project/Phase: Brampton Encore / 2**

ELECTRICAL

Invoice	Qty.	Description
2409 28Jul20 NoCat	4	LIBRARY: LED POT LIGHT
2409 28Jul20 NoCat	1	LIBRARY: SWITCH FOR POTLIGHTS
2409 28Jul20 NoCat	4	REC ROOM: LED POT LIGHT
2409 28Jul20 NoCat	1	REC ROOM: SWITCH FOR POTLIGHTS
2409 28,808 28Jul20	1	KITCHEN: 110V WALL RECEPTACLE ON DEDICATED CIRCUIT - GAS FIRED APPLIANCE - FOR AUX. EQUIPMENT - NOT A STOVE PLUG
2411 28,830 28Jul20	1	**DELETE** KITCHEN CABINET VALANCE LIGHTS (UNDER CABINETS) - WITH STRIP LIGHTS - DOES NOT INCLUDE (AND REQUIRES) KITCHEN UPGRADE PRICING DELETE FROM ORDER PE.2409
2411 28,810 28Jul20	1	KITCHEN: 220V WALL RECEPTICAL ON DEDICATED CIRCUIT- FOR 4 WIRE BUILT-IN WALL OVEN - SEE PLAN FOR LOCATION
2411 28,807 28Jul20	1	KITCHEN: 110V WALL RECEPTACLE ON DEDICATED CIRCUIT - FOR MICROWAVE - MICROWAVE NOT INCLUDED
2411 28Jul20 NoCat	1	KITCHEN: 36" CYCLONE CHIMNEY-STYLE HOOD FAN # SCB71136

FORMING

Invoice	Qty.	Description
2409 28,916 28Jul20 **	3	BASEMENT WINDOWS - UPGRADE EXISTING BASEMENT WINDOW TO 30 INCH X 24 INCH - MAY REQUIRE INSTALLATION OF WINDOW WELL

GOLDPARK

WORTH MORE™

CONSTRUCTION SUMMARY

Lot: 135

Model: 38-8 Elev.B CORELLI OPT - GFA1

Project/Phase: Brampton Encore / 2

FRAMING

Invoice	Qty.	Description
2409 28,856 28Jul20	1	.SMOOTH CEILINGS - GROUND FLOOR
2409 28,855 28Jul20	1	.SMOOTH CEILINGS - (2-STORY DESIGN) 2ND FLOOR
2409 28Jul20 NoCat	1	LIVING ROOM/HALLWAY: ADD HALF WALL, OPEN ABOVE + HAND RAIL (LIKE MODEL HOME), IN LIEU OF RAILING/PICKETS
2409 28,854 28Jul20	1	DELETE - OPTIONAL 10 FOOT TRAY CEILING - MASTER BEDROOM (AS PER PLAN)
2409 28Jul20 NoCat	1	LIBRARY/DEN: DELETE 2 ARCHES, DRYWALL OVER. LEAVE SPACE FOR DOUBLE FENCH DOORS WITH CLEAR, PLAIN GLASS - SEE REVISED LOCATION ON PLAN
2409 28,859 28Jul20	1	DELETE - MASTER ENSUITE: SHOWER STALL SHAMPOO SHELF - 12X14"H

GARAGE DOORS

Invoice	Qty.	Description
2409 28,864 28Jul20	2	DELETE - GARAGE DOOR OPENER - WITH 1 REMOTE- PRICE IS PER DOOR *BELT DRIVE*
2409 28,862 28Jul20	1	DELETE - DIGITAL ENTRY KEYPAD

HVAC

Invoice	Qty.	Description
2409 28,872 28Jul20	1	KITCHEN: GAS LINE ROUGH - 2ND FLOOR- (3-STOREY MODELS)
2409 28,879 28Jul20	1	HUMIDIFIER: WB3 - 18 (3,000+ SQ.FT.)
2411 28Jul20 NoCat	1	KITCHEN: 36" CYCLONE CHIMNEY-STYLE HOOD FAN # SCB71136

DisciplineMS.rpt 26jun20

Page 4 of 7
Printed and Sent: 28-Jul-20



CONSTRUCTION SUMMARY

Lot: 135

Model: 38-8 Elev.B CORELLI OPT - GFA1

Project/Phase: Brampton Encore / 2

PLUMBING

Invoice	Qty.	Description
2409 28,898 28Jul20	1	MASTER ENSUITE: UPGRADE TO FREE STANDING TUB - MIROLIN BROOK
2409 28,903 28Jul20	1	ROUGH-IN - WATERLINE FOR FIRDGE
2409 28Jul20 NoCat	1	MASTER ENSUITE: DELTA ARA 3 FUNCTION SHOWER KIT CHROME HAND SHOWER WITH SLIDE BAR + RAIN SHOWER FROM CEILING #DF-KIT4-WS

STAIRS AND RAILINGS

Invoice	Qty.	Description
2409 28Jul20 NoCat	1	LIVING ROOM/HALLWAY: ADD HALF WALL, OPEN ABOVE + HAND RAIL (LIKE MODEL HOME), IN LIEU OF RAILING/PICKETS


WINDOWS - BASEMENT

Invoice	Qty.	Description
2409 28,916 28Jul20	3	BASEMENT WINDOWS - UPGRADE EXISTING BASEMENT WINDOW TO 30 INCH X 24 INCH - MAY REQUIRE INSTALLATION OF WINDOW WELL

BEZ-135
July 23 2020
July 28 2020

The
Corelli
38' SERIES

Elevation A • 3,878 sq.ft. | Elevation B • 3,878 sq.ft.

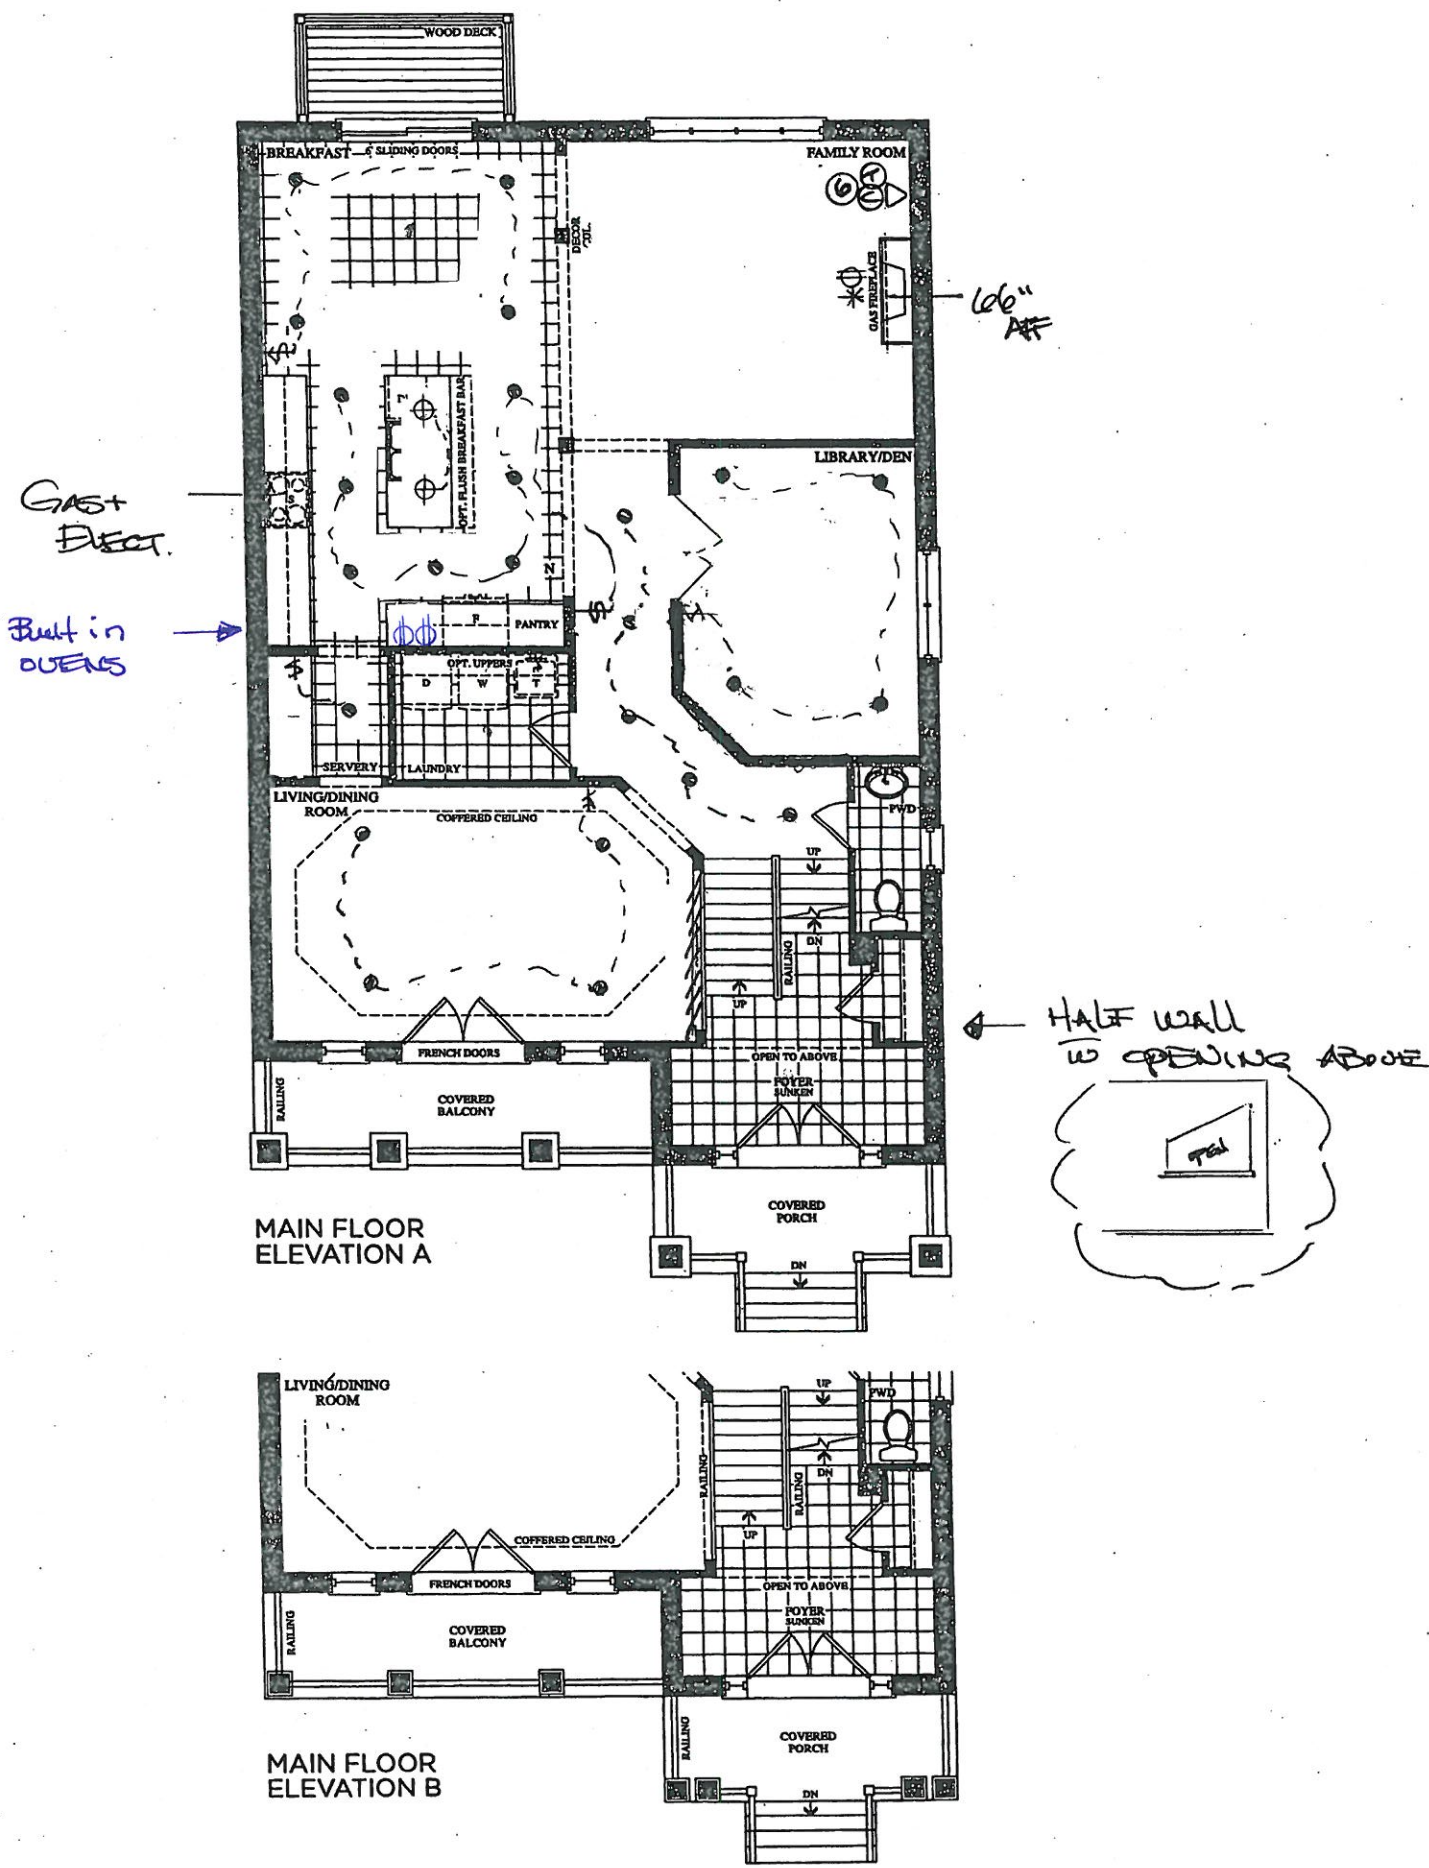



Prices, figures, illustrations, sizes, features and finishes are subject to change without notice. E.&O.E. Areas and dimensions are approximate and actual usable floor space may vary from the stated area. Layout may be reverse of the unit purchased. E. & O.E.

BEZ-135
July 23 2020
July 28 2020



The
Corelli
38' SERIES


Elevation A • 3,878 sq.ft. | Elevation B • 3,878 sq.ft.

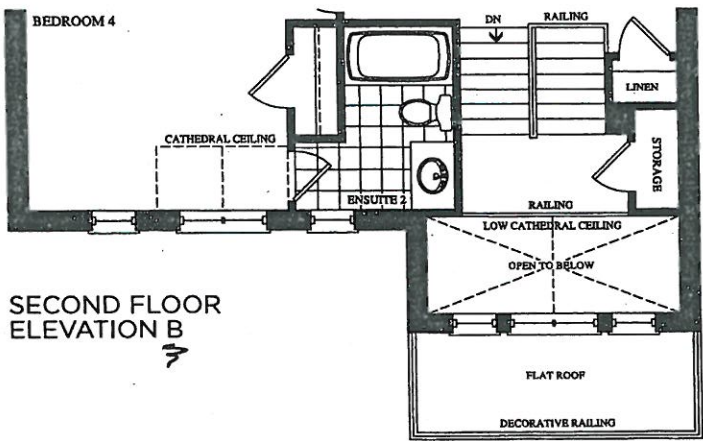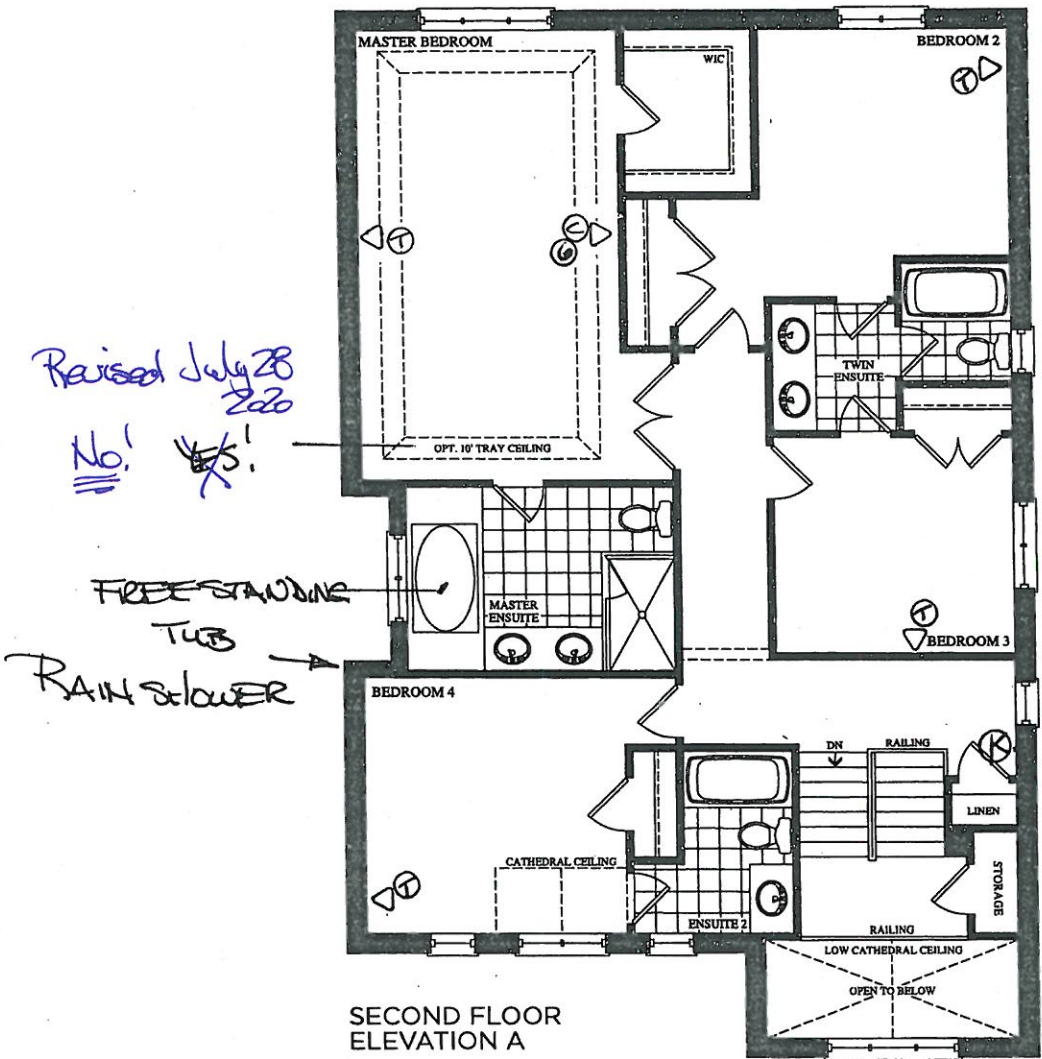


BE2-135
July 23 2020
July 28 2020


The
Corelli
38' SERIES

Elevation A • 3,878 sq.ft. | Elevation B • 3,878 sq.ft.

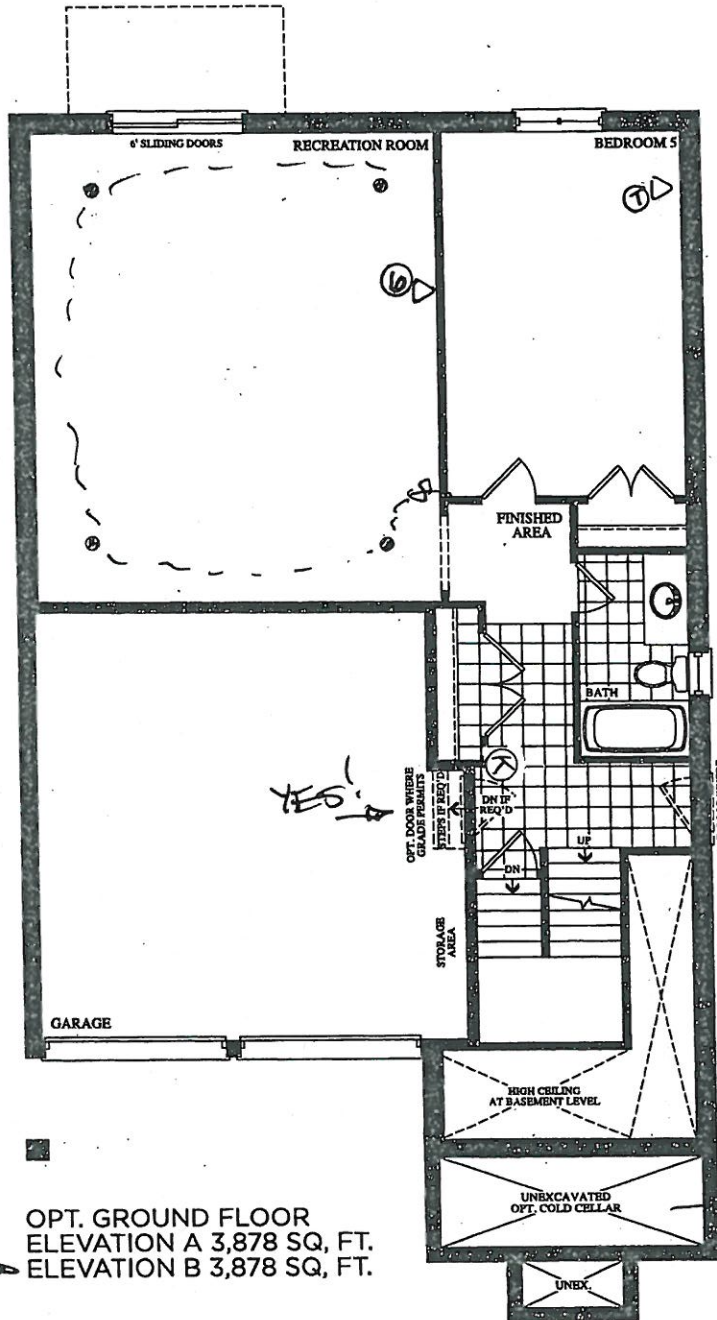

BE2-135
July 23 2026
July 28 2026
The Corelli
38' SERIES
Elevation A • 3,878 sq.ft. | Elevation B • 3,878 sq.ft.

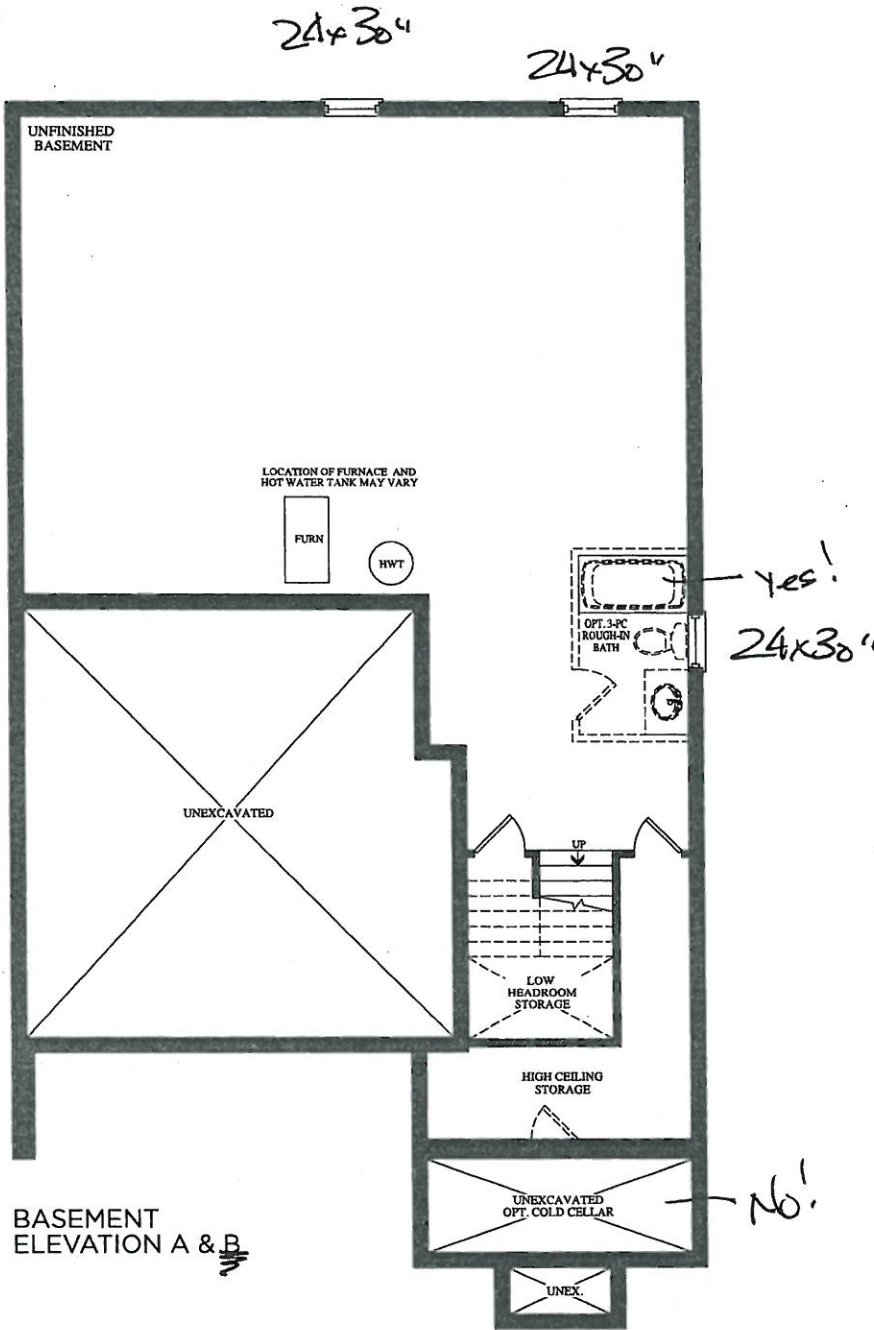


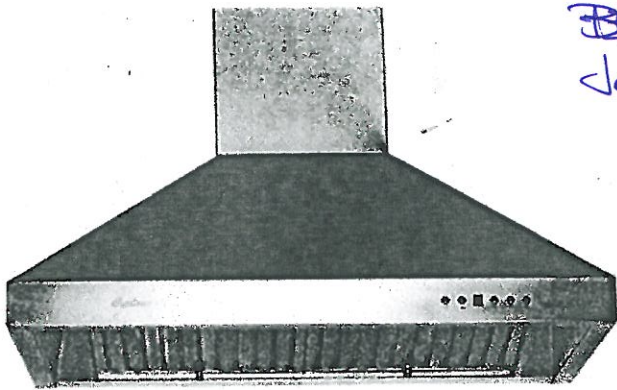

BE2-135
July 28 2020

Wall Mount

Bold and masculine by design, the professional grade range hood. A three-speed push button control panel gives you complete control of the fan while bright LED lights illuminate the cooking area. Comes with strong, easily removable, dishwasher-safe baffle filters to keep your kitchen clean and to keep you breathing easy.

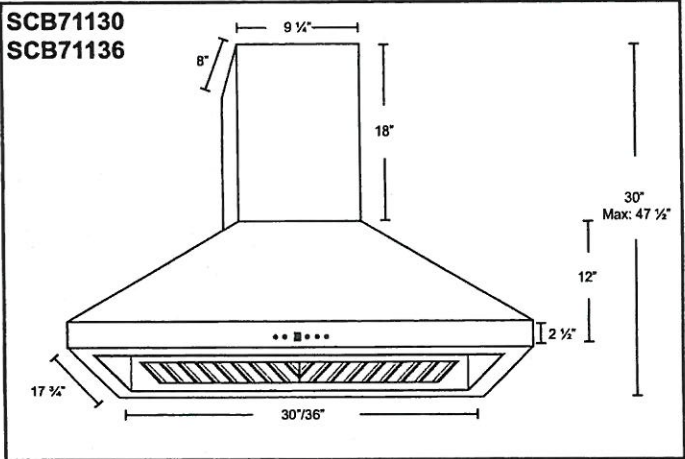

Specifications

- Air Flow Volume: 650 CFM
- Electrical Connection: 120V/60Hz
- Electrical Consumption: 200 Watts
- Fan Speed: 1299 RPM
- Finishes: Stainless Steel
- Venting: 6" Round - Top Only
- Dimensions: Width: 30"/36"
Height: 50"
Depth: 24"
- Sones: Min. 2
Max. 7



Model	Colour	Venting	Size
SCB71130	Stainless Steel	6"	30"
SCB71136	Stainless Steel	6"	36"