

GOLDPARK

WORTH MORE™

CONSTRUCTION SUMMARY

Lot: 77L

Model: 28-09 Elev A Gershwin

Project/Phase: Brampton Encore / 2

APPLIANCES

Invoice	Qty.	Description
2217 31383 30Apr20 NoCat	1	APPLIANCE PACKAGE: FRIDGE/STOVE/DISHWASHER - STAINLESS STEEL + WASHER/DRYER - WHITE INCLUDED IN APS

CENTRAL VAC AND WIRING

Invoice	Qty.	Description
2217 31386 30Apr20	1	CONDUIT PIPE- FROM ATTIC TO ELECTRICAL PANEL- TERMINATE APPROX CENTER OF ATTIC
2217 31388 30Apr20	1	FAMILY ROOM: CONDUIT PIPE- FOR TELEVISION- LOCATE APPROX. 66" A.F.F. ABOVE FIREPLACE, TERMINATING AT CABLE LOCATION

CERAMIC


Invoice	Qty.	Description
2217 31402 30Apr20 NoCat	1	MAIN FLOOR: FOYER/POWDER/KITCHEN-BREAKFAST: UPGRADE 4 FLOOR TILE - 12X24" LAID IN STRAIGHT, STACKED PATTERN. SEE PLAN FOR TILE DIRECTION

CONCRETE AND DRAIN

Invoice	Qty.	Description
2217 31381 30Apr20 **	1	ROUGH-IN - 3PC BASEMENT ROUGH-IN INCLUDED IN APS

ryDiscipline.rpt 14Mar20

Page 1 of 6



CONSTRUCTION SUMMARY

Lot: 77L

Model: 28-09 Elev A Gershwin

Project/Phase: Brampton Encore / 2

FRAMING

Invoice	Qty.	Description
2217 31380 30Apr20	1	MANDOOR - GARAGE TO HOUSE- AS PER PLAN AND GRADE PERMITING INCLUDED IN APS
2217 33008 30Apr20 NoCat	1	EXTENDED HEIGHT ARCHWAY -LEAVE DOORS STANDARD 80"
2217 33010 30Apr20 NoCat	1	SIDE DOOR - AS PER PLAN AND GRADE PERMITTING

GARAGE DOORS

Invoice	Qty.	Description
2217 31415 30Apr20	1	GARAGE DOOR OPENER - WITH 1 REMOTE- PRICE IS PER DOOR **BELT DRIVE**

GRANITE MARBLE QUARTZ

Invoice	Qty.	Description
2217 31405 30Apr20 NoCat	1	KITCHEN: UPGRADE 1 QUARTZ COUNTER
2217 31406 30Apr20 NoCat	1	KITCHEN: FLUSH BREAKFAST BAR
2223 31996 30Apr20 NoCat	1	KITCHEN: COOKTOP CUT OUT

HARDWOOD

Invoice	Qty.	Description
2217 31403 30Apr20 NoCat	1	MAIN FLOOR: GREAT ROOM / MAIN HALL / LANDINGS: UPGRADE 1 HARDWOOD - VINTAGE RED OAK SMOOTH 3/4 X 4-3/8"
2217 31404 30Apr20 NoCat	1	UPPER HALL: UPGRADE 1 HARDWOOD - VINTAGE RED OAK SMOOTH 3/4 X 4-3/8"

HVAC

Invoice	Qty.	Description
2217 31384 30Apr20 NoCat	1	A/C- 2.0 TON INCLUDED IN APS

GOLDPARK

WORTH MORE™

CONSTRUCTION SUMMARY

Lot: 77L

Model: 28-09 Elev A Gershwin

Project/Phase: Brampton Encore / 2

INTERIOR TRIM AND DOORS

Invoice	Qty.	Description
2217 31379 30Apr20 **	1	SIDE DOOR- HOME TO EXTERIOR- AS PER PLAN AND GRADE PERMITTING INCLUDED IN APS
2217 33009 30Apr20 NoCat	1	EXTENDED HEIGHT ARCHWAY -LEAVE DOORS STANDARD 80"

KITCHEN AND BATH CABINETRY

Invoice	Qty.	Description
2217 31399 30Apr20 NoCat	1	KITCHEN: DELETE UPPERS ABOVE STOVE, FINISH SIDES OF CABINETS. LEAVE APPROX. 36" SPACE FOR 30" CHIMNEY STYLE HOOD FAN
2217 31400 30Apr20 NoCat	1	KITCHEN: PREMIUM SPRAY STAIN
2217 31401 30Apr20 NoCat	1	KITCHEN: ADD 2 DOOR DEEP PANTRY, SEE PLAN FOR LOCATION INCLUDES FINISHED GABLE
2217 31409 30Apr20 NoCat	1	KITCHEN: POTS AND PANS DRAWERS
2223 31543 30Apr20 NoCat	1	KITCHEN: RELOCATE 2-DOOR PANTRY TO END OF COUNTER BY BREAKFAST, ADD 2ND FINISHED GABLE
2223 31994 30Apr20 NoCat	1	KITCHEN: DOUBLE APPLIANCE CABINETS FOR WALL OVENS INCLUDES FINISHED GABLE
2223 31995 30Apr20 NoCat	1	KITCHEN: RELOCATE POTS AND PANS DRAWERS TO BELOW COOK TOP TOP SHALLOW DRAWER IS DUMMY + 2 DEEP DRAWERS BELOW

MISC.

Invoice	Qty.	Description
2217 31410 30Apr20 NoCat	1	Purchaser has attended an appointment at the Decor Centre & has DECLINED any additional upgrades and accepts & acknowledges that there will be no further changes/additions/deletions to be made upon signing on March 12 2020. A minimum \$500 fee to re-open file will apply for any changes.
2217 31411 30Apr20 NoCat	1	BONUS PACKAGE: \$5,000.00 (INCLUDING TAXES) WORTH OF UPGRADES FROM GOLD PARK HOMES DÉCOR CENTRE IS BEING APPLIED TOWARD THIS ORDER. PURCHASER HAS A REMAINING AMOUNT OF \$00 (INCLUDING TAXES).
2223 31997 30Apr20 NoCat	1	Purchaser has attended an appointment at the Decor Centre & has DECLINED any additional upgrades and accepts and acknowledges that there will be no further changes/additions/deletions to be made upon signing on March 31, 2020. A minimum \$500 fee to re-open file will apply for any changes.

ryDiscipline.rpt 14Mar20

Page 4 of 6



Model: 28-09 Elev A Gershwin
Project/Phase: Brampton Encore / 2

Invoice	Qty.	Description
2217 31380 30Apr20 **	1	MANDOOR - GARAGE TO HOUSE- AS PER PLAN AND GRADE PERMITING INCLUDED IN APS
2217 32030 30Apr20 NoCat	1	SIDE DOOR AND GARAGE MANDOOR - AS PER PLAN AND GRADE PERMITTING

Invoice	Qty.	Description
2217 31407 30Apr20 NoCat	1	MAIN STAIRS: STAIN STAIRS TO MATCH HARDWOOD FLOORS, AS CLOSE AS POSSIBLE

Invoice	Qty.	Description
2217 31381 30Apr20	1	ROUGH-IN - 3PC BASEMENT ROUGH-IN INCLUDED IN APS

Invoice	Qty.	Description
2217 31413 30Apr20 NoCat	1	MASTER ENSUITE: WHIRLPOOL TUB #WO672

Invoice	Qty.	Description
2217 31408 30Apr20 NoCat	1	MAIN STAIRS: EUROLINE 1 + V GROOVE

Invoice	Qty.	Description
2217 31417 30Apr20	1	BASEMENT WINDOWS - UPGRADE EXISTING BASEMENT WINDOW TO 30 INCH X 24 INCH - MAY REQUIRE INSTALLATION OF WINDOW WELL **REAR ONLY**
2217 31418 30Apr20	2	BASEMENT WINDOWS - UPGRADE EXISTING BASEMENT WINDOW TO 30 INCH X 16 INCH INCLUDED IN APS



CONSTRUCTION SUMMARY

Lot: 77L
Model: 28-09 Elev A Gershwin
Project/Phase: Brampton Encore / 2

WINDOWS AND DOORS

Invoice	Qty.	Description
2217 31379 30Apr20 **	1	SIDE DOOR- HOME TO EXTERIOR- AS PER PLAN AND GRADE PERMITTING INCLUDED IN APS
2217 31380 30Apr20 **	1	MANDOOR - GARAGE TO HOUSE- AS PER PLAN AND GRADE PERMITING INCLUDED IN APS

This Document is Extremely Time Sensitive - Printed 30 Apr 20 at 14:29

*** NOTE: This is not an approved document. Document must be locked ***

Scheduled Closing Date:

Purchasers: RAVI VINOD MAHESHWARI & PRIYANKA RAMI Property: 77L
Telephone Res. / Bus: Project: Brampton Encore - Phase 2
Decor Advisor: Yolande Somerville Model and Elevation: 28-09 Elev A Gershwin

Layout Changes: Yes No Sketch Attached: Yes No Exterior Colour Scheme:

1. Cabinetry

	Style and Colour	Counter	Hardware
Kitchen / Breakfast	Siena oak *'Graphite'	*Quartz: Snow White	cs1-23
Laundry Room	n/a	n/a	n/a
Powder Room	n/a	n/a	n/a
Twin Bath	Siena oak 'Greystone'	P-Lam #6696-46	cs1-21
Master Ensuite Bathroom	Siena oak 'Greyston'e	P-Lam #4925k-07	cs1-24
Second Ensuite Bathroom (If Applicable)	n/a	n/a	n/a

Comment

2. Floor Tile

	Selection
Entrance Vestibule	*12x24" Eterna London polished 'Imperial Grey'
Main Hall	n/a
Kitchen / Breakfast	*12x24" Eterna London polished 'Imperial Grey'
Laundry Room	13x13" New Albion 'Grey'
Powder Room	*12x24" Eterna London polished 'Imperial Grey'
Twin Bath	13x13" New Albion 'Grey'
Master Ensuite Bathroom	13x13" New Reeds 'Brown'
Second Ensuite Bathroom (If Applicable)	n/a
Lower Landing (If Applicable)	n/a

Comment

3. Wall Tile

	Selection	Listello/Inserts	Describe
M.Ens Tub skirt/splash	8x10" Weave 'White'	Yes No	
Master Ensuite Bathroom			
Tub Deck	8x10" Weave 'White'	Yes No	
Shower Stall	8x10" Weave 'White'	Yes No	
Bathroom Walls	n/a	Yes No	
Second Ensuite Bathroom (If Applicable)	n/a	Yes No	
Twin Bath	8x10" Splendour 'White'	Yes No	
Kitchen Backsplash	Yes No	Backsplash Behind Fridge	

Comment

PP RM

Scheduled Closing Date:

Purchasers: RAVI VINOD MAHESHWARI & PRIYANKA RAMI Property: 77L
Telephone Res. / Bus: Project: Brampton Encore - Phase 2
Decor Advisor: Yolande Somerville Model and Elevation: 28-09 Elev A Gershwin

4. Plumbing Fixtures

Master Ensuite Bathroom Second Ensuite Powder Room
Other Room - Specify Other Washroom

Comment
Standard EXCEPT Whirtpool tub in Master Ensuite

5. Hardwood Flooring

Main Hall Kitchen / Breakfast Living Room Dining Room Family Room Den/Library Entrance Vestibule Lower Landing (If Applicable)
Upper Landing Upper Hall Master Bedroom Bedroom #2 Bedroom #3 Bedroom #4 Bedroom #5 Other Room - Specify

Comment

6. Carpeting

Ground Floor Second Floor Upgrade Description
Type Area Capped Runner - *Upgrade

Comment

7. Fireplace

Living Room Family Room Other Room - Specify
Purchased As Per Plan N/A
Fireplace Type Mantle Type Colour / Stain Surround Hearth

Comment

*** NOTE: This is not an approved document. Document must be locked ***

Scheduled Closing Date:

Purchasers: RAVI VINOD MAHESHWARI & PRIYANKA RAMI Property: 77L

Telephone Res. / Bus: Project: Brampton Encore - Phase 2

Decor Advisor: Yolande Somerville Model and Elevation: 28-09 Elev A Gershwin

8. Trim Carpentry

Interior Doors Front Door Glass Inserts Door Handles
Interior Trim

Comment

9. Plaster Mouldings and Medallions

Standard Throughout ☐ Yes ☐ No ☒ N/A

Entrance Vestibule	<input type="text"/>	<input type="text"/>	Kitchen/Breakfast	<input type="text"/>	<input type="text"/>
Main Hall	<input type="text"/>	<input type="text"/>	Den/Library	<input type="text"/>	<input type="text"/>
Living Room	<input type="text"/>	<input type="text"/>	Lower Landing	<input type="text"/>	<input type="text"/>
Dining Room	<input type="text"/>	<input type="text"/>	Other Room - Specify	<input type="text"/>	<input type="text"/>
Family Room	<input type="text"/>	<input type="text"/>			

Comment

10. Railings and Spindles

Railing Package	<input type="text" value="*Euroline 1 + V Groove"/>		
Railing Colour	<input type="text" value="*Graphite"/>	Spindle Colour	<input type="text" value="*Black"/>
Stringer / Riser	<input type="text" value="*Graphite"/>	Treads	<input type="text" value="*Graphite"/>
Comment		Oak Stairs	<input type="radio"/> Yes <input checked="" type="radio"/> No <input type="radio"/> N/A

11. Wall Paint / Ceilings

Throughout Finished Areas

Trim Paint

Smooth Ceilings
Ground Floor ☒
Second Floor ☐
Note

Comment

PR RM

Scheduled Closing Date:

Purchasers: RAVI VINOD MAHESHWARI & PRIYANKA RAMI Property: 77L

Telephone Res. / Bus: Project: Brampton Encore - Phase 2

Decor Advisor: Yolande Somerville Model and Elevation: 28-09 Elev A Gershwin

12. Electrical

Hood Fan ☐ White ☐ Stainless ☒ N/A

Above Kitchen Cabinet Light ☐ Yes ☒ No

Below Kitchen Cabinet Light ☐ Yes ☒ No

Standard Appliances ☒

Over The Range Microwave ☐

Chimney Style Fan ☒

Comment

13. Heating and Air Conditioning

Air Conditioning YES

Gas Provisions Stove NO

Gas Provisions Dryer NO

Gas Provisions Barbecue STD


Comment

14. Additional Comments

15. Disclaimers and Notes

- 1) Colours of all materials are as close as possible to builder's selection, but not necessarily identical due to variances in manufacturing.
- 2) Any extras listed above are null and void unless accompanied by a separate invoice/amendment. Said invoice must be paid in full.
- 3) The Purchaser acknowledges that after Interior Colour Selection form is signed and dated, no further changes will be permitted other than re-selection due to unavailability. _____ Purchaser's Initials
- 4) The Purchaser acknowledges reading and accepting the "Gold Park Homes Decor Centre Disclaimers" form. This document contains other miscellaneous disclaimers.

This Interior Colour Selection is final and approved by:

Signature:  Date: _____

The Gershwin SEMI SERIES


→ Elevation A • 1,920 sq.ft.
Elevation B • 1,920 sq.ft.
Elevation C • 1,920 sq.ft.

BEZ-77L
MAR 12 2020 (PP) (RM)

*REVISED MAR 31 2020

(PP) (RM)

smooth ceiling

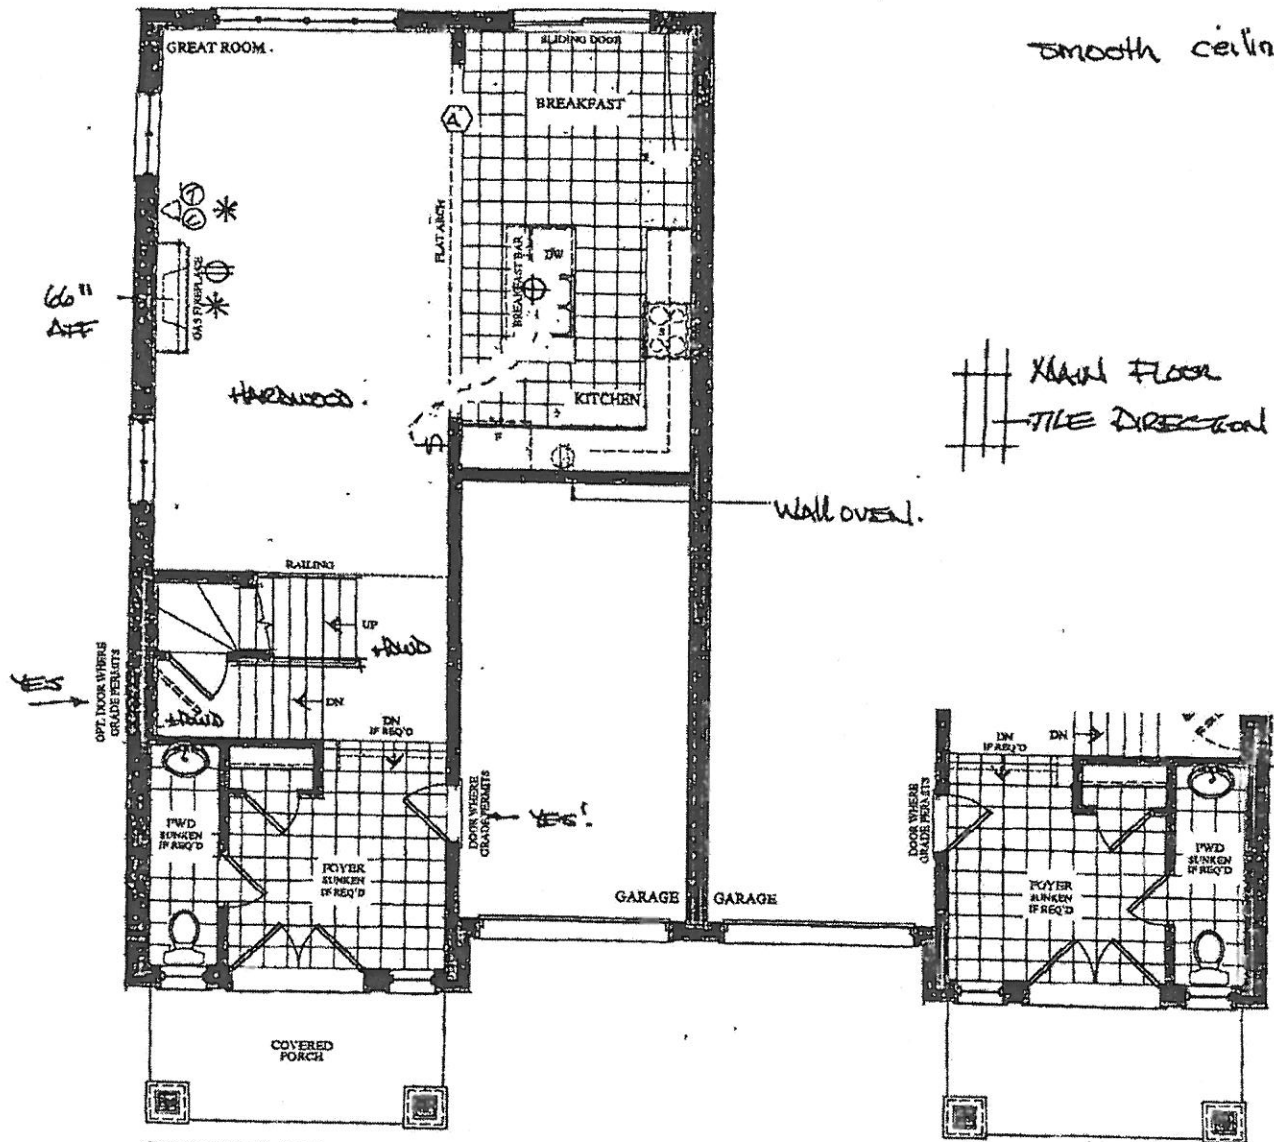

VENDOR

PURCHASER

PURCHASER

GOLDPARK
WORTH MORE™

Prices, figures, illustrations, sizes, features and finishes are subject to change without notice. Areas and dimensions are approximate and actual usable floor space may vary from the stated area. Layout may be reverse of the unit purchased. E. & O.E.

The Gershwin SEMI SERIES

→ Elevation A • 1,920 sq.ft.
Elevation B • 1,920 sq.ft.
Elevation C • 1,920 sq.ft.
Elevation D • 1,920 sq.ft.

REZ-77L

MAR 12 2020


MAR 31 2020

PP


RM

PP

RM

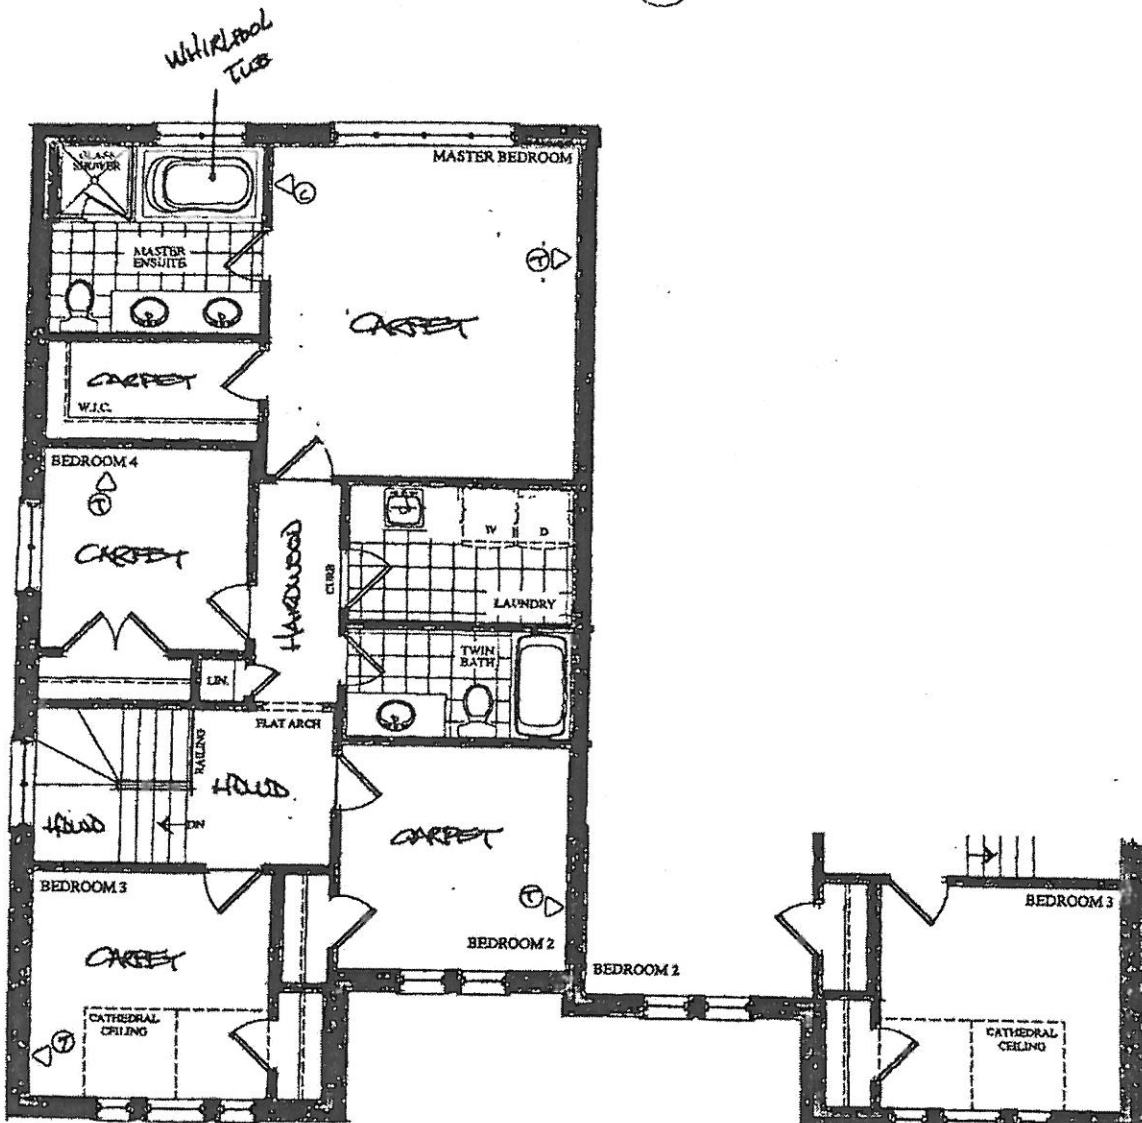

SECOND FLOOR
ELEVATION A

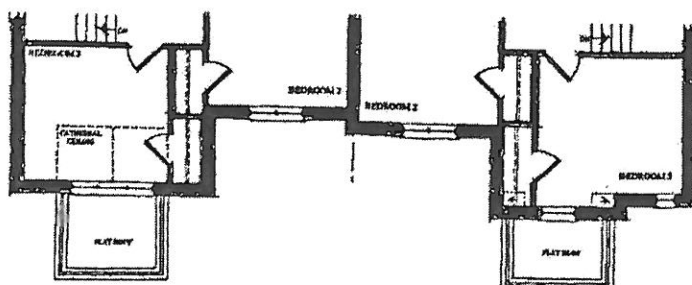

PART. SECOND FLOOR
ELEVATION C

PART. SECOND FLOOR
ELEVATION D

SECOND FLOOR
ELEVATION B

VENDOR

PURCHASER

PURCHASER


GOLDPARK
WORTH MORE™

Prices, figures, illustrations, sizes, features and finishes are subject to change without notice. Areas and dimensions are approximate and actual usable floor space may vary from the stated area. Layout may be reverse of the unit purchased. E. & O.E.


The Gershwin SEMI SERIES

→ Elevation A • 1,920 sq.ft.
Elevation B • 1,920 sq.ft.
Elevation C • 1,920 sq.ft.
Elevation D • 1,920 sq.ft.

BE2-77L
March 12 2020 PP RM
March 31 2020 PP RM

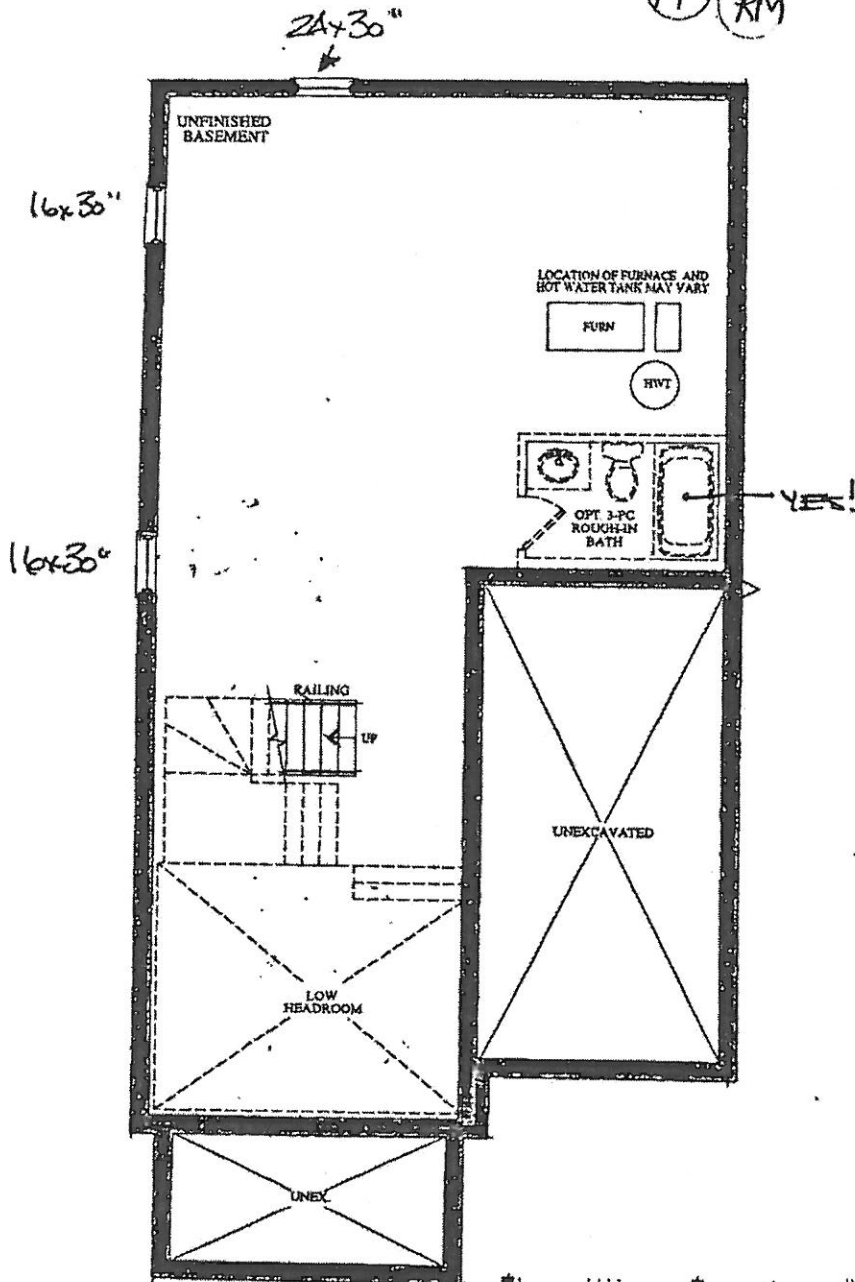

BASEMENT
ELEVATION A & B

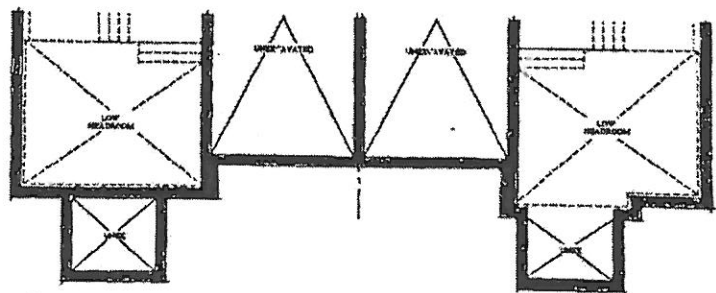

PART. BASEMENT FLOOR
ELEVATION C

PART. BASEMENT FLOOR
ELEVATION D

VENDOR

PURCHASER

PURCHASER

GOLDPARK
WORTH MORE™

Prices, figures, illustrations, sizes, features and finishes are subject to change without notice. Areas and dimensions are approximate and actual usable floor space may vary from the stated area. Layout may be reverse of the unit purchased. E. & O.E.

Trade Name: GOLD PARK

Site location: BRAMPTON

Model: SD-09 GERSHWIN

Address:





Project: ENCORE 2

Phase:

This layout has been explained to the purchaser by Cortina Kitchens Inc. and is understood by the purchaser.

REVISED
March 31 2020

PP RM

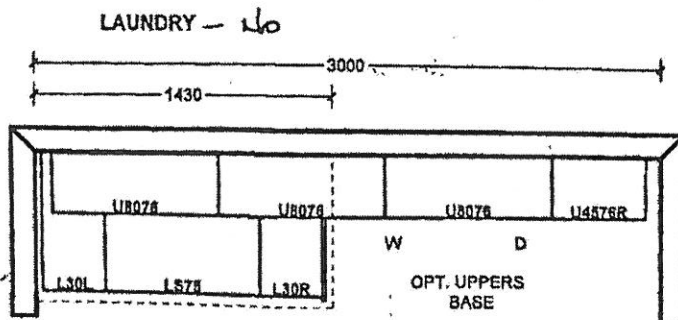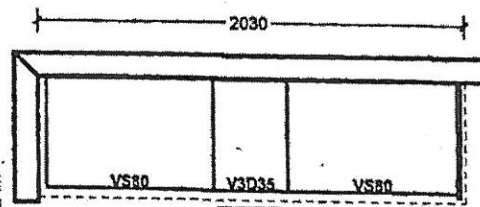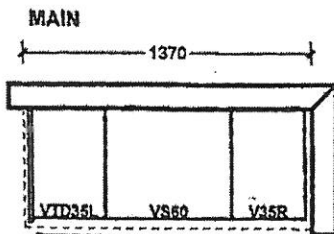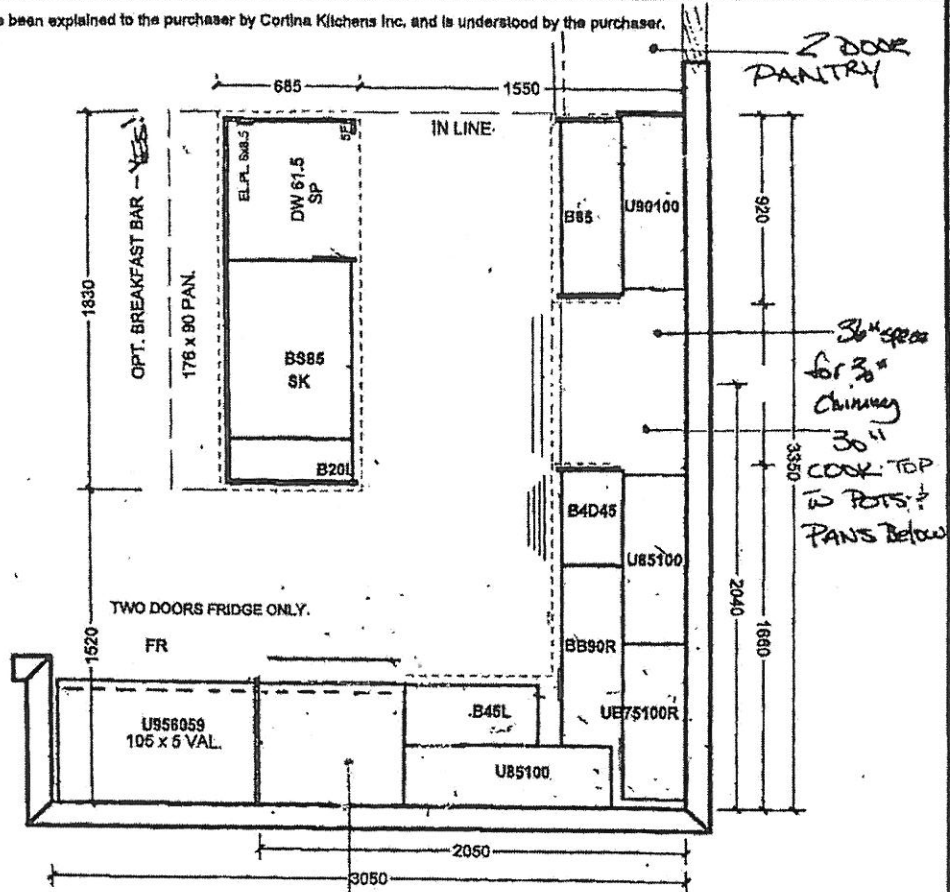

All prices subject to confirmation from head office.
This quotation is subject to the terms & conditions set out
in Cortina's Agreement of Purchase and Sale.

All agreements are contingent upon strikes, accidents, and delays beyond our control.
Please provide our installer with template for sinkholes or \$150.00 will be charged for callback.

ACCEPTED DATE: _____

Customer Signature

Salesperson Signature

Cortina Head Office Approval

Item A. Wood grain and colour are characteristics of the product. We cannot guarantee that such grain and colour will always match.
Item B. Cortina Kitchens Inc. reserves the right to alter dimensions and make technical changes without notice.

GOLDPARK
H O M E S




Granite, Marble,
Engineered Surfaces

- Standard 2CM & 3CM
- ⊖ Upgrade 1 2CM & 3CM
- ⊗ Upgrade 1 4 CM
- Upgrade 2


20mm (3/4") Profiles



30mm (1 1/4") Profiles

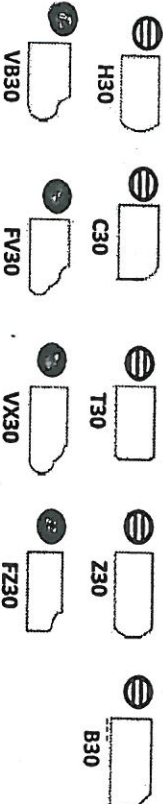

40mm (1 1/2") Profiles

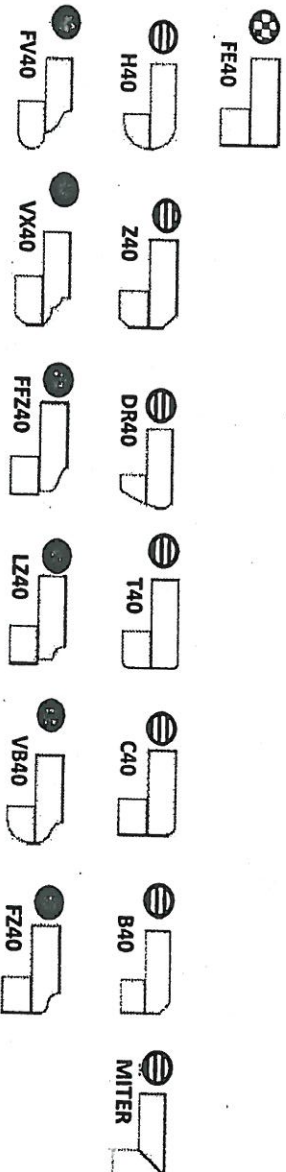


Note: All colours may not be available in 30mm at time ordered. Vendor reserves the right to use 40 mm edges (by lamination process).

*Mitre edge is available in Upgrade 1 for an overall thickness of 2". All other Mitre edge options will be an Upgrade 2 Edge.

BE2-77L
MAR 12 2020

PP

RM

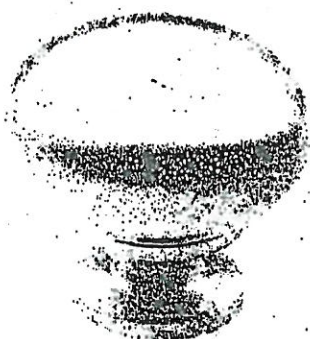


CSI-6




CSI-10




CSI-14

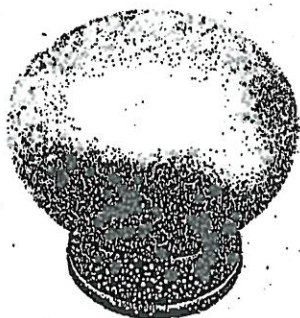

CSI-16

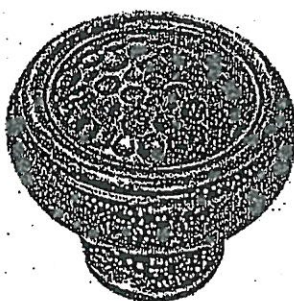

CSI-18

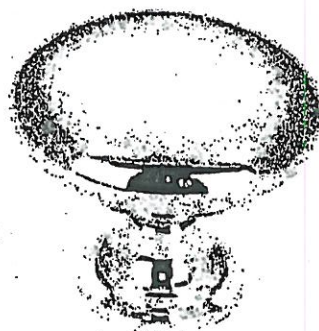

CSI-19



CSI-20




CSI-21




CSI-22



CSI-23

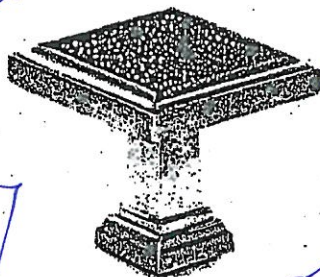

CSI-24

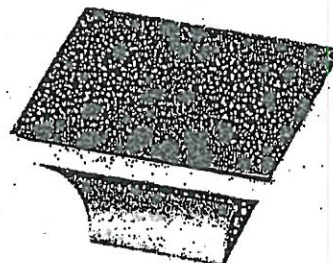

CSI-25

*NOTES:

- IMAGES ARE FOR QUICK REFERENCE PURPOSES ONLY
- ACTUAL SIZES AND FINISHES AS PER HARDWARE SAMPLE BOARD PROVIDED TO DECOR CENTRE



BATHROOM ACCESSORIES

PROJECT: ENCORE 2

LOT: 77L

INSTALL STANDARD BATHROOM ACCESSORIES
THRU OUT (TOWEL BAR, SOAP DISH, TISSUE
HOLDER) **location as per vendor's discretion



DO *NOT* INSTALL STANDARD BATHROOM
ACCESSORIES THRU OUT (TOWEL BAR, SOAP
DISH, TISSUE HOLDER)




SIGNATURE: _____


SIGNATURE: _____

DATE: _____


MARCH 12 2020

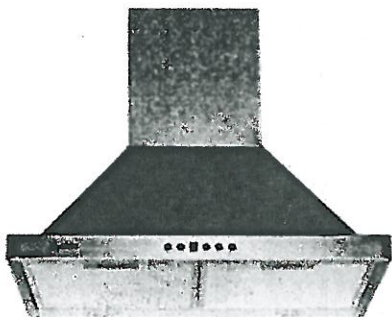

24" Width Model

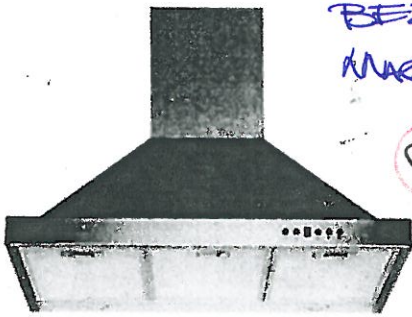

Mesh Filter

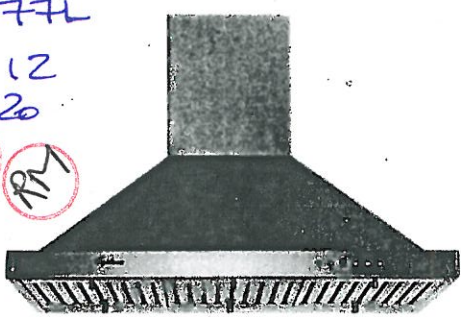


Baffle Filter



BEZ-77L
March 12
2020
PP RM

Wall Mount

Sometimes strength and beauty can co-exist. Strong and sturdy, yet attractive and unimposing, the SC500 combines the eye-pleasing design of European hoods with the power and efficiency of North American fans. A perfect match. Give your kitchen the look, feel, and capability that you have always wanted. Fitted with time-delay "OFF" options up to nine minutes, bright LED lights spaced for optimum light distribution, and a digital three-speed push button control panel.

Specifications

- Air Flow Volume: 550 CFM
 - Electrical Connection: 120V/60Hz
 - Electrical Consumption: 200 Watts
 - Fan Speed: 1599 RPM
 - Finishes: Stainless Steel
 - Venting: 6" Round - Top Only
 - Dimensions: Width: 24"/30"/36"
Height: 46"
Depth: 18"
 - Sones: Min. 2
Max. 6
- 

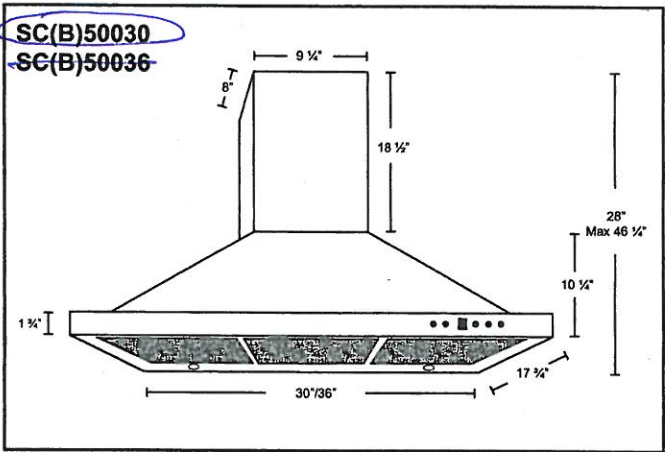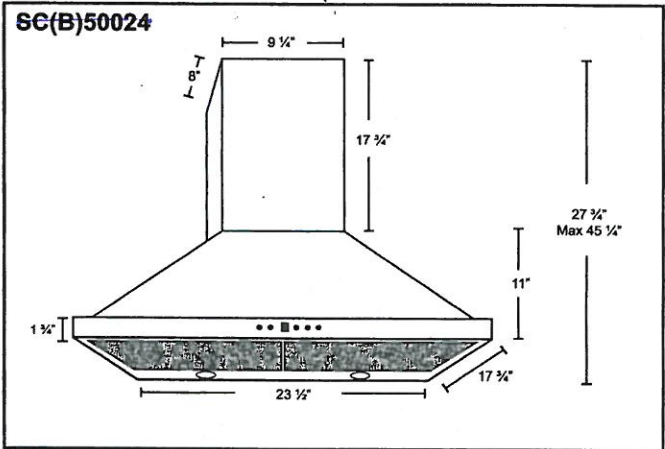

* B in the model name denotes a model with baffle filters.
SC500 - Mesh Filters SCB500 - Baffle Filters

Model	Colour	Venting	Size
SC(B)50024	Stainless Steel	6"	24"
SC(B)50030	Stainless Steel	6"	30"
SC(B)50036	Stainless Steel	6"	36"

The Gershwin SEMI SERIES

→ Elevation A • 1,920 sq.ft.
Elevation B • 1,920 sq.ft.
Elevation C • 1,920 sq.ft.

BEZ-77L



MARCH 12 2020

PP RM

*REVISED MARCH 31 2020

PP RM

smooth ceiling

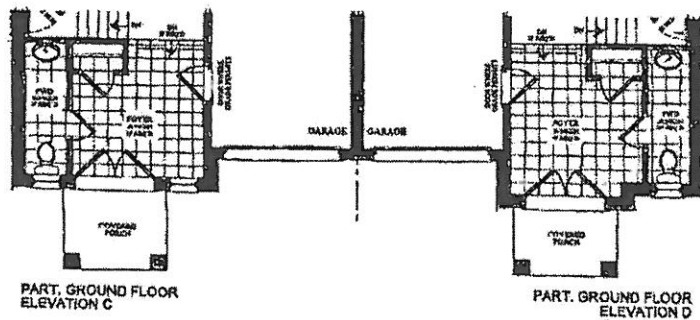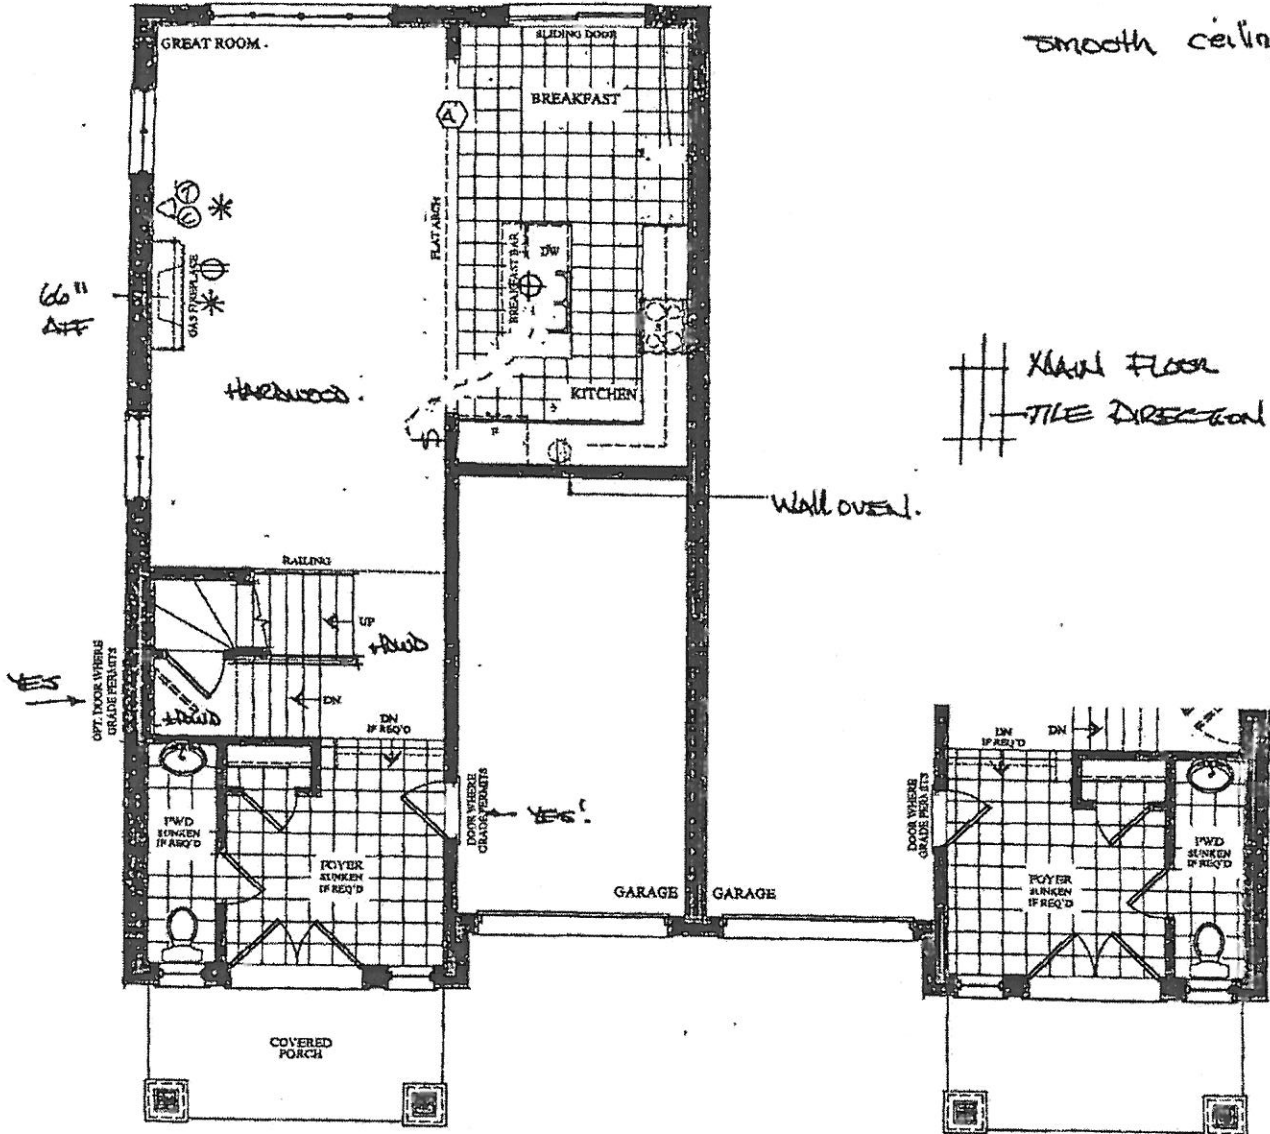

VENDOR
PURCHASER
PURCHASER

GOLDPARK
WORTH MORE™

Prices, figures, illustrations, sizes, features and finishes are subject to change without notice. Areas and dimensions are approximate and actual usable floor space may vary from the stated area. Layout may be reverse of the unit purchased. E. & O.E.

The Gershwin SEMI SERIES

→ Elevation A • 1,920 sq.ft.
Elevation B • 1,920 sq.ft.
Elevation C • 1,920 sq.ft.
Elevation D • 1,920 sq.ft.


BEZ-77L

MAR 12 2020

MAR 31 2020

PP RM

PP RM

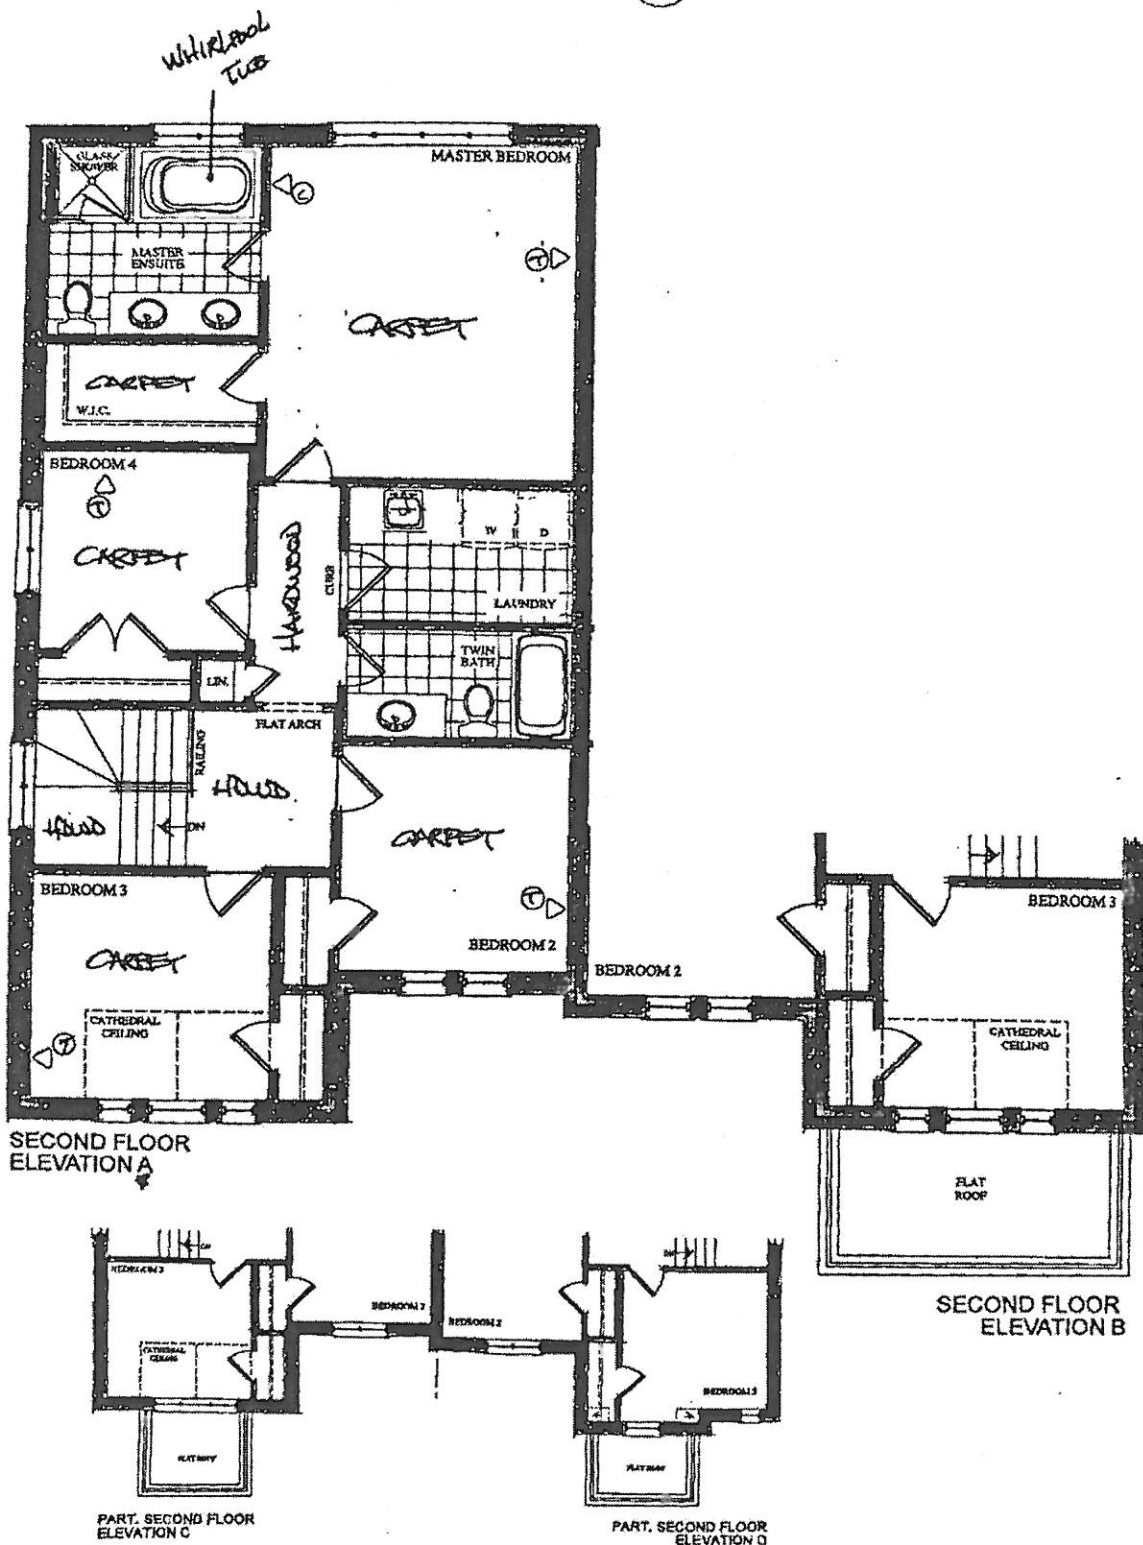

VENDOR

PURCHASER

PURCHASER


GOLDPARK
WORTH MORE™

Prices, figures, illustrations, sizes, features and finishes are subject to change without notice. Areas and dimensions are approximate and actual usable floor space may vary from the stated area. Layout may be reverse of the unit purchased, E. & O.E.


The Gershwin SEMI SERIES

→ Elevation A • 1,920 sq.ft.
Elevation B • 1,920 sq.ft.
Elevation C • 1,920 sq.ft.
Elevation D • 1,920 sq.ft.

DEZ-77L
March 12 2020 PP RM
March 31 2020 PP RM

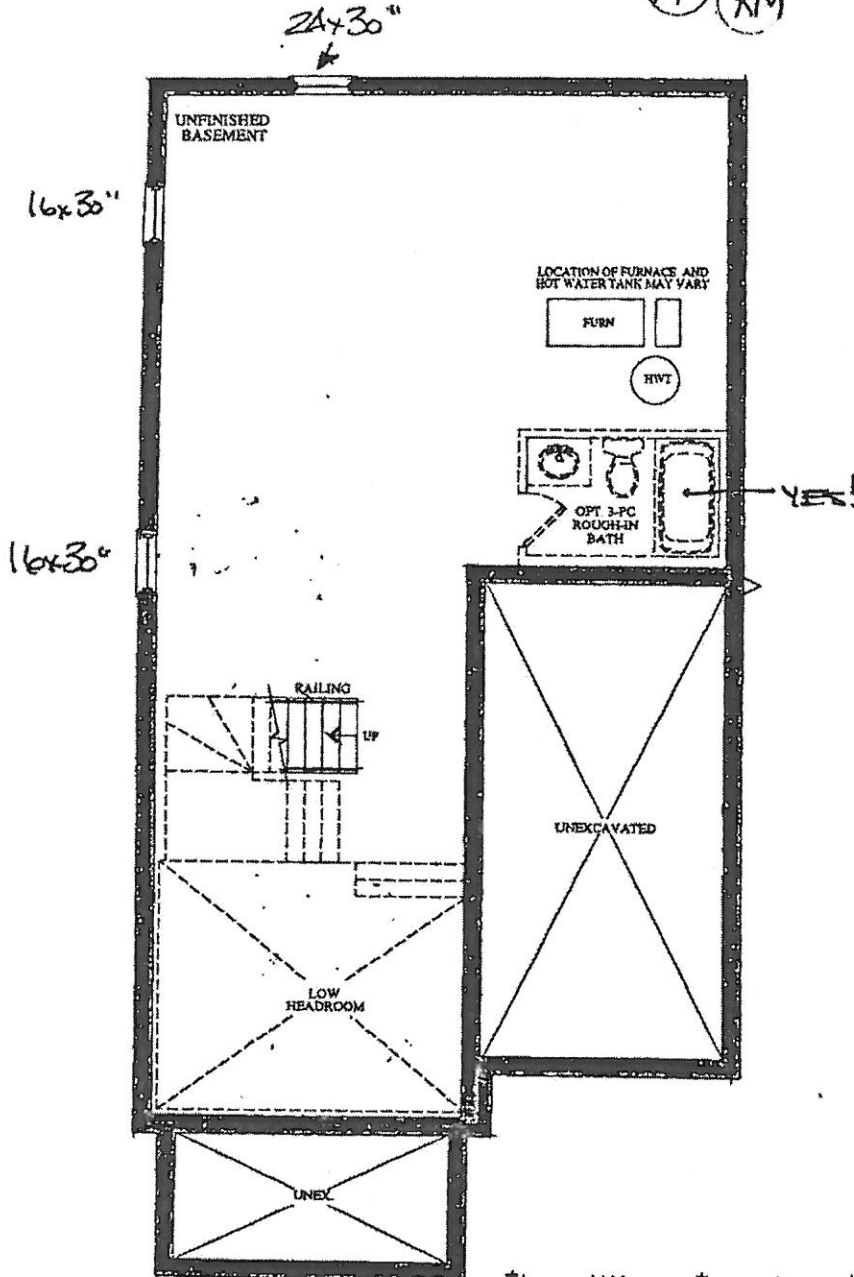

BASEMENT
ELEVATION A & B

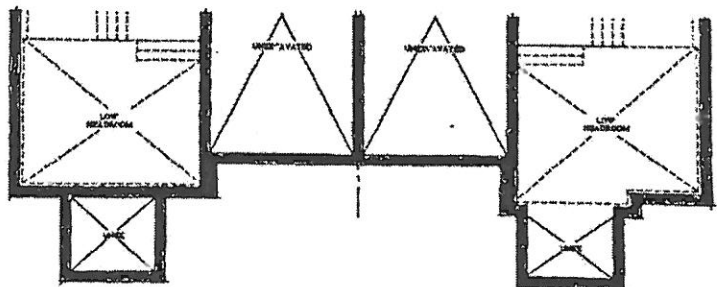

PART. BASEMENT FLOOR
ELEVATION C

PART. BASEMENT FLOOR
ELEVATION D

VENDOR

PURCHASER

PURCHASER

GOLDPARK
WORTH MORE™





Prices, figures, illustrations, sizes, features and finishes are subject to change without notice. Areas and dimensions are approximate and actual usable floor space may vary from the stated area. Layout may be reverse of the unit purchased. E. & O.E.

Trade Name: GOLD PARK	Site location: BRAMPTON	Model: SD-09 GERSHWIN
Address:	Project: ENCORE 2	Phase:

This layout has been explained to the purchaser by Cortina Kitchens Inc. and is understood by the purchaser.

REVISED
March 31 2020

PP RM

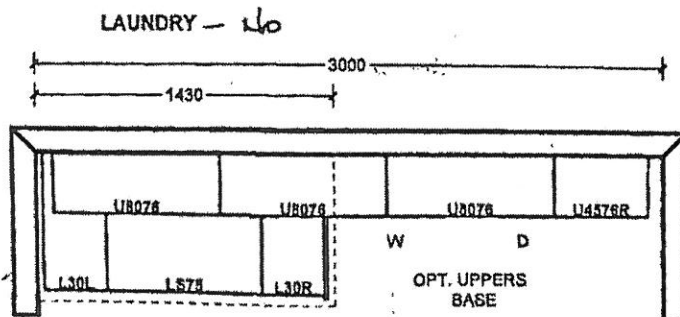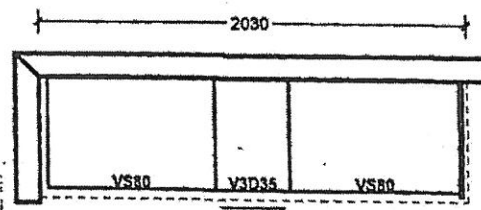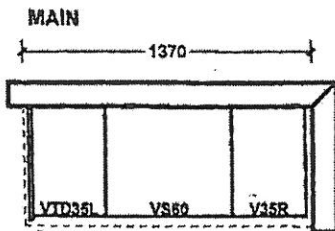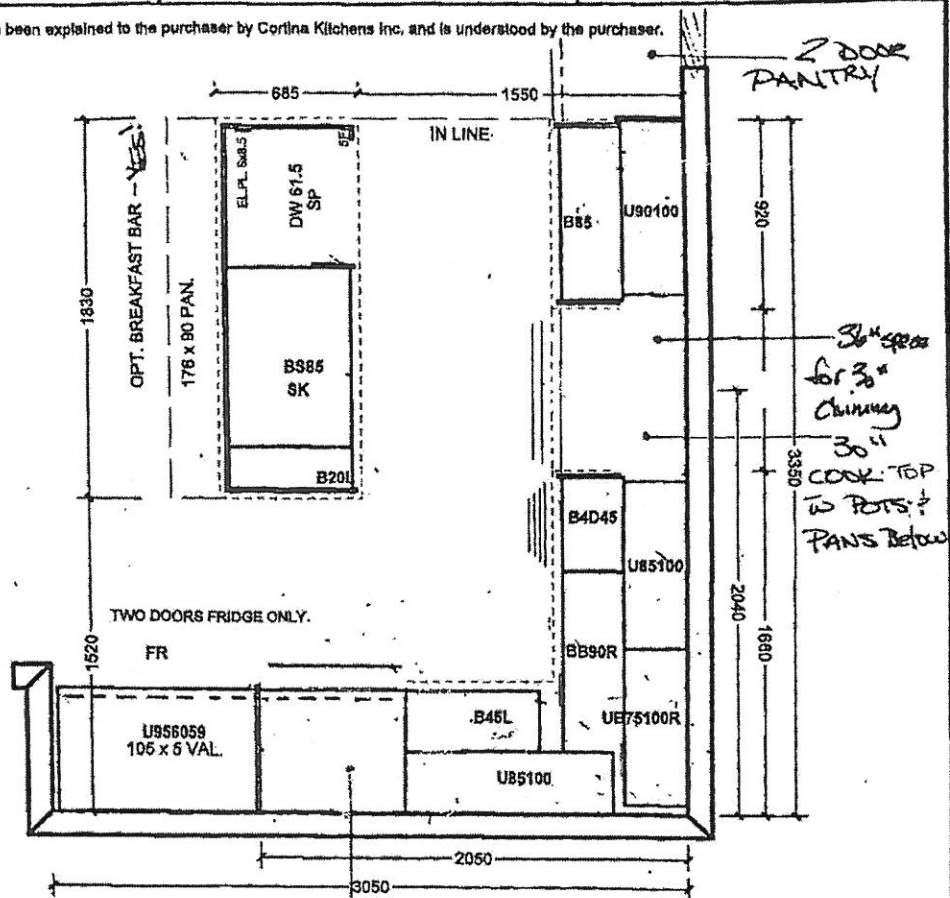

All prices subject to confirmation from head office.
This quotation is subject to the terms & conditions set out
in Cortina's Agreement of Purchase and Sale.

All agreements are contingent upon strikes, accidents, and delays beyond our control.
Please provide our installer with template for sinkholes or \$150.00 will be charged for callback.

ACCEPTED DATE: _____

Customer Signature

Salesperson Signature

Cortina Head Office Approval

Item A. Wood grain and colour are characteristics of the product. We cannot guarantee that such grain and colour will always match.
Item B. Cortina Kitchens Inc. reserves the right to alter dimensions and make technical changes without notice.

The Gershwin SEMI SERIES

→ Elevation A • 1,920 sq.ft.
Elevation B • 1,920 sq.ft.
Elevation C • 1,920 sq.ft.

BE2-77L

MAR 12 2020



PP

RM

*REVISED MAR 31 2020



smooth ceiling

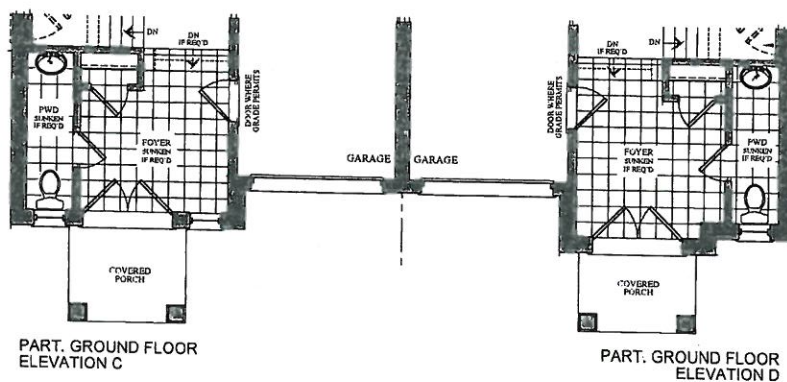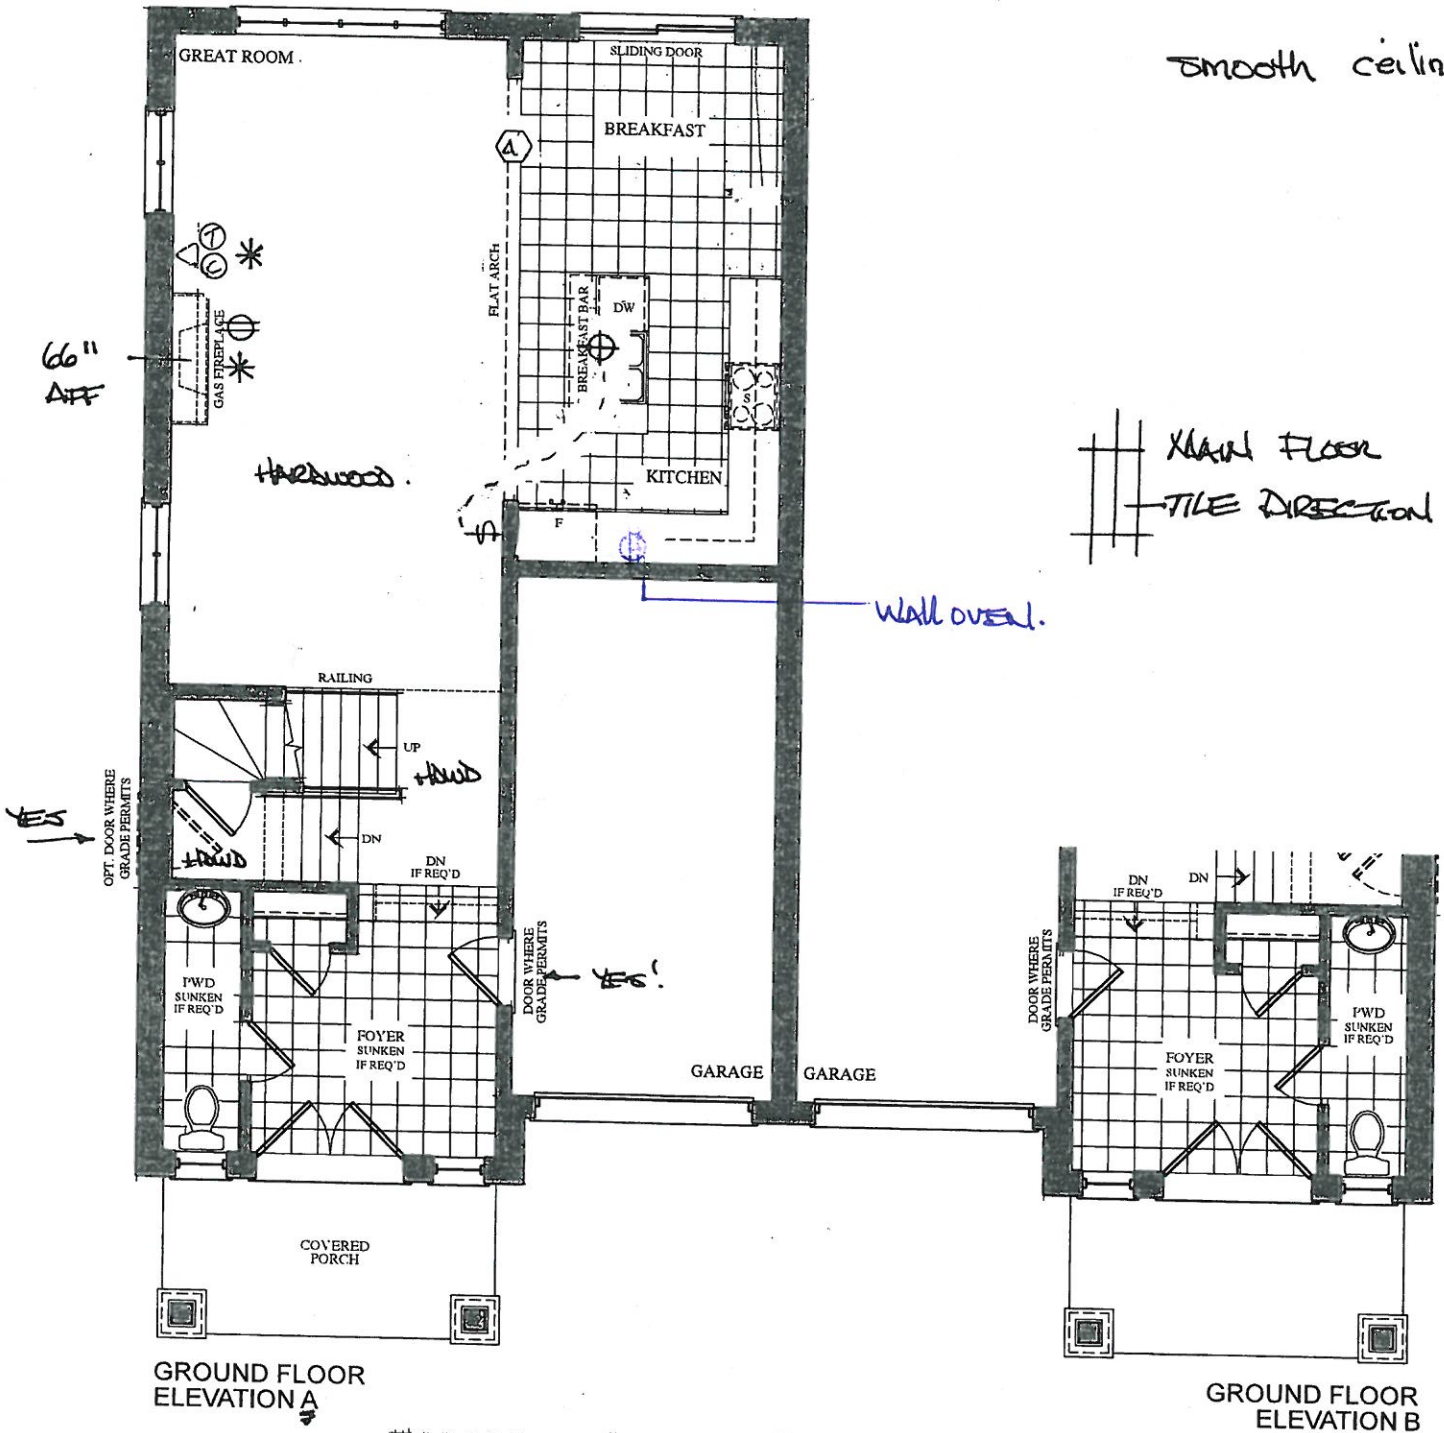

VENDOR

PURCHASER

PURCHASER

GOLDPARK
WORTH MORE™


Prices, figures, illustrations, sizes, features and finishes are subject to change without notice. Areas and dimensions are approximate and actual usable floor space may vary from the stated area. Layout may be reverse of the unit purchased. E. & O.E.

The Gershwin SEMI SERIES

→ Elevation A • 1,920 sq.ft.
Elevation B • 1,920 sq.ft.
Elevation C • 1,920 sq.ft.
Elevation D • 1,920 sq.ft.

REZ-77L
March 12 2020

March 31 2020

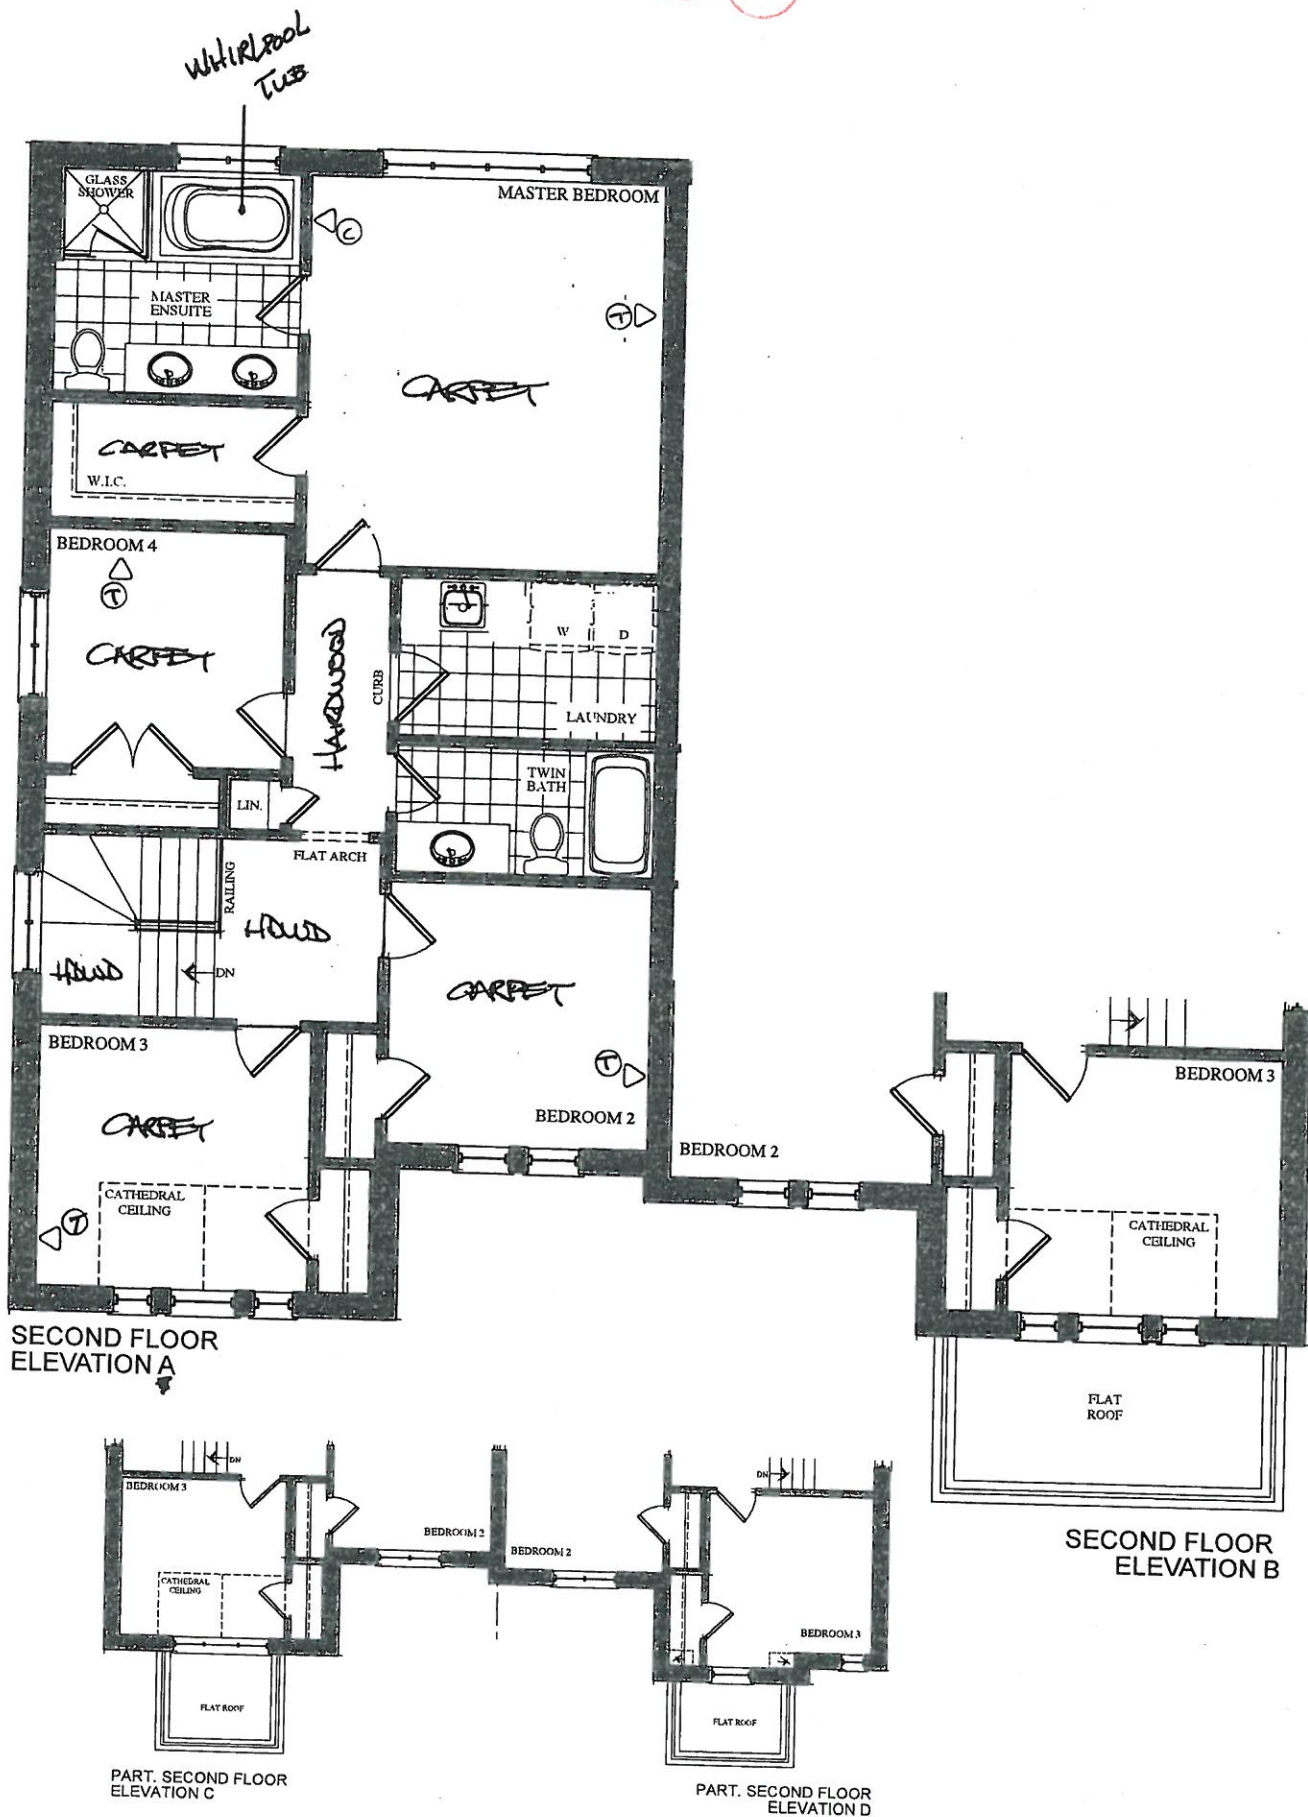


VENDOR
PURCHASER
PURCHASER

GOLDPARK
WORTH MORE™


Prices, figures, illustrations, sizes, features and finishes are subject to change without notice. Areas and dimensions are approximate and actual usable floor space may vary from the stated area. Layout may be reverse of the unit purchased. E. & O.E.

The
Gershwin
SEMI SERIES

→ Elevation A • 1,920 sq.ft.
Elevation B • 1,920 sq.ft.
Elevation C • 1,920 sq.ft.
Elevation D • 1,920 sq.ft.

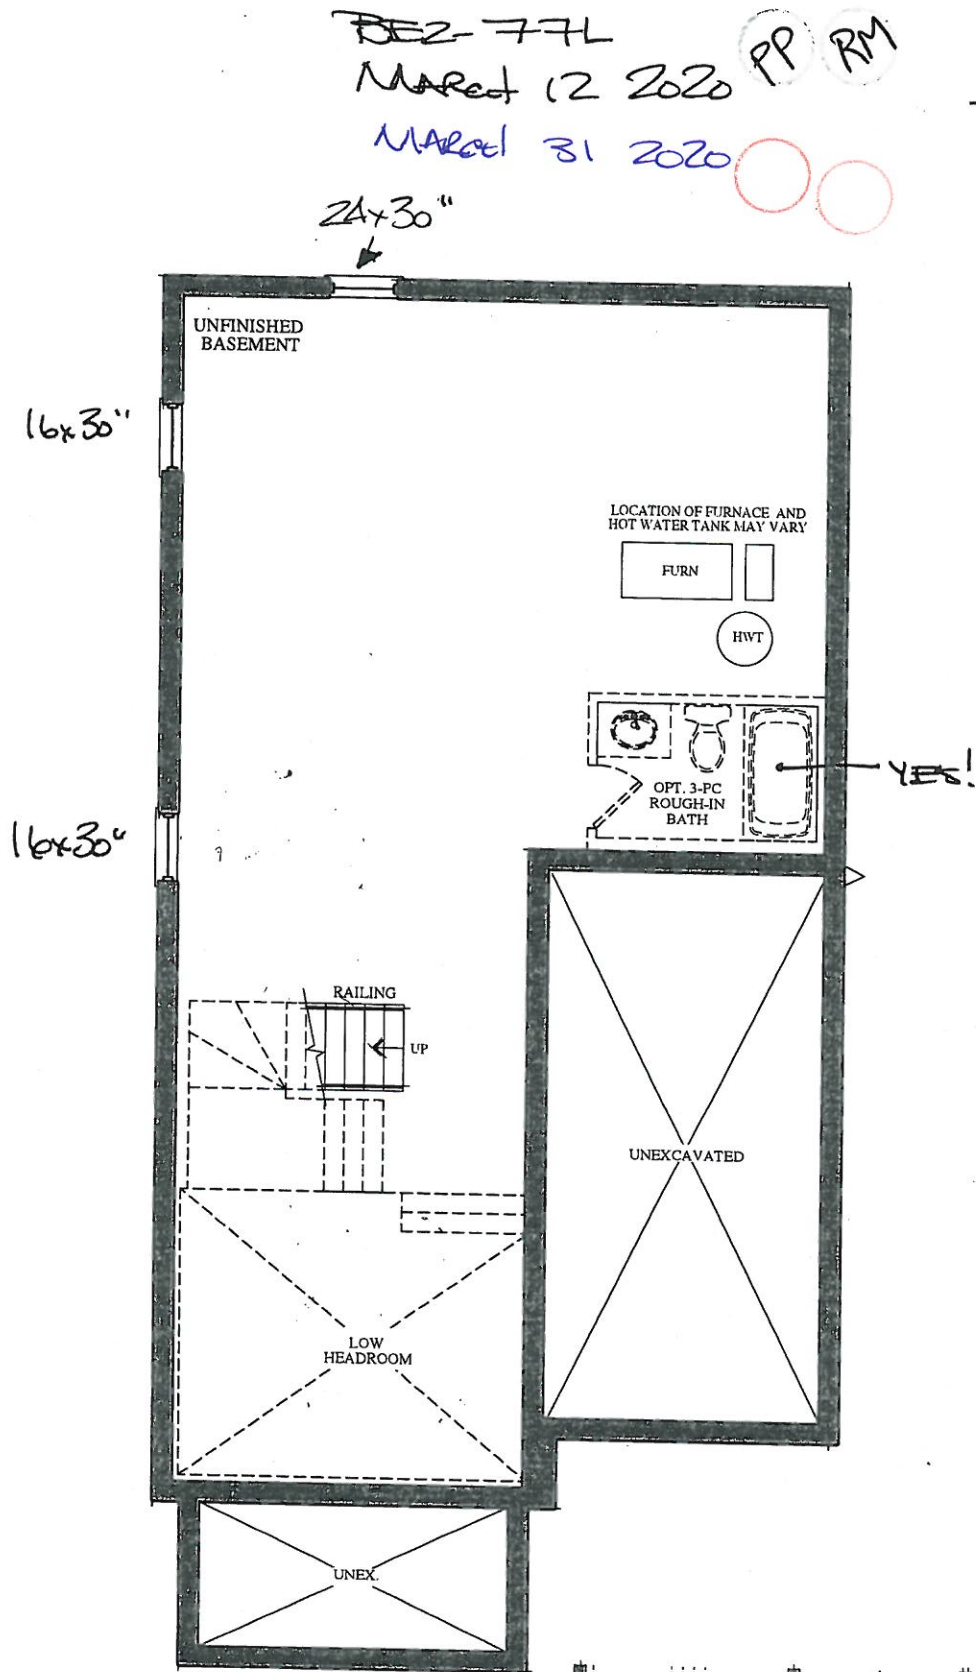

BASEMENT
ELEVATION A & B

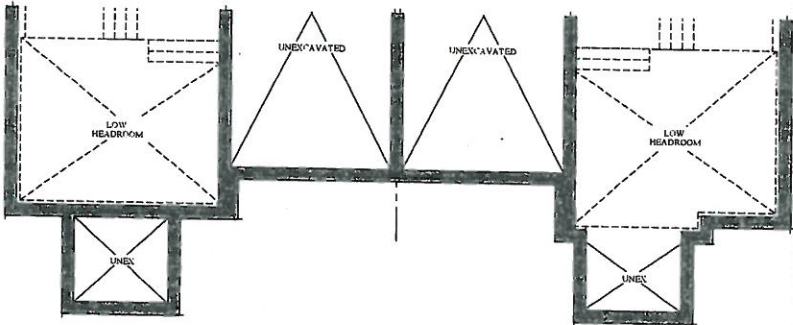

PART. BASEMENT FLOOR
ELEVATION C

PART. BASEMENT FLOOR
ELEVATION D

VENDOR






PURCHASER

PURCHASER

GOLDPARK
WORTH MORE™

Prices, figures, illustrations, sizes, features and finishes are subject to change without notice. Areas and dimensions are approximate and actual usable floor space may vary from the stated area. Layout may be reverse of the unit purchased. E. & O.E.

This layout has been explained to the purchaser by Cortina Kitchens Inc. and is understood by the purchaser.

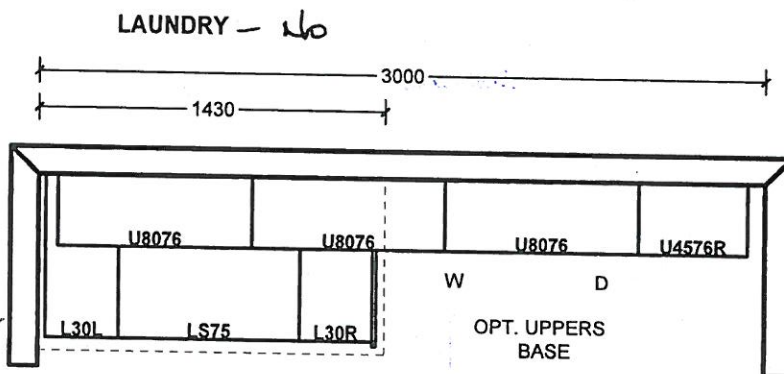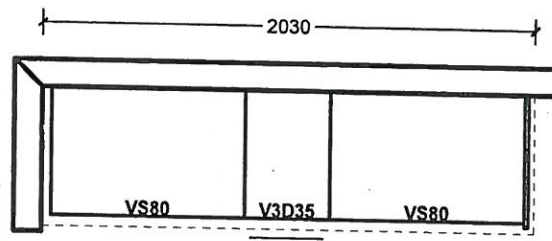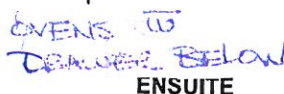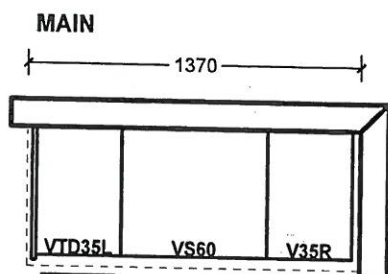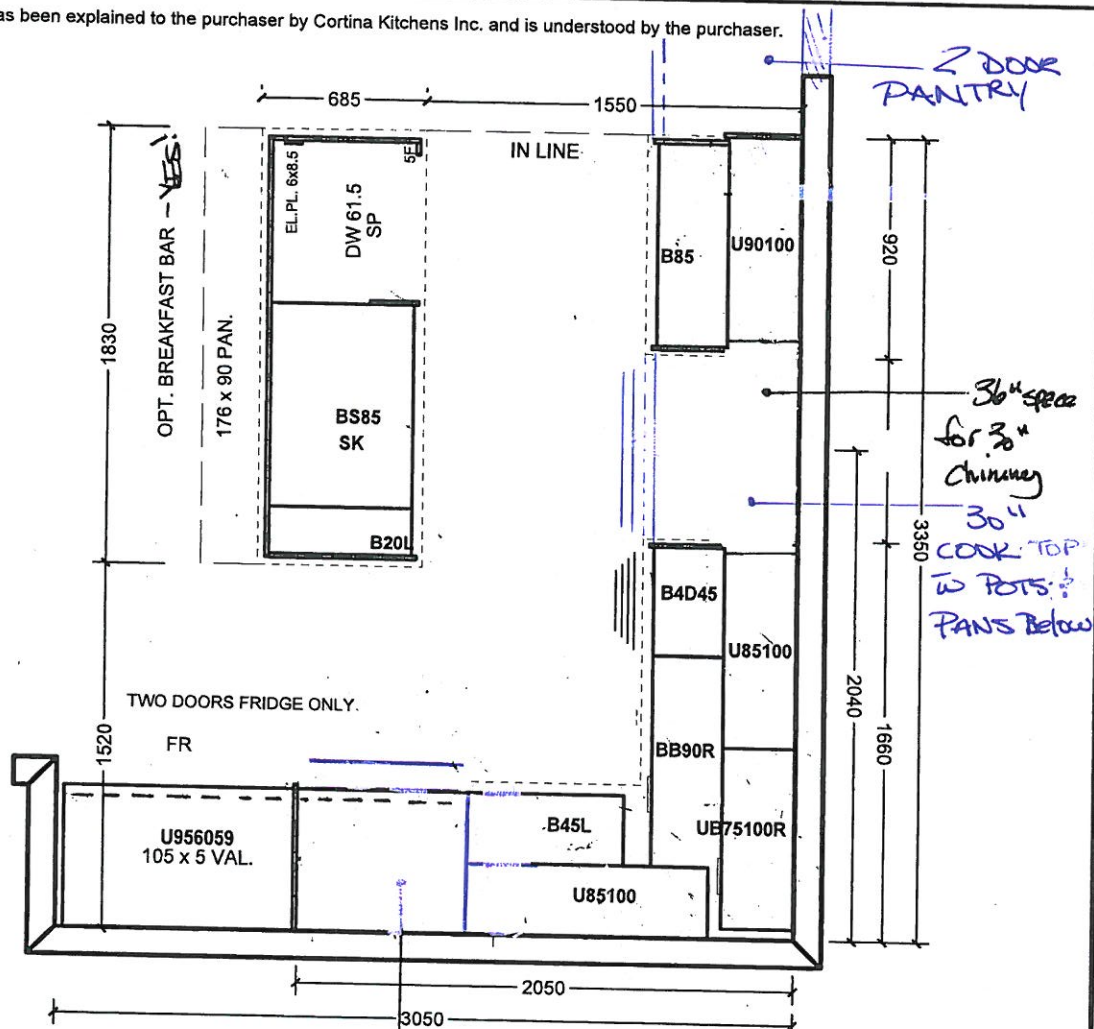

ACCEPTED DATE:_____

Cortina Head Office Approval

Item A. Wood grain and colour are characteristics of the product. We cannot guarantee that such grain and colour will always match.
Item B. Cortina Kitchens Inc. reserves the right to alter dimensions and make technical changes without notice.

Whirlpool®

Whirlpool Gold® 30-inch Electric Induction Cooktop

Model: GCI3061XB

MSRP:

RM
PP

FeaturesReviewsSpecs & ManualsWhere To BuyManuals & Guides


Dimensions

* Cutout Depth	49.05 cm, 19-5/16 in	* Cutout Width	74.93 cm, 29-1/2 in
Depth	54.13 cm, 21-5/16 in	Height	6.93 cm, 2-3/8 in
Width	77.15 cm, 30-3/8 in		

Configuration and Overview

Cooktop Type	Standard	Fuel Type	Electric Induction
Installs Over Built-In Oven	No	Size	76.20 cm, 30 in

Controls

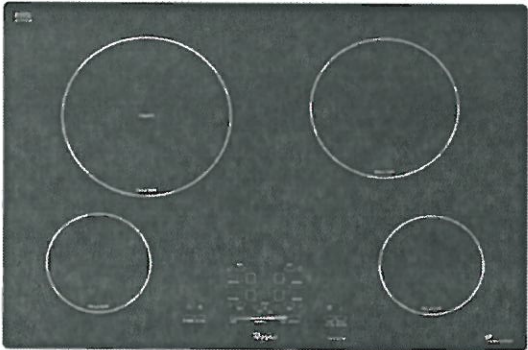

Whirlpool Gold® 30-inch Electric Induction Cooktop

GCI3061XB | 3.8 (25) Write a review

MSRP: \$1,899.99

Colour: Black



Where to buy

WishList Compare

Whirlpool®

6.4 cu. ft. Smart Combination Wall Oven with Touchscreen
Model: WOC75EC0HS

MSRP

- Features
- Reviews
- Specs & Manuals
- Where To Buy
- Manuals & Guides

Dimensions

BE2-77L

Capacity	6-2/5	Cutout Depth	60.96 cm, 24.0 in
Cutout Height	104.93 cm, 41.5/16 in	Cutout Width	72.39 cm, 28-1/2 in
Depth	59.06 cm, 23-1/4 in	Depth Closed Excluding Handles	62.23 cm, 24-1/2 in
Depth With Door Open 90 Degree	118.74 cm, 46-3/4 in	Height	108.11 cm, 42-9/16 in
Microwave Capacity	39.62 l, 1.4 cu. ft.	Oven Capacity	141.50 l, 5.0 cu. ft.
Width	76.20 cm, 30.0 in		

Configuration and Overview

Fuel Type	Electric	Oven Type	Combination
Size	76.20 cm, 30 in		



6.4 cu. ft. Smart Combination Wall Oven with Touchscreen

WOC75EC0HS | ★★★★★ 1.0 (1) Write a review

RM
PP

MSRP: \$3,799.99

Colour: Stainless Steel



Where to buy

WishList Compare

BE2-77L

RF265BEAESR French Door with Family Hub, 24.2 cu. ft

WHERE TO BUY

BENEFITS

SPECS

REVIEWS

SUPPORT

COMPARE

RM
PP

137 kg	Twin Cooling Plus™	<div></div> 35 3/4 x 70 x 35 5/8 inch	24.2 cu.ft
Net Weight(kg)	Twin Cooling Plus™	Net Dimension (WxHxD)(inch)	Net Total(cu.ft)

RF265BEAESR French Door with Family Hub, 24.2 cu. ft

WHERE TO BUY


BENEFITS

SPECS

REVIEWS

SUPPORT

COMPARE



RF265BEAESR French Door with Family Hub, 24.2 cu. ft

RF265BEAESR/AC

3.6 (174) Write a review

• Food Management

• Family Communication

• Entertainment

• Connected Living

WHERE TO BUY