




LOT NUMBER: 98
UNIT NAME: THE KNIGHTSWOOD
ELEVATION: B (REV)
UNIT NUMBER: 5005

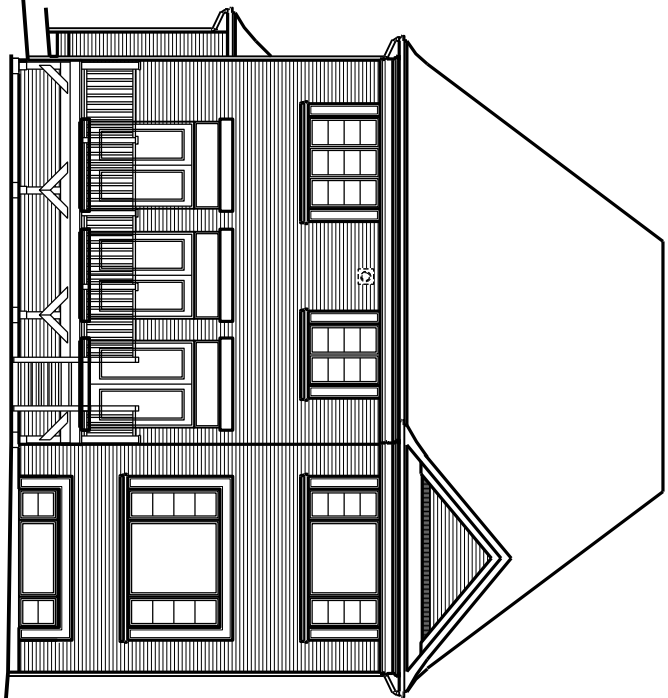

LOT NUMBER: 99
UNIT NAME: OAKGROVE
ELEVATION: B
UNIT NUMBER: 5003

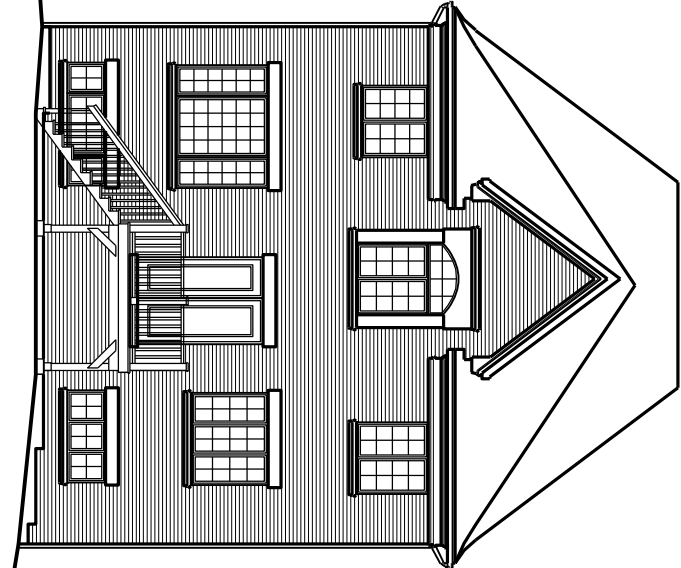


LOT NUMBER: 100
UNIT NAME: FORESTCREST
ELEVATION: A (REV)
UNIT NUMBER: 4203

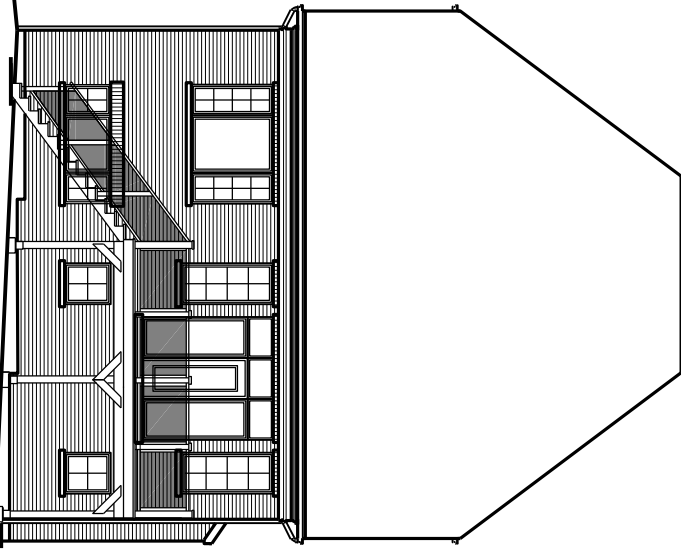


LOT NUMBER: 101
UNIT NAME: THE BRIARWOOD
ELEVATION: A
UNIT NUMBER: 4000


PURPLE CREEK ROAD

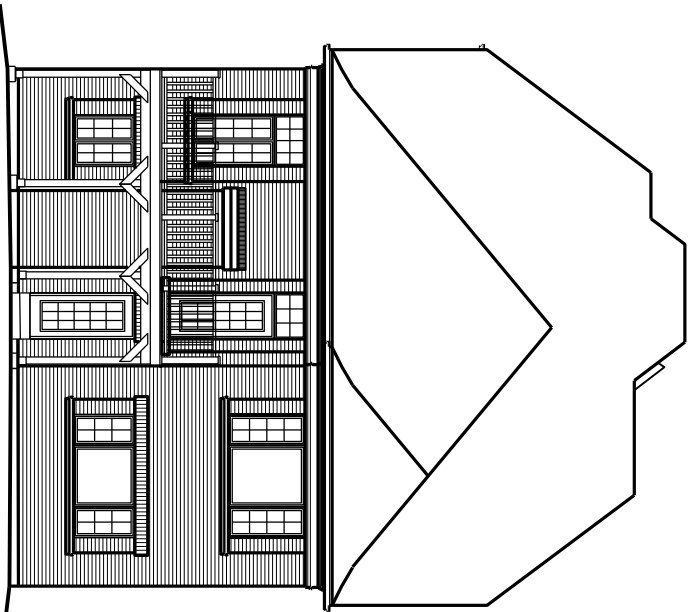

LOT NUMBER: 102
UNIT NAME: MAPLEWOOD
ELEVATION: A (REV)
UNIT NUMBER: 4201

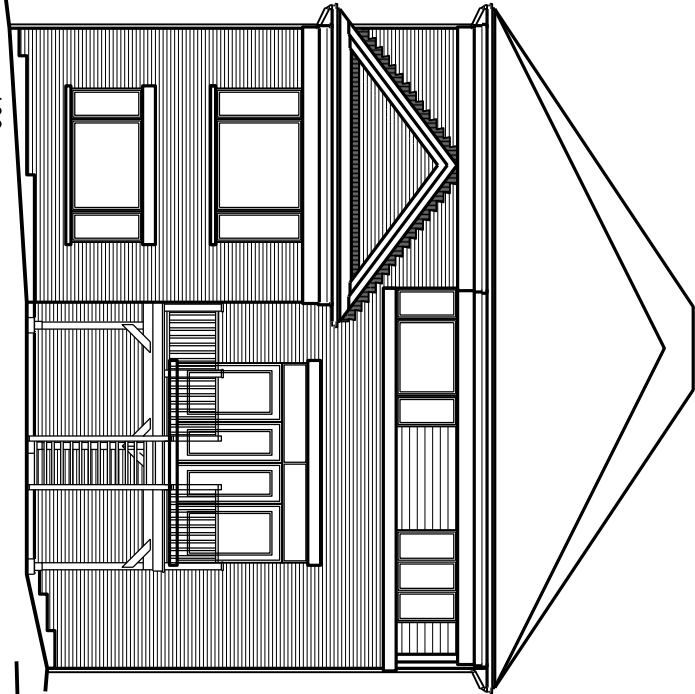

LOT NUMBER: 103
UNIT NAME: THE BEAUMONT
ELEVATION: UPG. REAR EL. C
UNIT NUMBER: 5004

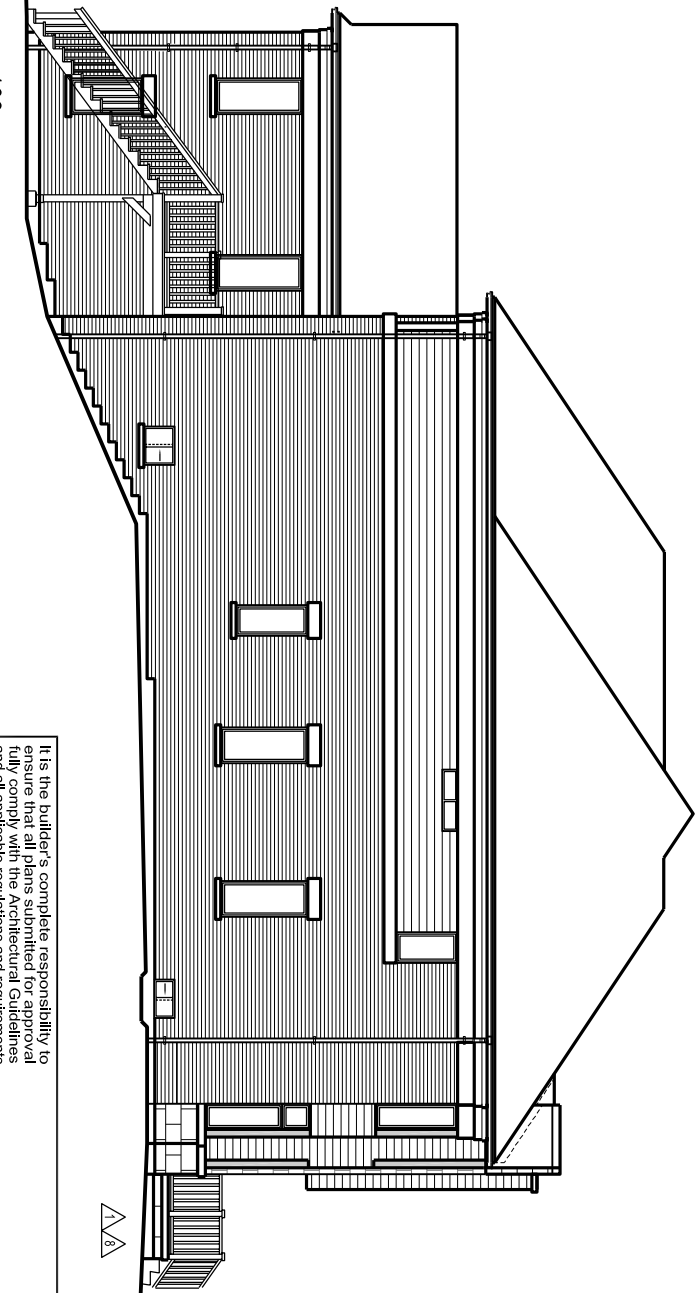

LOT NUMBER: 103
UNIT NAME: THE BEAUMONT
ELEVATION: UPG. SIDE EL. C
UNIT NUMBER: 5004

PURPLE CREEK ROAD

It is the builder's complete responsibility to ensure that all plans submitted for approval fully comply with the Architectural Guidelines and all applicable regulations and requirements including zoning provisions and any provisions in the applicable zoning bylaws. The Architect is not responsible in any way for examining or approving site (lotting) plans or working drawings with respect to any zoning or building code or permit matter or that any house can be properly built or located on its lot. This is to certify that these plans comply with the applicable Architectural Design Guidelines approved by the City of VAUGHAN.



LEGEND:

1. BRICK/STONE VENER ON SIDES OF STAIRS
POURED OR BRICK LEDGE PRECAST

2. DROP OR RAISE RAINING
BY AMOUNT INDICATED.

3. ADD BANDING AND/OR TRIM
AS INDICATED.

4. ADDED CAMBERED HEADERS

8. PROVIDE GUARD PER
CONSTRUCTION NOTE 11.

9. FOYER SUNKEN AS INDICATED

5. 8'-0" X 8'-0" GARAGE DOORS,
LIGHT FIXTURE RELOCATED
AS INDICATED.



DESIGN ASSOCIATES INC.
WWW.HUNTDESIGN.CA

GOLDPARK HOMES - 217020
PINE VALLEY, VAUGHAN ONT.
8966 Woodbine Ave. Markham, ON L3R 0J7 ■ T 905.797.5133 ■ F 905.797.7326 ■ 2020/07/22 ■ NEA ■

STREETSCAPES - (LOTS 98-103)
PAGE XX
217020WSS01