




LOT NUMBER: 115
UNIT NAME: FORESTCREST
ELEVATION: A (REV)
UNIT NUMBER: 4203

ROSSHAVEN CRESCENT



LOT NUMBER: 110
UNIT NAME: THE KNIGHTSWOOD
ELEVATION: B (REV)
UNIT NUMBER: 5005

PURPLE CREEK ROAD

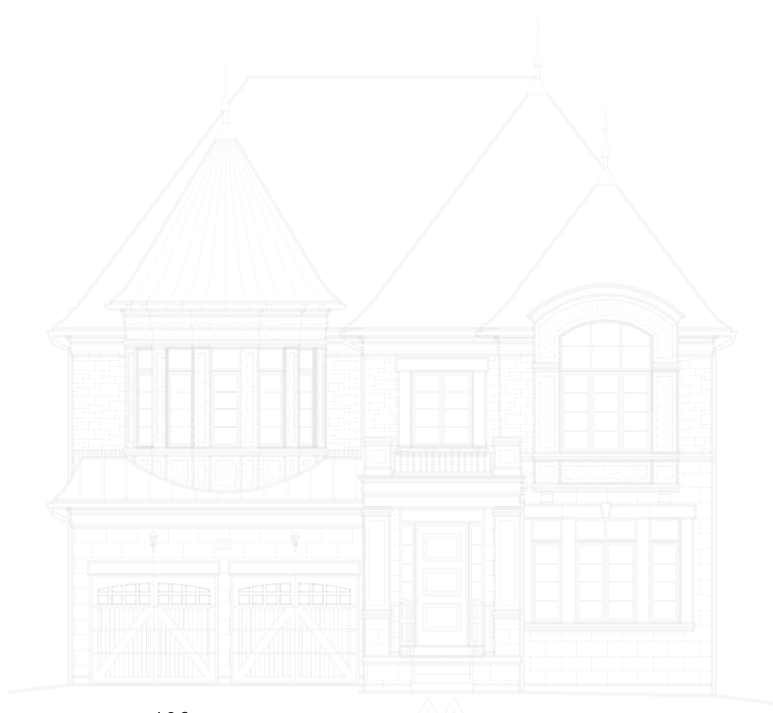

LOT NUMBER: 106
UNIT NAME: THE KNIGHTSWOOD
ELEVATION: B (REV)
UNIT NUMBER: 5005



LOT NUMBER: 122
UNIT NAME: VALLEYVIEW
ELEVATION: A (REV)
UNIT NUMBER: 4002



LOT NUMBER: 121
UNIT NAME: SUMMERDALE
ELEVATION: B (REV)
UNIT NUMBER: 4001

ROSSHAVEN CRESCENT



LOT NUMBER: 120
UNIT NAME: VALLEYVIEW
ELEVATION: B
UNIT NUMBER: 4002



LOT NUMBER: 119
UNIT NAME: SUMMERDALE
ELEVATION: A (REV)
UNIT NUMBER: 4001

It is the builder's complete responsibility to ensure that all plans submitted for approval fully comply with the Architectural Guidelines and all applicable regulations and requirements including zoning provisions and any provisions in the subdivision agreement. The Control Architect is not responsible in any way for examining or approving site (lotting) plans or working drawings with respect to any zoning or building code or permit matter or that any house can be properly built or located on its lot.

This is to certify that these plans comply with the applicable Architectural Design Guidelines approved by the City of VAUGHAN.

LOTS 120 - 122

JOHN G. WILLIAMS LTD., ARCHITECT
ARCHITECTURAL CONTROL REVIEW
AND APPROVAL

APPROVED BY:
DATE: FEB 12, 2020

This stamp certifies compliance with the applicable Design Guidelines only and bears no further professional responsibility.

LEGEND:

- | | | | | |
|--|---|---|-----------------------------|--|
| 1 BRICK/ STONE VENEER ON SIDES OF STAIRS (POURED OR "BRICK LEDGE" PRECAST) | 2 DROP OR RAISE BANDING BY AMOUNT INDICATED. | 3 ADD BANDING AND/OR TRIM AS INDICATED. | 4 ADDED CAMBERED HEADERS | 5 8'-0" X 8'-0" GARAGE DOORS. |
| 6 DROPPED OR RAISED SOFFIT AS INDICATED. | 7 ADJUSTED ROOF OVERHANG AS INDICATED ON ROOF PLAN. | 8 PROVIDE GUARD FER CONSTRUCTION NOTE 11. | 9 FOYER SUNKEN AS INDICATED | 10 LIGHT FIXTURE RELOCATED AS INDICATED. |

HUNT
DESIGN ASSOCIATES INC.
www.huntdesign.ca

CLIENT NAME - PROJECT NUMBER

PROJECT NAME, MUNICIPALITY, PROVINCE

8966 Woodbine Ave, Markham, ON L3R 0J7 ■ T 905.737.5133 ■ F 905.737.7326 ■ 2018/09/11 ■ OF ■

All drawings specifications, related documents and design are the copyright property of Hunt Design Associates (H.D.A.). Reproduction of this property in whole or in part is strictly prohibited without H.D.A.'s written permission.

STREETSCAPES (LOTS 106, 110, 115, 119-122)

PAGE XX

217020WSS01