

CONCRETE AND DRAIN

Invoice	Qty.	Description
2245 06Aug20 NoCat	1	.BACK-FLOW PREVENTER VALVE
2245 06Aug20 NoCat	1	**CUSTOM LAYOUT** BUILD ADDITIONAL THIRD CAR GARAGE SPACE WITH TANDEM. PURCHASER ACKNOWLEDGES THAT EXISTING WINDOW IN BEDROOM 2 WILL BE REDUCED IN SIZE AND/OR RELOCATED ALONG THE WALL TO PERMIT TANDEM INCLUDED IN APS
2245 06Aug20 NoCat	1	**CUSTOM LAYOUT** VENDOR TO EXTEND THREE CAR GARAGE SPACE TO APPROXIMATELY 30 FEET WIDE AND INSTALL GARAGE DOORS THAT ARE APPROXIMATELY ONE FOOT WIDER AND TALLER THAN STANDARD SIZE
2245 06Aug20 NoCat	1	**CUSTOM LAYOUT** VENDOR TO SUPPLY AND INSTALL OPTIONAL COVERED LOGGIA AS PER PLAN

CROWN MOULDING

Invoice	Qty.	Description
2379 06Aug20 NoCat	1	.FAMILY ROOM - OPT. COFFERED CEILING AS PER PLAN
2379 06Aug20 NoCat	1	.FAMILY ROOM - OPT. WAFFLE CEILING, BEAM DETAIL AS PER PLAN (6 BOXES) OPTION#1 CTR-B07

DRYWALL

Invoice	Qty.	Description
2245 06Aug20 NoCat	1	**CUSTOM LAYOUT** BUILD ADDITIONAL THIRD CAR GARAGE SPACE WITH TANDEM. PURCHASER ACKNOWLEDGES THAT EXISTING WINDOW IN BEDROOM 2 WILL BE REDUCED IN SIZE AND/OR RELOCATED ALONG THE WALL TO PERMIT TANDEM
2245 06Aug20 NoCat	1	**CUSTOM LAYOUT** VENDOR TO EXTEND THREE CAR GARAGE SPACE TO APPROXIMATELY 30 FEET WIDE AND INSTALL GARAGE DOORS THAT ARE APPROXIMATELY ONE FOOT WIDER AND TALLER THAN STANDARD SIZE
2379 06Aug20 NoCat	1	.MASTER BEDROOM: UPGRADE EXTERIOR GARDEN DOOR ASSEMBLY TO 96"
2379 06Aug20 NoCat	1	.GREAT ROOM: UPGRADE EXTERIOR SLIDING DOOR ASSEMBLY TO 96"
2379 06Aug20 NoCat	1	.FAMILY ROOM - OPT. COFFERED CEILING AS PER PLAN
2379 06Aug20 NoCat	1	.FAMILY ROOM - OPT. WAFFLE CEILING, BEAM DETAIL AS PER PLAN (6 BOXES) OPTION#1 CTR-B07

ELECTRICAL

Invoice	Qty.	Description
2379 72,307 06Aug20	1	.KITCHEN: FIXTURE: RELOCATE STANDARD CEILING MOUNT FIXTURE LOCATE ABOVE ISLAND, SEE PLAN FOR LOCATION
2379 72,280 06Aug20	1	.KITCHEN: CEILING OUTLET: ADDITIONAL REINFORCED CEILING OUTLET - LOCATE ABOVE ISLAND, USE SAME SWITCH AS STANDARD LIGHT
2379 72,289 06Aug20	6	.MAIN HALL: 4" E/S LED INTERIOR POT LIGHT - GROUND FLOOR - EACH -SEE PLAN FOR LOCATION IN LIEU OF STANDARD CEILING LIGHTS - USE STANDARD SWITCH INCLUDED IN APS
2379 06Aug20 NoCat	1	.GREAT ROOM: FIREPLACE - ADD HEAT ACTIVATED FAN

EXTERIOR COLOURS

Invoice	Qty.	Description
2245 06Aug20 NoCat	1	EXTERIOR COLOUR PACKAGE # BR.1

FIREPLACE

Invoice Qty. Description

2379 72,321 06Aug20	1	.GREAT ROOM: FIREPLACE - ADD HEAT ACTIVATED FAN
---------------------------	---	---

FORMING

Invoice Qty. Description

2245 06Aug20 NoCat	1	**CUSTOM LAYOUT** VENDOR TO PROVIDE A SERVICE STAIRCASE TO BASEMENT INCLUDED IN APS
2245 06Aug20 NoCat	1	**CUSTOM LAYOUT** VENDOR TO SUPPLY AND INSTALL OPTIONAL COVERED LOGGIA AS PER PLAN INCLUDED IN APS
2245 06Aug20 NoCat	3	.BASEMENT WINDOWS - UPGRADE BASEMENT WINDOW SIZE TO 30 " X 24" - 10" FRAME (PINEVALLEY 50 FOOT LOTS ONLY)
2245 06Aug20 NoCat	1	.BASEMENT WINDOWS - EGRESS BASEMENT WINDOW 40" X 24" - 10" FRAME (PINEVALLEY 50 FOOT LOTS ONLY)
2245 06Aug20 NoCat	1	**CUSTOM LAYOUT** BUILD ADDITIONAL THIRD CAR GARAGE SPACE WITH TANDEM. PURCHASER ACKNOWLEDGES THAT EXISTING WINDOW IN BEDROOM 2 WILL BE REDUCED IN SIZE AND/OR RELOCATED ALONG THE WALL TO PERMIT TANDEM
2245 06Aug20 NoCat	1	**CUSTOM LAYOUT** VENDOR TO EXTEND THREE CAR GARAGE SPACE TO APPROXIMATELY 30 FEET WIDE AND INSTALL GARAGE DOORS THAT ARE APPROXIMATELY ONE FOOT WIDER AND TALLER THAN STANDARD SIZE
2379 06Aug20 NoCat	1	.GREAT ROOM: UPGRADE EXTERIOR SLIDING DOOR ASSEMBLY TO 96"
2379 06Aug20 NoCat	1	.MASTER BEDROOM: UPGRADE EXTERIOR GARDEN DOOR ASSEMBLY TO 96"
2379 06Aug20 NoCat	1	.KITCHEN - UPGRADE TO 8" DUCT (INTERIOR WALL) IN LIEU OF STANDARD OFFERING

FRAMING

Invoice	Qty.	Description
2245 06Aug20 NoCat	1	**CUSTOM LAYOUT** VENDOR TO EXTEND THREE CAR GARAGE SPACE TO APPROXIMATELY 30 FEET WIDE AND INSTALL GARAGE DOORS THAT ARE APPROXIMATELY ONE FOOT WIDER AND TALLER THAN STANDARD SIZE INCLUDED IN APS
2245 06Aug20 NoCat	3	.BASEMENT WINDOWS - UPGRADE BASEMENT WINDOW SIZE TO 30 " X 24" - 10" FRAME (PINEVALLEY 50 FOOT LOTS ONLY)
2245 06Aug20 NoCat	1	.BASEMENT WINDOWS - EGRESS BASEMENT WINDOW 40" X 24" - 10" FRAME (PINEVALLEY 50 FOOT LOTS ONLY)
2245 06Aug20 NoCat	1	**CUSTOM LAYOUT** BUILD ADDITIONAL THIRD CAR GARAGE SPACE WITH TANDEM. PURCHASER ACKNOWLEDGES THAT EXISTING WINDOW IN BEDROOM 2 WILL BE REDUCED IN SIZE AND/OR RELOCATED ALONG THE WALL TO PERMIT TANDEM
2245 06Aug20 NoCat	1	**CUSTOM LAYOUT** VENDOR TO PROVIDE A SERVICE STAIRCASE TO BASEMENT
2245 06Aug20 NoCat	1	**CUSTOM LAYOUT** VENDOR TO SUPPLY AND INSTALL OPTIONAL COVERED LOGGIA AS PER PLAN
2379 06Aug20 NoCat	1	.GREAT ROOM: UPGRADE EXTERIOR SLIDING DOOR ASSEMBLY TO 96"
2379 06Aug20 NoCat	1	.MASTER BEDROOM: UPGRADE EXTERIOR GARDEN DOOR ASSEMBLY TO 96"
2379 72,609 06Aug20	1	.FAMILY ROOM - OPT. COFFERED CEILING AS PER PLAN
2379 72,608 06Aug20	1	.FAMILY ROOM - OPT. WAFFLE CEILING, BEAM DETAIL AS PER PLAN (6 BOXES) OPTION#1 CTR-B07
2379 06Aug20 NoCat	1	.KITCHEN - UPGRADE TO 8" DUCT (INTERIOR WALL) IN LIEU OF STANDARD OFFERING

GARAGE DOORS

Invoice	Qty.	Description
2245 06Aug20 NoCat	1	**CUSTOM LAYOUT** BUILD ADDITIONAL THIRD CAR GARAGE SPACE WITH TANDEM. PURCHASER ACKNOWLEDGES THAT EXISTING WINDOW IN BEDROOM 2 WILL BE REDUCED IN SIZE AND/OR RELOCATED ALONG THE WALL TO PERMIT TANDEM
2245 06Aug20 NoCat	1	**CUSTOM LAYOUT** VENDOR TO EXTEND THREE CAR GARAGE SPACE TO APPROXIMATELY 30 FEET WIDE AND INSTALL GARAGE DOORS THAT ARE APPROXIMATELY ONE FOOT WIDER AND TALLER THAN STANDARD SIZE

HVAC

Invoice	Qty.	Description
2379 72,218 06Aug20	1	.KITCHEN - UPGRADE TO 8" DUCT (INTERIOR WALL) IN LIEU OF STANDARD OFFERING
2379 72,248 06Aug20	1	.APRILAIRE 600 WHOLE HOUSE STEAM HUMIDIFIER (UP TO 4,000 SQ.FT.) - COMPLETE WITH HI VOLTAGE WIRING, 240V DOUBLE BREAKER 20 AMP, SHUT OFF VALVE
2379 72,215 06Aug20	1	.FURNACE - LENNOX 2 STAGE VARIABLE SPEED FURNACE (90,000 TO 110,000 BTU FOOT s) IN LIEU OF STANDARD OFFERING - (PINE VALLEY SITE ONLY - REFERENCE MODEL SPECIFIC FOR FURANCE UPGRADE EXTRA)
2379 06Aug20 NoCat	1	.GREAT ROOM: FIREPLACE - ADD HEAT ACTIVATED FAN

INTERIOR TRIM AND DOORS

Invoice	Qty.	Description
2245 06Aug20 NoCat	1	**CUSTOM LAYOUT** BUILD ADDITIONAL THIRD CAR GARAGE SPACE WITH TANDEM. PURCHASER ACKNOWLEDGES THAT EXISTING WINDOW IN BEDROOM 2 WILL BE REDUCED IN SIZE AND/OR RELOCATED ALONG THE WALL TO PERMIT TANDEM
2379 06Aug20 NoCat	1	.FAMILY ROOM - OPT. COFFERED CEILING AS PER PLAN
2379 06Aug20 NoCat	1	.FAMILY ROOM - OPT. WAFFLE CEILING, BEAM DETAIL AS PER PLAN (6 BOXES) OPTION#1 CTR-B07

KITCHEN AND BATH CABINETRY

Invoice	Qty.	Description
2379 06Aug20 NoCat	1	.KITCHEN - UPGRADE TO 8" DUCT (INTERIOR WALL) IN LIEU OF STANDARD OFFERING

PAINT

Invoice	Qty.	Description
2379 06Aug20 NoCat	1	.FAMILY ROOM - OPT. COFFERED CEILING AS PER PLAN
2379 06Aug20 NoCat	1	.FAMILY ROOM - OPT. WAFFLE CEILING, BEAM DETAIL AS PER PLAN (6 BOXES) OPTION#1 CTR-B07

PLUMBING

Invoice	Qty.	Description
2245 06Aug20 NoCat	1	.BACK-FLOW PREVENTER VALVE

STAIRS AND RAILINGS

Invoice	Qty.	Description
2245 06Aug20 NoCat	1	**CUSTOM LAYOUT** VENDOR TO PROVIDE A SERVICE STAIRCASE TO BASEMENT

WINDOWS - BASEMENT

Invoice	Qty.	Description
2245 72,675 06Aug20	3	.BASEMENT WINDOWS - UPGRADE BASEMENT WINDOW SIZE TO 30 " X 24" - 10" FRAME (PINEVALLEY 50 FOOT LOTS ONLY)
2245 72,678 06Aug20	1	.BASEMENT WINDOWS - EGRESS BASEMENT WINDOW 40" X 24" - 10" FRAME (PINEVALLEY 50 FOOT LOTS ONLY)

WINDOWS AND DOORS


Invoice	Qty.	Description
2245 06Aug20 NoCat	1	**CUSTOM LAYOUT** BUILD ADDITIONAL THIRD CAR GARAGE SPACE WITH TANDEM. PURCHASER ACKNOWLEDGES THAT EXISTING WINDOW IN BEDROOM 2 WILL BE REDUCED IN SIZE AND/OR RELOCATED ALONG THE WALL TO PERMIT TANDEM
2379 06Aug20 NoCat	1	.GREAT ROOM: UPGRADE EXTERIOR SLIDING DOOR ASSEMBLY TO 96"
2379 06Aug20 NoCat	1	.MASTER BEDROOM: UPGRADE EXTERIOR GARDEN DOOR ASSEMBLY TO 96"

SCHEDULE 'F'



TV-132
 JUNE 9 2020
 See ~~attach~~

Lot 132
50' SERIES
 Elevation B • 3,465 sq.ft.

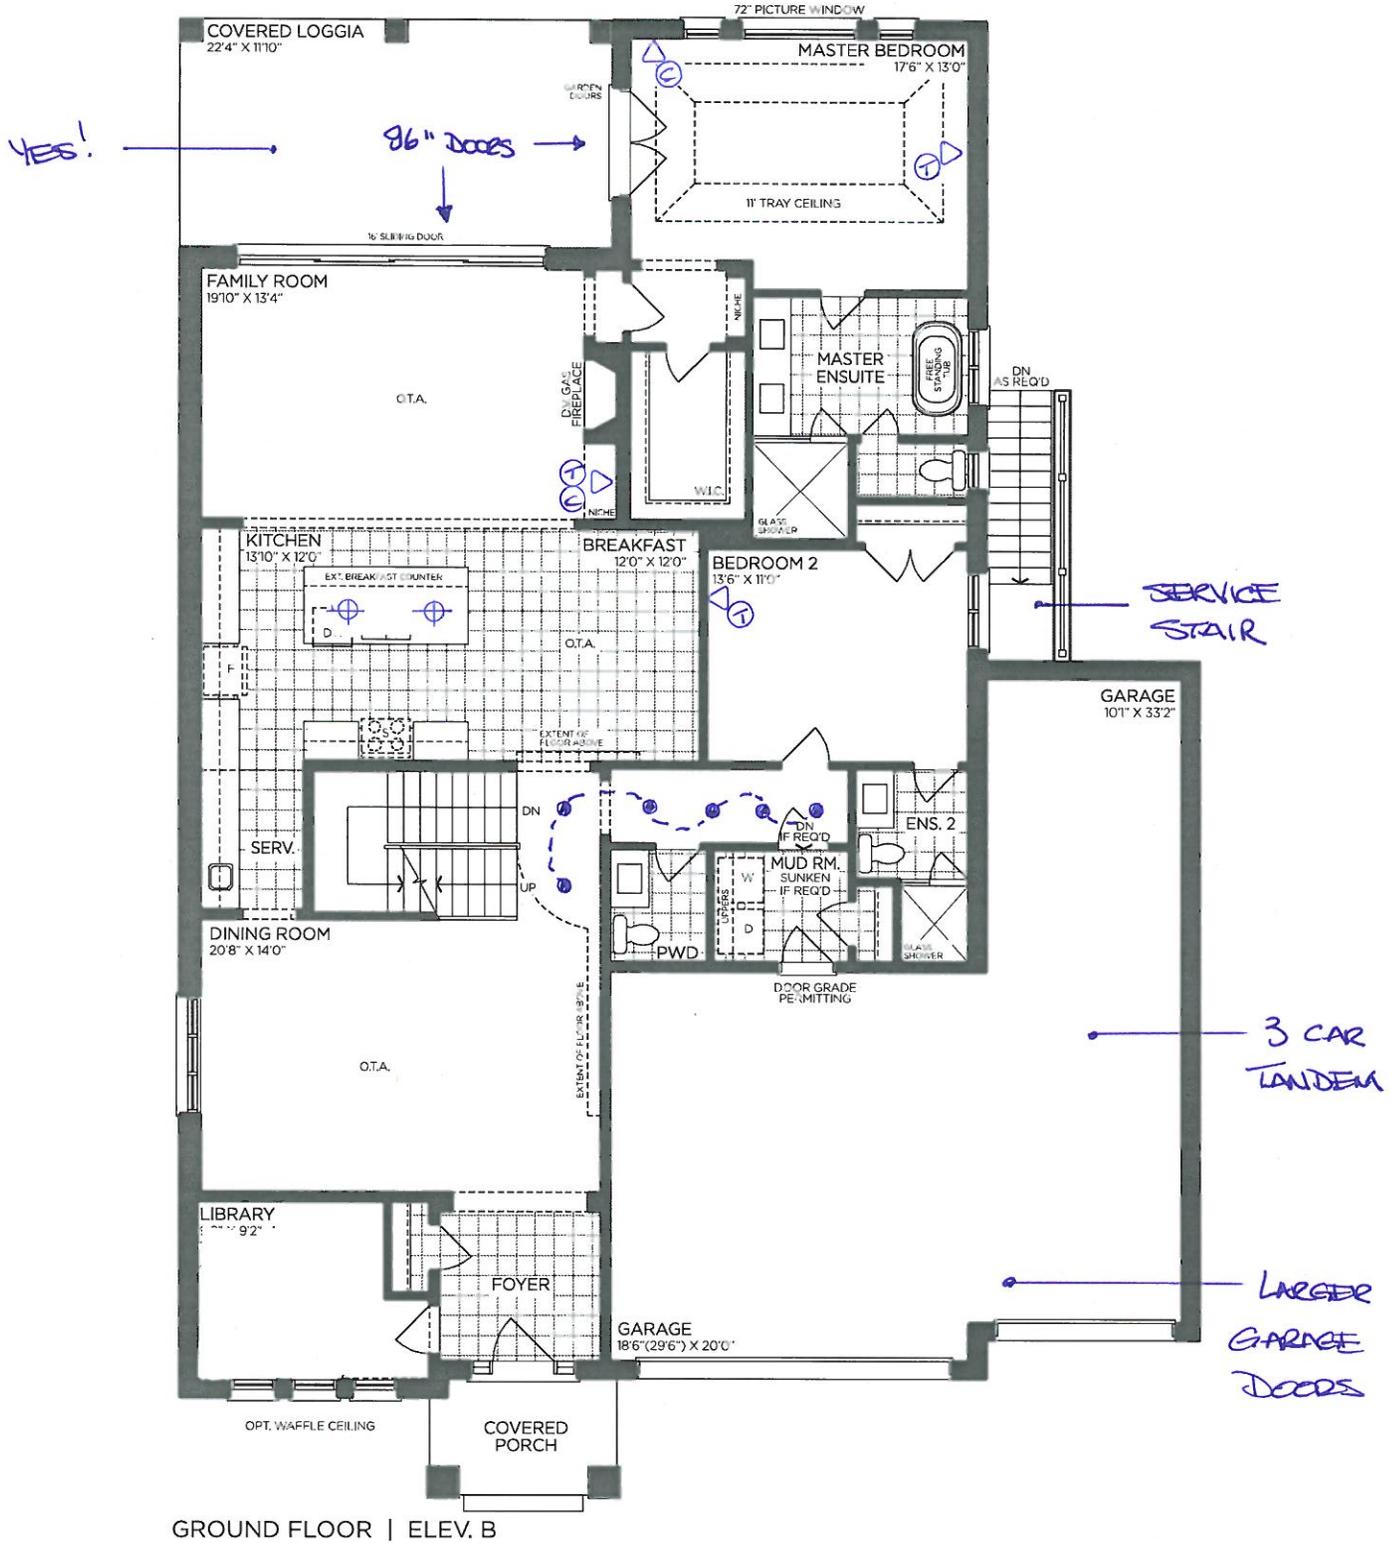

VENDOR

PURCHASER

PURCHASER

GOLDPARK
 WORTH MORE™


Prices, figures, illustrations, sizes, features and finishes are subject to change without notice. Areas and dimensions are approximate and actual usable floor space may vary from the stated area. Layout may be reverse of the unit purchased. E. & O.E. 5006

SCHEDULE 'F'



PV-132
 JUNE 9 2026
 See attach

Lot 132
50' SERIES
 Elevation B • 3,465 sq.ft.

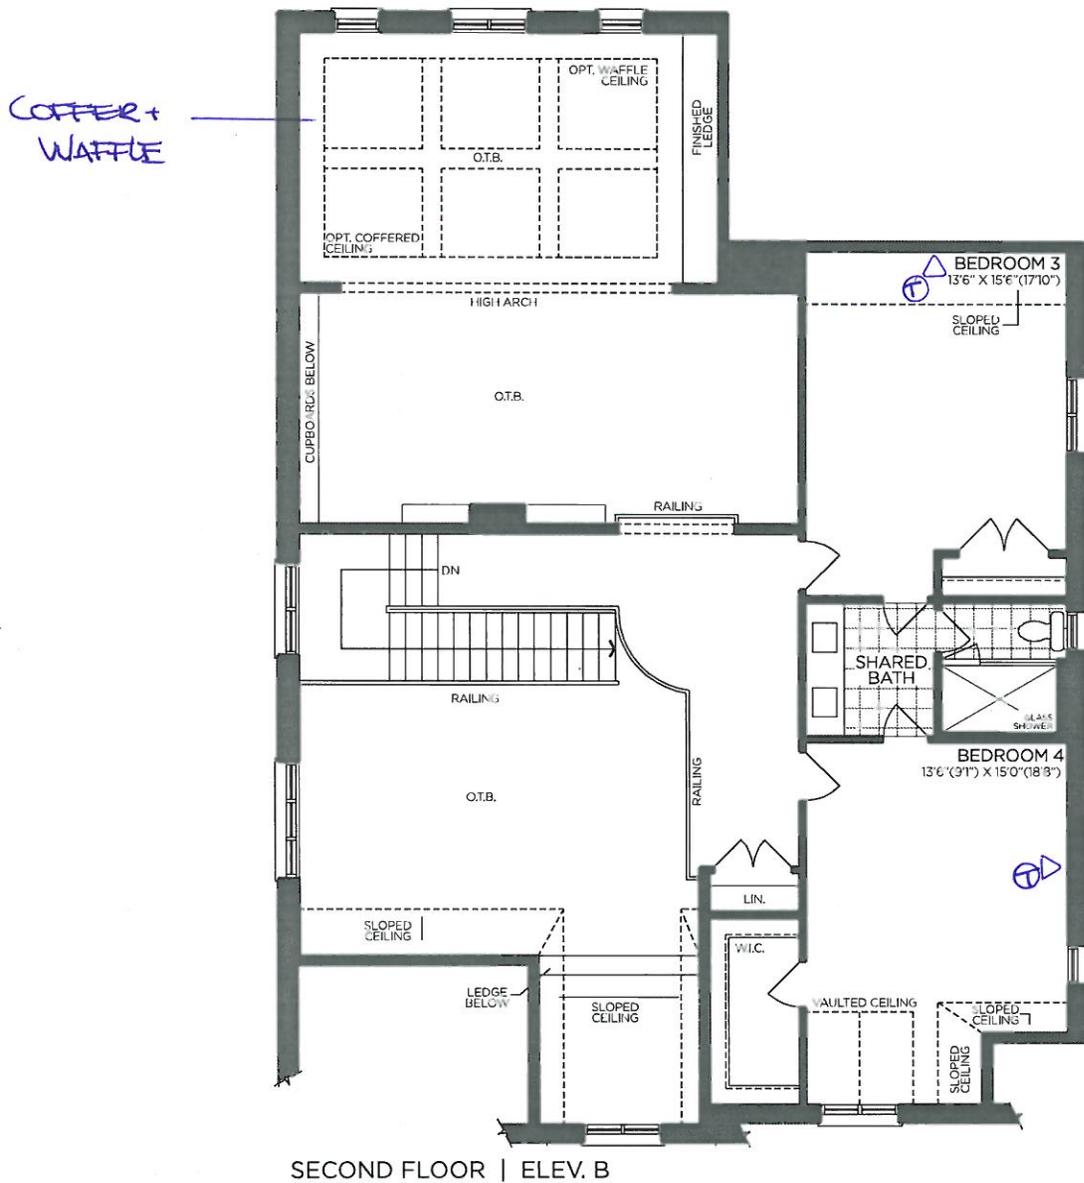

SECOND FLOOR | ELEV. B

VENDOR

PURCHASER

PURCHASER

GOLDPARK
 WORTH MORE™

Prices, figures, illustrations, sizes, features and finishes are subject to change without notice. Areas and dimensions are approximate and actual usable floor space may vary from the stated area. Layout may be reverse of the unit purchased. E. & O.E. 5006


SCHEDULE 'F'



PV-132
JUNE 9 2020

See Attach.

Lot 132
50' SERIES
Elevation B • 3,465 sq.ft.

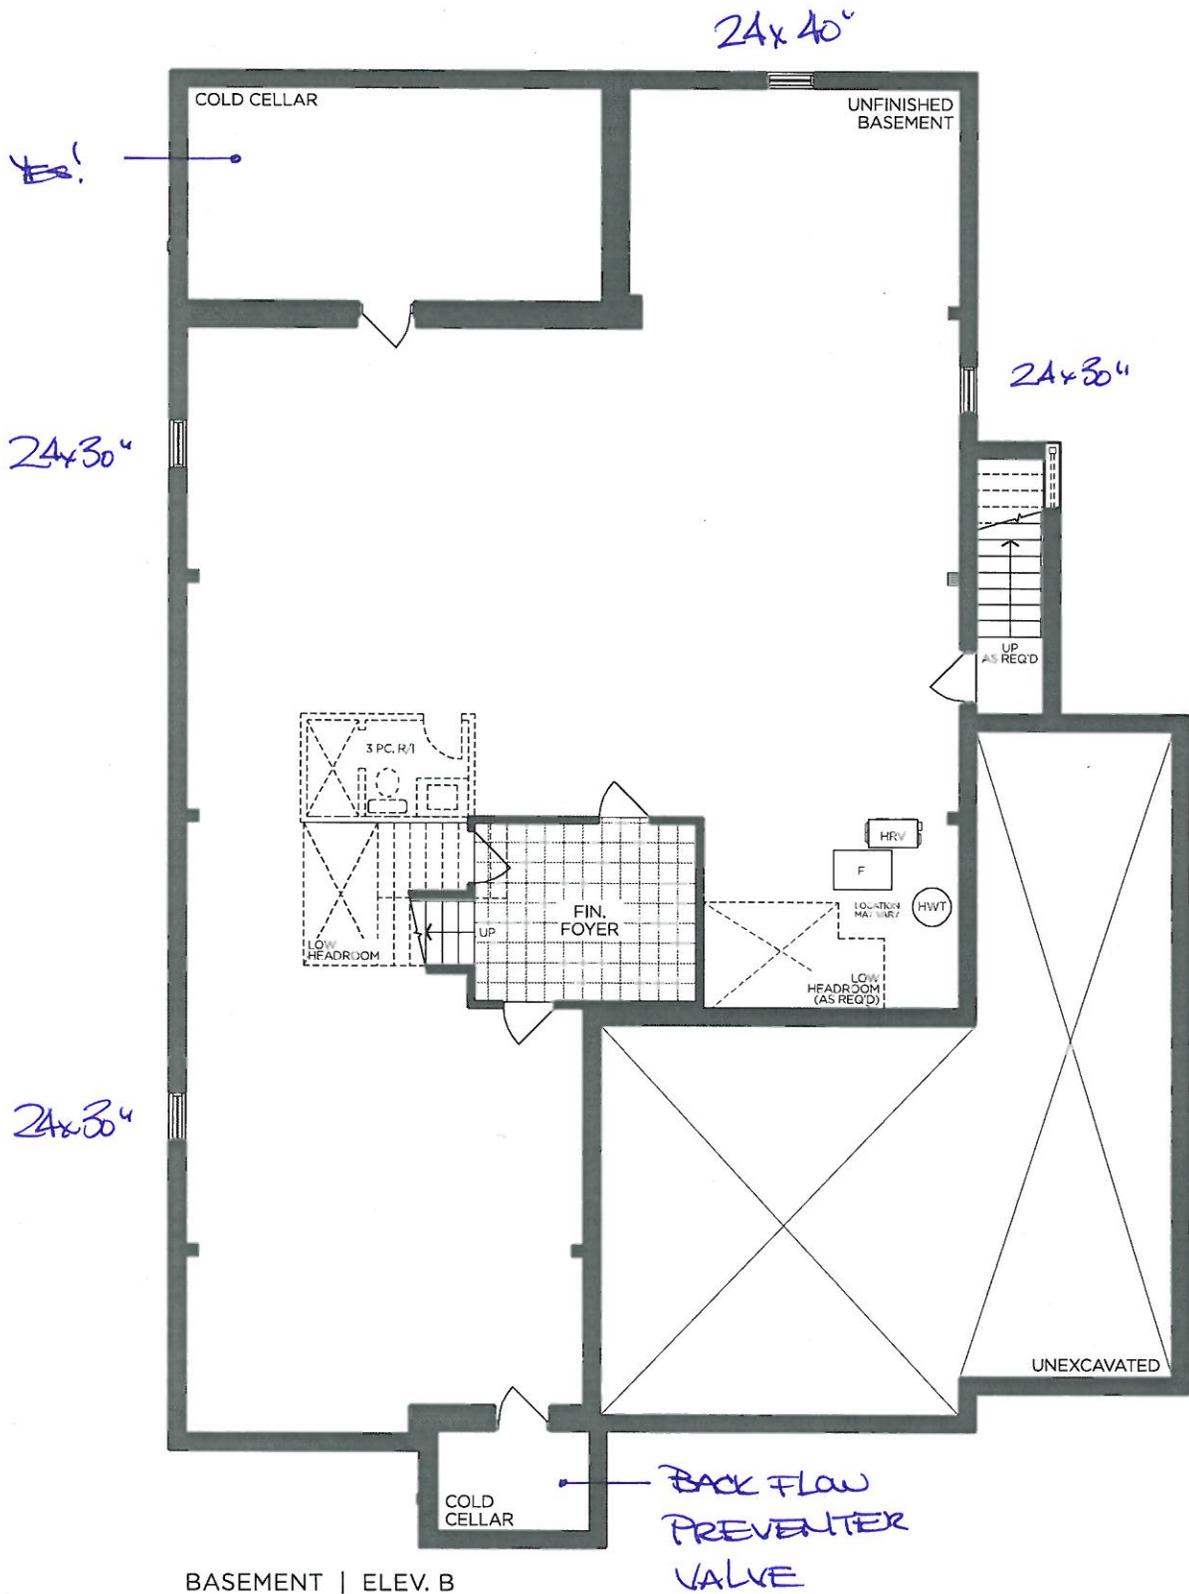

BASEMENT | ELEV. B

VENDOR

PURCHASER

PURCHASER

GOLDPARK
WORTH MORE™


Prices, figures, illustrations, sizes, features and finishes are subject to change without notice. Areas and dimensions are approximate and actual usable floor space may vary from the stated area. Layout may be reverse of the unit purchased. E. & O.E. 5006

SCHEDULE 'F'



TV-132
JUNE 9 2020

MC *June 19 2020*
Lot 132
50' SERIES
Elevation B • 3,465 sq. ft.

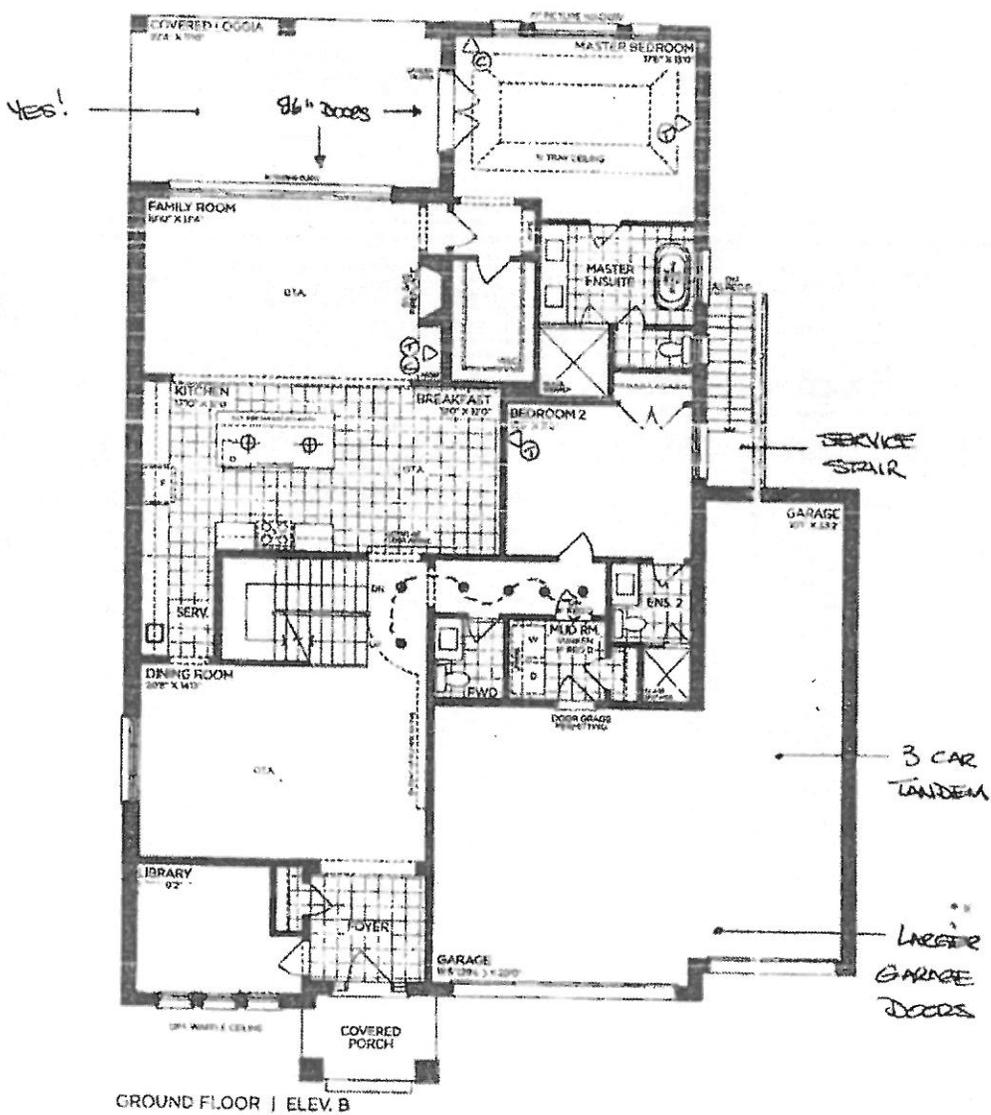

VENDOR
PURCHASER
PURCHASER

GOLDPARK
WORTH MORE™

Prices, figures, illustrations, area, features and finishes are subject to change without notice. Areas and dimensions are approximate and actual usable floor space may vary from the stated area. Layout may be revised if the unit purchased. E. & O.E. 3/06

SCHEDULE 'F'




DL-132
June 9 2020

June 19-2020
MK Lot 132

Lot 132

50' SERIES

Elevation B • 3,465 sq.ft.

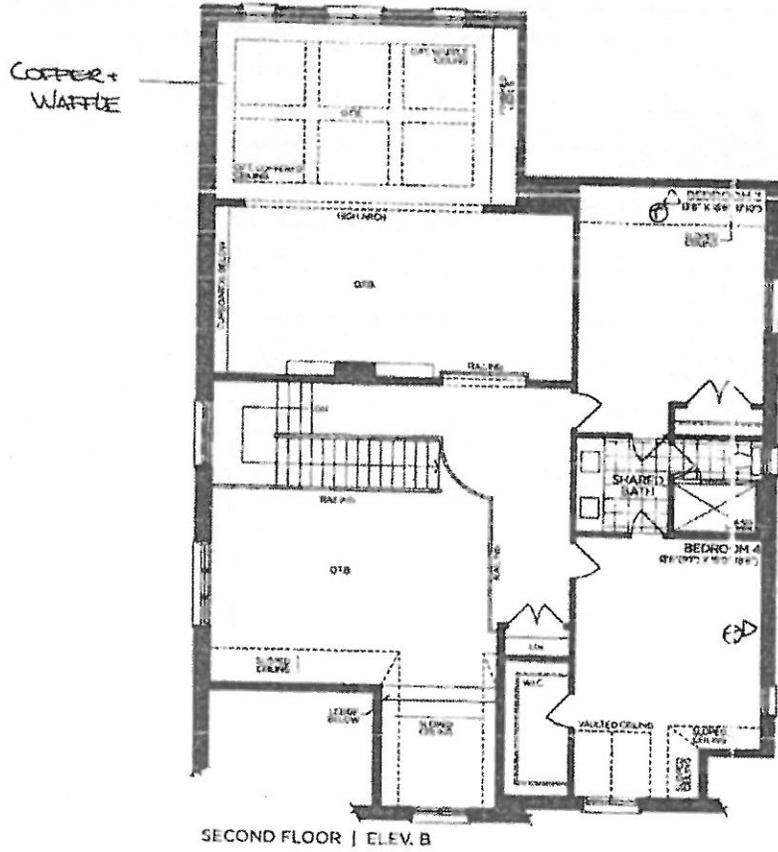

VENDOR

PURCHASER

PURCHASER

GOLDPARK
WORTH MORE™

Prices, quotes, illustrations, sizes, features and finishes are subject to change without notice. Areas and dimensions are approximate and actual usable floor space may vary from the stated area. Layout may be reverse of the unit purchased. © & TM, 2020

SCHEDULE 'F'

JUNE 19 - 20




PL-132
JUNE 9 2020

Lot 132

50' SERIES

Elevation B • 3,465 sq.ft.

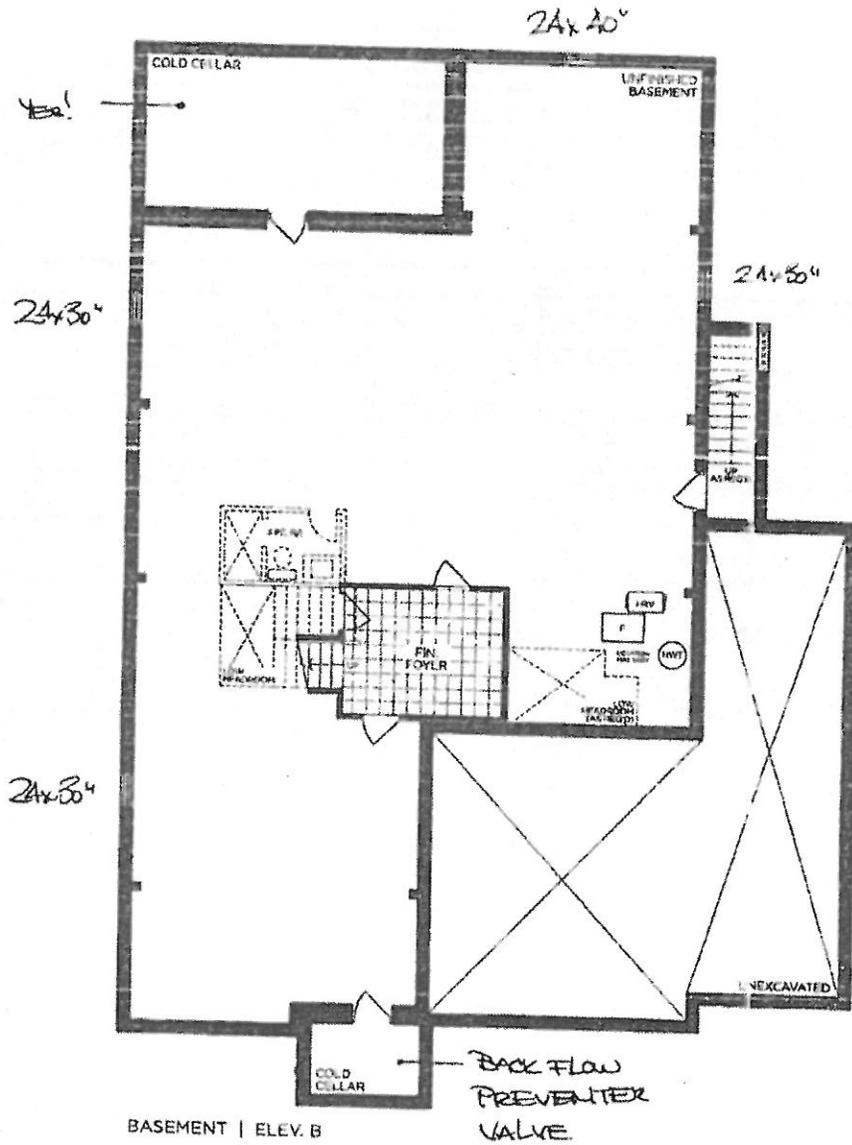

VENDOR

PURCHASER

PURCHASER

GOLDPARK

WORTH MORE™

Prices, figures, illustrations, sizes, features and finishes are subject to change without notice. Areas and dimensions are approximate and actual usable floor space may vary from the stated area. Layout may be reverse of the unit purchased. E. & O.E. 5006