



CONSTRUCTION SUMMARY

Lot: 113  
Model: 42.07 Custom Lot 113  
Project/Phase: Pine Valley Forevergreen / 1

CERAMIC

Invoice	Qty.	Description
2389  05Aug20 NoCat	1	.MASTER ENSUITE: SHOWER NICHE [SHAMPOO SHELF] - COMPLETE WITH MATCHING MARBLE JAMBS ON 4 SIDES, STANDARD TILE, APPROX. 12 X 18 INSTALLED VERTICALLY - SEE PLAN

CONCRETE AND DRAIN

Invoice	Qty.	Description
2389  05Aug20 NoCat	1	.BACK-FLOW PREVENTER VALVE

CROWN MOULDING

Invoice	Qty.	Description
2389  05Aug20 NoCat	1	**LIBRARY - OPT COFFERED CEILING AS PER PLAN
2389  05Aug20 NoCat	1	**LIBRARY: OPT. WAFFLE CEILING, BEAM DETAIL AS PER PLAN (4 BOXES) OPTION 1 #CTR-BO7
2389  05Aug20 NoCat	1	.*GREAT ROOM: OPT. COFFERED CEILING AS PER PLAN
2389  05Aug20 NoCat	1	**GREAT ROOM: OPT. WAFFLE CEILING, BEAM DETAIL AS PER PLAN (9 BOXES) OPTION 1 #CTR-BO7



CONSTRUCTION SUMMARY

Lot: 113

Model: 42.07 Custom Lot 113

Project/Phase: Pine Valley Forevergreen / 1

DRYWALL

Invoice	Qty.	Description
2389  05Aug20 NoCat	1	**LIBRARY - OPT COFFERED CEILING AS PER PLAN
2389  05Aug20 NoCat	1	**LIBRARY: OPT. WAFFLE CEILING, BEAM DETAIL AS PER PLAN (4 BOXES) OPTION 1 #CTR-BO7
2389  05Aug20 NoCat	1	.*GREAT ROOM: OPT. COFFERED CEILING AS PER PLAN
2389  05Aug20 NoCat	1	**GREAT ROOM: OPT. WAFFLE CEILING, BEAM DETAIL AS PER PLAN (9 BOXES) OPTION 1 #CTR-BO7
2389  05Aug20 NoCat	20	.2ND FLOOR: INCREASE HEIGHT OF DOOR TO 8FT SECOND FLOOR - PER DOOR







GOLDPARK

WORTH MORE™

CONSTRUCTION SUMMARY

Lot: 113

Model: 42.07 Custom Lot 113

Project/Phase: Pine Valley Forevergreen / 1

INTERIOR TRIM AND DOORS

Invoice	Qty.	Description
2389  05Aug20 NoCat	1	**LIBRARY - OPT COFFERED CEILING AS PER PLAN
2389  05Aug20 NoCat	1	**LIBRARY: OPT. WAFFLE CEILING, BEAM DETAIL AS PER PLAN (4 BOXES) OPTION 1 #CTR-BO7
2389  05Aug20 NoCat	1	.*GREAT ROOM: OPT. COFFERED CEILING AS PER PLAN
2389  05Aug20 NoCat	1	**GREAT ROOM: OPT. WAFFLE CEILING, BEAM DETAIL AS PER PLAN (9 BOXES) OPTION 1 #CTR-BO7
2389  05Aug20 NoCat	20	.2ND FLOOR: INCREASE HEIGHT OF DOOR TO 8FT SECOND FLOOR - PER DOOR

NETWORK AND WIRING

Invoice	Qty.	Description
2389 72,259 05Aug20	1	.GREAT ROOM: CONDUIT PIPE - FOR WALL MOUNT TV - LOCATE ABOVE FIREPLACE, APPROX 66" A.F.F. THRU BASEMENT, TERMINATING AT CABLE - SEE PLAN

PAINT

Invoice	Qty.	Description
2389  05Aug20 NoCat	1	**LIBRARY - OPT COFFERED CEILING AS PER PLAN
2389  05Aug20 NoCat	1	**LIBRARY: OPT. WAFFLE CEILING, BEAM DETAIL AS PER PLAN (4 BOXES) OPTION 1 #CTR-BO7
2389  05Aug20 NoCat	1	.*GREAT ROOM: OPT. COFFERED CEILING AS PER PLAN
2389  05Aug20 NoCat	1	**GREAT ROOM: OPT. WAFFLE CEILING, BEAM DETAIL AS PER PLAN (9 BOXES) OPTION 1 #CTR-BO7
2389  05Aug20 NoCat	20	.2ND FLOOR: INCREASE HEIGHT OF DOOR TO 8FT SECOND FLOOR - PER DOOR

DisciplineMS.rpt 26jun20

Page 6 of 7  
Printed and Sent: 05-Aug-20

GOLDPARK

WORTH MORE™

CONSTRUCTION SUMMARY

Lot: 113

Model: 42.07 Custom Lot 113

Project/Phase: Pine Valley Forevergreen / 1

PLUMBING

Invoice	Qty.	Description
2389 72,346 05Aug20	1	.KITCHEN: ROUGH-IN FOR KITCHEN POT FILLER (FIXTURE NOT INCLUDED)
2389  05Aug20 NoCat	1	MASTER ENSUITE: MOEN `ARRIS` POSI-TEMP 3-FUNCTION RAIN SHOWER (from ceiling) + HAND SHOWER + SLIDE BAR - CHROME #TS22002EP/3372/TS23005/62320/3887EP/A725

WINDOWS - BASEMENT

Invoice	Qty.	Description
2389 72,351 05Aug20	4	.BASEMENT WINDOWS - UPGRADE BASEMENT WINDOW SIZE TO 30 " X 24" - 8" FRAME

WINDOWS AND DOORS

Invoice	Qty.	Description
2389  05Aug20 NoCat	1	.BREAKFAST: UPGRADE EXTERIOR SLIDING DOOR ASSEMBLY TO 96" TALL

DisciplineMS.rpt 26jun20

Page 7 of 7  
Printed and Sent: 05-Aug-20


SCHEDULE 'F'



PV-113  
JUNE 13 2020

Lot 113  
42' SERIES

Elevation A • 3,600 sq.ft.

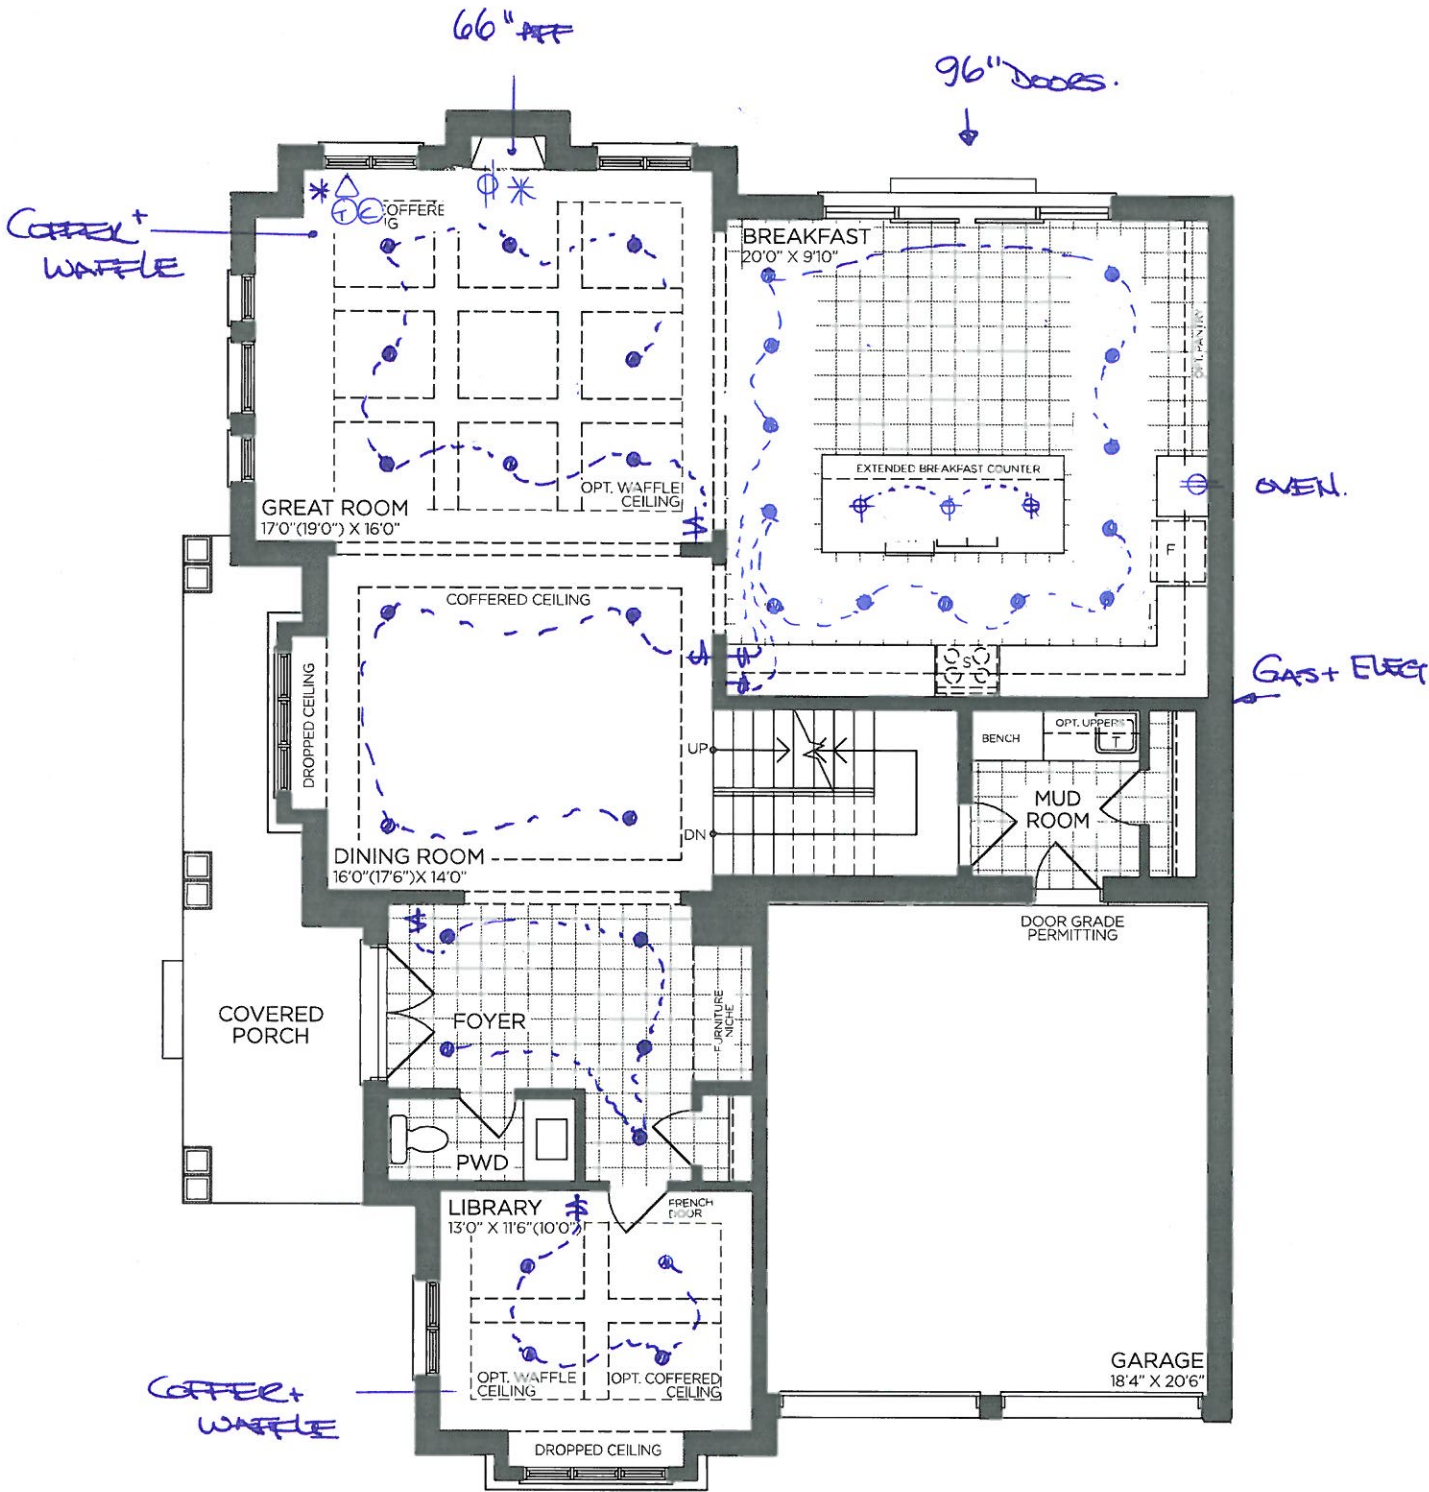

GROUND FLOOR | ELEV. A

VENDOR

PURCHASER

PURCHASER

**GOLDPARK**  
WORTH MORE™

Prices, figures, illustrations, sizes, features and finishes are subject to change without notice. Areas and dimensions are approximate and actual usable floor space may vary from the stated area. Layout may be reverse of the unit purchased. E. & O.E. 4207




SCHEDULE 'F'



PV-113  
JUNE 13 2020

Lot 113  
42' SERIES

Elevation A • 3,600 sq.ft.

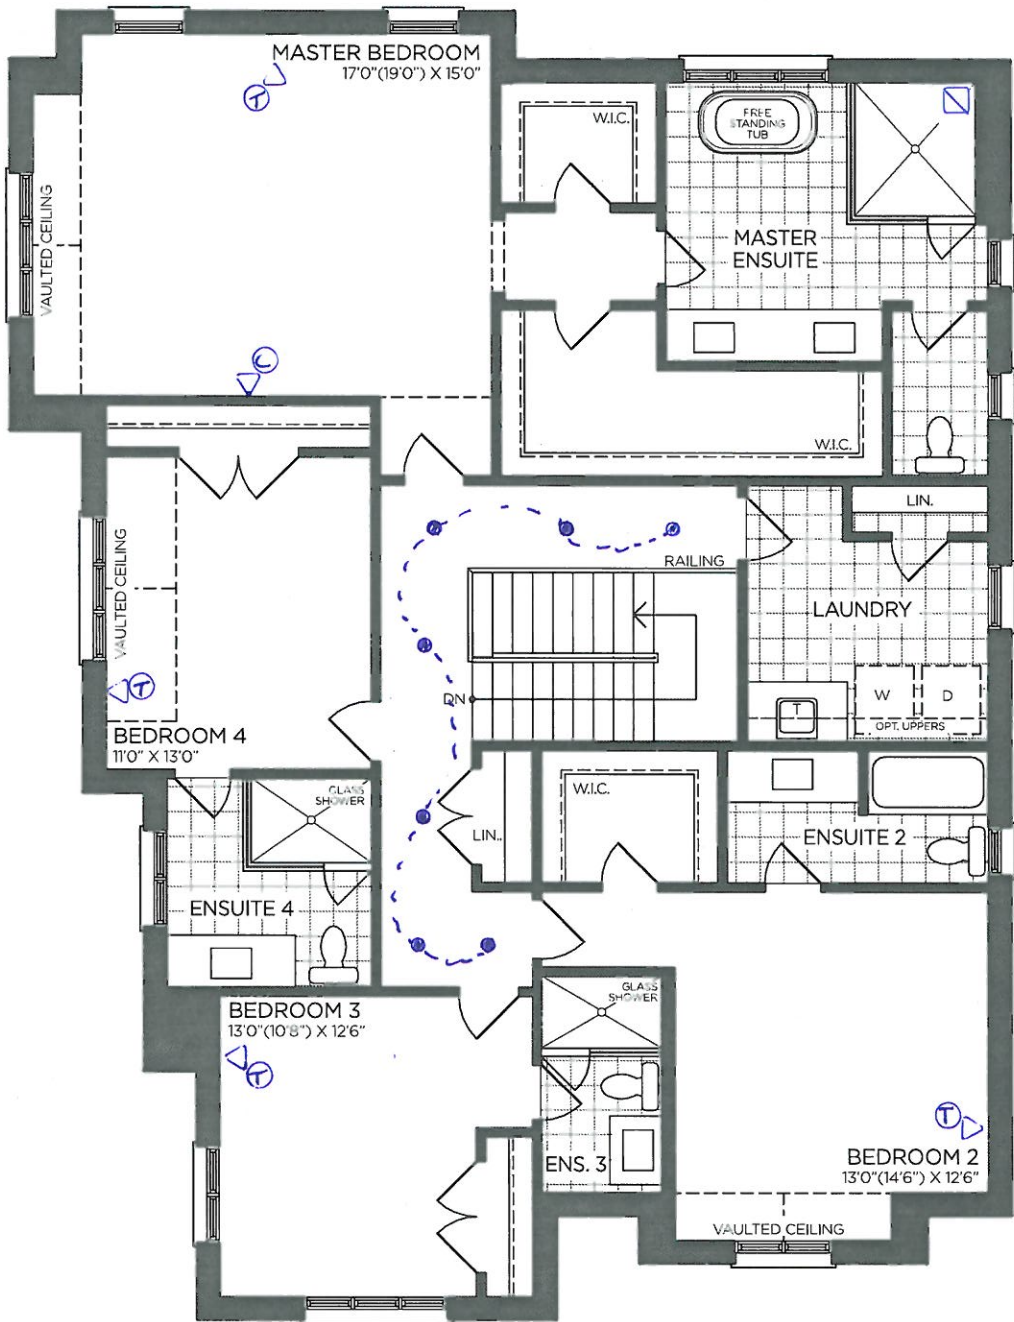

RAIN SHOWER  
← + NIGHT

SECOND FLOOR | ELEV. A

VENDOR

PURCHASER

PURCHASER

GOLDPARK  
WORTH MORE™

Prices, figures, illustrations, sizes, features and finishes are subject to change without notice. Areas and dimensions are approximate and actual usable floor space may vary from the stated area. Layout may be reverse of the unit purchased. E. & O.E. 4207


SCHEDULE 'F'



PV-113  
June 13 2020

Lot 113  
42' SERIES

Elevation A • 3,600 sq.ft.

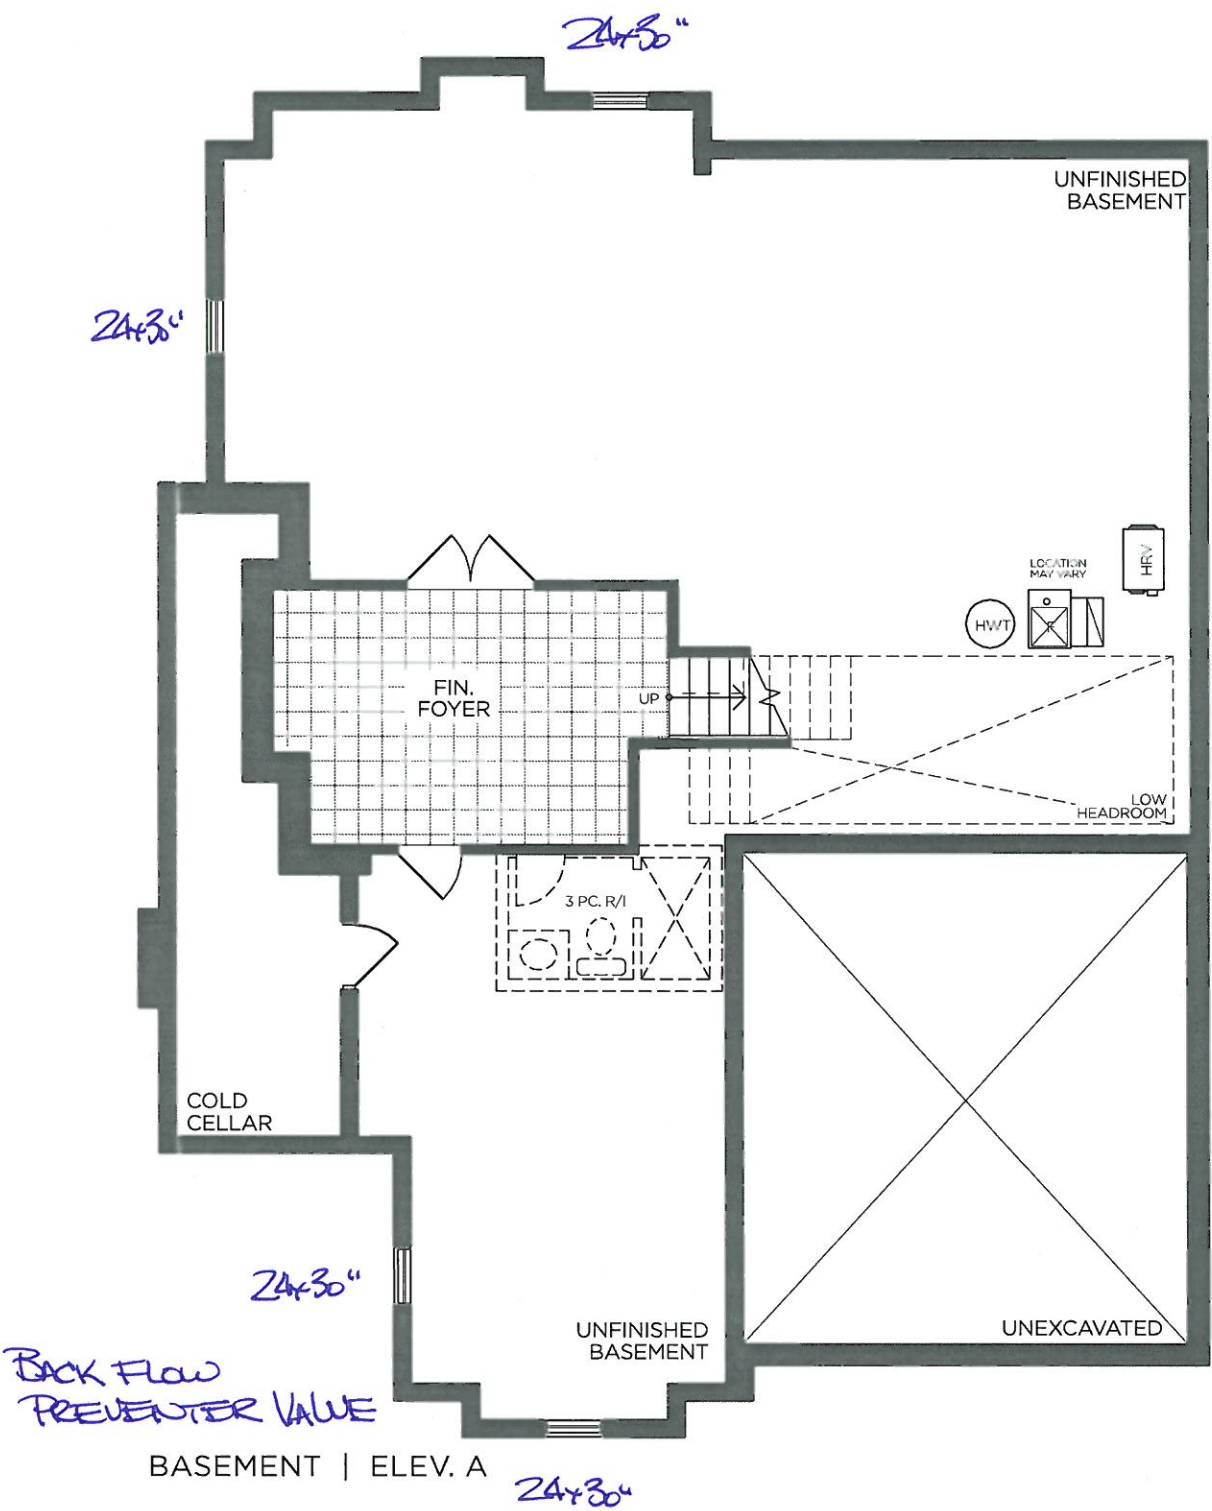

GOLDPARK  
WORTH MORE™

VENDOR

PURCHASER

PURCHASER

Prices, figures, illustrations, sizes, features and finishes are subject to change without notice. Areas and dimensions are approximate and actual usable floor space may vary from the stated area. Layout may be reverse of the unit purchased. E. & O.E. 4207