

**Lot: 112****Model: 50.01 A HILLSBOROUGH****Project/Phase: Pine Valley Forevergreen / 1**

ELECTRICAL

Invoice	Qty.	Description
2264 72,273 05Aug20	1	.KITCHEN: 110V WALL RECEPTACLE ON SEPARATE CIRCUIT - GAS FIRED APPLIANCE - FOR AUX. EQUIPMENT - NOT A STOVE PLUG
2264 72,310 05Aug20	2	.UPPER HALL: UPGRADE STANDARD CEILING MOUNT FIXTURE TO (1) LED POT LIGHT - SECOND FLOOR - SEE PLAN FOR LOCATION
2264 72,290 05Aug20	4	.UPPER HALL: 4" E/S LED INTERIOR POT LIGHT (INSULATED CEILING) - SECOND FLOOR - EACH
2264 72,279 05Aug20	1	.MASTER ENSUITE: SHOWER POT LIGHT: 6" RECESSED SHOWER POT LIGHT - USE SAME SWITCH AS STANDARD

EXTERIOR COLOURS

Invoice	Qty.	Description
2264 05Aug20 NoCat	1	EXTERIOR COLOUR PKG: BR# 4

FORMING

Invoice	Qty.	Description
2264 05Aug20 NoCat	3	.BASEMENT WINDOWS - UPGRADE BASEMENT WINDOW SIZE TO 30 " X 24" - 10" FRAME (PINEVALLEY 50 FOOT LOTS ONLY) - **REAR IS LOB**
2264 05Aug20 NoCat	1	.BREAKFAST ROOM: UPGRADE EXTERIOR GARDEN DOOR ASSEMBLY TO 96" TALL

**Lot: 112****Model: 50.01 A HILLSBOROUGH****Project/Phase: Pine Valley Forevergreen / 1**

PLUMBING

Invoice	Qty.	Description
2264 72,346 05Aug20	1	KITCHEN: ROUGH-IN FOR KITCHEN POT FILLER (FIXTURE NOT INCLUDED)
2264 05Aug20 NoCat	1	MASTER ENSUITE: MOEN `ARRIS` POSI-TEMP 3-FUNCTION RAIN SHOWER (from ceiling) + HAND SHOWER + SLIDE BAR - CHROME #TS22002EP/3372/TS23005/62320/3887EP/A725
2264 05Aug20 NoCat	1	.BACK-FLOW PREVENTER VALVE

WINDOWS - BASEMENT

Invoice	Qty.	Description
2264 05Aug20 NoCat	1	.BASEMENT WINDOWS - UPGRADE BASEMENT WINDOW SIZE TO 30 " X 24" - 10" FRAME (PINEVALLEY 50 FOOT LOTS ONLY) - **REAR IS LOB**

WINDOWS AND DOORS

Invoice	Qty.	Description
2264	1	.BREAKFAST ROOM: UPGRADE EXTERIOR GARDEN DOOR ASSEMBLY TO 96" TALL
05Aug20 NoCat		


SCHEDULE 'F'



PV-112.
JUNE 13 2026

Lot 112
50' SERIES

Elevation A • 3,225 sq.ft.

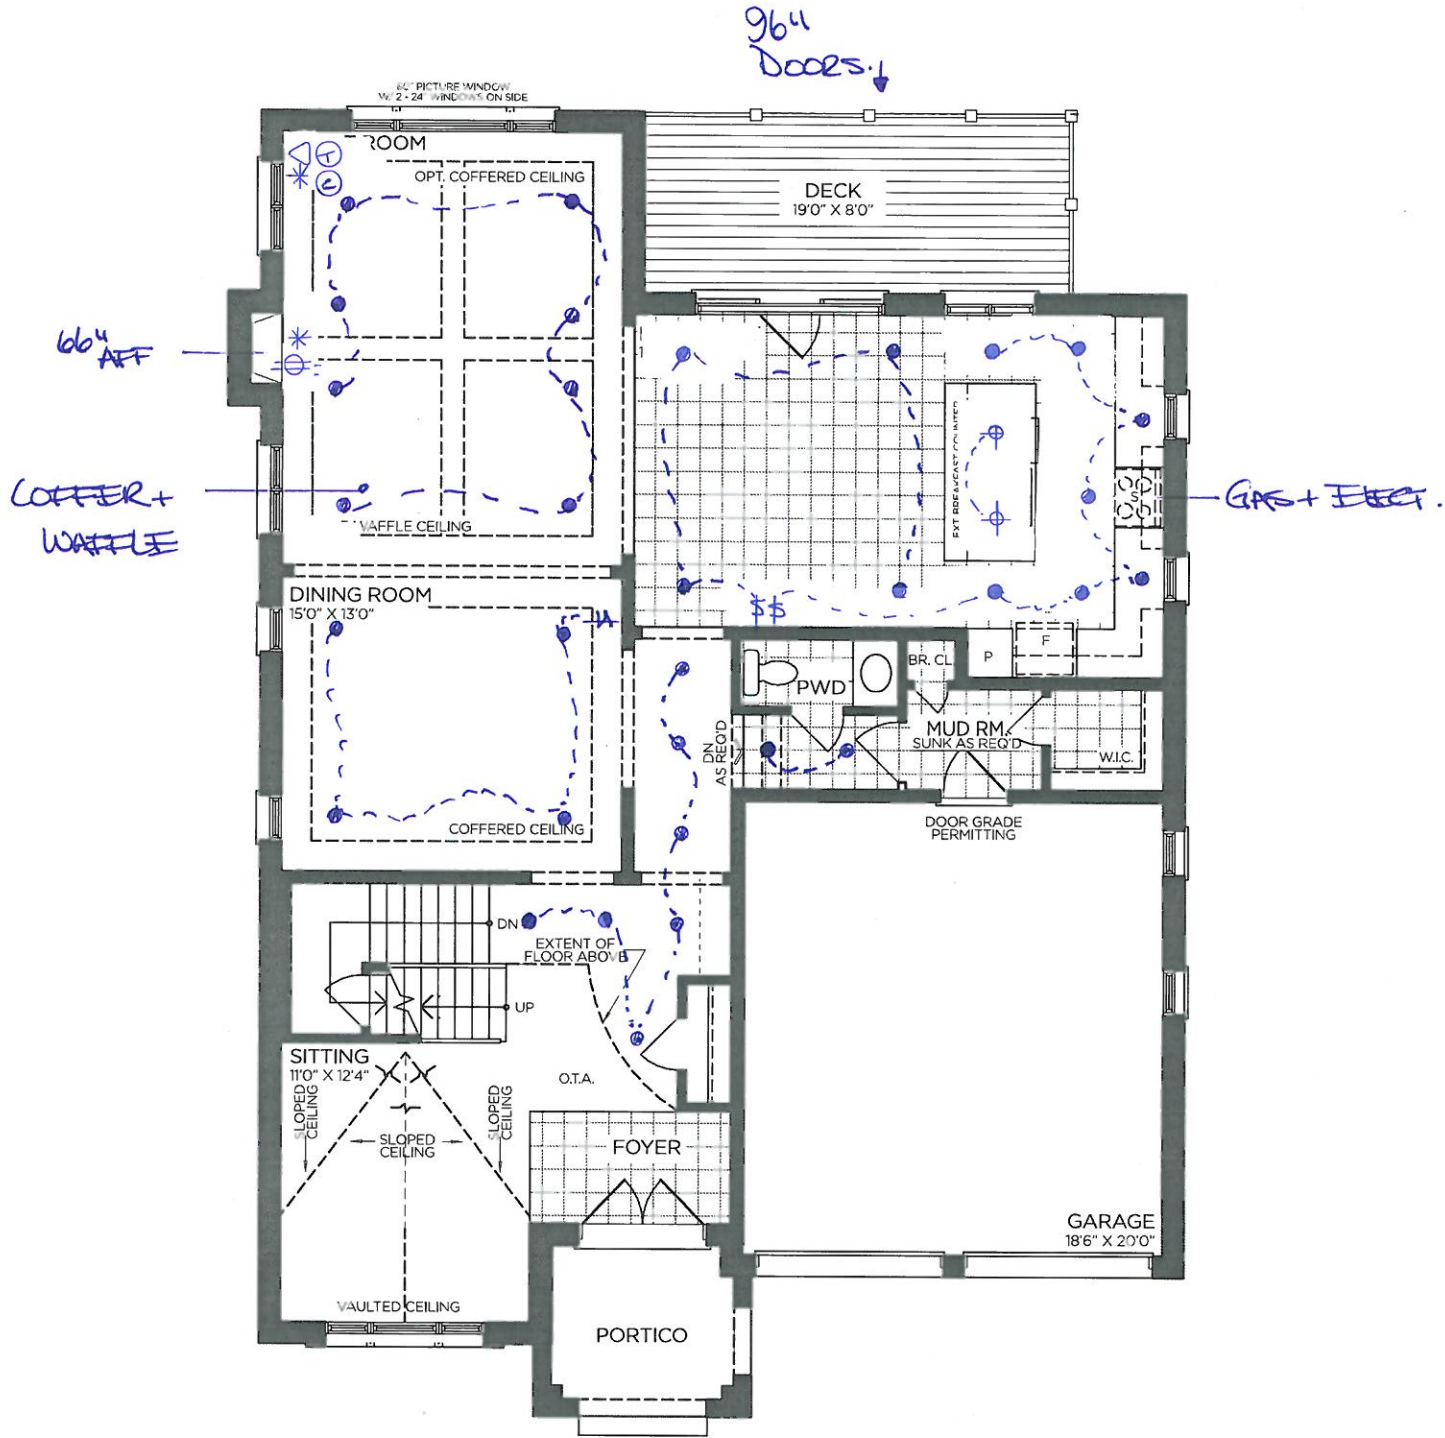

GROUND FLOOR | ELEV. A

VENDOR	<input type="text"/>
PURCHASER	<input type="text"/>
PURCHASER	<input type="text"/>

GOLDPARK
WORTH MORE™

Prices, figures, illustrations, sizes, features and finishes are subject to change without notice. Areas and dimensions are approximate and actual usable floor space may vary from the stated area. Layout may be reverse of the unit purchased. E. & O.E. 5001

SCHEDULE 'F'



PV-112.
JUNE 13 2020


Lot 112
50' SERIES

Elevation A • 3,225 sq.ft.

8' doors
on 2nd Floor

TRAY
CEILING!

Niches +
Rain shower.

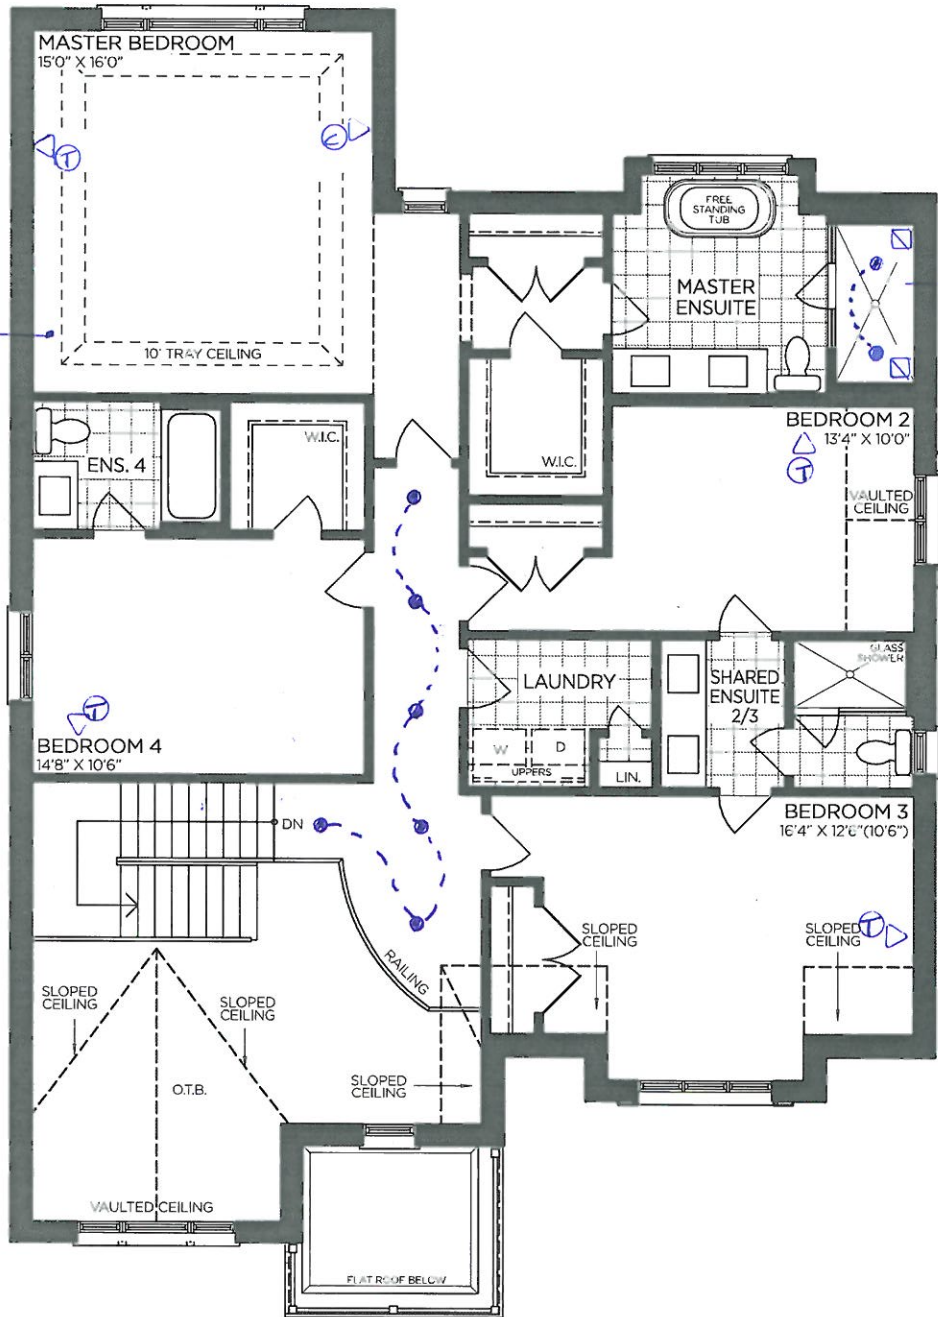

SECOND FLOOR | ELEV. A

GOLDPARK
WORTH MORE™

VENDOR

PURCHASER

PURCHASER

Prices, figures, illustrations, sizes, features and finishes are subject to change without notice. Areas and dimensions are approximate and actual usable floor space may vary from the stated area. Layout may be reverse of the unit purchased. E. & O.E. 5001


SCHEDULE 'F'



PV-112
JUNE 13 2020

Lot 112
50' SERIES

Elevation A • 3,225 sq.ft.

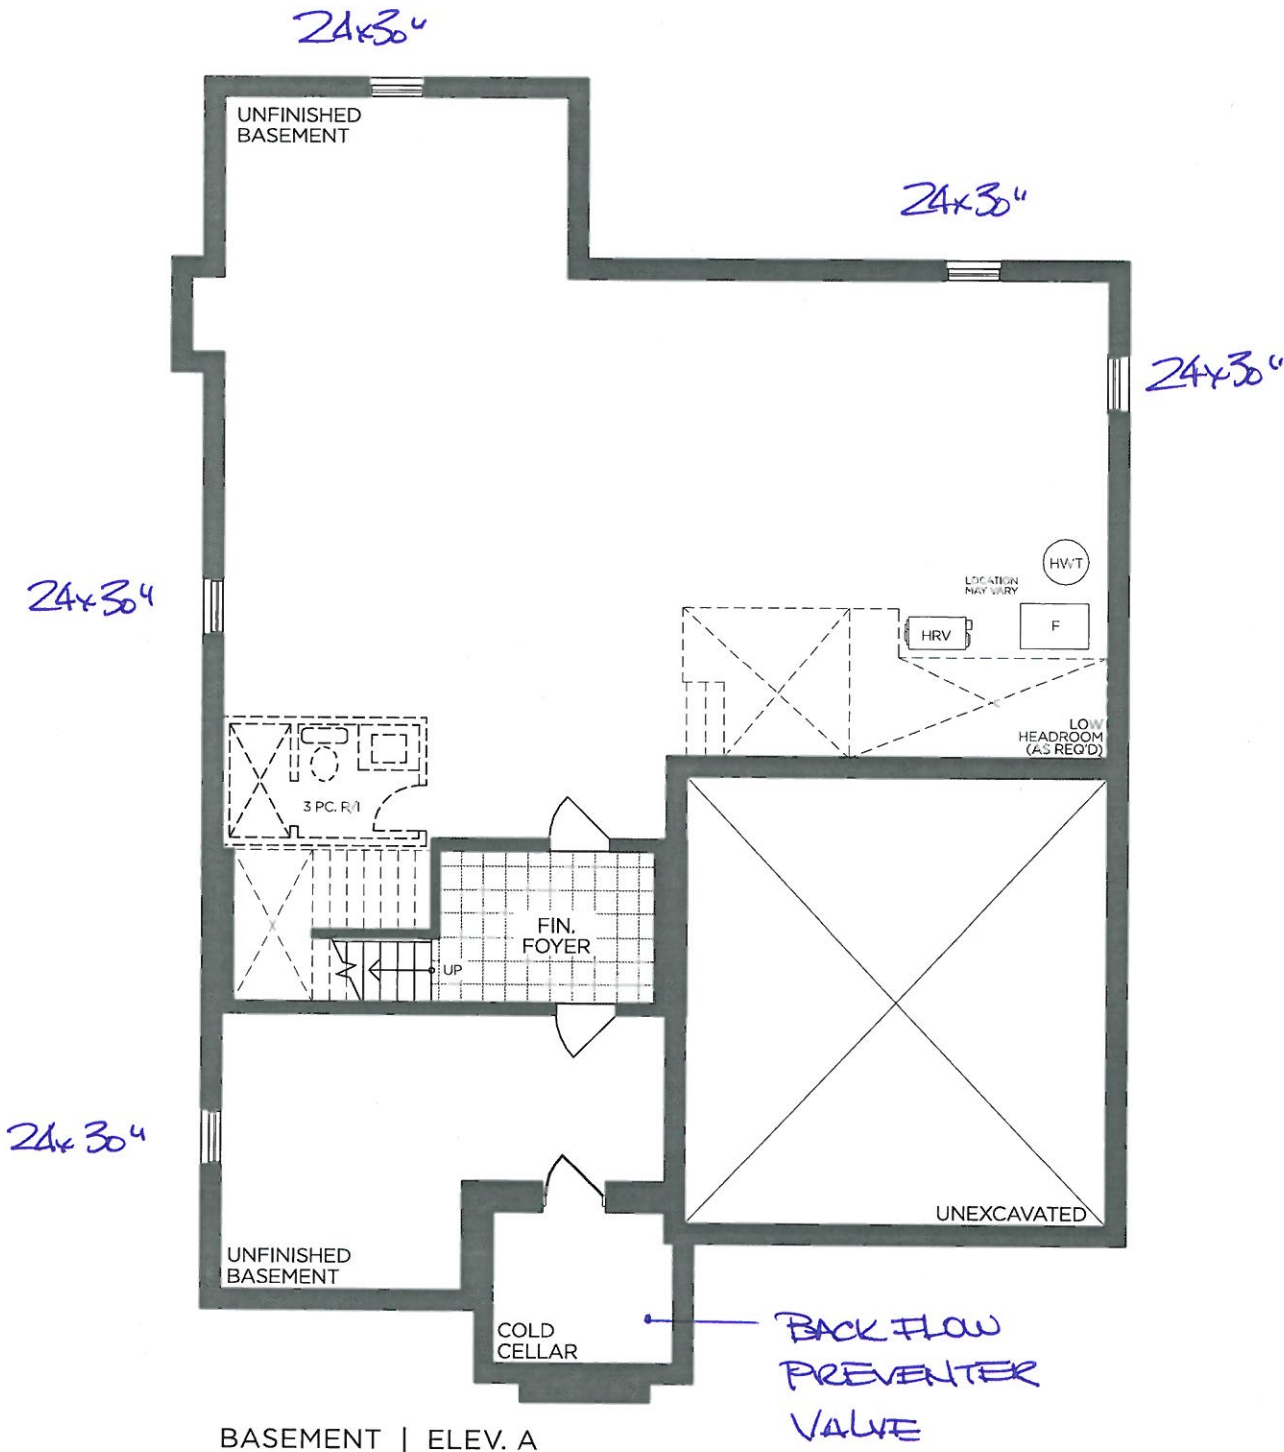

BASEMENT | ELEV. A

VENDOR	
PURCHASER	
PURCHASER	

GOLDPARK
WORTH MORE™

Prices, figures, illustrations, sizes, features and finishes are subject to change without notice. Areas and dimensions are approximate and actual usable floor space may vary from the stated area. Layout may be reverse of the unit purchased. E. & O.E. 5001

PLUMBING UPGRADES

POSI-TEMP SHOWER ONLY* W/3 FUNCTION TRANSFER VALVE
TRIM AND SLIDE BAR W/HAND SHOWER

MOEN - ARRIS



- ☒ CHROME
☐ BRUSHED NICKEL
☐ MATTE BLACK
- ☐ from WALL
☒ from CEILING

MODEL TS22002EP / 3372 / TS23005 / 62320 / 3887EP / A725

Lot# 112	
Room: MASTER ENSUITE	Signature:
Date: JUNE 13 2026	Signature: