

GOLDPARK

WORTH MORE™

CONSTRUCTION SUMMARY

Lot: 126

Model: 38-11 Elev B Schumann

Project/Phase: Brampton Encore / 2

CARPET

Invoice	Qty.	Description
2153 24Apr20 NoCat	1	MUD ROOM: DELETE CLOSET, RELOCATE WASHEFR DRYER FROM 2ND FLOOR TO MAIN FLOOR 'MUD ROOM' COMPLETE WITH STACKING MACHINES & STANDARD TUB ON LEGS BESIDE. CREATE 'COMPUTER LOFT', INSTALL STANDARD CARPET FLOOR ON FORMER 2ND FLOOR LAUNDRY

CENTRAL VAC AND WIRING

Invoice	Qty.	Description
2153 28,794 24Apr20	1	COMPUTER LOFT (FORMER 2ND FLOOR LAUNDRY: CAT 6 WIRING - ADD CAT 6- SEE PLAN FOR LOCATION
2153 24Apr20 NoCat	1	CONDUIT PIPE- FROM ATTIC TO ELECTRICAL PANEL- TERMINATE APPROX. CENTER OF ATTIC

CERAMIC

Invoice	Qty.	Description
2387 25Aug20 NoCat	1	FOYER / POWDER / MUD ROOM: UPGRADE 4 FLOOR TILE - 12X24" LAID IN STRAIGHT, STACKED PATTERN. SEE PLAN FOR TILE DIRECTION
2387 25Aug20 NoCat	1	MASTER ENSUITE FLOOR TILE - 12X24" LAID IN STRAIGHT, STACKED PATTERN. SEE PLAN FOR TILE DIRECTION
2387 25Aug20 NoCat	1	TWIN BATH: UPGRADE 4 FLOOR TILE - 12X24" LAID IN STRAIGHT, STACKED PATTERN. SEE PLAN FOR TILE DIRECTION
2387 25Aug20 NoCat	1	ENSUITE 2: UPGRADE 4 FLOOR TILE - 12X24" LAID IN STRAIGHT, STACKED PATTERN. SEE PLAN FOR TILE DIRECTION

CONCRETE AND DRAIN

Invoice	Qty.	Description
2153 28,894 24Apr20 **	1	ROUGH-IN - 3PC BASEMENT ROUGH-IN
2153 24Apr20 NoCat	1	BACK-FLOW PREVENTER VALVE

DisciplineMS.rpt 26jun20

Page 1 of 9
Printed and Sent: 25-Aug-20

Scheduled Closing Date:

Purchasers: Dharmendrasinh Vansadiya & Snehalakunwarba V Property: 126

Telephone Res. / Bus: Project: Brampton Encore - Phase 2

Decor Advisor: Yolande Somerville Model and Elevation: 38-11 Elev B Schumann

Layout Changes: ☒ Yes ☐ No Sketch Attached: ☒ Yes ☐ No Exterior Colour Scheme:

1. Cabinetry

	Style and Colour	Counter	Hardware
Kitchen / Breakfast	*Florentine mdf 'White matte'	Granite: Grigio Sardo	*CH-46
Laundry Room	n/a	n/a	n/a
Powder Room	n/a	n/a	n/a
Twin Bath	Varese pvc 'White Crystal'	P-Lam #6696-46	cs1-24
Master Ensuite Bathroom	Siena oak *'Graphite'	P-Lam #6698-46	cs1-24
Second Ensuite Bathroom (If Applicable)	Siena oak 'Greystone'	P-Lam #4925k-07	cs1-24

Comment

2. Floor Tile

	Selection
Entrance Vestibule	*12x24" Eterna London polished 'Imperial Grey'
Main Hall	n/a
Kitchen / Breakfast	see hardwood
Laundry Room	n/a
Powder Room	*12x24" Eterna London polished 'Imperial Grey'
Mud Room	*12x24" Eterna London polished 'Imperial Grey'
Master Ensuite Bathroom	*12x24" Carrara X polished 'White'
Second Ensuite Bathroom (If Applicable)	*12x24" Eterna Carrara polished 'White'
Lower Landing (If Applicable)	n/a
Twin Bath	*12x24" Eterna London polished 'Imperial Grey'

Comment

3. Wall Tile

	Selection	Listello/Inserts	Describe
M. Ens. Tub skirt/splash	8x10" Splendour 'White'	☐ Yes ☒ No	
Master Ensuite Bathroom			
Tub Deck	8x10" Splendour 'White'	☐ Yes ☒ No	
Shower Stall	8x10" Splendour 'White'	☐ Yes ☒ No	
Bathroom Walls	n/a	☐ Yes ☒ No	
Second Ensuite Bathroom (If Applicable)	8x10" Weave 'White'	☐ Yes ☒ No	
Twin Bath	8x10" Weave 'White'	☐ Yes ☒ No	
Kitchen Backsplash	☐ Yes ☒ No	Backsplash Behind Fridge	

Comment

See
attach.
BED-126
June 16, 2020

Scheduled Closing Date:

Purchasers: Dharmendrasinh Vansadiya & Snehal Kunwarba V Property: 126

Telephone Res. / Bus:

Project: Brampton Encore - Phase 2

Decor Advisor: Yolande Somerville

Model and Elevation: 38-11 Elev B Schumann

4. Plumbing Fixtures

Master Ensuite Bathroom Second Ensuite Powder Room
Other Room - Specify Other Washroom

Comment

Standard Thru out

5. Hardwood Flooring

	Type and Stain		Type and Stain
Main Hall	*3/4x5" wht oak wire brush 'Zeus'	Upper Landing	*3/4x5" wht oak wire brush 'Zeus'
Kitchen / Breakfast	*3/4x5" wht oak wire brush 'Zeus'	Upper Hall	n/a
Living Room	*3/4x5" wht oak wire brush 'Zeus'	Master Bedroom	n/a
Dining Room	*3/4x5" wht oak wire brush 'Zeus'	Bedroom #2	n/a
Family Room	*3/4x5" wht oak wire brush 'Zeus'	Bedroom #3	n/a
Den/Library	n/a	Bedroom #4	n/a
Entrance Vestibule	n/a	Bedroom #5	n/a
Lower Landing (If Applicable)	*3/4x5" wht oak wire brush 'Zeus'	Other Room - Specify	

Comment

6. Carpeting

	Upgrade	Description
Ground Floor	☐	
Second Floor	☐	std 4002-21 with std u/pad
	☐	

	Type	Area
Upgrade Underpad		
	Capped	Runner - *Upgrade
Carpet on Stairs		

Comment

7. Fireplace

	Living Room			Family Room			Other Room - Specify		
	Purchased	As Per Plan	N/A	Purchased	As Per Plan	N/A	Purchased	As Per Plan	N/A
Fireplace Type	☐	☐	☒	☐	☒	☐	☐	☐	☒
Mantle Type				Standard gas					
Colour / Stain				NF-24					
Surround				White					
Hearth				Bianco Carrara					
				none					

Comment

See attach.

BE2-126
June 16, 2020

Scheduled Closing Date:

Purchasers: Dharmendrasinh Vansadiya & Snehalakunwarba V Property: 126

Telephone Res. / Bus:

Project: Brampton Encore - Phase 2

Decor Advisor: Yolande Somerville

Model and Elevation: 38-11 Elev B Schumann

8. Trim Carpentry

Interior Doors *Standard Front Door Glass Inserts Standard Door Handles Standard

Interior Trim Standard

Comment

9. Plaster Mouldings and Medallions

Standard Throughout ☐ Yes ☐ No ☒ N/A

Entrance Vestibule Kitchen/Breakfast

Main Hall Den/Library

Living Room Lower Landing

Dining Room Other Room - Specify

Family Room

Comment

10. Railings and Spindles

Railing Package *Euroline1 + V Groove

Railing Colour *Zeus Spindle Colour *Black

Stringer / Riser *Zeus Treads *Zeus

Comment

Oak Stairs ☒ Yes ☐ No ☐ N/A

11. Wall Paint / Ceilings

Throughout Finished Areas Warm Grey

Trim Paint White

Smooth Ceilings

Ground Floor ☒

Second Floor ☐

Note

Comment

See
attach.

BE2-126
June 16, 2020

Scheduled Closing Date:

Purchasers: Dharmendrasinh Vansadiya & Snehalkunwarba \ Property: 126

Telephone Res. / Bus:

Project: Brampton Encore - Phase 2

Decor Advisor: Yolande Somerville

Model and Elevation: 38-11 Elev B Schumann

12. Electrical

Hood Fan ☐ White ☐ Stainless ☒ N/A

Above Kitchen Cabinet Light ☐ Yes ☒ No

Below Kitchen Cabinet Light ☐ Yes ☒ No

Standard Appliances ☐

Over The Range Microwave ☐

Chimney Style Fan ☒

Comment

13. Heating and Air Conditioning

Air Conditioning

Gas Provisions Stove

Gas Provisions Dryer

Gas Provisions Barbecue

Comment

14. Additional Comments

15. Disclaimers and Notes

- 1) Colours of all materials are as close as possible to builder's selection, but not necessarily identical due to variances in manufacturing.
- 2) Any extras listed above are null and void unless accompanied by a separate invoice/amendment. Said invoice must be paid in full.
- 3) The Purchaser acknowledges that after Interior Colour Selection form is signed and dated, no further changes will be permitted other than re-selection due to unavailability. _____ Purchaser's Initials
- 4) The Purchaser acknowledges reading and accepting the "Gold Park Homes Decor Centre Disclaimers" form. This document contains other miscellaneous disclaimers.


This Interior Colour Selection is final and approved by:

Signature: See attach Date: June 16, 2020
(BE2-126)

The Schumann 38' SERIES

Elevation A • 3,050 sq.ft.
Elevation B • 3,050 sq.ft.

BE2-126
MARCH 19 2020 *see attach.*
BE2-126
JUNE 16, 2020. *see attach.*

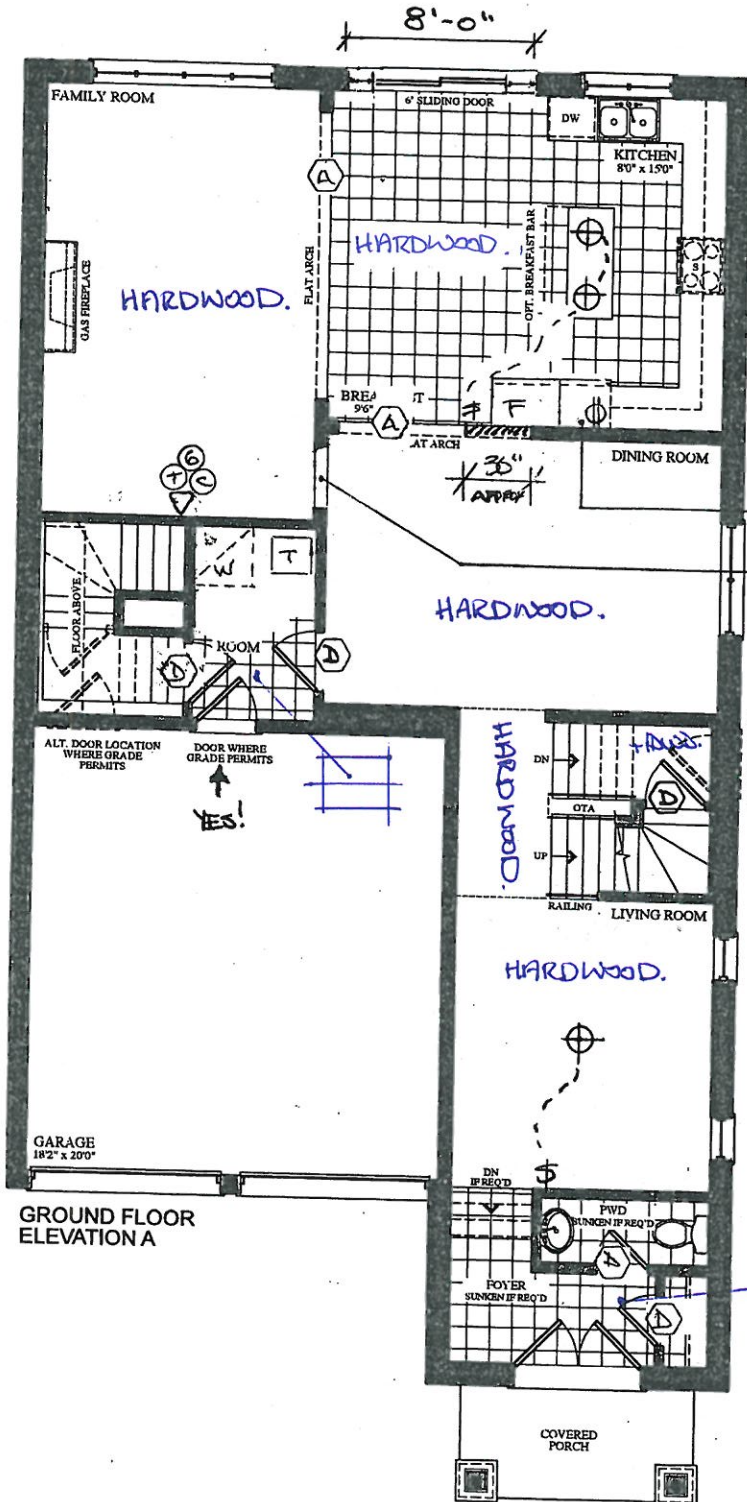

SMOOTH CEILING.

GAS + ELECT.


FRIDGE WATER LINE

WALL OVER.

CREATE "WINDOW"
(30" W, 36" AFF, TOP IN LINE W GRATES).

YES!

PART. GROUND FLOOR
ELEVATION B

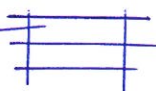

VENDOR

PURCHASER

PURCHASER

GOLDPARK
WORTH MORE™

Prices, figures, illustrations, sizes, features and finishes are subject to change without notice. Areas and dimensions are approximate and actual usable floor space may vary from the stated area. Layout may be reverse of the unit purchased. E. & O.E.

The Schumann 38' SERIES


Elevation A • 3,050 sq.ft.
→ Elevation B • 3,050 sq.ft.

BE2-126
March 19 2020

BE2-126
June 16, 2010.

see attach

see attach

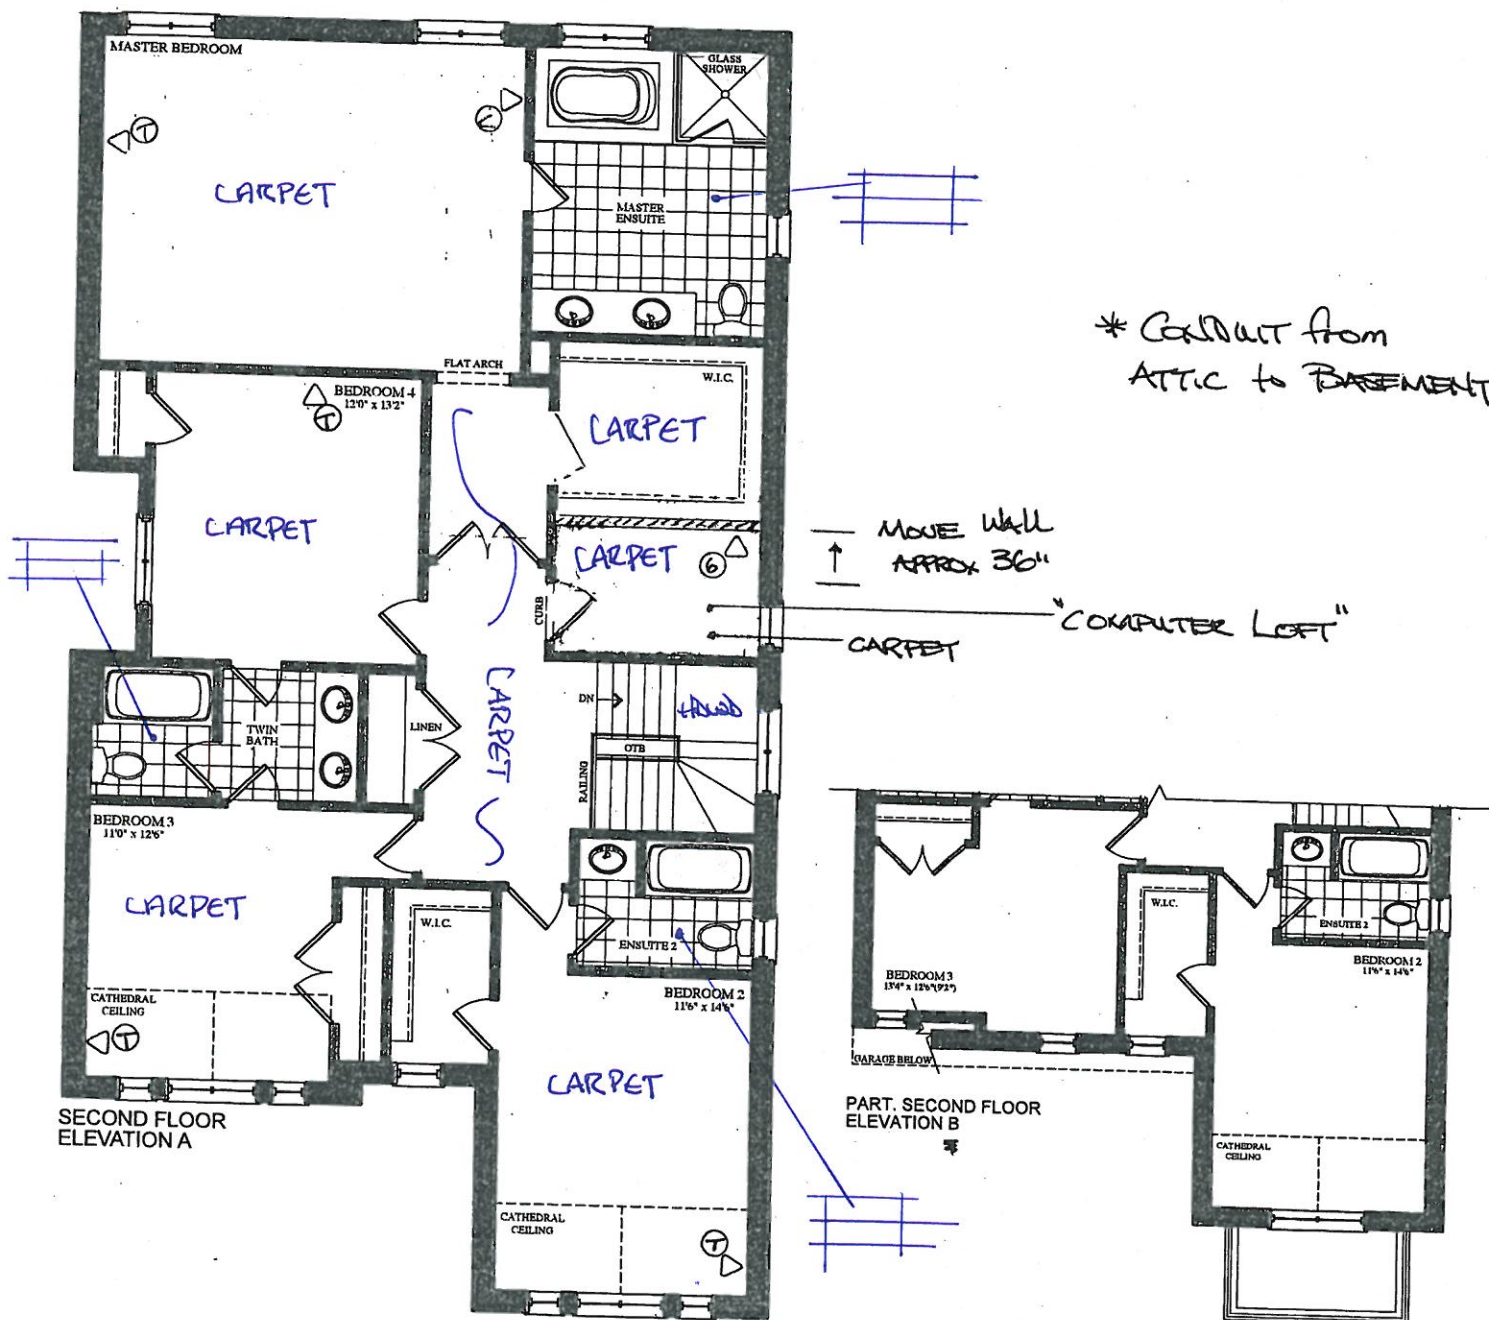

VENDOR
PURCHASER
PURCHASER

GOLDPARK
WORTH MORE™

Prices, figures, illustrations, sizes, features and finishes are subject to change without notice. Areas and dimensions are approximate and actual usable floor space may vary from the stated area. Layout may be reverse of the unit purchased. E. & O.E.

The
Schumann
38' SERIES

Elevation A • 3,050 sq.ft.
Elevation B • 3,050 sq.ft.


BE2-126

MAR 19 2020

see attach.

see attach.

BE2-126
June 16, 2020.

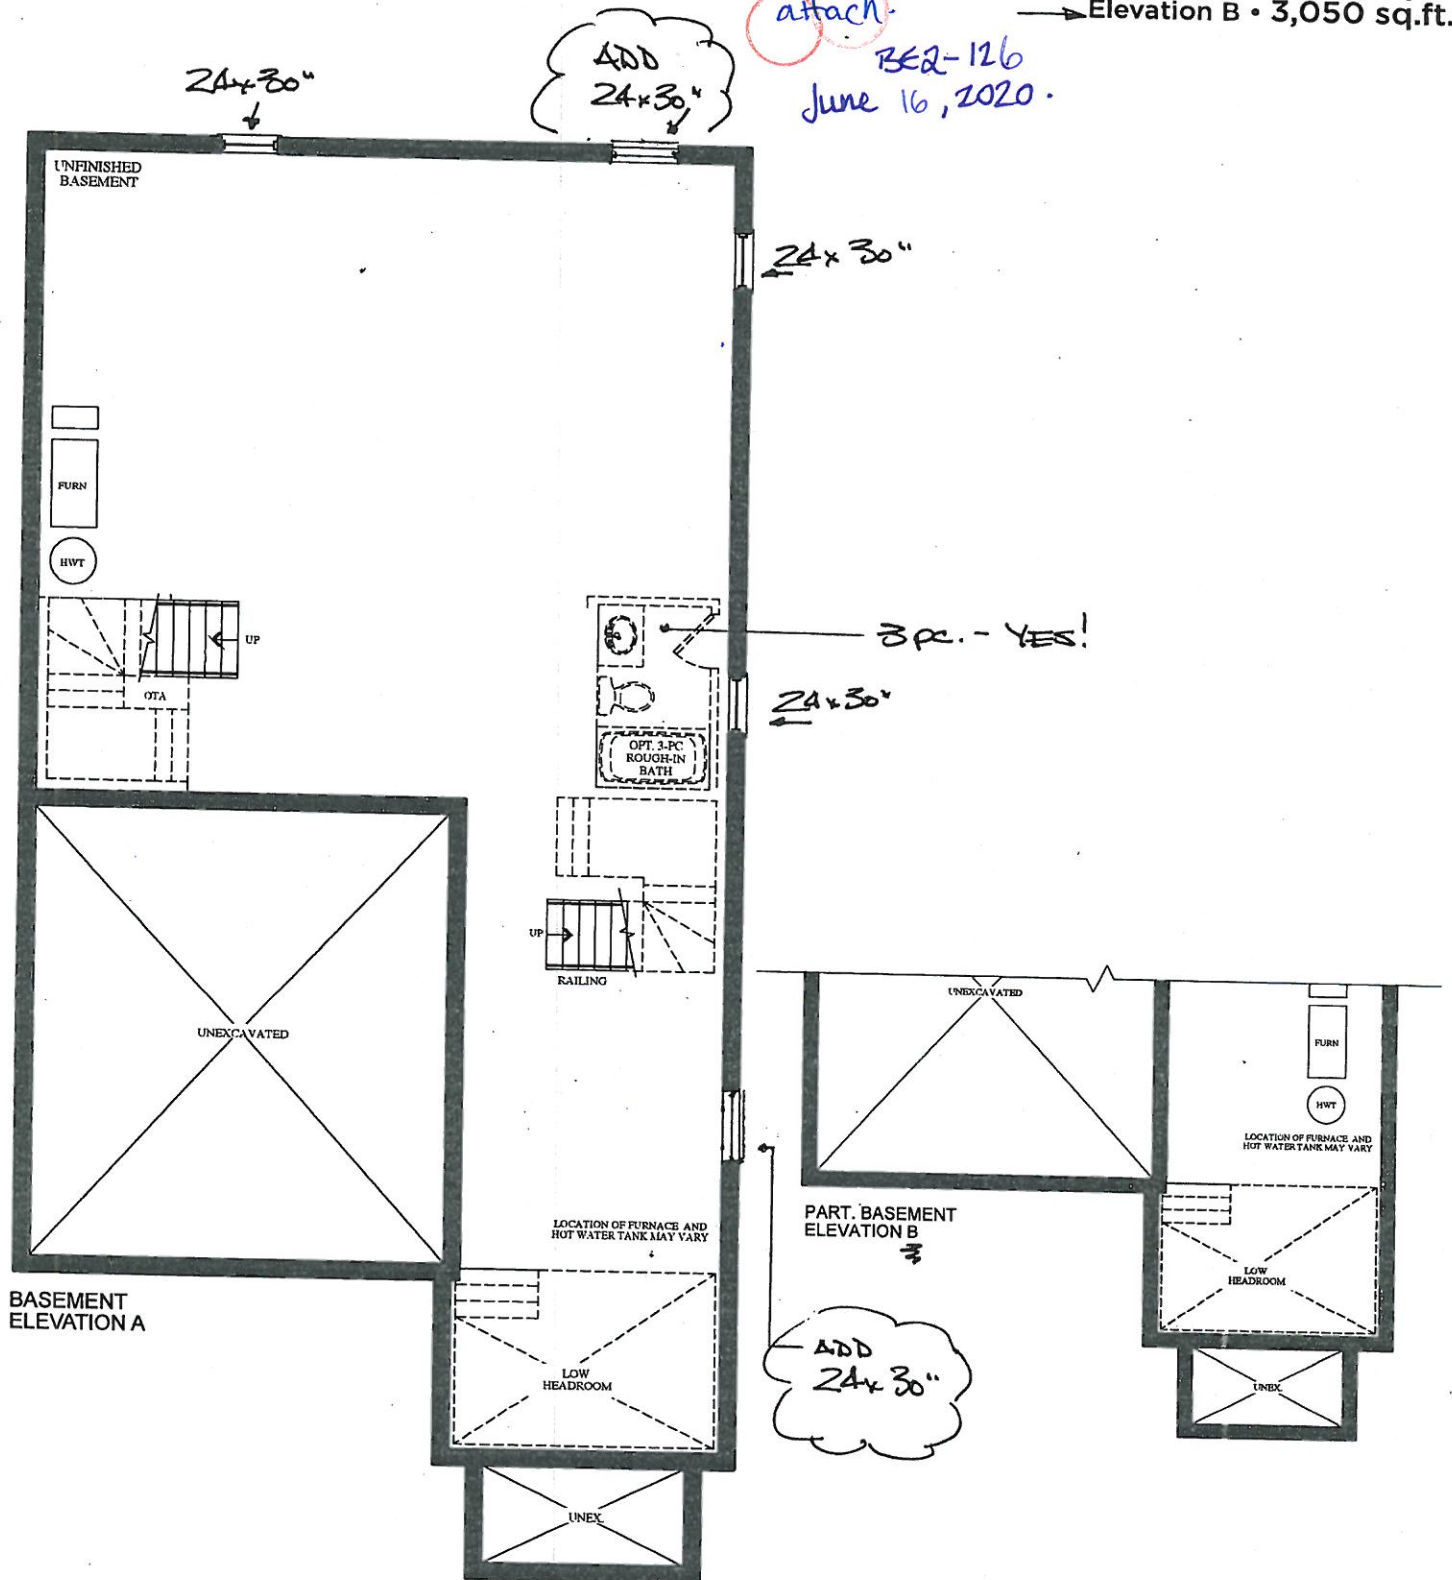

VENDOR

PURCHASER

PURCHASER

GOLDPARK
WORTH MORE™

Prices, figures, illustrations, sizes, features and finishes are subject to change without notice. Areas and dimensions are approximate and actual usable floor space may vary from the stated area. Layout may be reverse of the unit purchased. E. & O.E.

CORTINA

KITCHENS INC.
70 Regina Road, Woodbridge, Ontario L4L 8L6
Tel: 905-264-6464 Fax: 905-264-0664
www.CortinaKitchens.com

BE2-126
June 16, 2020

See
attach.

QUOTATION

Date: 29/11/19

Trade Name: GOLD PARK

Site location: BRAMPTON


Model: 38-11 THE SCHUMAN

Address:

Project: ENCORE 2

Phase:

This layout has been explained to the purchaser by Cortina Kitchens Inc. and is understood by the purchaser.

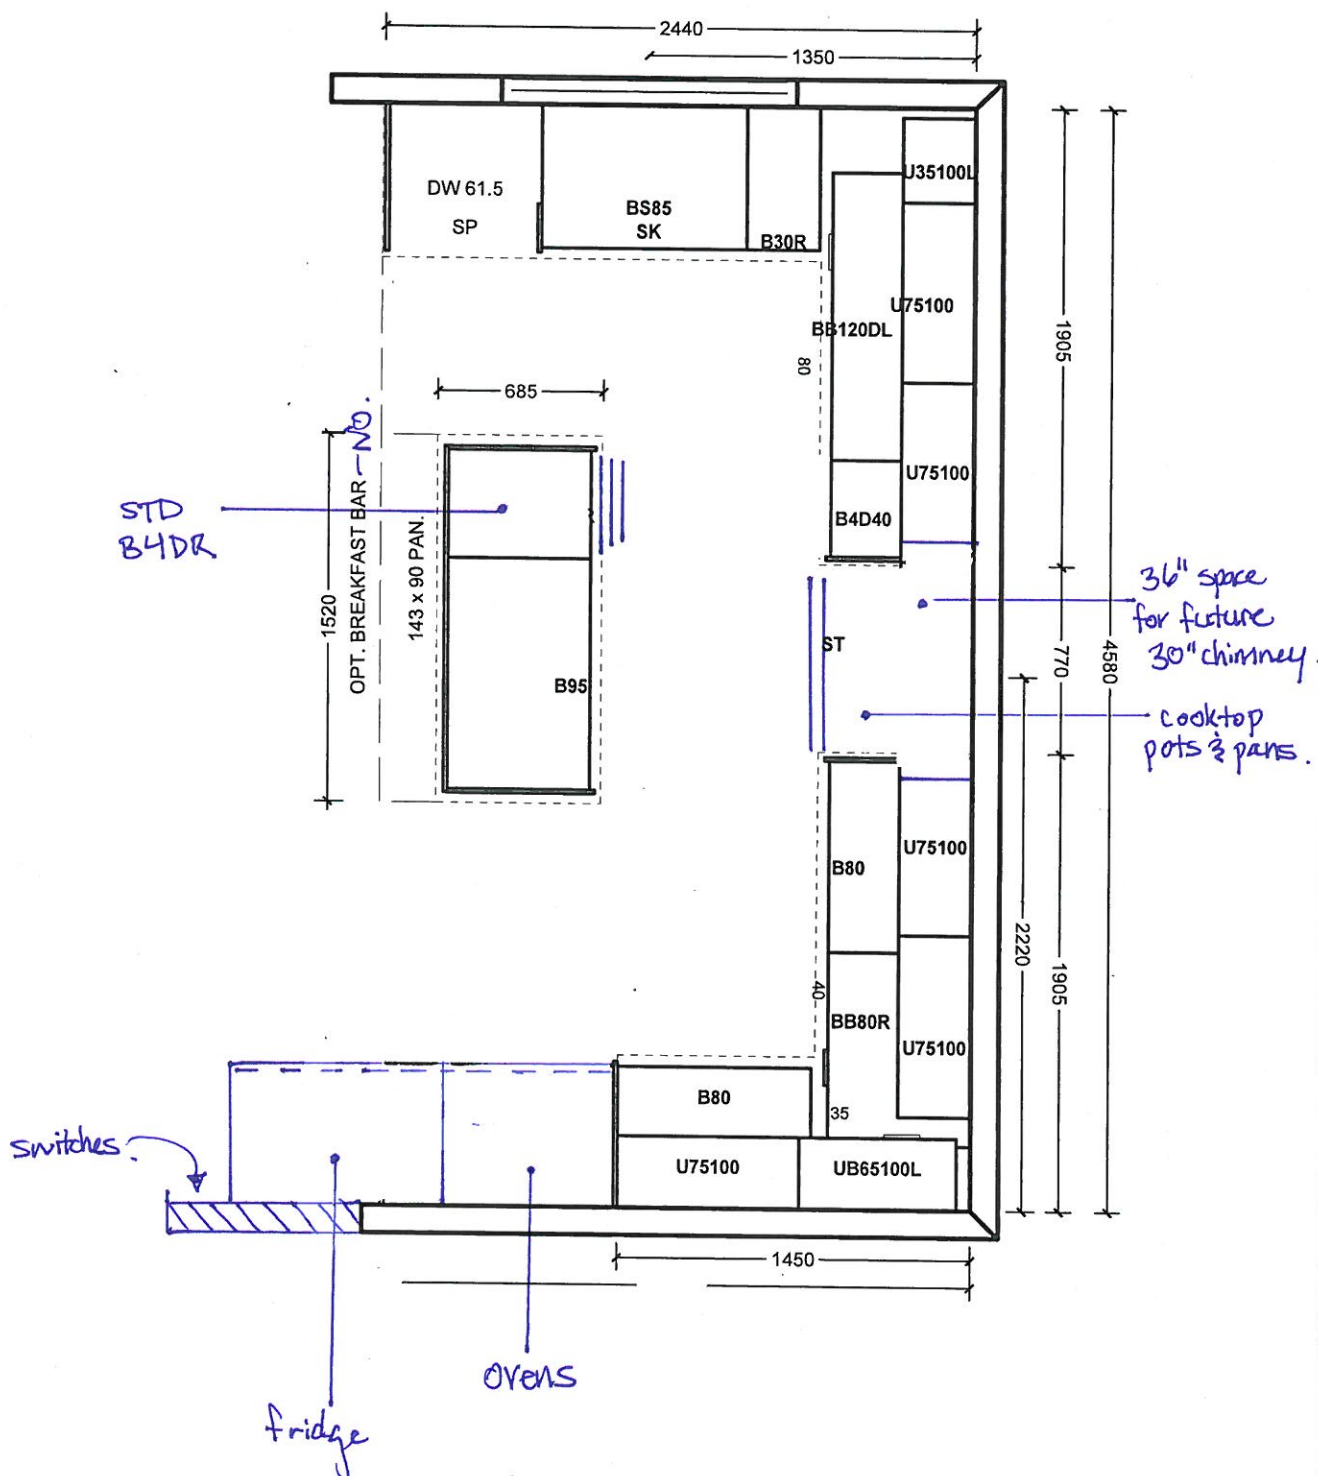

All prices subject to confirmation from head office.
This quotation is subject to the terms & conditions set out
in Cortina's Agreement of Purchase and Sale.

ACCEPTED DATE: _____

All agreements are contingent upon strikes, accidents, and delays beyond our control.
Please provide our installer with template for sinkholes or \$150.00 will be charged for callback.

Customer Signature

Salesperson Signature

Cortina Head Office Approval

Item A. Wood grain and colour are characteristics of the product. We cannot guarantee that such grain and colour will always match.
Item B. Cortina Kitchens Inc. reserves the right to alter dimensions and make technical changes without notice.

CORTINA

KITCHENS INC.
70 Regina Road, Woodbridge, Ontario L4L 8L6
Tel: 905-264-6464 Fax: 905-264-0664
www.CortinaKitchens.com

QUOTATION

Date: 29/11/19

BE2-126
June 16/2020
See attach.

Trade Name: GOLD PARK

Site location: BRAMPTON

Model: 38-11 THE SCHUMAN


Address:

Project: ENCORE 2


Phase:

This layout has been explained to the purchaser by Cortina Kitchens Inc. and is understood by the purchaser.


ENS 2

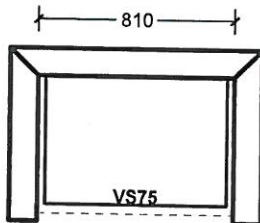


TWIN BATH BED 3/4

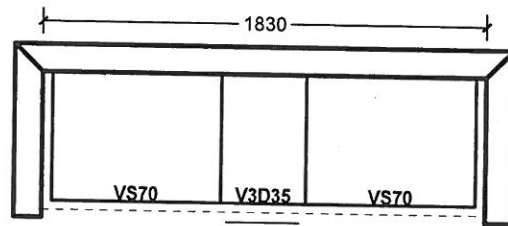

ENSUITE

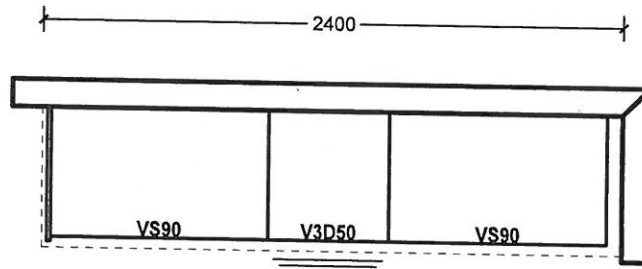

LAUNDRY - No option.

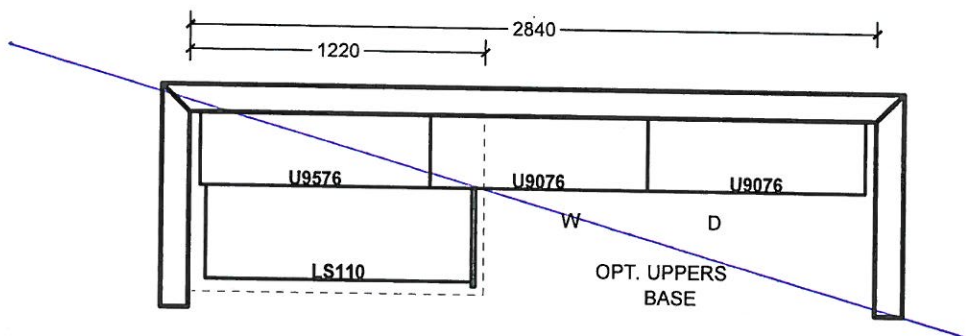

All prices subject to confirmation from head office.
This quotation is subject to the terms & conditions set out
in Cortina's Agreement of Purchase and Sale.

ACCEPTED DATE: _____

All agreements are contingent upon strikes, accidents, and delays beyond our control.
Please provide our installer with template for sinkholes or \$150.00 will be charged for callback.

Customer Signature

Salesperson Signature

Cortina Head Office Approval

Item A. Wood grain and colour are characteristics of the product. We cannot guarantee that such grain and colour will always match.
Item B. Cortina Kitchens Inc. reserves the right to alter dimensions and make technical changes without notice.


- Standard 2CM & 3CM
- ◐ Upgrade 1 2CM & 3CM
- ◑ Upgrade 1 4 CM
- Upgrade 2

20mm (3/4") Profiles




Kitchen.

30mm (1-1/4") Profiles

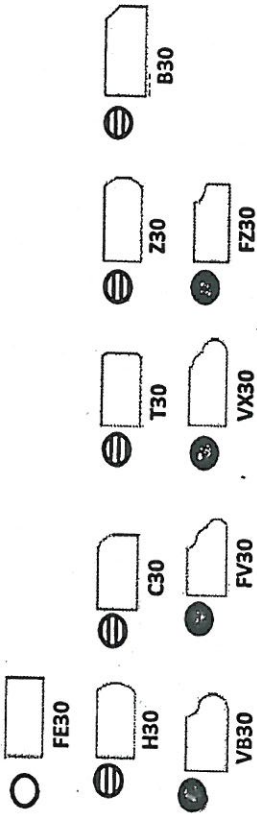

40mm (1-1/2") Profiles

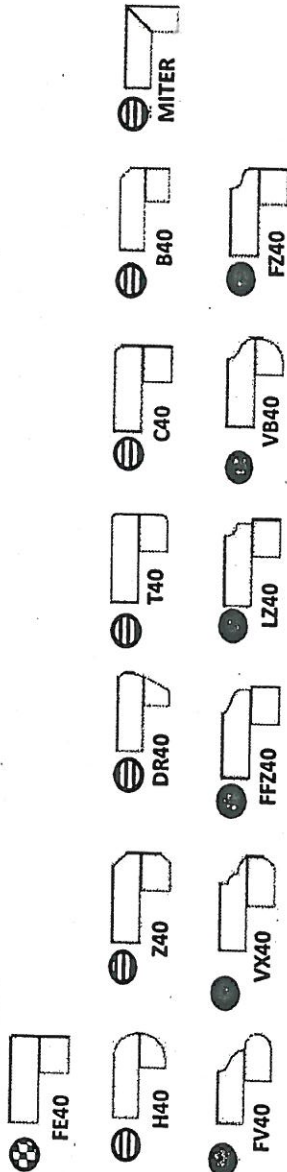


See
attach.
BED-126
JUNE 16, 2020

Note: All colours may not be available in 30mm at time ordered. Vendor reserves the right to use 40 mm edges (by lamination process).

*Mitre edge is available in Upgrade 1 for an overall thickness of 2". All other Mitre edge options will be an Upgrade 2 Edge.

BE2-126
June 16, 2020

See
attach.

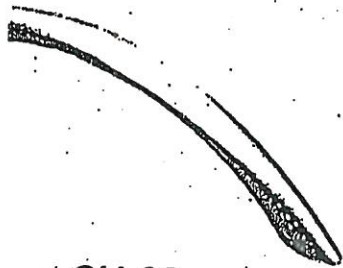


CH-32




CH-38




CH-44

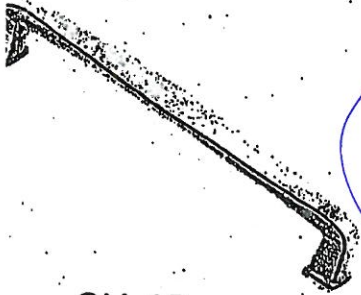


CH-45

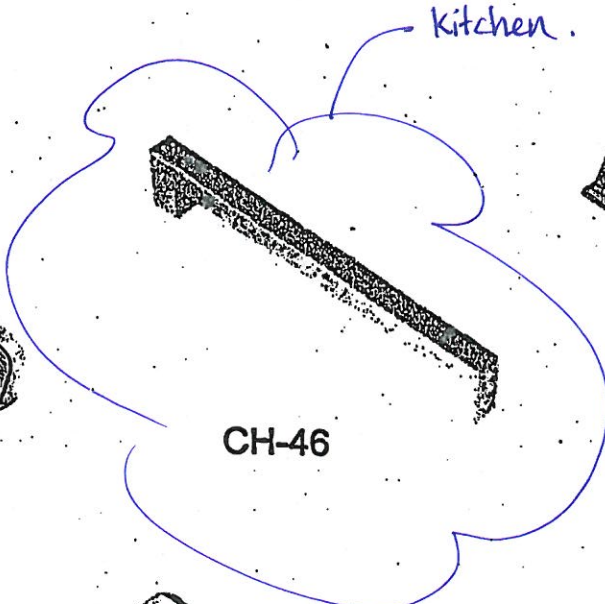

CH-46

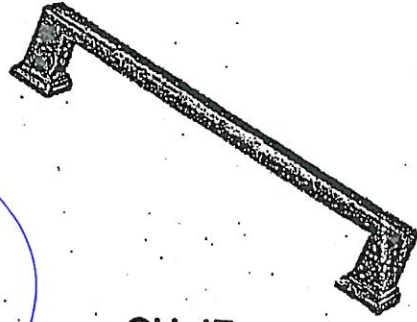

CH-47

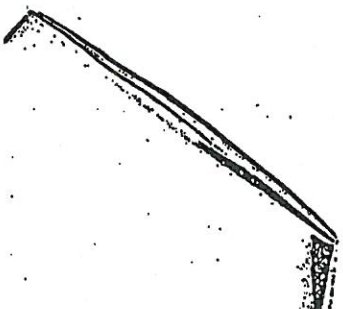


CH-48




CH-49




CH-50

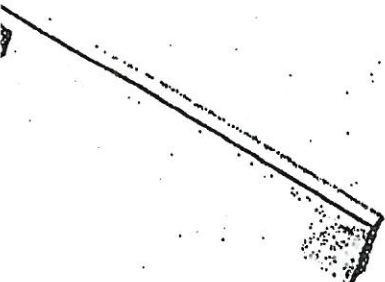

CH-51

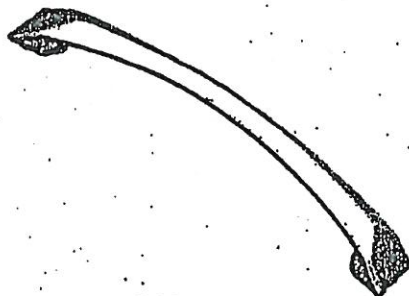

CH-52

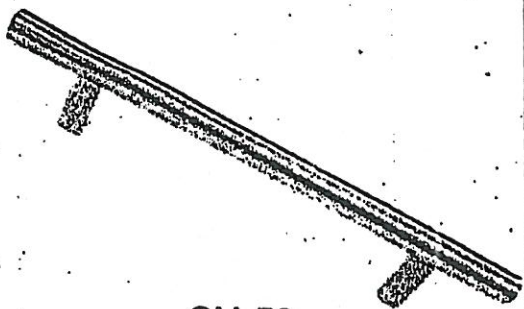

CH-53

NOTES:

IMAGES ARE FOR QUICK REFERENCE PURPOSES ONLY
ACTUAL SIZES AND FINISHES AS PER HARDWARE
SAMPLE BOARD PROVIDED TO DECOR CENTRE

BE2-126
JUNE 16/2020

See
attach




CSI-6




CSI-10




CSI-14

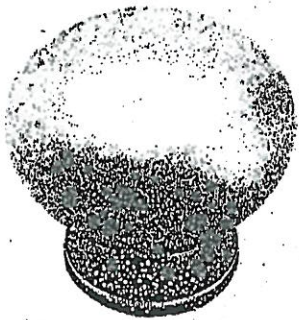

CSI-16

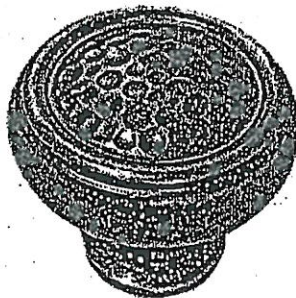

CSI-18

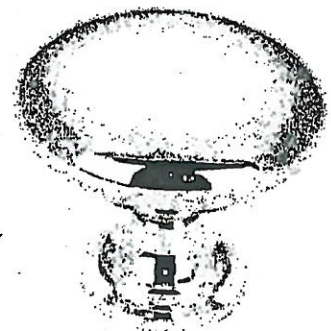

CSI-19




CSI-20




CSI-21



CSI-22

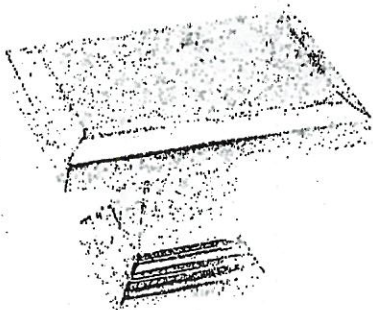


CSI-23

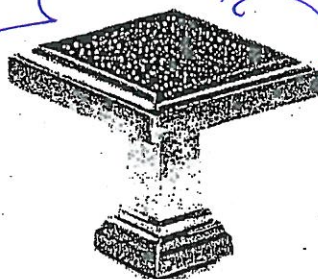

CSI-24

1. Master Ensuite
2. Twin Ensuite
3. Ensuite 2.

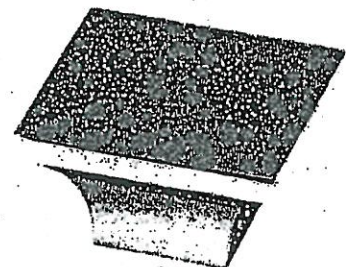

CSI-25

***NOTES:**

- IMAGES ARE FOR QUICK REFERENCE PURPOSES ONLY
- ACTUAL SIZES AND FINISHES AS PER HARDWARE SAMPLE BOARD PROVIDED TO DECOR CENTRE



BATHROOM ACCESSORIES

PROJECT: ENCORE 2

LOT: 126

INSTALL STANDARD BATHROOM ACCESSORIES
THRU OUT (TOWEL BAR, SOAP DISH, TISSUE
HOLDER) **location as per vendors discretion

☐

DO *NOT* INSTALL STANDARD BATHROOM
ACCESSORIES THRU OUT (TOWEL BAR, SOAP
DISH, TISSUE HOLDER)

☒

SIGNATURE: see attach.

SIGNATURE:

DATE: June 16, 2020



Project: Encore 2

Lot: 126

Purchaser(s): DHARMENDRA SURESH VANSADIYA

Standard Hood Fan Deletion

We acknowledge that the builder's standard hood fan will not be installed.
Do not supply, install and/or credit. We will install our own hood fan after closing.

Signature: see attach.

Signature:

Date: June 16, 2020

*** NOTE: This is not an approved document. Document must be locked ***

Scheduled Closing Date:

Purchasers: Dharmendrasinh Vansadiya & Snehal Kumbar v Property: 126

Telephone Res. / Bus:

Project: Brampton Encore - Phase 2

Decor Advisor: Yolande Somenflo

Model and Elevation: 38-11 Elev B Schumann

Layout Changes: ☒ Yes ☐ No

Sketch Attached: ☒ Yes ☐ No

Exterior Colour Scheme:

1. Cabinetry

	Style and Colour	Counter	Hardware
Kitchen / Breakfast	Florientino mdf 'White matte'	Granite: Grigio Sardo	CH-46
Laundry Room	n/a	n/a	n/a
Powder Room	n/a	n/a	n/a
Twin Bath	Varoso pvc 'White Crystal'	P-Lam #6696-46	CS1-24
Master Ensuite Bathroom	Siena oak 'Graphite'	P-Lam #6698-46	CS1-24
Second Ensuite Bathroom (If Applicable)	Siena oak 'Greystone'	P-Lam #4925K-07	CS1-24

Comment

2. Floor Tile

	Selection
Entrance Vestibule	"12x24" Eterna London polished 'Imperial Grey'
Main Hall	n/a
Kitchen / Breakfast	see hardwood
Laundry Room	n/a
Powder Room	"12x24" Eterna London polished 'Imperial Grey'
Mud Room	"12x24" Eterna London polished 'Imperial Grey'
Master Ensuite Bathroom	"12x24" Carrara X polished 'White'
Second Ensuite Bathroom (If Applicable)	"12x24" Eterna Carrara polished 'White'
Lower Landing (If Applicable)	n/a
Twin Bath	"12x24" Eterna London polished 'Imperial Grey'

Comment

3. Wall Tile

	Selection	ListeBohnartis	Describe
M. Ens. Tub skirt/splash	8x10" Splendour 'White'	☐ Yes ☒ No	
Master Ensuite Bathroom			
Tub Deck	8x10" Splendour 'White'	☐ Yes ☒ No	
Shower Stall	8x10" Splendour 'White'	☐ Yes ☒ No	
Bathroom Walls	n/a	☐ Yes ☒ No	
Second Ensuite Bathroom (If Applicable)	8x10" Weave 'White'	☐ Yes ☒ No	
Twin Bath	8x10" Weave 'White'	☐ Yes ☒ No	
Kitchen Backsplash	☐ Yes ☒ No		Backsplash Behind Fridge

Comment

NSA
23-126
June 16, 2020

GOLDPARK

NOTE: This is not an approved document. Document must be locked

INTERIOR COLOUR SCHEME

Purchasers:

Sharm Prakash Vatsa & Sonika Vatsa Property, 128

Telephone Res. / Bus:

Project: Brampton Encore - Phase 2

Decor Advisor:

Yolanke Simenoff

Model and Elevation: 38-11 Elev B Schumann

4. Plumbing Fixtures

Master Ensuite Bathroom

Second Ensuite

Powder Room

Comment

Other Room - Specify

Other Washroom

Standard Finishes

5. Hardwood Flooring

Main Hall

Type and Stain

3/4x5" whit oak wire brush 'Zeus'

Upper Landing

Type and Stain

3/4x5" whit oak w/o brush 'Zeus'

Kitchen / Breakfast

3/4x5" whit oak wire brush 'Zeus'

Upper Hall

N/A

Living Room

3/4x5" whit oak wire brush 'Zeus'

Master Bedroom

N/A

Dining Room

3/4x5" whit oak wire brush 'Zeus'

Bedroom #2

N/A

Family Room

3/4x5" whit oak wire brush 'Zeus'

Bedroom #3

N/A

Den/Library

N/A

Bedroom #4

N/A

Entrance Vestibule

N/A

Bedroom #5

N/A

Lower Landing

3/4x5" whit oak wire brush 'Zeus'

Other Room - Specify

(If Applicable)

Comment

6. Carpeting

Ground Floor

Upgrade

Description

Second Floor

☐

3/8" 4002-21 with sisal underpad

Upgrade Underpad

Type

Area

Carpet on Stairs

Capped

Runner - Upgrade

Comment

7. Fireplace

Living Room

Purchased

As Per Plan

N/A

Family Room

Purchased

As Per Plan

N/A

Other Room - Specify

Purchased

As Per Plan

N/A

Fireplace Type

Standard gas

Manifold Type

NF-24

Colour / Stain

White

Surround

Bianco Carrara

Hearth

None

Comment

IV 5A
662-126
June 16, 2010

GOLDPARK
WORKSHOP**INTERIOR COLOUR SCHEME******* NOTE: This is not an approved document. Document must be locked *****
Scheduled Closing Date:

Purchasers: Dharmendrash Vansadia & Snehal Kumarbe V. Property: 128
Telephone Res. / Bus: Project: Brampton Encore - Phase 2
Decor Advisor: Yolande Gomerelle Model and Elevation: 38-11 Elev B Schumann

8. Trim Carpentry

Interior Doors ☒ Standard Front Door Glass Inserts ☒ Standard Door Handles ☒ Standard
Interior Trim ☒ Standard
Comment:

9. Plaster Mouldings and MedallionsStandard Throughout ☐ Yes ☐ No ☒ N/A

Entrance Vestibule			Kitchen/Breakfast		
Main Hall			Den/Library		
Living Room			Lower Landing		
Dining Room			Other Room - Specify		
Family Room					
Comment:					

10. Railings and Spindles

Railing Package ☒ Standard / V-Groove
Railing Colour ☒ Zeus
Stringer / Riser ☒ Zeus
Spindle Colour ☒ Black
Treads ☒ Zeus
Oak Stairs ☒ Yes ☐ No ☐ N/A
Comment:

11. Wall Paint / CeilingsThroughout Finished Areas ☒ Warm GreyTrim Paint ☒ White

Smooth Ceilings

Ground Floor ☒Second Floor ☐

Note:

Comment:

BY SA
BE2-126
June 16, 2020

*** NOTE: This is not an approved document. Document must be locked ***
Scheduled Closing Date:

Purchasers: Chameindrasith Manasinga & Snehakumwatha's Property: 128

Telephone Res / Rev:

Project: Brampton Enclave - Phase 2

Decor Advisor: Yolanda Sommers

Model and Elevation: 38-11 E by B Schumann

12. Electrical

Hood Fan ☐ With ☐ Stainless ☒ NA

Above Kitchen Cabinet Light ☐ Yes ☒ No

Standard Appliances ☐

Below Kitchen Cabinet Light ☐ Yes ☒ No

Over The Range Microwave ☐

Chimney Style Fan ☒

Comment

13. Heating and Air Conditioning

Air Conditioning ☒

Gas Provisions Stove ☒

Gas Provisions Dryer ☒

Gas Provisions Barbecue ☒

Comment

14. Additional Comments

15. Disclaimers and Notes

- Colours of all materials are as close as possible to builder's selection, but not necessarily identical due to variances in manufacturing.
- Any errors listed above are null and void unless accompanied by a separate invoice/amendment. Said invoice must be paid in full.
- The Purchaser acknowledges that after the final Colour Selection form is signed and dated, no further changes will be permitted other than reselection due to unavailability. Purchaser's Initials: _____
- The Purchaser acknowledges reading and accepting the "Gold Park Homes Decor Centre Disclaimers" form. This document contains other miscellaneous disclaimers.

This Interior Colour Selection is final and approved by:

Signature: D. V. Van der Merwe Date: June 16, 2020
(BET-126)

**The
Schumann**
38' SERIES


Elevation A = 3,050 sq.ft.
 → Elevation B = 3,050 sq.ft.

FF-2-126

4/21/19 232

REF-126

June 16, 2020

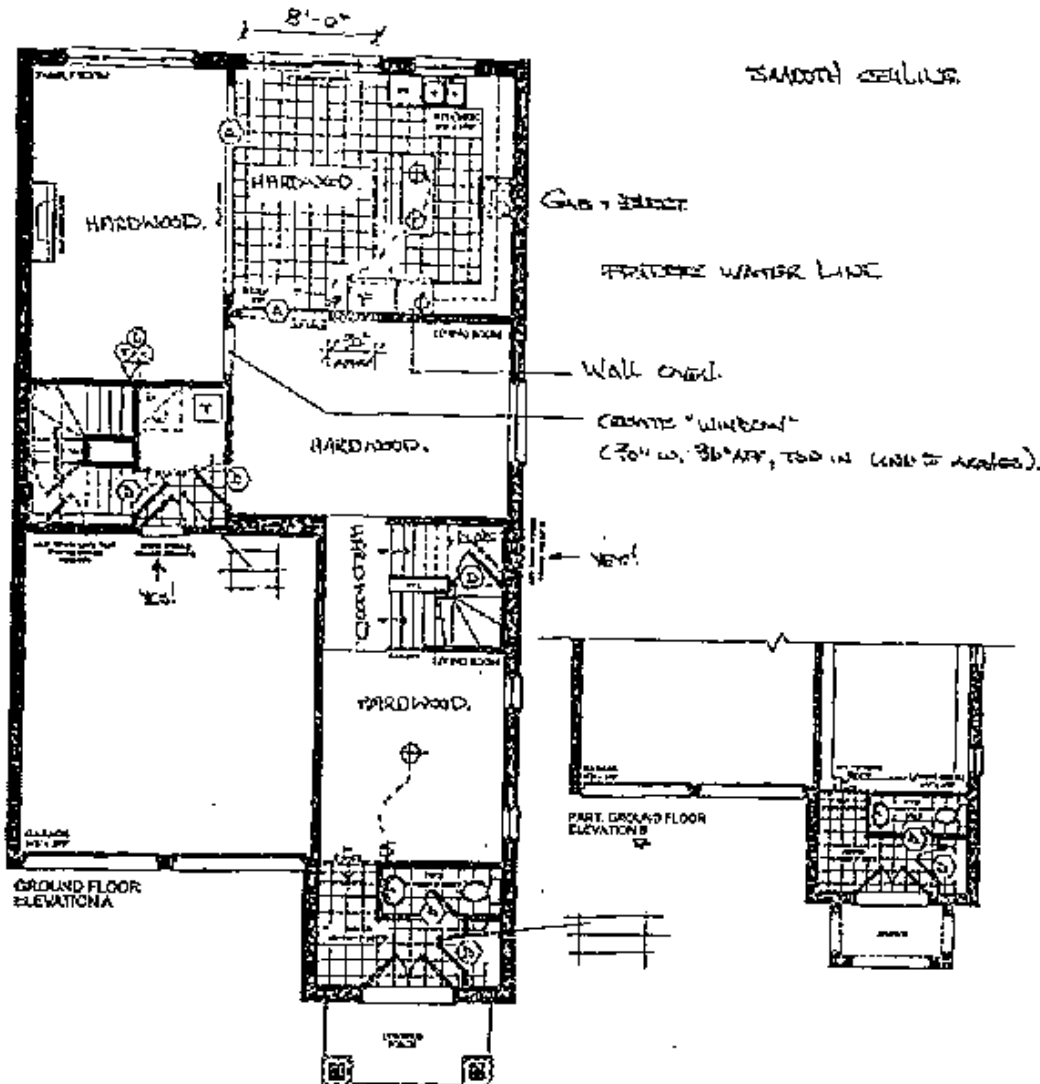

VENDOR

PURCHASER

PURCHASER

GOLDPARK

WORTH MORE

Some square tubular steel features and finishes are subject to change without notice. Always different ones are acceptable and actual used floor plate may vary from the stated one. Layout may be different of the one provided. E & O E.


encore
BUILDERS

SCHEDULE 'T'

The Schumann 38' SERIES

Elevation A = 3,050 sq.ft.
Elevation B = 3,050 sq.ft.

BS2-126
March 13, 2020
BS2-126
June 10, 2020

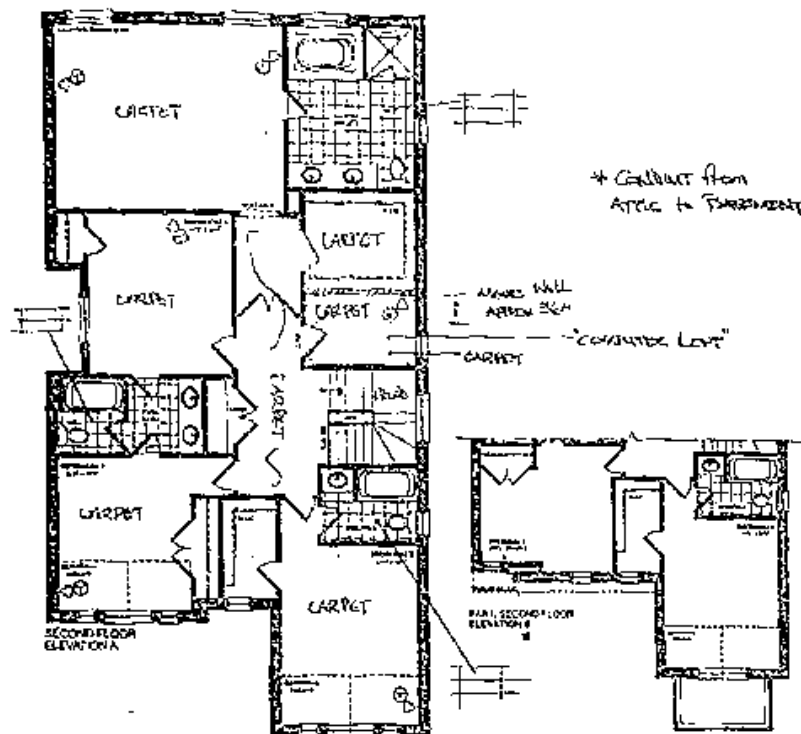

VENDOR
PURCHASER
PURCHASER

GOLDPARK
WORTH, MO

These floor plans are shown with fixtures and finishes as listed to change a floor plan. Areas and dimensions are approximate and shall include floor space may vary from the actual and shall be the responsibility of the architect, E.B.C.

encore
FRANCONIA

SCHEDULE 'F'

The Schumann 38' SERIES


Elevation A • 3,050 sq.ft.
Elevation B • 3,050 sq.ft.

PS-2-126

MARCH 13 2022

PS-2-126

JUNE 16, 2020

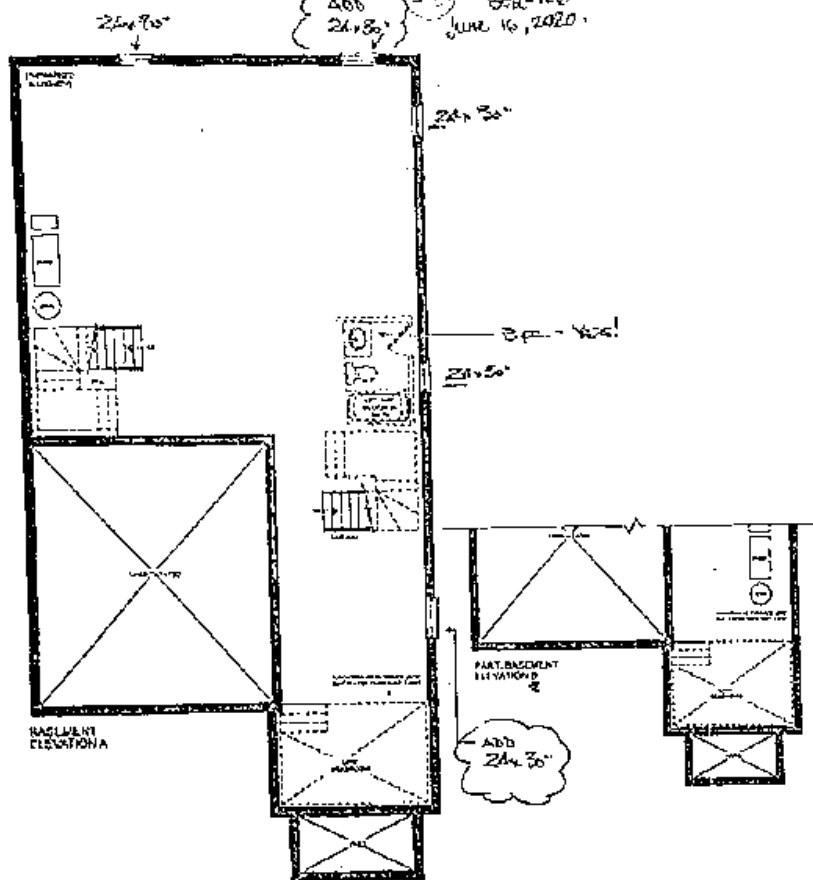


VENDOR

PURCHASER

PURCHASER

GOLDPARK
WORTH 405"

Prices, features, dimensions, and finishes are subject to change without notice. Areas and dimensions are approximate and actual results may vary. From the actual area layout may be shown in the unit specifications.

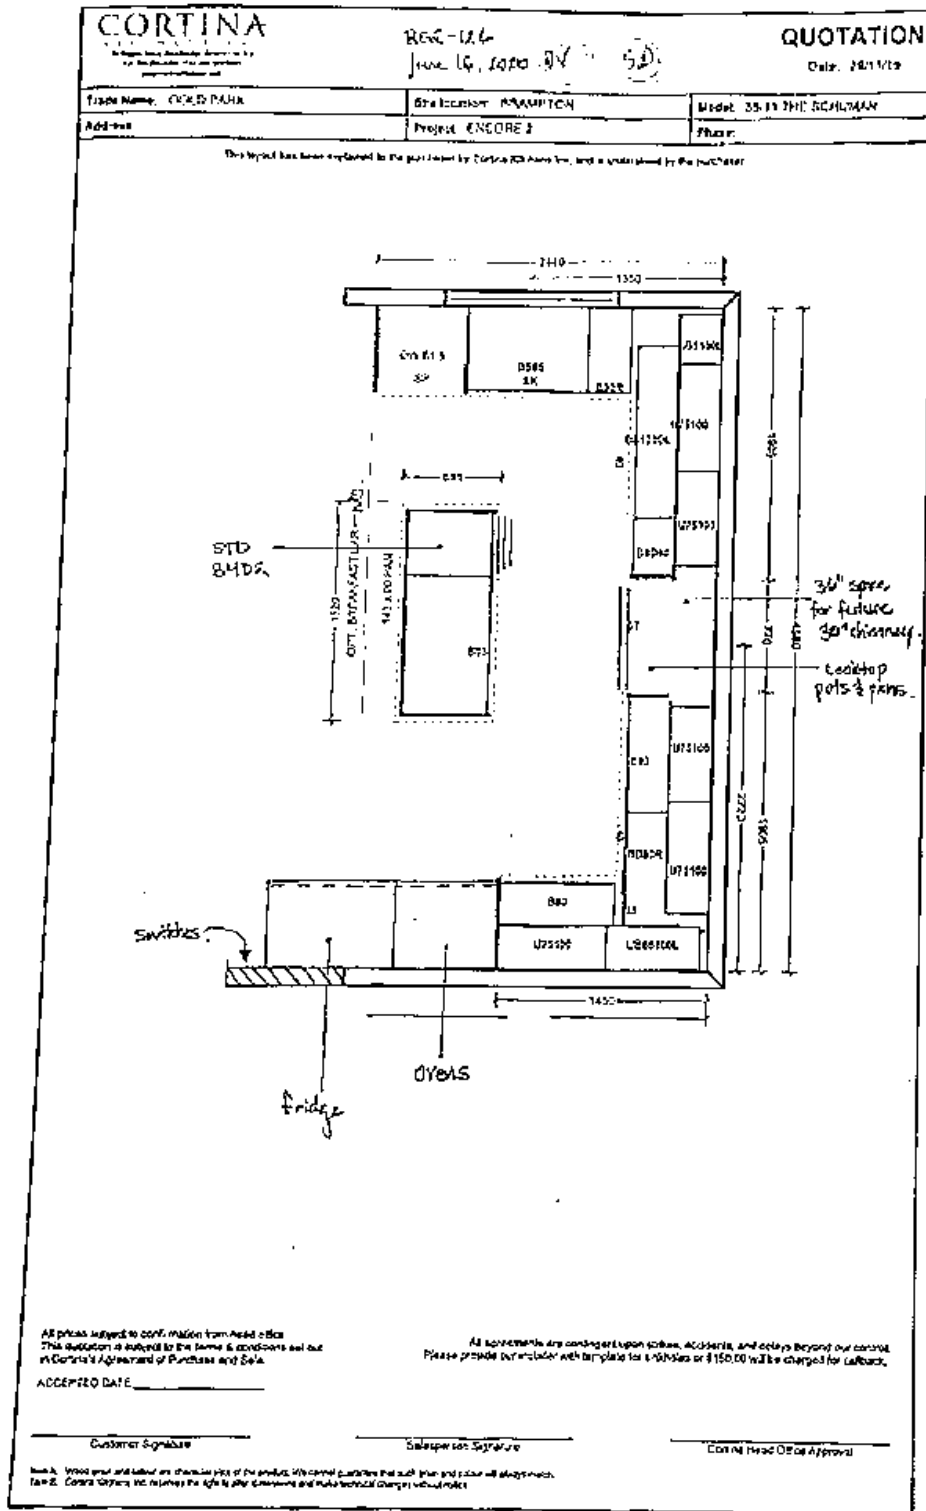

CORTINA

1000 Highway 100, Suite 100
St. Catharines, ON L7M 7K5
905-688-8888

QUOTATION

Date: 26/11/19

Handwritten: 26-11-19
June 16, 2019

Project Name: GOLD PARK

Site Location: BRAMPTON

Model: 25-11 THE SCHUMMER


Project: ENCORE 2

Phase:

Address:

This quote has been prepared by the supplier by Cortina Kitchens Inc. and is intended for the purchaser.


ENS 2

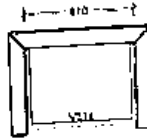


TWIN BATH BED 3/4



ENSUITE

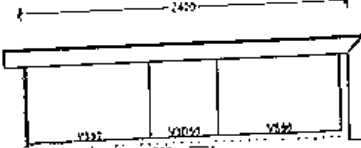

LAUNDRY - NO CROWN

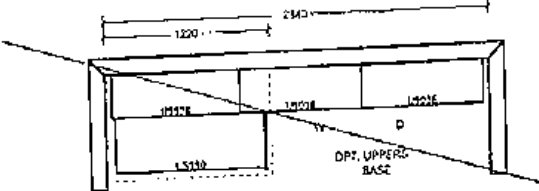

All prices subject to confirmation from head office.
This quotation is subject to the terms & conditions set out
in Cortina's Agreement of Purchase and Sale.

All agreements are binding and upon all best, accidents, and delays beyond our control.
Please provide our installer with templates for details or \$110.00 will be charged for cutback.

ACCEPTED DATE: _____

Customer Signature: _____

Salesperson Signature: _____

Cortina's Office Approval: _____

Item A: Wood panel and other in the assembly of the product. We cannot guarantee that such panel and other items will be replaced.
Item B: Cortina Kitchens Inc. reserves the right to alter dimensions and/or technical specifications without notice.

Granite, Marble,
Engineered Surfaces

[illegible]

XTINA

UPGRADE HARDWARE

CH-125
June 16, 2020 (N) (52)

UPGRADE HARDWARE



CH-32




CH-38




CH-44



CH-45

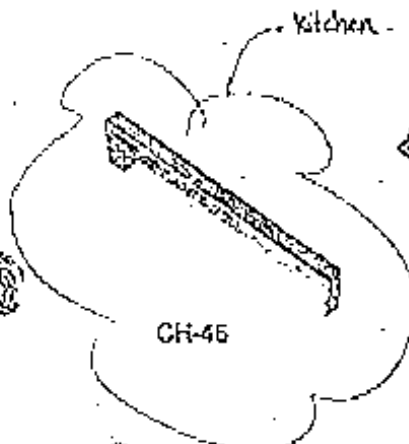

CH-46

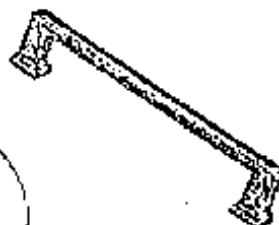

CH-47



CH-48



CH-49



CH-50



CH-51



CH-52



CH-53

NOTES:

IMAGES ARE FOR QUICK REFERENCE PURPOSES ONLY
ACTUAL SIZES AND FINISHES AS PER HARDWARE
AMPLE BOARD PROVIDED TO DECOR CENTRE

STANDARD HARDWARE

RES-126
June 1990 (N)

STANDARD HARDWARE



CSI-6



CSI-10



CSI-14



CSI-16



CSI-18



CSI-19



CSI-20




CSI-21



CSI-22



CSI-23

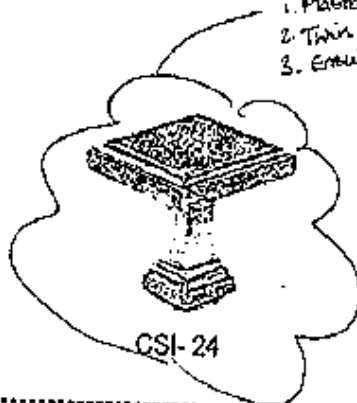

CSI-24



CSI-25

1. Master Engraving
2. Thin Engraving
3. Engraving 2

NOTES:

- IMAGES ARE FOR QUICK REFERENCE PURPOSES ONLY
- ACTUAL SIZES AND FINISHES AS PER HARDWARE
- SAMPLE BOARD PROVIDED TO DECOR CENTRE

WORTH MORE

PROJECT: ENCORE 2

LOT: 126

☐

SIGNATURE

D. N. V. *Very nice* -

SIGNATURE:

S. A. V.

DATE:

June 16, 2020



Project: Encore 2

Lot: 126

Purchaser(s): ~~D. N. VANDALIYA~~ S. D. VANDALIYA

Standard Hood Fan Deletion

We acknowledge that the builder's standard hood fan will not be installed.
Do not supply, install and/or credit. We will install our own hood fan after closing.

Signature:  D. N. Vandalia

Signature:  S. D. Vandalia

Date: June 16, 2020