

GOLDPARK

WORTH MORE™

CONSTRUCTION SUMMARY

Lot: 153

Model: 40.03 B BROOKSIDE

Project/Phase: Pine Valley Forevergreen / 1

APPLIANCES

Invoice	Qty.	Description
2360 72,217 25Aug20 **	1	KITCHEN - UPGRADE TO 8" DUCT (EXTERIOR WALL) IN LIEU OF STANDARD OFFERING

CONCRETE AND DRAIN

Invoice	Qty.	Description
2233 24Jul20 NoCat	1	.BACK-FLOW PREVENTER VALVE
2360 25Aug20 NoCat	1	.RELOCATE LAUNDRY ROOM FROM GROUND OR 2ND FLOOR TO BASEMENT

DRYWALL

Invoice	Qty.	Description
2360 25Aug20 NoCat	1	.**CUSTOM LAYOUT** DINING ROOM - DELETE ARCHWAY FROM MAIN HALL *AND* FURNITURE NICHE MOVE POWDER ROOM AND WIC - MAKING CLOSET APPROX 24" LONGER. SEE PLAN FOR LOCATION
2360 25Aug20 NoCat	1	**CUSTOM LAYOUT** DELETE LINEN CLOSET, INCREASE BEDROOM 2 CLOSET - RECENTER DOORS REVISE LAYOUT OF BEDROOM 4 WIC TO CREATE LARGER LINEN CLOSET ACCESSIBLE FROM HALLWAY
2360 25Aug20 NoCat	14	.THRU OUT: ADDITIONAL FOR SAFE & SOUND (SOLID CORE)
2360 25Aug20 NoCat	3	.UPGRADE TO CURVED ARCHWAY PRICE PER OPENING: MAIN HALLWAY / FOYER MAIN HALLWAY (AT STAIRS) MAIN HALLWAY (AT BREAKFAST)
2360 25Aug20 NoCat	1	**CUSTOM LAYOUT** BEDROOM 3: INCREASE CLOSET APPROX 18" - RE-CENTER DOORS (SEE PLAN FOR LOCATION)
2360 25Aug20 NoCat	1	**CUSTOM LAYOUT** DELETE CLOSET IN MUD ROOM - LEAVE OPEN SPACE

DisciplineMS.rpt 26jun20

Page 1 of 6
Printed and Sent: 25-Aug-20

PAINT

Invoice	Qty.	Description
2360 25Aug20 NoCat	1	**CUSTOM LAYOUT** DELETE LINEN CLOSET, INCREASE BEDROOM 2 CLOSET - RECENTER DOORS REVISE LAYOUT OF BEDROOM 4 WIC TO CREATE LARGER LINEN CLOSET ACCESSIBLE FROM HALLWAY
2360 25Aug20 NoCat	3	.UPGRADE TO CURVED ARCHWAY PRICE PER OPENING: MAIN HALLWAY / FOYER MAIN HALLWAY (AT STAIRS) MAIN HALLWAY (AT BREAKFAST)
2360 25Aug20 NoCat	1	**CUSTOM LAYOUT** DELETE CLOSET IN MUD ROOM - LEAVE OPEN SPACE

PLUMBING

Invoice	Qty.	Description
2233 24Jul20 NoCat	1	.BACK-FLOW PREVENTER VALVE
2360 72,349 25Aug20	1	.RELOCATE LAUNDRY ROOM FROM GROUND OR 2ND FLOOR TO BASEMENT
2360 72,332 25Aug20	1	KITCHEN: ROUGH-IN 1/4" COLD WATER LINE TO FRIDGE

WINDOWS - BASEMENT

Invoice	Qty.	Description
2233 72,351 24Jul20	3	.BASEMENT WINDOWS - UPGRADE BASEMENT WINDOW SIZE TO 30 " X 24" - 8" FRAME

WINDOWS AND DOORS

Invoice	Qty.	Description
2360 25Aug20 NoCat	2	.BREAKFAST ROOM: UPGRADE EXTERIOR FRENCH DOOR ASSEMBLY TO 96" HEIGHT




SCHEDULE 'F'

PV-153
July 17 2024

The
Brookside
40' SERIES

Elevation A • 3,380 sq.ft.

→ Elevation B • 3,350 sq.ft.

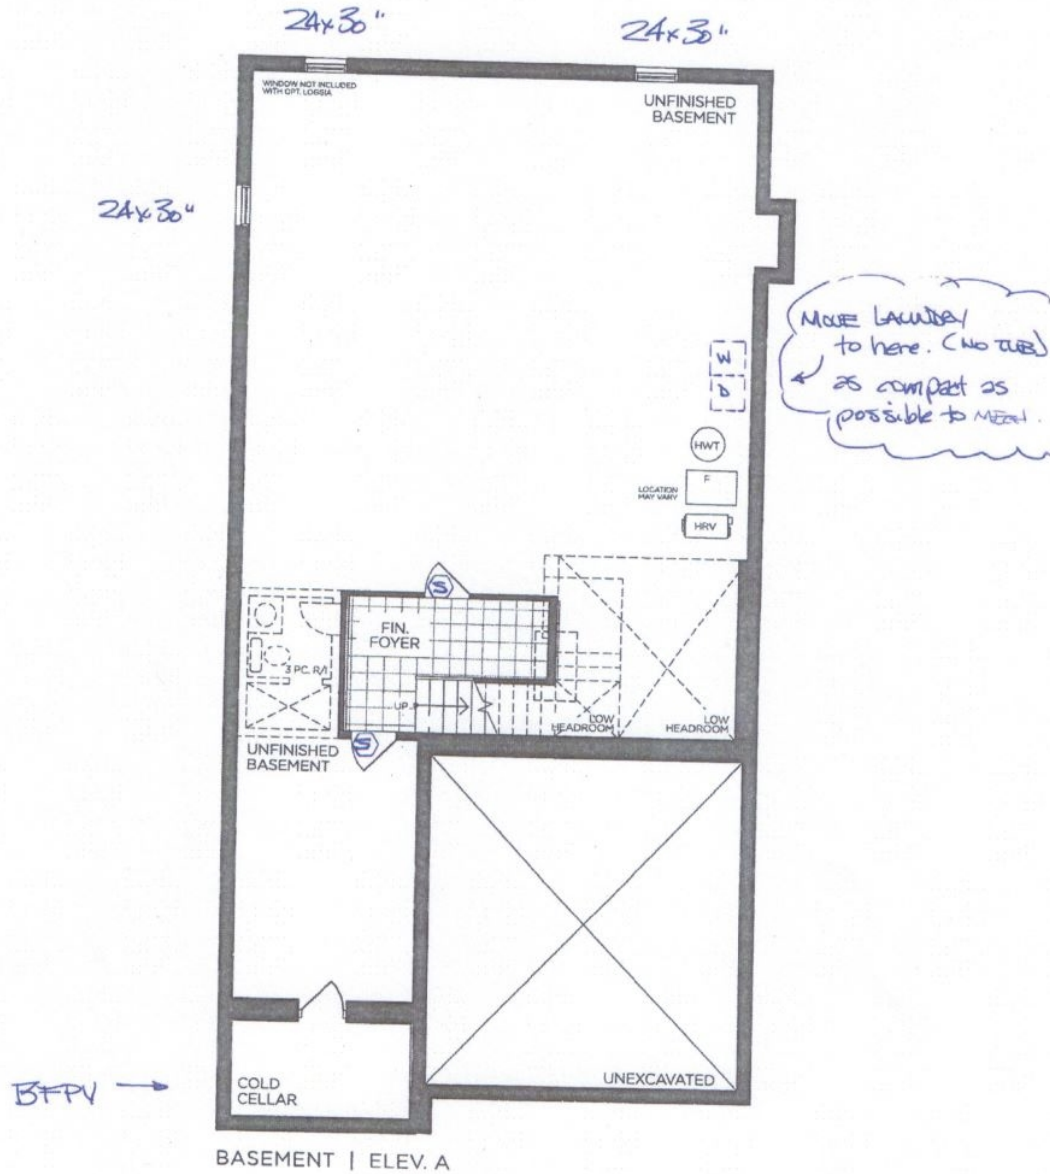

VENDOR
PURCHASER
PURCHASER

GOLDPARK
WORTH MORE™


Prices, figures, illustrations, sizes, features and finishes are subject to change without notice. Areas and dimensions are approximate and actual usable floor space may vary from the stated area. Layout may be reverse of the unit purchased. E. & O.E. 4003

SCHEDULE 'F'



PV-153
July 17 2020

The
Brookside
40' SERIES
Elevation A • 3,380 sq.ft.
→ Elevation B • 3,350 sq.ft.

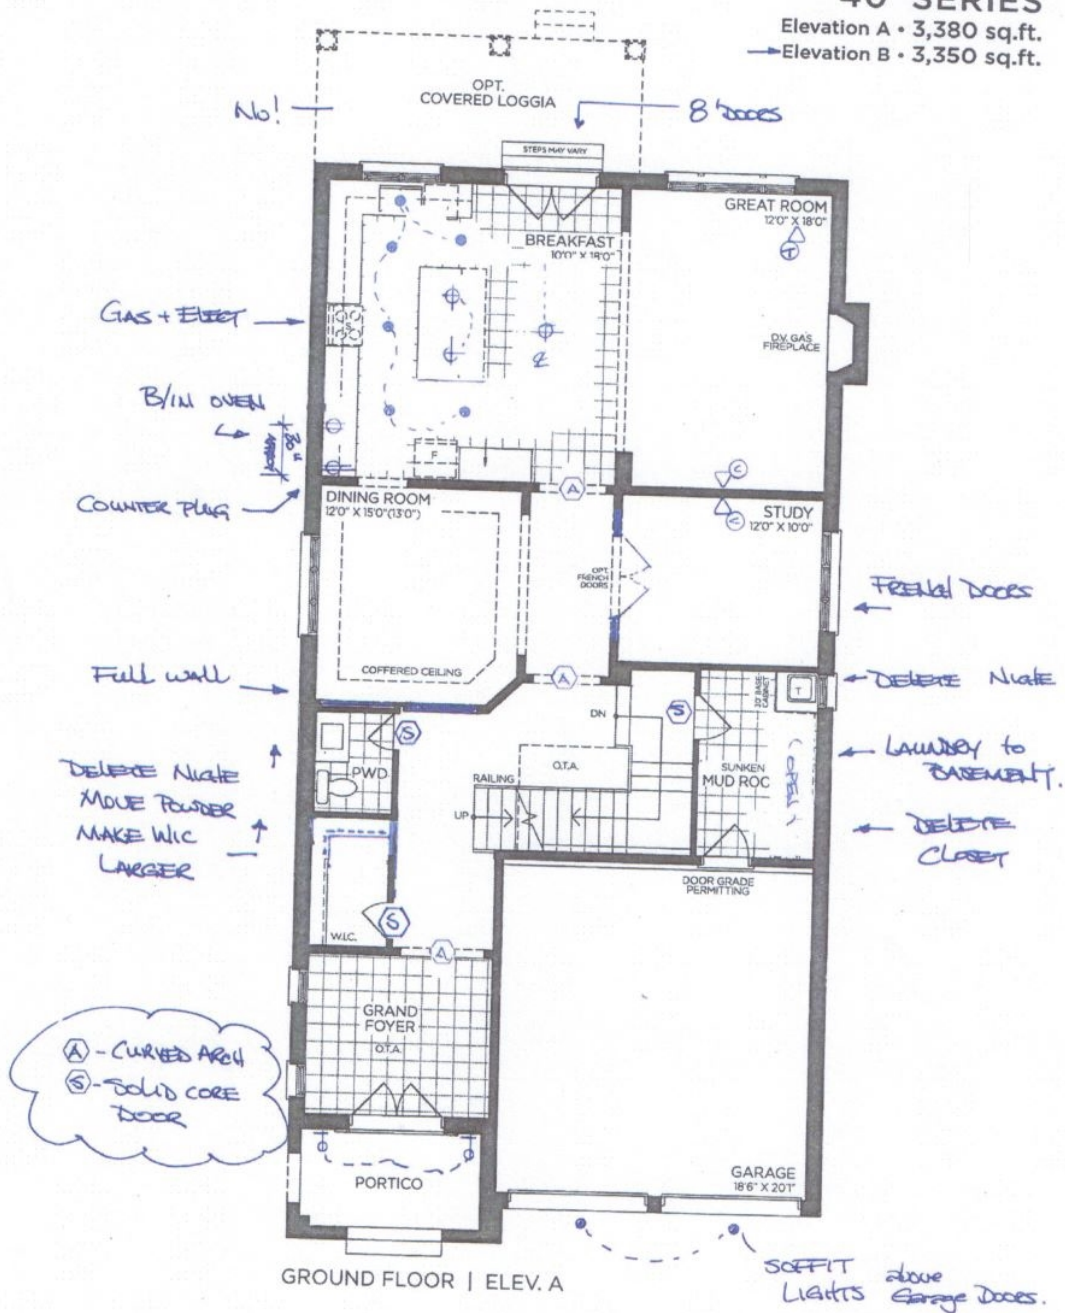

VENDOR
PURCHASER
PURCHASER

GOLDPARK
WORTH MORE

Prices, figures, illustrations, sizes, features and finishes are subject to change without notice. Areas and dimensions are approximate and actual usable floor space may vary from the stated area. Layout may be reverse of the unit purchased. E. & O.E. 4003

SCHEDULE 'F'



TV-153


July 17 2020

The Brookside

40' SERIES

Elevation A • 3,380 sq.ft.

→ Elevation B • 3,350 sq.ft.

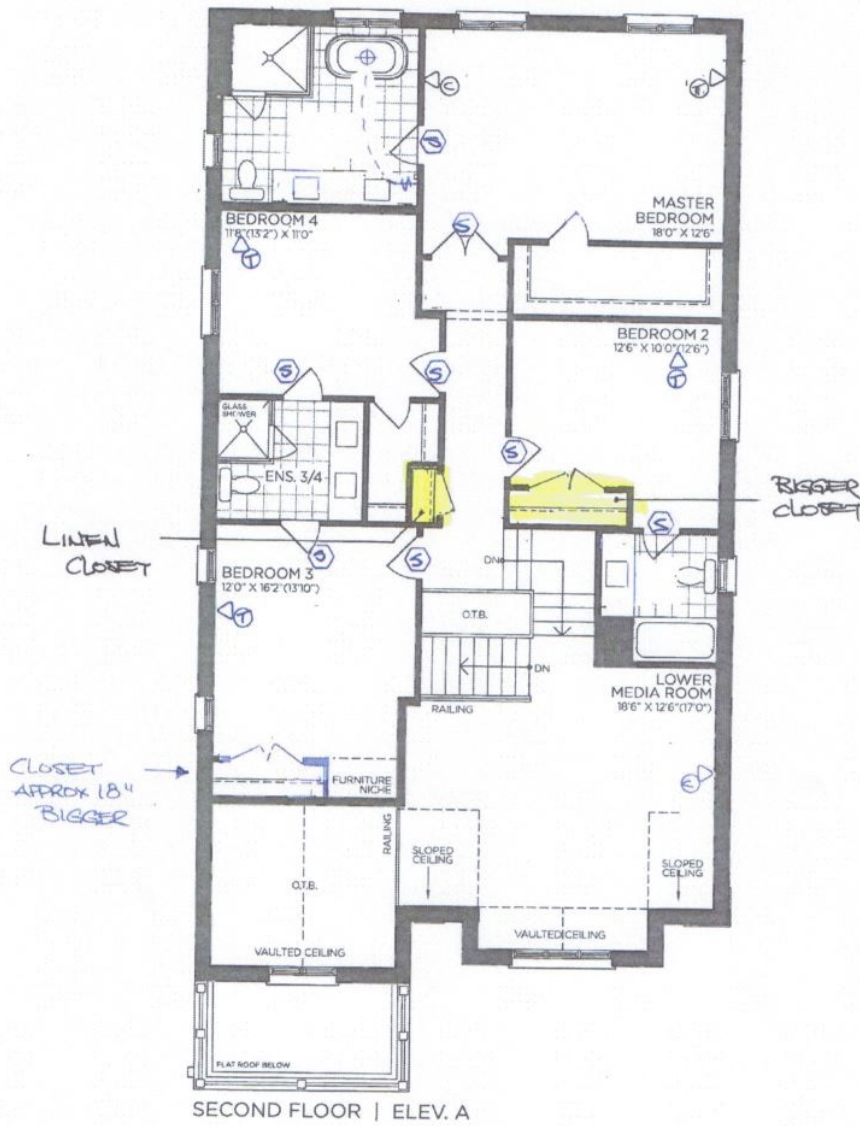

VENDOR

PURCHASER

PURCHASER

GOLDPARK
WORTH MORE™

Prices, figures, illustrations, sizes, features and finishes are subject to change without notice. Areas and dimensions are approximate and actual usable floor space may vary from the stated area. Layout may be reverse of the unit purchased. E. & O.E. 4003

SCHEDULE 'F'



PV-153

July 17 2020




The Brookside 40' SERIES


Elevation A • 3,380 sq.ft.

Elevation B • 3,350 sq.ft.


BIGGER
CLOSET

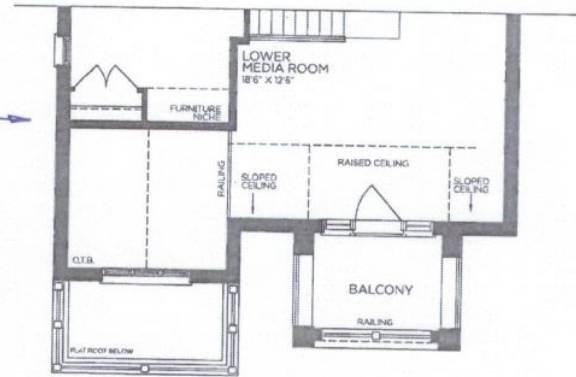


→ PART. SECOND FLOOR | ELEV. B

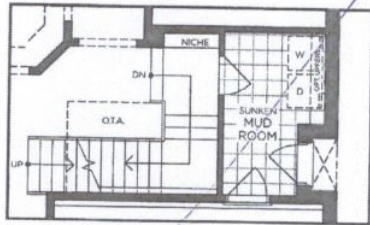

PART. OPT. GROUND FLOOR
W/ OPT. SIDE ENTRANCE | ELEV. A
(ELEV. B SIMILAR)

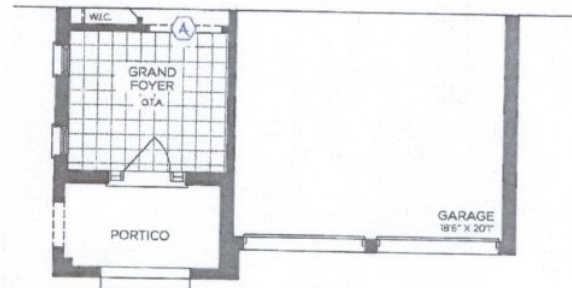

→ PART. GROUND FLOOR | ELEV. B

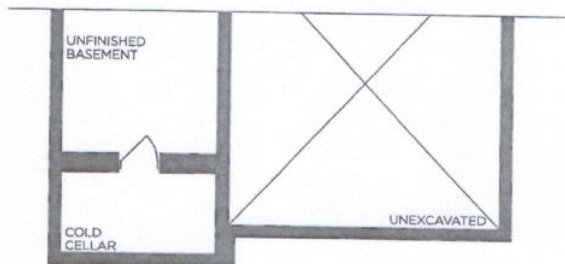

→ PART. BASEMENT | ELEV. B

VENDOR
PURCHASER
PURCHASER

GOLDPARK
WORTH MORE™

Prices, figures, illustrations, sizes, features and finishes are subject to change without notice. Areas and dimensions are approximate and actual usable floor space may vary from the stated area. Layout may be reverse of the unit purchased. E. & O.E. 4003