

BASEMENT WINDOWS

Invoice	Qty.	Description
2388 72,675 25Aug20	1	**REVISED QTY** AUG 25 2020 : ** BASEMENT WINDOWS - UPGRADE BASEMENT WINDOW SIZE TO 30 " X 24" - 10" FRAME (PINEVALLEY 50 FOOT LOTS ONLY) - **REAR IS LOB**

CERAMIC

Invoice	Qty.	Description
2264 25Aug20 NoCat	2	.MASTER ENSUITE: SHOWER NICHE [SHAMPOO SHELF] - COMPLETE WITH MATCHING MARBLE JAMBS ON 4 SIDES, STANDARD TILE, APPROX. 12 X 18 INSTALLED VERTICALLY

CONCRETE AND DRAIN

Invoice	Qty.	Description
2264 25Aug20 NoCat	1	.BACK-FLOW PREVENTER VALVE

CROWN MOULDING

Invoice	Qty.	Description
2264 25Aug20 NoCat	1	.**GREAT ROOM: OPT COFFERED CEILING AS PER PLAN
2264 25Aug20 NoCat	1	.**GREAT ROOM: OPTIONAL WAFFLE CEILING (4 BOX) AS PER PLAN CTR-B07
2264 25Aug20 NoCat	1	.MASTER BEDROOM - OPT. 10 FOOT TRAY CEILING - AS PER PLAN

DRYWALL

Invoice	Qty.	Description
2264 25Aug20 NoCat	1	.**GREAT ROOM: OPT COFFERED CEILING AS PER PLAN
2264 25Aug20 NoCat	1	.**GREAT ROOM: OPTIONAL WAFFLE CEILING (4 BOX) AS PER PLAN CTR-B07
2264 25Aug20 NoCat	1	.MASTER BEDROOM - OPT. 10 FOOT TRAY CEILING - AS PER PLAN
2264 25Aug20 NoCat	19	.2ND FLOOR: INCREASE HEIGHT OF DOOR TO 8FT SECOND FLOOR - PER DOOR

ELECTRICAL

Invoice	Qty.	Description
2264 72,281 25Aug20	1	.GREAT ROOM: INTERIOR WALL OUTLET: ADDITIONAL 110V WALL INTERIOR RECEPTACLE ON EXISTING CIRCUIT FOR WALL MOUNTED TV - APPROX. 66" A.F.F. ABOVE FIREPLACE
2264 72,289 25Aug20	7	.MAIN HALL: 4" E/S LED INTERIOR POT LIGHT - GROUND FLOOR - EACH IN LIEU OF STANDARD CEILING LIGHTS - USE STD SWITCH
2264 72,289 25Aug20	2	.HALL AT POWDER ROOM: 4" E/S LED INTERIOR POT LIGHT - GROUND FLOOR - EACH IN LIEU OF STD CEILING LIGHTS - USE STD SWITCH INCLUDED IN APS
2264 72,289 25Aug20	4	.DINING ROOM: 4" E/S LED INTERIOR POT LIGHT - GROUND FLOOR - EACH
2264 72,278 25Aug20	1	.DINING ROOM: ADDITIONAL INTERIOR SWITCH FOR POTLIGHTS
2264 72,309 25Aug20	1	.GREAT ROOM: UPGRADE STANDARD CEILING MOUNT FIXTURE TO (1) LED POT LIGHT - GROUND FLOOR - SEE PLAN FOR LOCATION
2264 72,289 25Aug20	7	.GREAT ROOM: 4" E/S LED INTERIOR POT LIGHT - GROUND FLOOR - EACH USE SAME SWITCH AS STANDARD
2264 72,289 25Aug20	4	.BREAKFAST ROOM: 4" E/S LED INTERIOR POT LIGHT - GROUND FLOOR - EACH - INCLUDES 1 SWITCH INCLUDED IN APS
2264 72,307 25Aug20	1	.KITCHEN: FIXTURE: RELOCATE STANDARD CEILING MOUNT FIXTURE - ABOVE ISLAND
2264 72,280 25Aug20	1	.KITCHEN: CEILING OUTLET: ADDITIONAL REINFORCED CEILING OUTLET - LOCATE ABOVE ISLAND, USE SAME SWITCH AS STANDARD
2264 72,303 25Aug20	1	.KITCHEN: FIXTURE: UNDER CABINET FLUORESCENT LIGHT FIXTURES - DOES NOT INCLUDE (AND REQUIRES) LIGHT VALANCE
2264 72,289 25Aug20	7	.KITCHEN: 4" E/S LED INTERIOR POT LIGHT - GROUND FLOOR - EACH
2264 72,278 25Aug20	1	.KITCHEN: ADDITIONAL INTERIOR SWITCH FOR POTLIGHTS

ELECTRICAL

Invoice	Qty.	Description
2264 72,273 25Aug20	1	.KITCHEN: 110V WALL RECEPTACLE ON SEPARATE CIRCUIT - GAS FIRED APPLIANCE - FOR AUX. EQUIPMENT - NOT A STOVE PLUG
2264 72,310 25Aug20	2	.UPPER HALL: UPGRADE STANDARD CEILING MOUNT FIXTURE TO (1) LED POT LIGHT - SECOND FLOOR - SEE PLAN FOR LOCATION
2264 72,290 25Aug20	4	.UPPER HALL: 4" E/S LED INTERIOR POT LIGHT (INSULATED CEILING) - SECOND FLOOR - EACH
2264 72,279 25Aug20	1	.MASTER ENSUITE: SHOWER POT LIGHT: 6" RECESSED SHOWER POT LIGHT - USE SAME SWITCH AS STANDARD

EXTERIOR COLOURS

Invoice	Qty.	Description
2264 25Aug20 NoCat	1	EXTERIOR COLOUR PKG: BR# 4

FORMING

Invoice	Qty.	Description
2264 25Aug20 NoCat	1	**REVISED QTY** AUG 25 2020 : **BASEMENT WINDOWS - UPGRADE BASEMENT WINDOW SIZE TO 30 " X 24" - 10" FRAME (PINEVALLEY 50 FOOT LOTS ONLY) - **REAR IS LOB**
2264 25Aug20 NoCat	1	.BREAKFAST ROOM: UPGRADE EXTERIOR GARDEN DOOR ASSEMBLY TO 96" TALL

FRAMING

Invoice	Qty.	Description
2264 72,675 25Aug20	1	**REVISED QTY** AUG 25 2020 : ** BASEMENT WINDOWS - UPGRADE BASEMENT WINDOW SIZE TO 30 " X 24" - 10" FRAME (PINEVALLEY 50 FOOT LOTS ONLY) - **REAR IS LOB**
2264 25Aug20 NoCat	1	.**GREAT ROOM: OPT COFFERED CEILING AS PER PLAN
2264 25Aug20 NoCat	1	.**GREAT ROOM: OPTIONAL WAFFLE CEILING (4 BOX) AS PER PLAN CTR-B07
2264 25Aug20 NoCat	1	.BREAKFAST ROOM: UPGRADE EXTERIOR GARDEN DOOR ASSEMBLY TO 96" TALL
2264 72,523 25Aug20	1	.MASTER BEDROOM - OPT. 10 FOOT TRAY CEILING - AS PER PLAN
2264 72,631 25Aug20	2	.MASTER ENSUITE: SHOWER NICHE [SHAMPOO SHELF] - COMPLETE WITH MATCHING MARBLE JAMBS ON 4 SIDES, STANDARD TILE, APPROX. 12 X 18 INSTALLED VERTICALLY
2264 72,644 25Aug20	19	.2ND FLOOR: INCREASE HEIGHT OF DOOR TO 8FT SECOND FLOOR - PER DOOR

HVAC

Invoice	Qty.	Description
2264 72,224 25Aug20	1	.KITCHEN: GAS LINE ROUGH-IN - MAIN FLOOR FOR APPLIANCE - SEE PLAN

INTERIOR TRIM AND DOORS

Invoice	Qty.	Description
2264 25Aug20 NoCat	1	.**GREAT ROOM: OPT COFFERED CEILING AS PER PLAN
2264 25Aug20 NoCat	1	.**GREAT ROOM: OPTIONAL WAFFLE CEILING (4 BOX) AS PER PLAN CTR-B07
2264 25Aug20 NoCat	1	.MASTER BEDROOM - OPT. 10 FOOT TRAY CEILING - AS PER PLAN
2264 25Aug20 NoCat	19	.2ND FLOOR: INCREASE HEIGHT OF DOOR TO 8FT SECOND FLOOR - PER DOOR

KITCHEN AND BATH CABINETRY

Invoice	Qty.	Description
2264 25Aug20 NoCat	1	KITCHEN: ROUGH-IN FOR KITCHEN POT FILLER (FIXTURE NOT INCLUDED)

NETWORK AND WIRING

Invoice	Qty.	Description
2264 72,259 25Aug20	1	.GREAT ROOM: CONDUIT PIPE - FOR WALL MOUNT TV - LOCATE APPROX 66" A.F.F. ABOVE FIREPLACE, THRU BASEMENT TERMINATING AT CABLE LOCATION

PAINT

Invoice	Qty.	Description
2264 25Aug20 NoCat	1	.**GREAT ROOM: OPT COFFERED CEILING AS PER PLAN
2264 25Aug20 NoCat	1	.**GREAT ROOM: OPTIONAL WAFFLE CEILING (4 BOX) AS PER PLAN CTR-B07
2264 25Aug20 NoCat	1	.MASTER BEDROOM - OPT. 10 FOOT TRAY CEILING - AS PER PLAN
2264 25Aug20 NoCat	19	.2ND FLOOR: INCREASE HEIGHT OF DOOR TO 8FT SECOND FLOOR - PER DOOR

PLUMBING

Invoice	Qty.	Description
2264 72,346 25Aug20	1	KITCHEN: ROUGH-IN FOR KITCHEN POT FILLER (FIXTURE NOT INCLUDED)
2264 25Aug20 NoCat	1	MASTER ENSUITE: MOEN `ARRIS` POSI-TEMP 3-FUNCTION RAIN SHOWER (from ceiling) + HAND SHOWER + SLIDE BAR - CHROME #TS22002EP/3372/TS23005/62320/3887EP/A725
2264 25Aug20 NoCat	1	.BACK-FLOW PREVENTER VALVE

WINDOWS AND DOORS


Invoice	Qty.	Description
2264 25Aug20 NoCat	1	.BREAKFAST ROOM: UPGRADE EXTERIOR GARDEN DOOR ASSEMBLY TO 96" TALL

SCHEDULE 'F'



PV-112.
 JUNE 13 2020
 JULY 10 2020

Lot 112
50' SERIES
 Elevation A • 3,225 sq.ft.

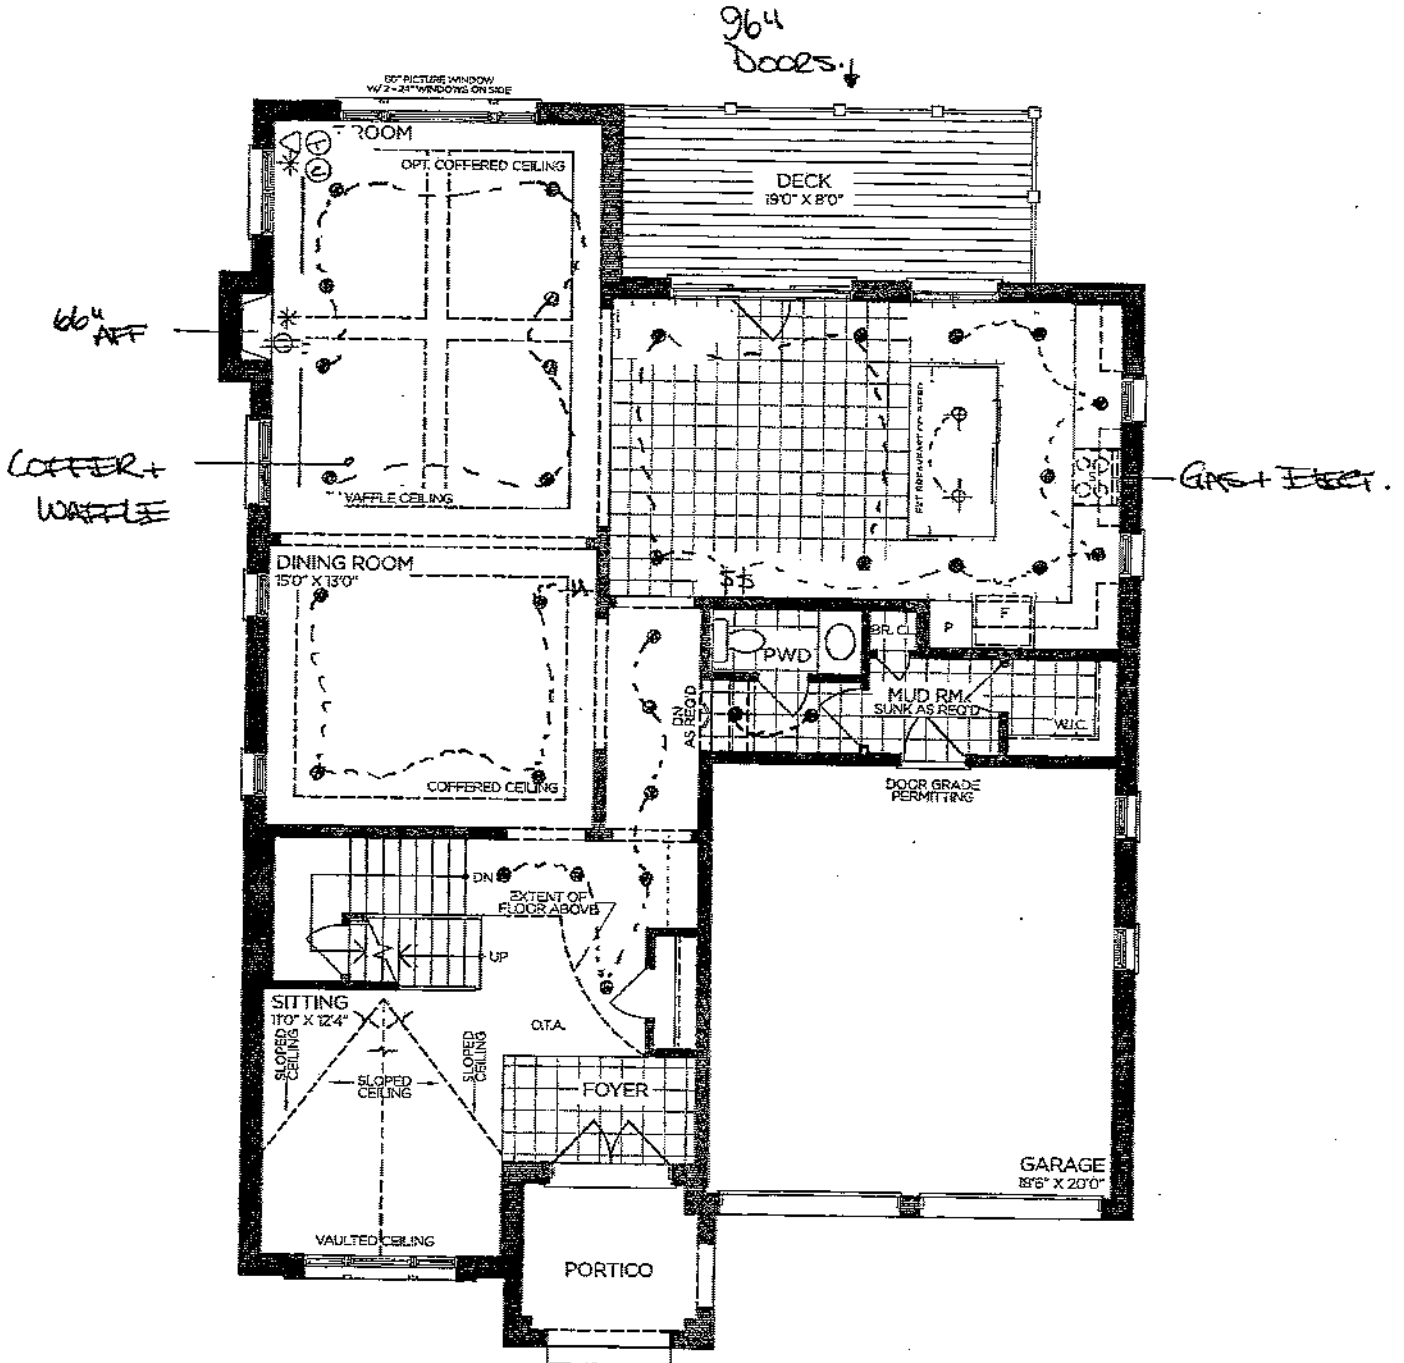

GROUND FLOOR | ELEV. A

VENDOR

PURCHASER

PURCHASER

GOLDPARK
 WORTH MORE™

Prices, figures, illustrations, sizes, features and finishes are subject to change without notice. Areas and dimensions are approximate and actual usable floor space may vary from the stated area. Layout may be reverse of the unit purchased. E & O.E. 5001

SCHEDULE 'F'




PV-112.
 June 13 2020
 July 10 2020

Lot 112
50' SERIES

Elevation A • 3,225 sq.ft.

8' Joists
 on 2nd Floor

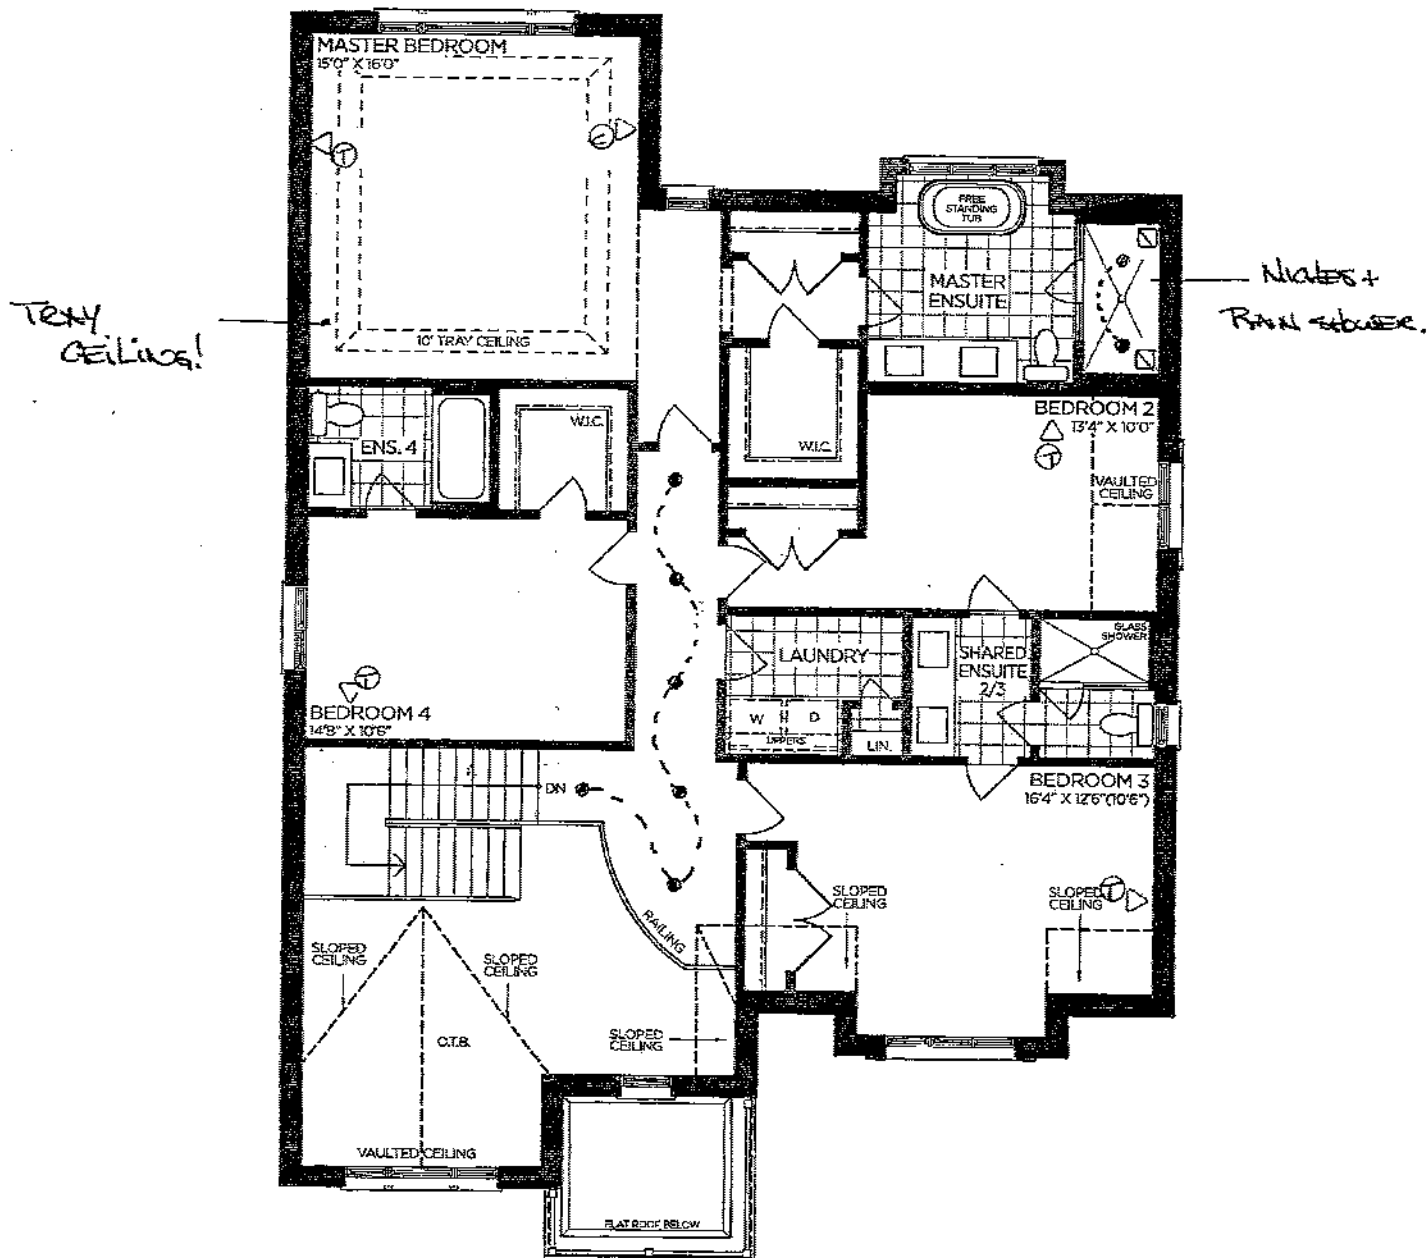

SECOND FLOOR | ELEV. A

VENDOR

PURCHASER

PURCHASER

GOLDPARK
 WORTH MORE™


Prices, figures, illustrations, sizes, features and finishes are subject to change without notice. Areas and dimensions are approximate and actual usable floor space may vary from the stated area. Layout may be reverse of the unit purchased. E. & O.E. 5001

SCHEDULE 'F'



PV-112
 JUNE 13 2020
 July 10 2020

Lot 112
50' SERIES
 Elevation A • 3,225 sq.ft.

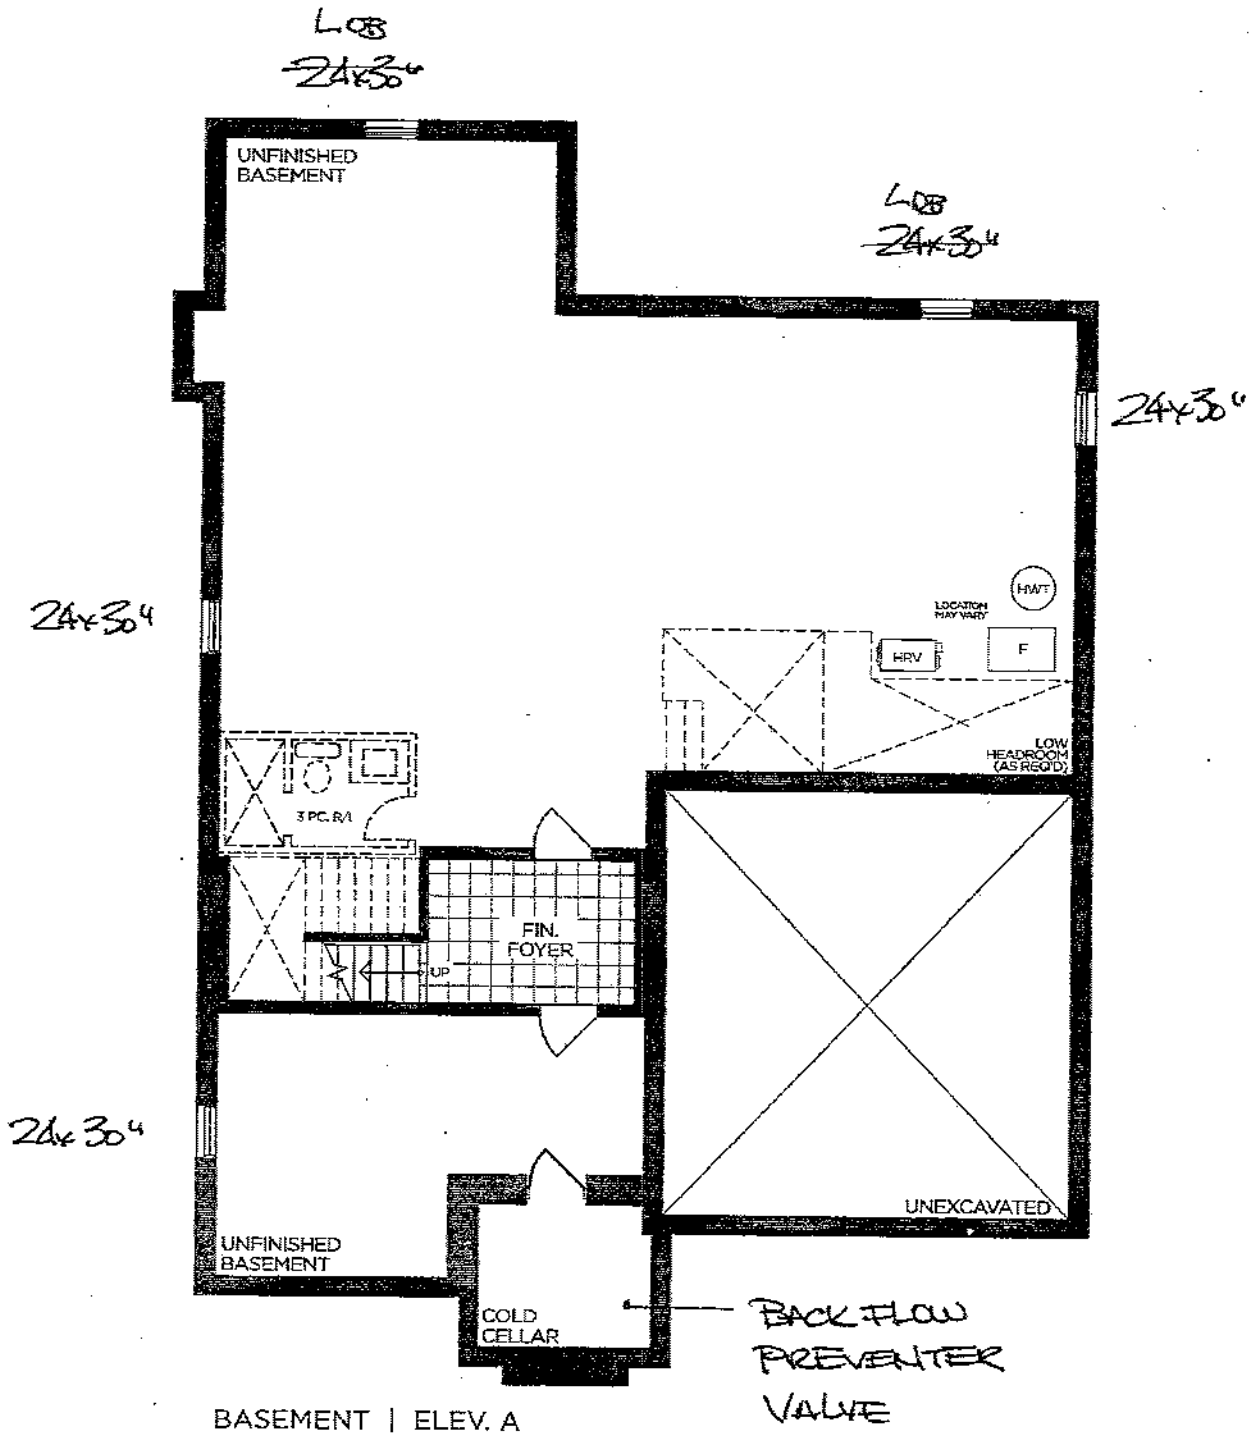

VENDOR

PURCHASER

PURCHASER

GOLDPARK
 WORTH MORE™

Prices, figures, illustrations, sizes, features and finishes are subject to change without notice. Areas and dimensions are approximate and actual usable floor space may vary from the stated area. Layout may be reverse of the unit purchased. E. & O.E. 5001

**POSI-TEMP SHOWER ONLY* W/3 FUNCTION TRANSFER VALVE
TRIM AND SLIDE BAR W/HAND SHOWER**

MOEN - ARRIS



CHROME

BRUSHED NICKEL

MATTE BLACK

from WALL

from CEILING

MODEL TS22002EP / 3372 / TS23005 / 62320 / 3887EP / A725

Lot#
112

Room:
MASTER ENSUITE

Signature:

Date:
JUNE 13 2020

Signature: