

DRYWALL		
Invoice	Qty.	Description
2347 07Aug20 NoCat	1	.**CUSTOM LAYOUT** ENSUITE 3/4: REMOVE WALL AND DOOR SEPARATING VANITY/WATER CLOSET - LEAVE 1 OPEN SPACE
2347 07Aug20 NoCat	1	.MASTER ENSUITE: ADD APPROX. 30" WIDE, FULL HEIGHT NIBB WALL AT END OF VANITY SEPARATING VANITY/TOILET
2347 07Aug20 NoCat	1	.**CUSTOM LAYOUT** REMOVE HEADER AND NIB WALL AT FOYER/MAIN HALL & MAIN HALL/KITCHEN
2347 07Aug20 NoCat	1	.**CUSTOM LAYOUT** REMOVE DOUBLE DOORS AT MASTER BEDROOM, INSTALL SINGLE LARGER DOOR - MOVE TOWARD FRONT OF HOUSE. REMOVE DOOR TO WIC, CREATE APPROX 42" OPENING - NO HEADER OR NIBB WALLS AT WIC - SEE PLAN FOR LOCATION
2347 07Aug20 NoCat	1	.BREAKFAST ROOM: UPGRADE GARDEN DOOR ASSEMBLY TO 8' HEIGHT [IN LIEU OF STANDARD DOOR ASSEMBLY WITH TRANSOM]
2347 07Aug20 NoCat	1	.**NOTE** INSTALL 32" X 96" DOOR FROM LAUNDRY TO HALLWAY
2347 07Aug20 NoCat	1	.FOYER CLOSET: INSTALL 32X96" DOUBLE DOORS AT CLOSET

ELECTRICAL		
Invoice	Qty.	Description
2347 72,289 07Aug20	6	.KITCHEN: 4" E/S LED INTERIOR POT LIGHT - GROUND FLOOR - EACH INCLUDES 1 SWITCH INCLUDED IN APS
2347 72,307 07Aug20	1	.KITCHEN: FIXTURE: RELOCATE STANDARD CEILING MOUNT FIXTURE - LOCATE ABOVE ISLAND - SEE PLAN FOR LOCATION
2347 72,667 07Aug20	1	.KITCHEN: ROUGH-IN FOR CAPPED CEILING OUTLET (FUTURE LIGHT FIXTURE) - EACH - USE SAME SWITCH AS STANDARD LIGHT - SEE PLAN FOR LOCATION
2347 72,280 07Aug20	1	.POWDER ROOM: CEILING OUTLET: ADDITIONAL REINFORCED CEILING OUTLET - LOCATE APPROX CENTER OF ROOM - IN LIEU OF STANDARD VANITY LIGHT
2408 72,292 25Aug20	1	REAR DOOR: ADDITIONAL EXTERIOR COACH LIGHT ON SAME SWITCH (BUILDERS STANDARD FIXTURE) - AT REAR **LOCATE OPPOSITE SIDE AS STANDARD. SAME HEIGHT AND SWITCH AS STANDARD**

**Lot: 142****Model: 40.02 A VALLEYVIEW****Project/Phase: Pine Valley Forevergreen / 1**

FRAMING

Invoice	Qty.	Description
2347 07Aug20 NoCat	1	.FOYER CLOSET: INSTALL 32X96" DOUBLE DOORS AT CLOSET
2347 07Aug20 NoCat	1	.MASTER ENSUITE: REPOSITION TUB TO BE CENTERED BELOW REAR WINDOW - SEE PLAN FOR LOCATION
2347 07Aug20 NoCat	1	.BREAKFAST ROOM: UPGRADE GARDEN DOOR ASSEMBLY TO 8' HEIGHT [IN LIEU OF STANDARD DOOR ASSEMBLY WITH TRANSOM]

GARAGE DOORS

Invoice	Qty.	Description
2267	1	***REVISED LAYOUT*** MOVE REAR GARAGE WALL APPROX 3' (SQUARE OFF REAR OF GARAGE) TO CREATE LARGER LAUNDRY ROOM. MOVE DOOR FROM GARAGE TO HOUSE CLOSER TO EXTERIOR WALL. SEE PLAN FOR LOCATION. [COMPLETE WITH STANDARD LEVEL FINISHES]
07Aug20 NoCat		



CONSTRUCTION SUMMARY

Lot: 142

Model: 40.02 A VALLEYVIEW

Project/Phase: Pine Valley Forevergreen / 1

PAINT

Invoice	Qty.	Description
2347 07Aug20 NoCat	1	.**CUSTOM LAYOUT** REVISE LAYOUT OF POWDER ROOM. INTERIOR OF POWDER ROOM TO BE APPROX. 4'X7'. REDUCE FOYER CLOSET TO ACCOMMODATE, INSTALL LARGER CLOSET DOORS - SEE ATTACHED SKETCH
2347 07Aug20 NoCat	1	.INCREASED HEIGHT TO MAN DOOR FROM HOUSE TO GARAGE (32X94") TALL HEIGHT - IF GRADE PERMITS (EACH)
2347 07Aug20 NoCat	1	***CUSTOM LAYOUT** DELETE CLOSET AT LAUNDRY
2347 07Aug20 NoCat	1	.**CUSTOM LAYOUT** ENSUITE 3/4: REMOVE WALL AND DOOR SEPARATING VANITY/WATER CLOSET - LEAVE 1 OPEN SPACE
2347 07Aug20 NoCat	1	.**CUSTOM LAYOUT** REMOVE HEADER AND NIB WALL AT FOYER/MAIN HALL & MAIN HALL/KITCHEN
2347 07Aug20 NoCat	1	.**CUSTOM LAYOUT** REMOVE DOUBLE DOORS AT MASTER BEDROOM, INSTALL SINGLE LARGER DOOR - MOVE TOWARD FRONT OF HOUSE. REMOVE DOOR TO WIC, CREATE APPROX 42" OPENING - NO HEADER OR NIBB WALLS AT WIC - SEE PLAN FOR LOCATION
2347 07Aug20 NoCat	1	.**NOTE** INSTALL 32" X 96" DOOR FROM LAUNDRY TO HALLWAY
2347 07Aug20 NoCat	1	.FOYER CLOSET: INSTALL 32X96" DOUBLE DOORS AT CLOSET



CONSTRUCTION SUMMARY

Lot: 142

Model: 40.02 A VALLEYVIEW

Project/Phase: Pine Valley Forevergreen / 1

PLUMBING		
Invoice	Qty.	Description
2267 07Aug20 NoCat	1	.***REVISED LAYOUT*** MOVE REAR GARAGE WALL APPROX 3` (SQUARE OFF REAR OF GARAGE) TO CREATE LARGER LAUNDRY ROOM. MOVE DOOR FROM GARAGE TO HOUSE CLOSER TO EXTERIOR WALL. SEE PLAN FOR LOCATION. [COMPLETE WITH STANDARD LEVEL FINISHES]
2347 07Aug20 NoCat	1	.MASTER ENSUITE: UPGRADE TO MOEN 90* RAIN SHOWER (from ceiling) + HAND SHOWER WITH SLIDE BAR `CHROME` #TS2712EP/3372/TS4172/62320/S3879EP/A721
2347 07Aug20 NoCat	1	.MASTER ENSUITE: REPOSITION TUB TO BE CENTERED BELOW REAR WINDOW - SEE PLAN FOR LOCATION
2347 72,346 07Aug20	1	.KITCHEN: ROUGH-IN FOR KITCHEN POT FILLER (FIXTURE NOT INCLUDED)
2347 07Aug20 NoCat	1	.**CUSTOM LAYOUT** ENSUITE 3/4: REMOVE WALL AND DOOR SEPARATING VANITY/WATER CLOSET - LEAVE 1 OPEN SPACE
2347 07Aug20 NoCat	1	.MASTER ENSUITE: ADD APPROX. 30" WIDE, FULL HEIGHT NIBB WALL AT END OF VANITY SEPARATING VANITY/TOILET

PLUMBING FIXTURES		
Invoice	Qty.	Description
2347 07Aug20 NoCat	1	.MASTER ENSUITE: UPGRADE TO MOEN 90* RAIN SHOWER (from ceiling) + HAND SHOWER WITH SLIDE BAR `CHROME` #TS2712EP/3372/TS4172/62320/S3879EP/A721
2347 07Aug20 NoCat	1	.MASTER ENSUITE: REPOSITION TUB TO BE CENTERED BELOW REAR WINDOW - SEE PLAN FOR LOCATION

WINDOWS - BASEMENT		
Invoice	Qty.	Description
2267 72,351 07Aug20	2	.BASEMENT WINDOWS - UPGRADE BASEMENT WINDOW SIZE TO 30 " X 24" - 8" FRAME
2305 72,672 07Aug20	2	.BASEMENT WINDOWS - EGRESS BASEMENT WINDOW 47 " X 35" - 8" FRAME- REAR ONLY REAR ONLY

WINDOWS AND DOORS		
Invoice	Qty.	Description
2347 07Aug20 NoCat	1	.BREAKFAST ROOM: UPGRADE GARDEN DOOR ASSEMBLY TO 8` HEIGHT [IN LIEU OF STANDARD DOOR ASSEMBLY WITH TRANSOM]

SCHEDULE 'F'



PV-142
April 3 2020

MAY 21 2020


July 2020

See attached.
See attach.

The Valleyview

40' SERIES

Elevation A • 3,145 sq.ft.
Elevation B • 3,170 sq.ft.

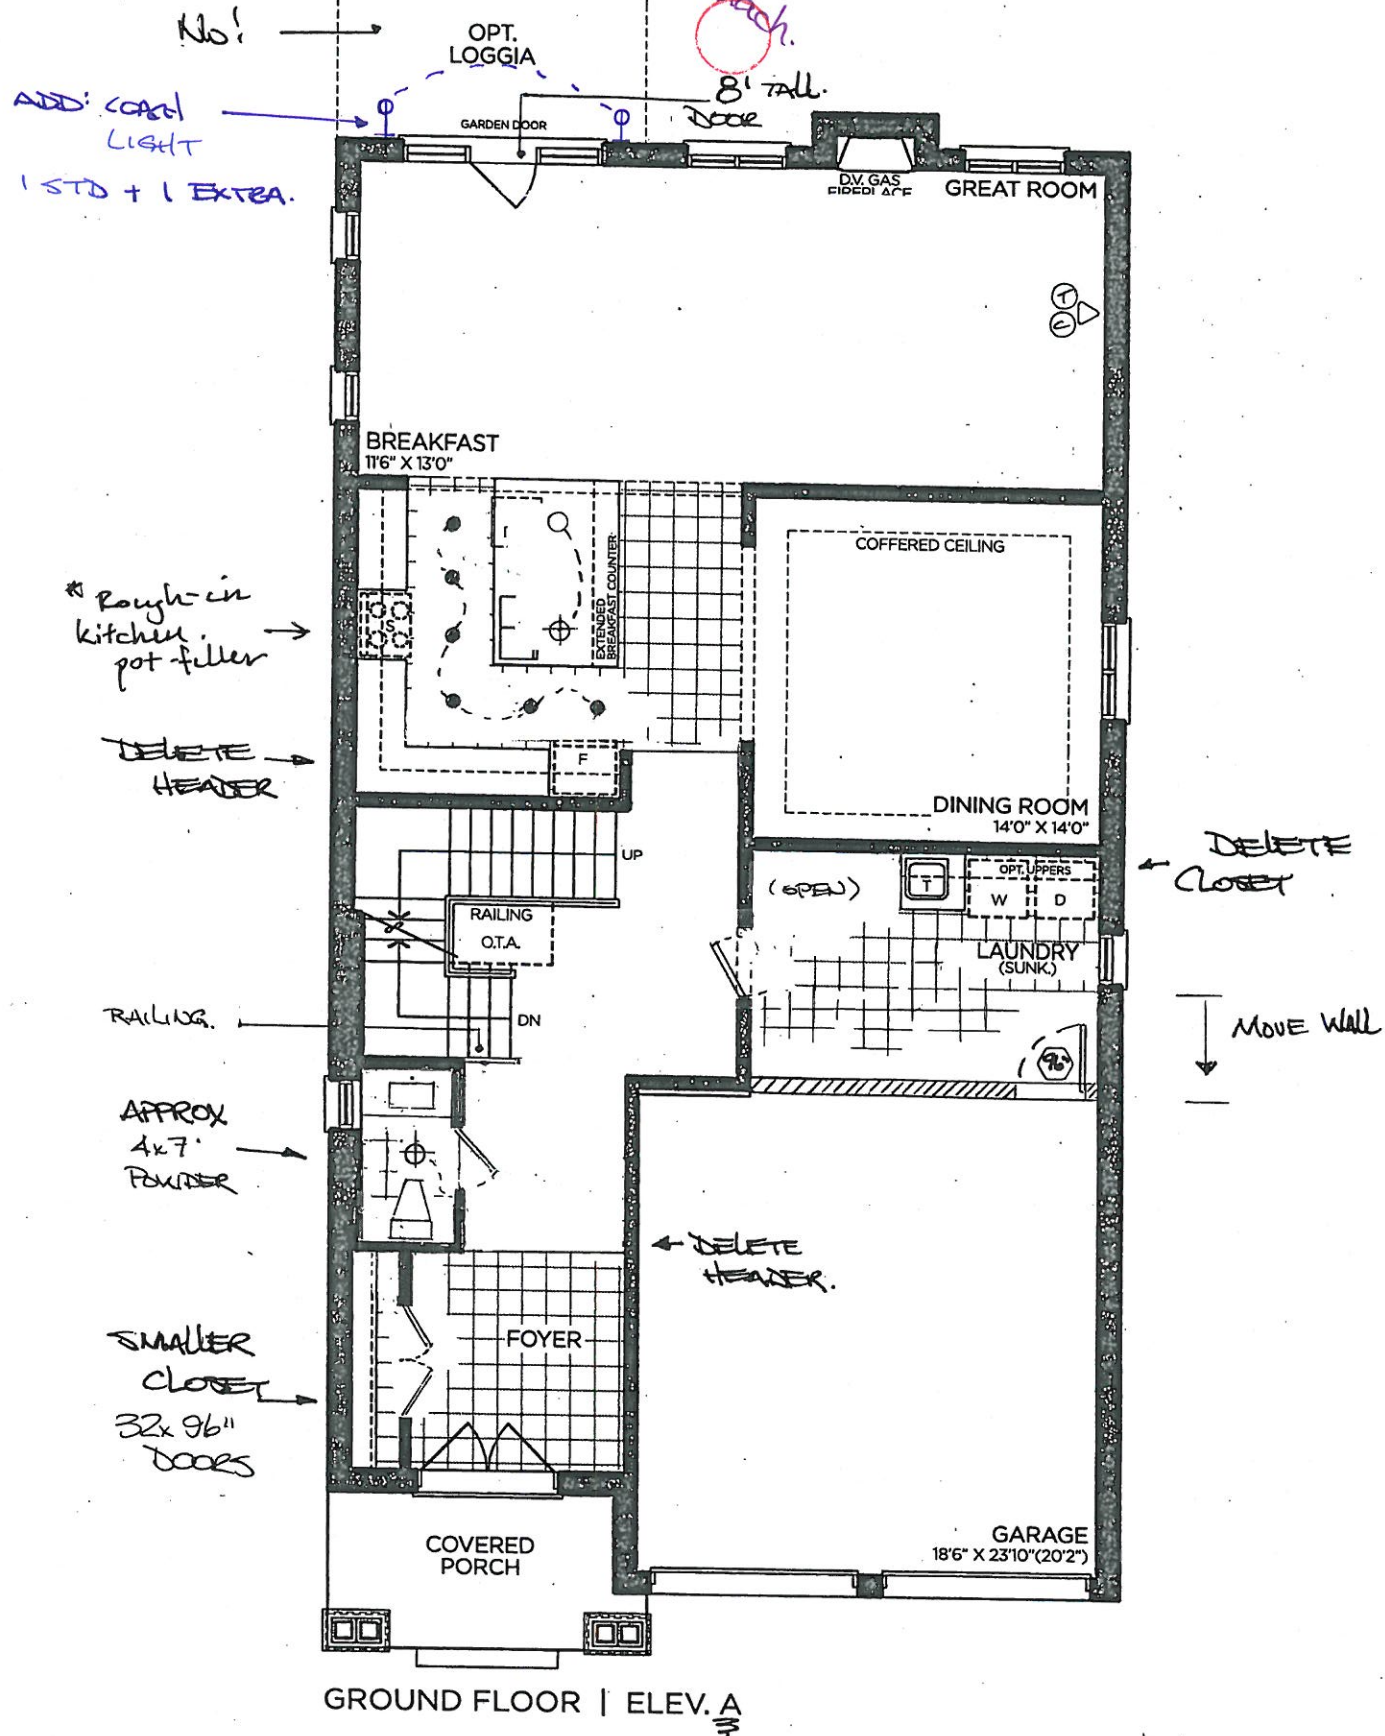

VENDOR

PURCHASER

PURCHASER

GOLDPARK
WORTH MORE™

Prices, figures, illustrations, sizes, features and finishes are subject to change without notice. Areas and dimensions are approximate and actual usable floor space may vary from the stated area. Layout may be reverse of the unit purchased. E. & O.E. 4002

SCHEDULE 'F'



PV-142

MAY 21 2020

JULY 20 2020

See attached.

See attach.


The Valleyview 40' SERIES

Elevation A • 3,145 sq.ft.
Elevation B • 3,170 sq.ft.

RANSHUR + shower niche

CENTER TUB BELOW window

W.I.C. → 42" OPENING
(NO HEADER)
(MOVE)
1 LARGER DOOR
to KIDRM. →

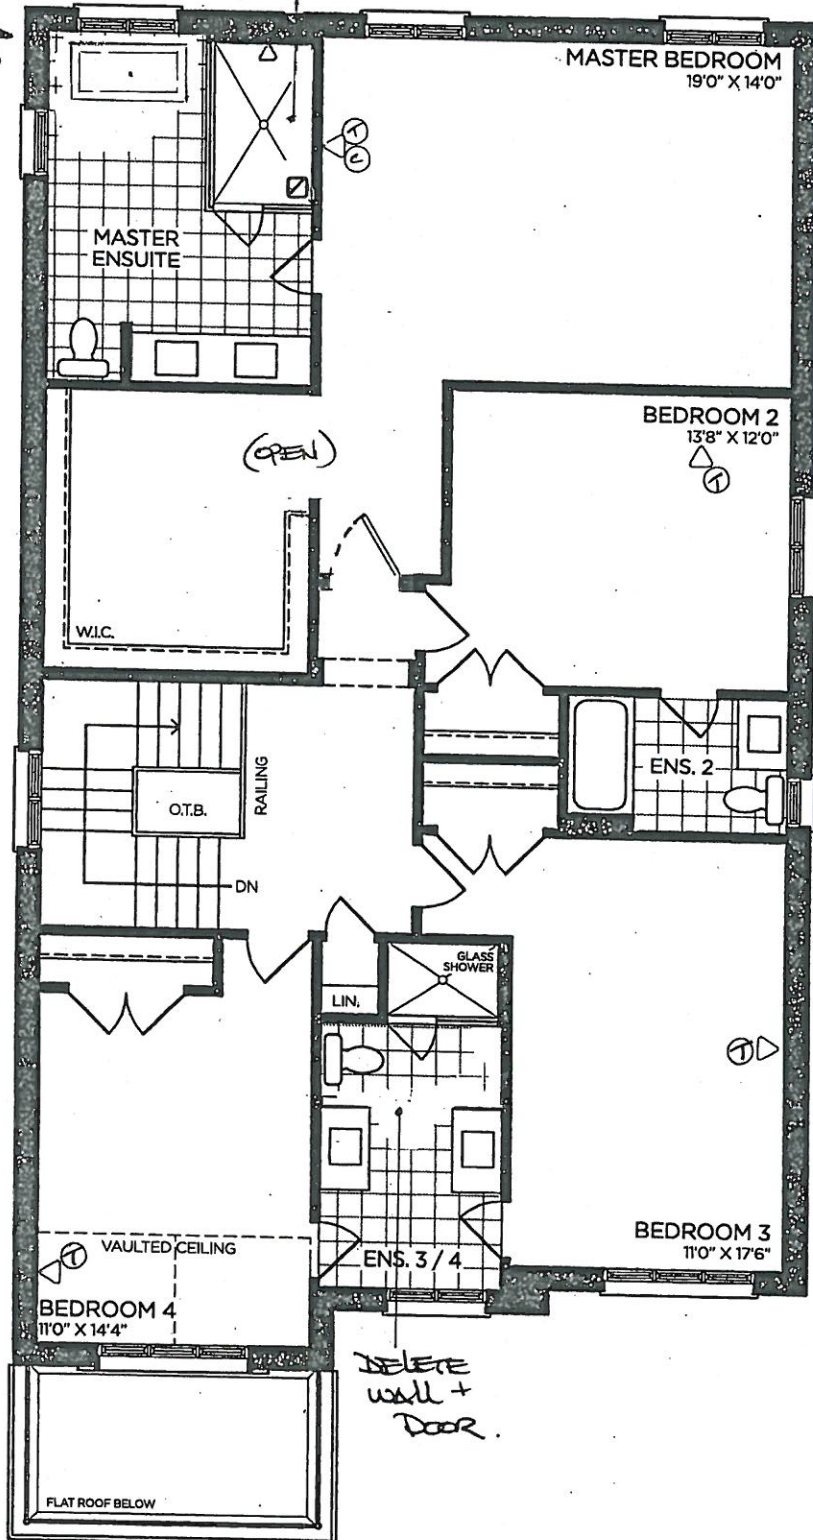

SECOND FLOOR | ELEV. A

VENDOR	
PURCHASER	
PURCHASER	

GOLDPARK
WORTH MORE™

Prices, figures, illustrations, sizes, features and finishes are subject to change without notice. Areas and dimensions are approximate and actual usable floor space may vary from the stated area. Layout may be reverse of the unit purchased. E. & O.E. 4002

SCHEDULE 'F'

The Valleyview
40' SERIES

→ Elevation A • 3,145 sq.ft.
Elevation B • 3,170 sq.ft.



PV-142.


MAY 21 2020

July 20 2020

See attached.

See attached.

9' CEILING

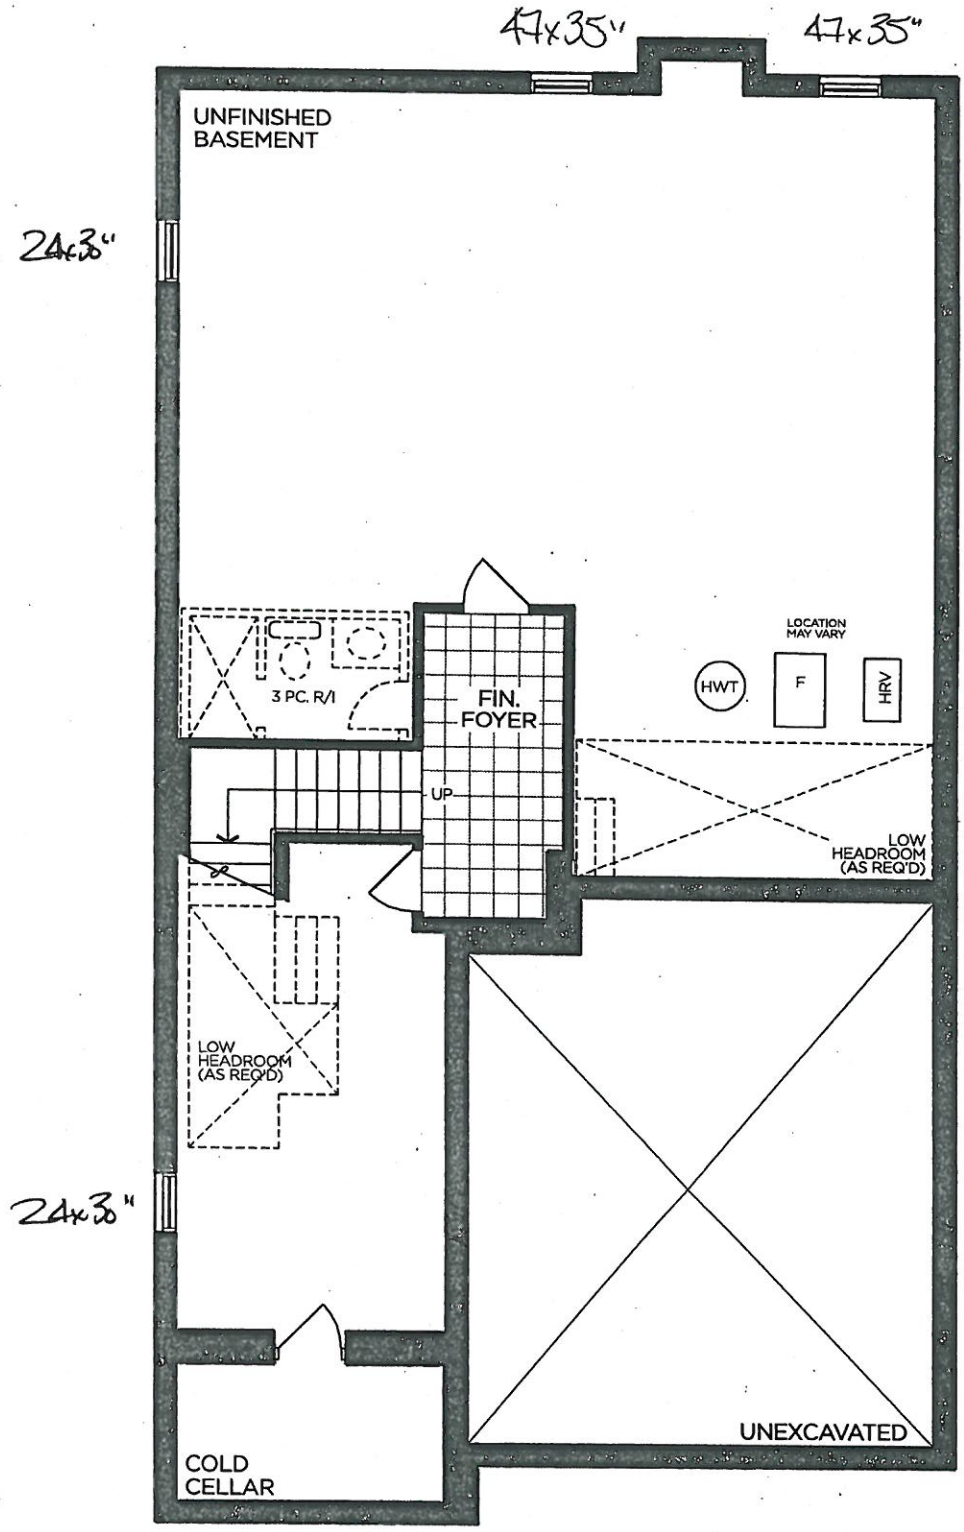

BASEMENT | ELEV. A

VENDOR

PURCHASER

PURCHASER

GOLDPARK
WORTH MORE™

Prices, figures, illustrations, sizes, features and finishes are subject to change without notice. Areas and dimensions are approximate and actual usable floor space may vary from the stated area. Layout may be reverse of the unit purchased. E. & O.E. 4002

SCHEDULE 'F'




PV-142
APRIL 3 2020
MAY 21 2020
July 2020

The Valleyview

40' SERIES

Elevation A - 3,145 sq.ft.
Elevation B - 3,170 sq.ft.

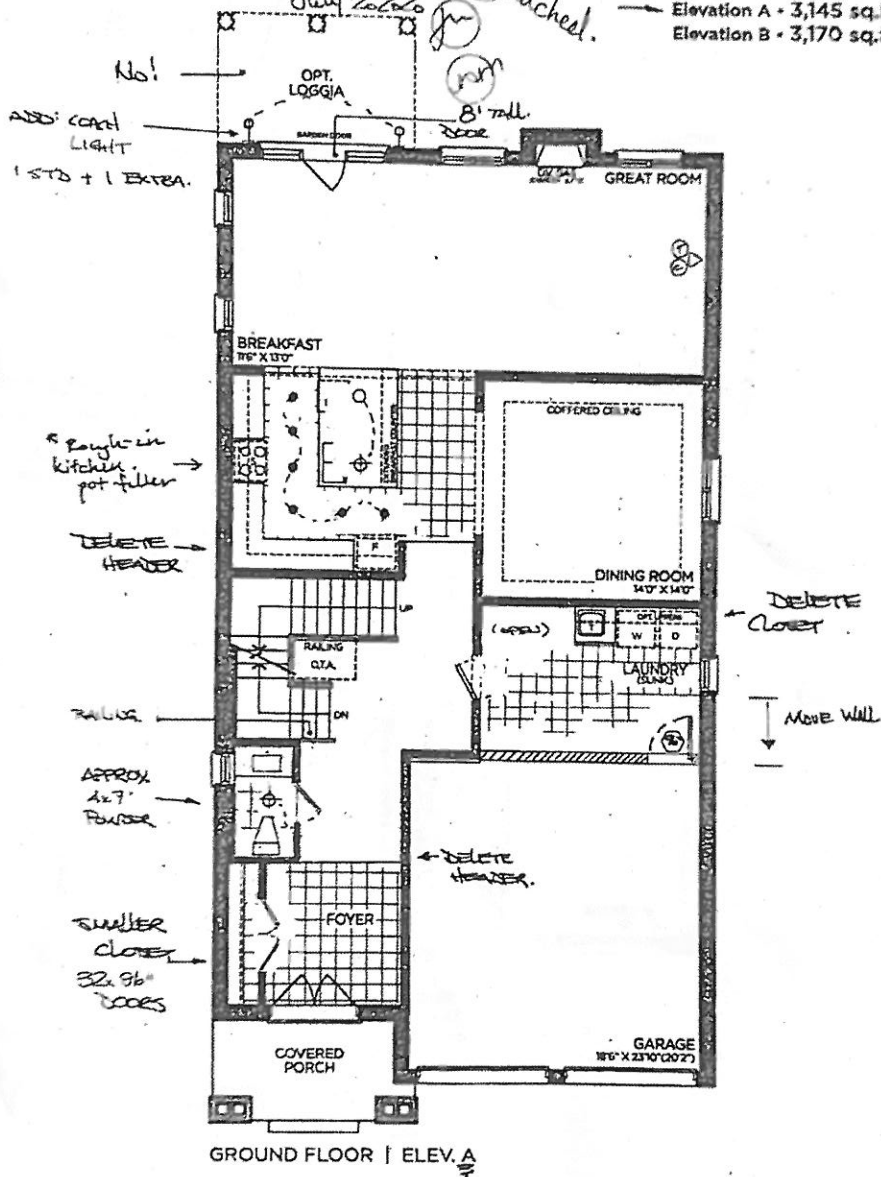

VENDOR

PURCHASER

PURCHASER

GOLDPARK
WORTH MORE™


Prices, figures, illustrations, sizes, features and finishes are subject to change without notice. Areas and dimensions are approximate and actual usable floor space may vary from the stated area. Layout may be reverse of the unit purchased. E. & D.E. 4002

SCHEDULE 'F'



PV-142
May 21 2020
July 2 2020

The Valleyview
40' SERIES
Elevation A • 3,145 sq.ft.
Elevation B • 3,170 sq.ft.

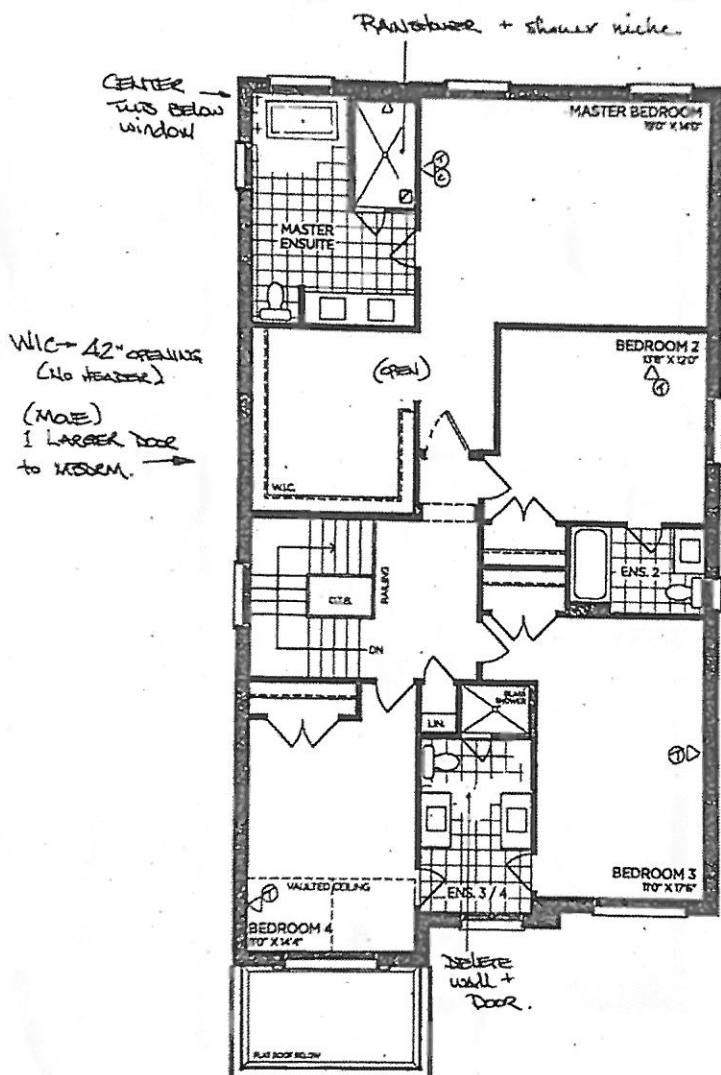

SECOND FLOOR | ELEV. A

VENDOR

PURCHASER

PURCHASER

GOLDPARK
WORTH MORE

Prices, figures, illustrations, sizes, features and finishes are subject to change without notice. Area and dimensions are approximate and actual usable floor space may vary from the stated area. Layout may be reverse of the unit purchased. E & O.E. 4002

SCHEDULE 'F'



PV-1A2.

MAY 21 2020

July 20 2020

The Valleyview 40' SERIES

Elevation A • 3,145 sq.ft.
Elevation B • 3,170 sq.ft.


47x35"

47x35"

9' CEILING

24x3"

24x3"

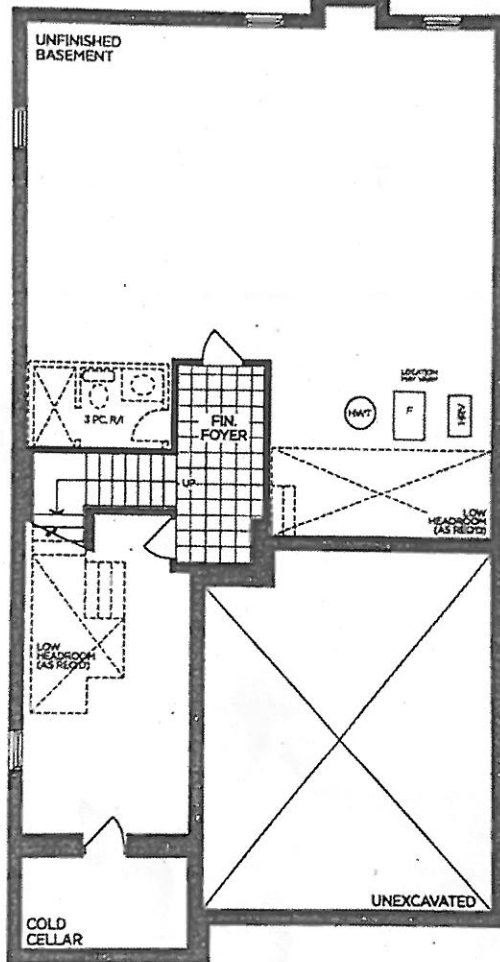

BASEMENT | ELEV. A

VENDOR
PURCHASER
PURCHASER

GOLDPARK
WORTH MORE™

Prices, figures, illustrations, sizes, features and finishes are subject to change without notice. Areas and dimensions are approximate and actual usable floor space may vary from the stated area. Layout may be reverse of the unit purchased. E. & O.E. 4002