

SCHEDULE 'F'




The Valleyview
40' SERIES

Elevation A • 3,145 sq.ft.
Elevation B • 3,170 sq.ft.

PV-120
March 17 2020
June 4 2020
June 19 2020
Aug 21 2020
Look out 30x48"
See attached
See attached
See attached
See attached

36x48"

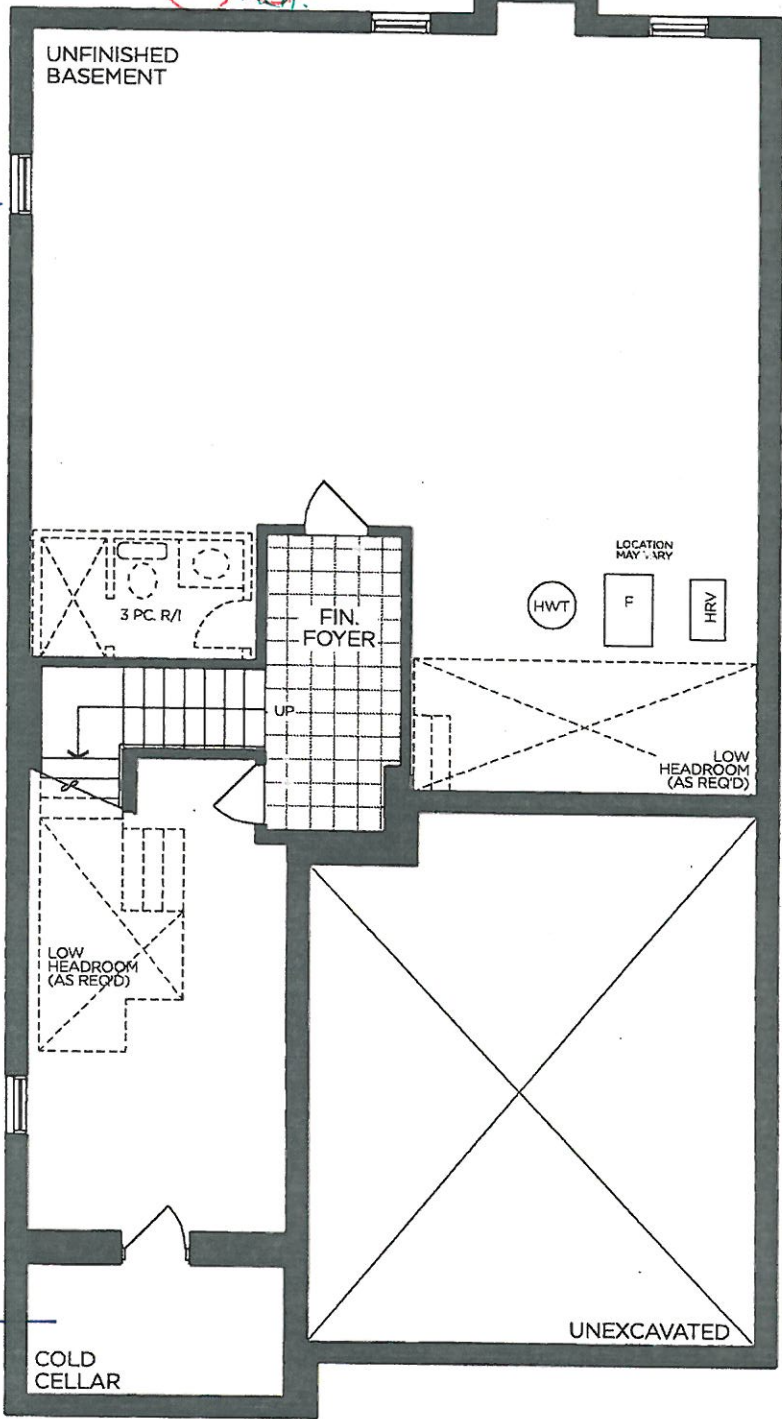

STD 16x30"

Backflow Preventer Valve

BASEMENT | ELEV. A

VENDOR
PURCHASER
PURCHASER

GOLDPARK
WORTH MORE™

Prices, figures, illustrations, sizes, features and finishes are subject to change without notice. Areas and dimensions are approximate and actual usable floor space may vary from the stated area. Layout may be reverse of the unit purchased. E. & O.E. 4002

SCHEDULE 'F'



JUNE 19 2020

PV-120

MAILED 17 2020

JUNE 4 2020

The Valleyview 40' SERIES

Elevation A • 3,145 sq.ft.

Elevation B • 3,170 sq.ft.

REVISED LAYOUT

AUG 21 2020

No!

OPT. LOGGIA

GARDEN DOOR

DM GAS FIREPLACE

GREAT ROOM
18'6" X 13'0"

Black
INTERIOR
Windows

BREAKFAST
11'6" X 13'0"

COFFERED CEILING

DINING ROOM
14'0" X 14'0"

LAUNDRY
(SUNK)

DOOR GRADE
PERMITTING

SERVICE
STAIRS.

PWD

FOYER

COVERED
PORCH

GARAGE
18'6" X 23'10" (20'2")

GROUND FLOOR | ELEV. A

VENDOR

PURCHASER

PURCHASER

GOLDPARK
WORTH MORE™

Prices, figures, illustrations, sizes, features and finishes are subject to change without notice. Areas and dimensions are approximate and actual usable floor space may vary from the stated area. Layout may be reverse of the unit purchased. E. & O.E. 4002

SCHEDULE 'F'



The Valleyview 40' SERIES

Elevation A • 3,145 sq.ft.
→ Elevation B • 3,170 sq.ft.

PN-120

MARCH 17 2020

JUNE 4 2020

JUNE 19 2020

AUGUST 21 2020


See attach.

See attached.

See attached.

See attached.

* REVISED LAYOUT *
STRAIGHTEN TUB
RELOCATE VANITY
RELOCATE TOILET

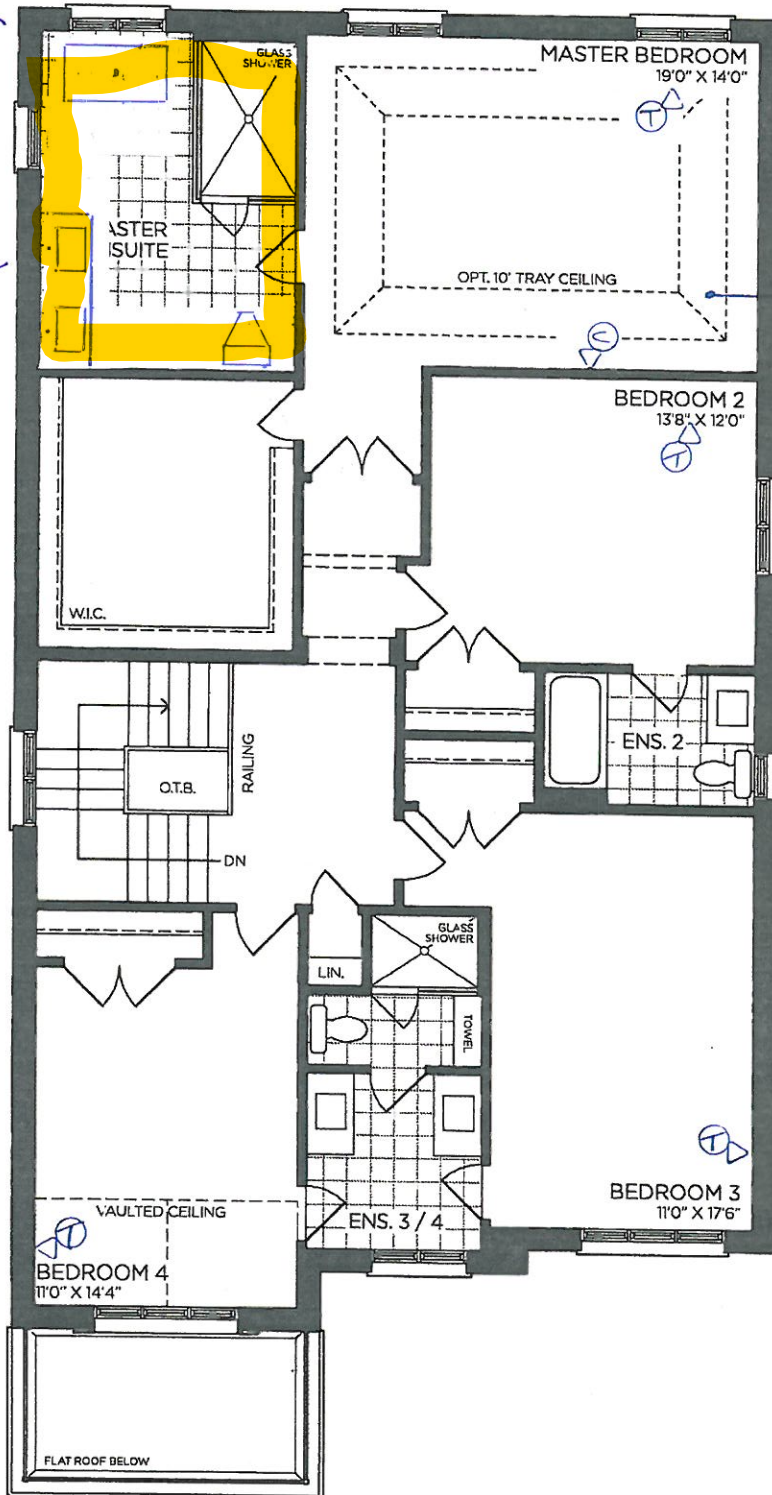

SECOND FLOOR | ELEV. A

VENDOR

PURCHASER

PURCHASER

GOLDPARK
WORTH MORE™

Prices, figures, illustrations, sizes, features and finishes are subject to change without notice. Areas and dimensions are approximate and actual usable floor space may vary from the stated area. Layout may be reverse of the unit purchased. E. & O.E. 4002

SCHEDULE 'F'



PV-120 *see attached*
MAR 17 2020

JUNE 4 2020 *see attached*

JUNE 19 2020 *see attached*


AUG 2 2020

see attached


The Valleyview 40' SERIES

Elevation A • 3,145 sq.ft.
→ Elevation B • 3,170 sq.ft.


YES!

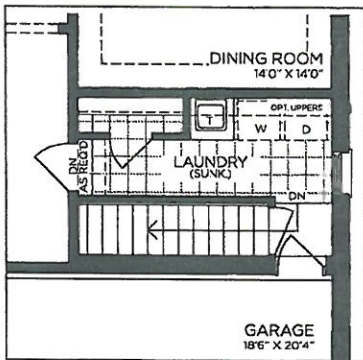


PART. GROUND FLOOR
OPT. SERVICE STAIR

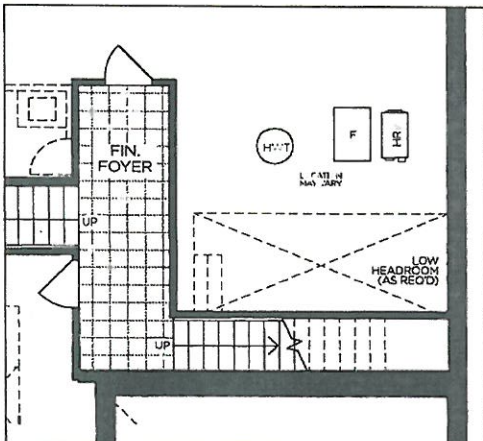


PART. BASEMENT
OPT. SERVICE STAIR

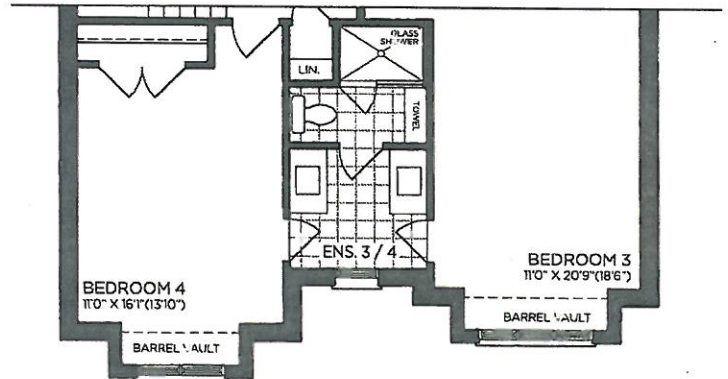

→ PART. SECOND FLOOR | ELEV. B

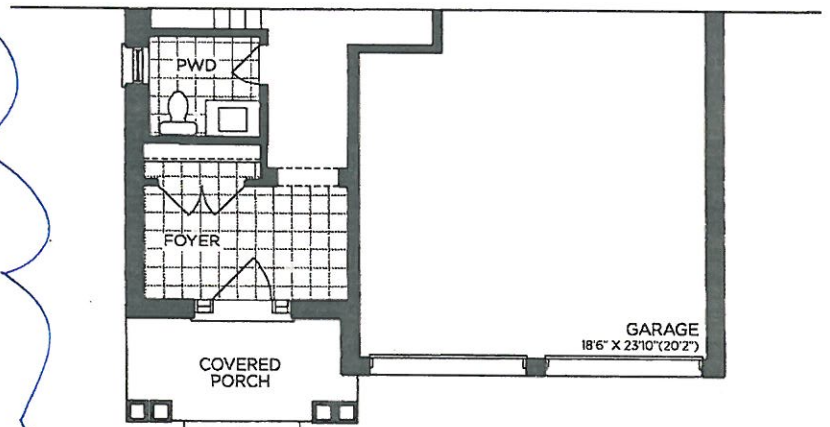

→ PART. GROUND FLOOR | ELEV. B

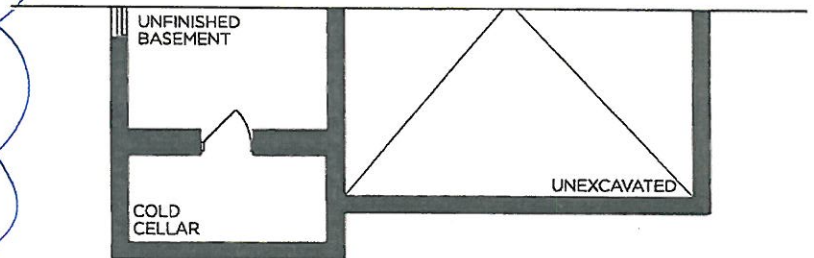

→ PART. BASEMENT | ELEV. B

VENDOR
PURCHASER
PURCHASER

GOLDPARK
WORTH MORE™

Prices, figures, illustrations, sizes, features and finishes are subject to change without notice. Areas and dimensions are approximate and actual usable floor space may vary from the stated area. Layout may be reverse of the unit purchased. E. & O.E. 4002

SCHEDULE 'F'



The Valleyview 40' SERIES

Elevation A • 3,145 sq.ft.
Elevation B • 3,170 sq.ft.

PV-120

MARCH 17 2020

JUNE 4 2020

JUNE 19 2020

AUG 21 2020


see attached

Look out 30x48"

36x48"

STD 16x30"

Backflow
PREVENTER
1/4" Vt

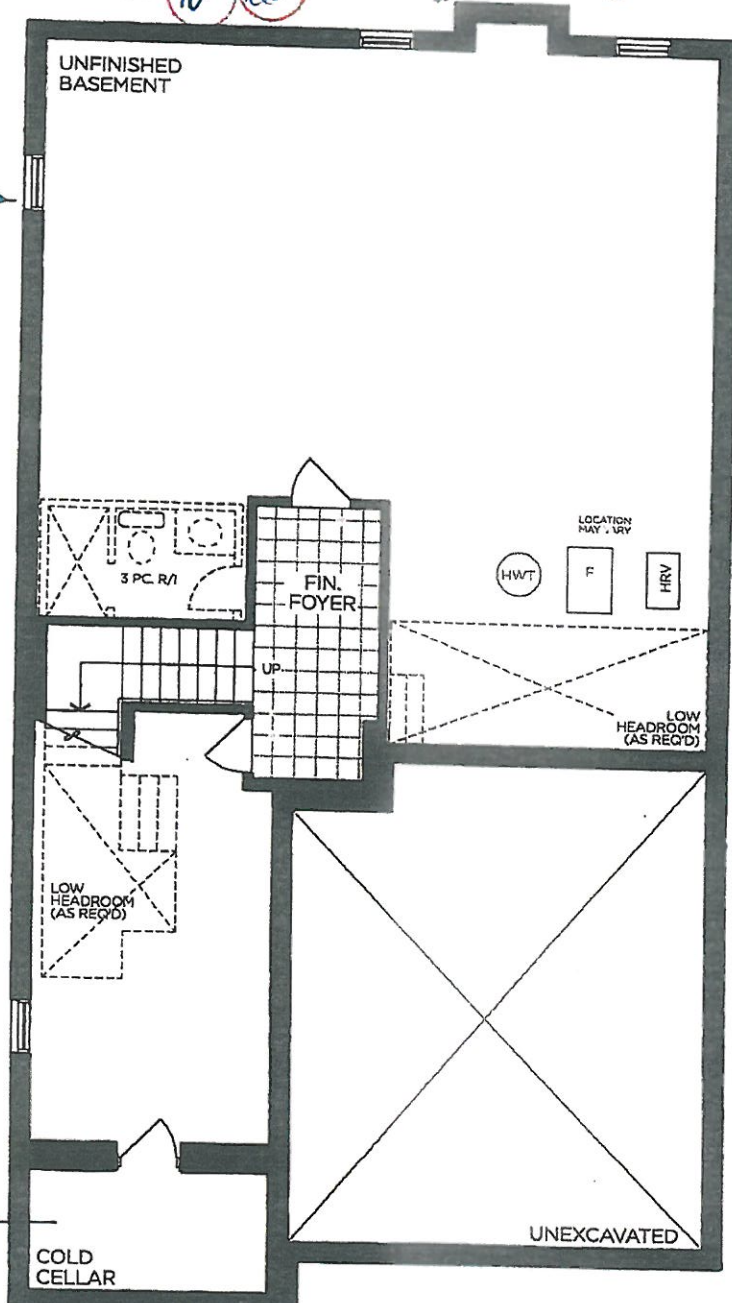

SCHEDULE 'F'

PINE VALLEY
FOREVERGREEN

JUNE 19 2020

PV-120

MAR 17 2020

JUNE 4 2020

attached.

The Valleyview 40' SERIES

Elevation A • 3,145 sq.ft.
Elevation B • 3,170 sq.ft.

REUSED LAYOUT

AUG 21 2020

AV CL

No!

OPT. LOGGIA

GARDEN DOOR

D.V. GAS FIREPLACE

GREAT ROOM
18'6" X 13'0"

TE

Black
INTERIOR
Windows

BREAKFAST
11'6" X 13'0"

D.V.
EXTER. ALUMINUM CLOSET

COFFERED CEILING

DINING ROOM
14'0" X 14'0"

OST. UPPERS
W I D

LAUNDRY
(SUNK)

DOOR GRADE
PERMITTING

SERVICE
STAIRS.

RAILING
O.T.A.

DN

PWD

FOYER

COVERED
PORCH

GARAGE
18'6" X 23'10" (20'2")

DELETE N/S WALL
↓ MOVE ARCH →

SCHEDULE 'F'



PI-120

MARCH 17 2020 *see attached*

JUNE 4 2020 *see attached*


JUNE 19 2020 *see attached*

The Valleyview 40' SERIES

Elevation A • 3,145 sq.ft.
Elevation B • 3,170 sq.ft.

AUGUST 21 2020 *(A) (C)*

- * REVISED LAYOUT *
- STRAIGHTEN TUB
- RELOCATE VANITY
- RELOCATE TOILET

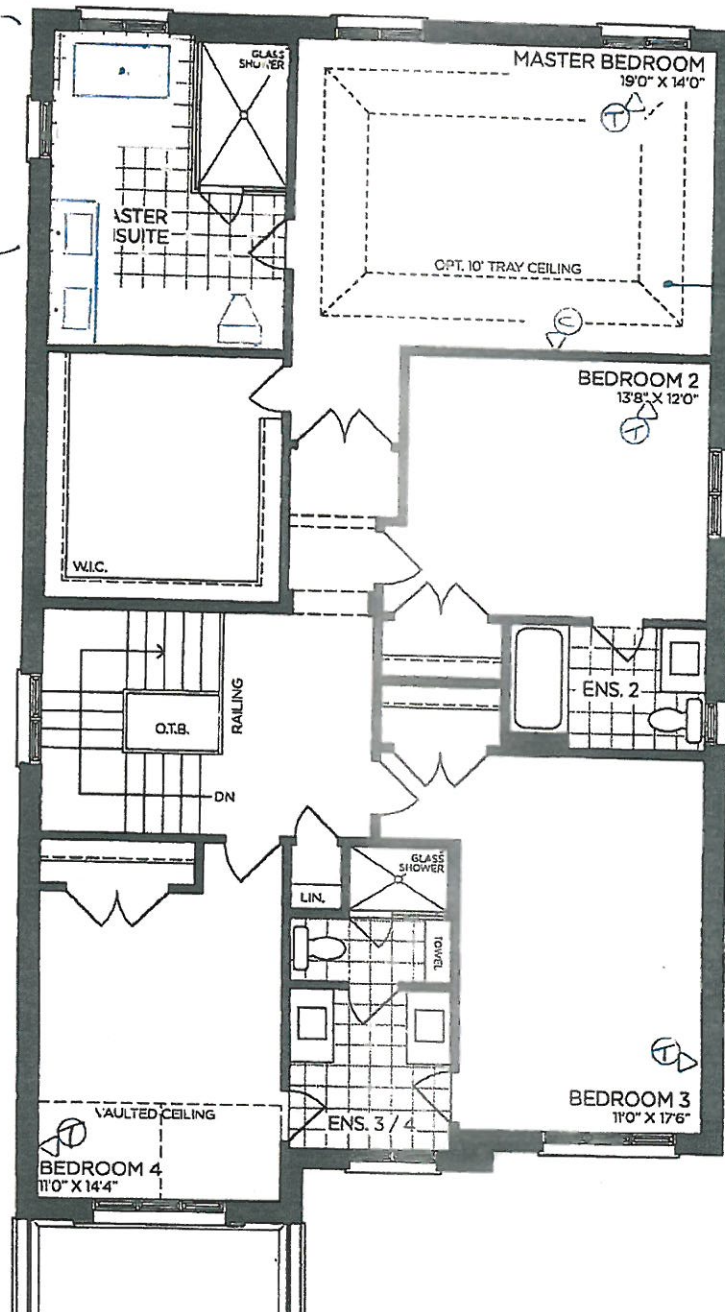

TRAY
CEILING - YES!

SCHEDULE 'F'



PV-120 ~~see attached~~
MAR 17 2020

JUNE 4 2020 ~~see attached~~

JUNE 19 2020 ~~see attached~~


AUG 2 2020 ~~see attached~~

The Valleyview 40' SERIES


Elevation A • 3,145 sq.ft.

→ Elevation B • 3,170 sq.ft.


YES!

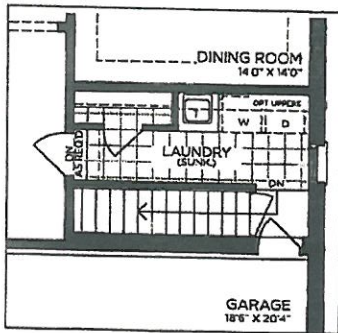


PART. GROUND FLOOR
OPT. SERVICE STAIR

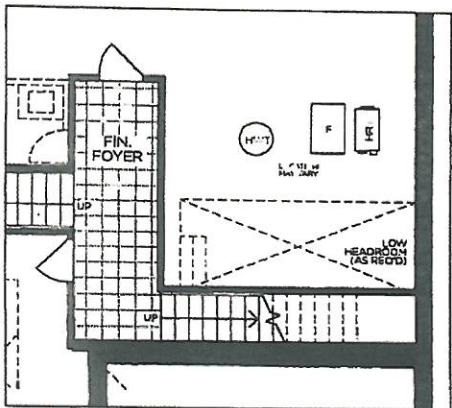


PART. BASEMENT
OPT. SERVICE STAIR

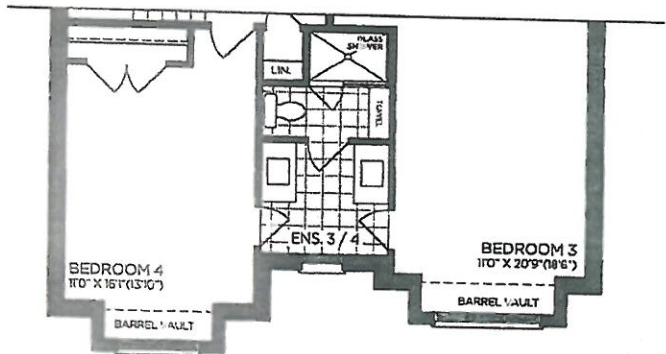

→ PART. SECOND FLOOR | ELEV. B

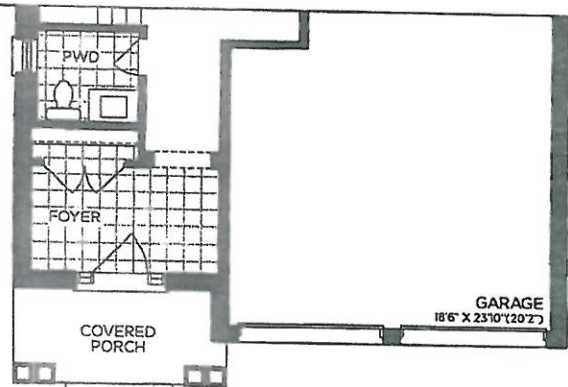

→ PART. GROUND FLOOR | ELEV. B

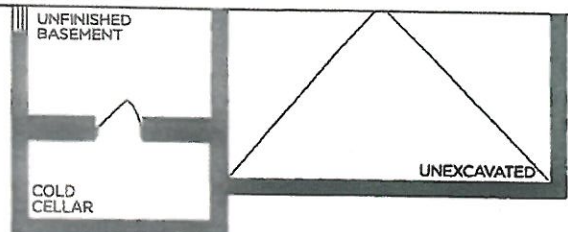

→ PART. BASEMENT | ELEV. B