

DRYWALL		
Invoice	Qty.	Description
2353 02Sep20 NoCat	1	.2ND FLOOR: INCREASE HEIGHT OF DOOR TO 8FT SECOND FLOOR - (18 DOORS TOTAL)
2353 02Sep20 NoCat	1	***DELETE *** .UPGRADE MAIN FLOOR LINEAR FIREPLACE - MAJESTIC ECHELON 2 60" LINEAR DIRECT VENT GAS FIREPLACE IN LIEU OF STANDARD (includes required exhaust grill above fireplace, approx 20" from ceiling) (REVISED SEPT 2 2020)

ELECTRICAL		
Invoice	Qty.	Description
2437 72,289 02Sep20	6	GREAT ROOM: 4" E/S LED INTERIOR POT LIGHT - GROUND FLOOR - EACH *INCLUDES 1 SWITCH INCLUDED IN APS
2395 02Sep20 NoCat	1	.GREAT ROOM: FIREPLACE - ADD HEAT ACTIVATED FAN
2353 72,281 02Sep20	1	.GREAT ROOM: INTERIOR WALL OUTLET: ADDITIONAL 110V WALL INTERIOR RECEPTACLE ON EXISTING CIRCUIT FOR WALL MOUNTED TV - LOCATE APPROX. 66" A.F.F. ABOVE FIREPLACE
2353 72,292 02Sep20	1	.FRONT PORTICO: ADDITIONAL EXTERIOR COACH LIGHT ON SAME SWITCH (BUILDERS STANDARD FIXTURE) - AT REAR OR SIDE ELEVATION ONLY
2353 72,292 02Sep20	1	.REAR YARD: ADDITIONAL EXTERIOR COACH LIGHT ON SAME SWITCH (BUILDERS STANDARD FIXTURE) - AT REAR - OPPOSITE SIDE OF DOOR FROM STANDARD (USE SAME SWITCH AS STANDARD)
2353 72,280 02Sep20	1	.POWDER ROOM: CEILING OUTLET: ADDITIONAL REINFORCED CEILING OUTLET -APPROX CENTER OF ROOM - *DELETE VANITY LIGHT* USE THAT SWITCH
2353 72,307 02Sep20	1	.KITCHEN: FIXTURE: RELOCATE STANDARD CEILING MOUNT FIXTURE - TO ABOVE ISLAND - SEE PLAN FOR LOCATION
2353 72,280 02Sep20	1	.KITCHEN: CEILING OUTLET: ADDITIONAL REINFORCED CEILING OUTLET - LOCATE ABOVE ISLAND -SEE PLAN, USE SAME SWITCH AS STANDARD
2353 72,303 02Sep20	1	.KITCHEN: FIXTURE: UNDER CABINET FLUORESCENT LIGHT FIXTURES - DOES NOT INCLUDE (AND REQUIRES) LIGHT VALANCE
2353 02Sep20 NoCat	2	.MASTER ENSUITE: RELOCATE STANDARD VANITY LIGHTS *FROM* ABOVE MIRROR *TO* BESIDE MIRROR - 1 ON EACH END OF VANITY MIRRORS - SEE PLAN FOR LOCATION LOCATE APPROX 70" A.F.F.
2353 72,280 02Sep20	1	.MASTER ENSUITE: ADD CEILING OUTLET: ADDITIONAL REINFORCED CEILING OUTLET - SEE PLAN FOR LOCATION - SAME SWITCH AS VANITY LIGHTS
2353 02Sep20 NoCat	1	.MASTER ENSUITE: RELOCATE STANDARD GFI TO BELOW SWITCHES, IF POSSIBLE FUTURE CABINET TOWER TO BE PLACED BETWEEN MIRRORS
2353 72,667 02Sep20	1	.ENSUITE 2 : ROUGH-IN FOR CAPPED CEILING OUTLET (FUTURE LIGHT FIXTURE) - EACH LOCATE CENTERED TO VANITY - SEE PLAN FOR LOCATION



CONSTRUCTION SUMMARY

Lot: 137

Model: 40.03 A BROOKSIDE

Project/Phase: Pine Valley Forevergreen / 1

WINDOWS AND DOORS

Invoice	Qty.	Description
2353 02Sep20 NoCat	2	.BREAKFAST ROOM: UPGRADED HEIGHT OF EXTERIOR DOORS TO 96" (FRENCH DOORS)
2353 02Sep20 NoCat	1	.SUN TUNNEL EXTENSION, 6 FOOT RIGID TUNNEL EXTENSION [2TR 6 FOOT] - UP TO 6 FOOT MAX.

SCHEDULE 'F'



PV-137


MAY 22 2022

Revised: July 9 2022

* REVISED: August 28, 2020

The Brookside 40' SERIES

Elevation A • 3,380 sq.ft.
Elevation B • 3,350 sq.ft.

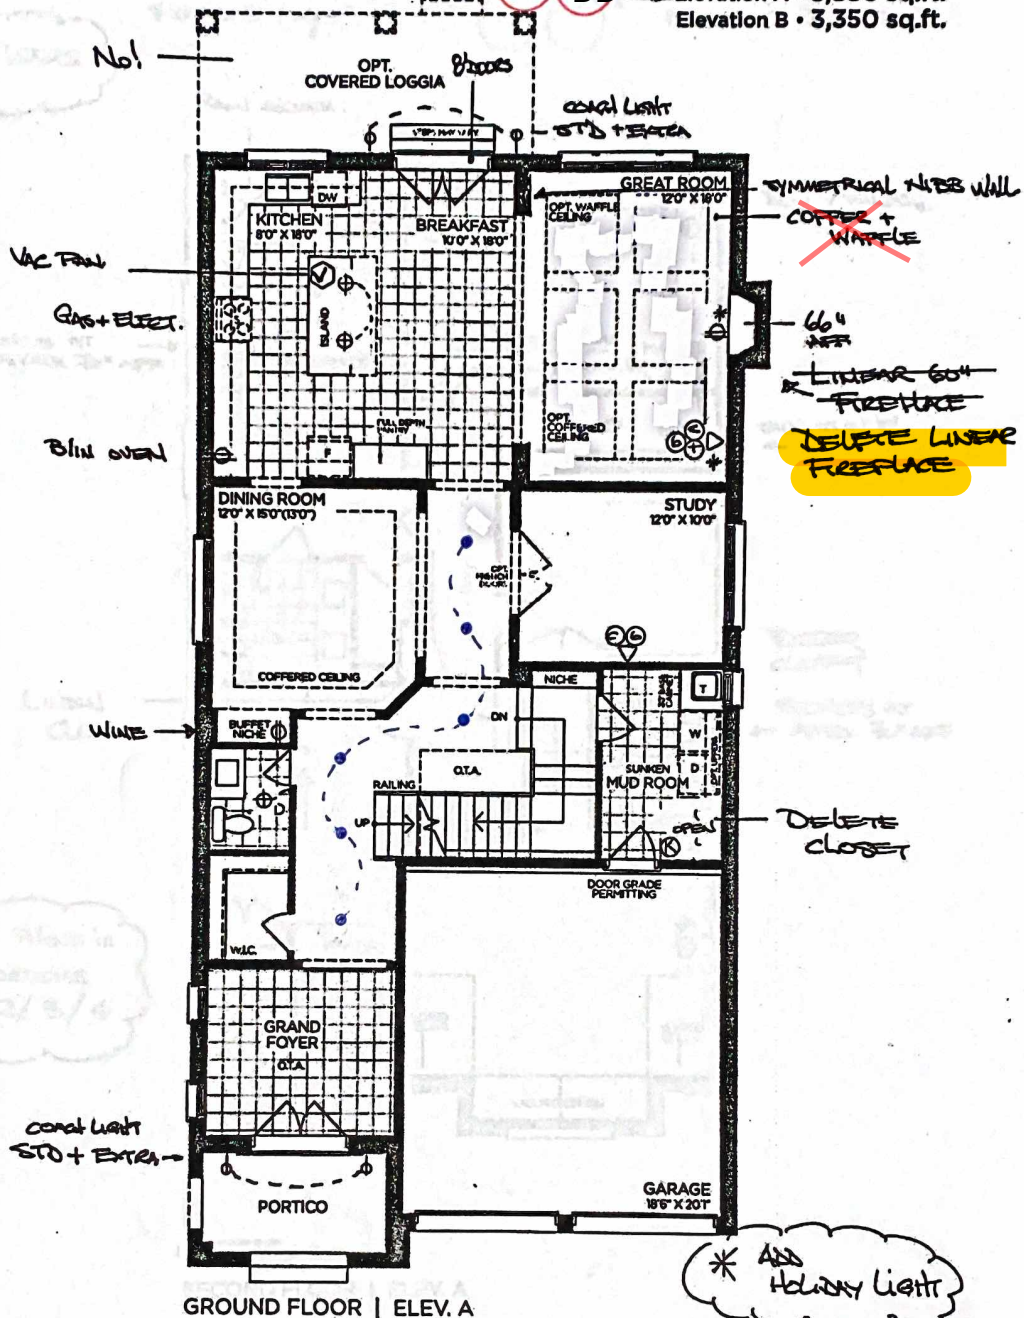

GROUND FLOOR | ELEV. A

VENDOR

PURCHASER

PURCHASER

GOLDPARK
WORTH MORE™

Prices, figures, illustrations, sizes, features and finishes are subject to change without notice. Areas and dimensions are approximate and actual usable floor space may vary from the stated area. Layout may be reverse of the unit purchased. E. & O.E. 4003



PINE VALLEY
ESTABLISHED 1934

AN-137

MAY 22 2020

July 9 2020

* REVISED August 28, 2020

The Brookside 40' SERIES

Elevation A • 3,380 sq.ft.

Elevation B • 3,350 sq.ft.

8' Doors

RAIN SHOWER.

SCANDLES AT
APPROX 70' AFE

-TRAY CEILING.

Sun and

**BIGGER
CLOSE**

SCONES AT
+ APPROX. 7" AFF

LINEN
CLOSET

No Phone in
BEDROOMS
2/3/4

SECOND FLOOR | ELEV. A

VENDOR

PURCHASER

PURCHASER

GOLDPARK
WORTH MORE

Prices, figures, illustrations, sizes, features and finishes are subject to change without notice. Areas and dimensions are approximate and actual usable floor space may vary from the stated area. Layout may be reverse of the unit purchased. E. & O. 4003

SCHEDULE 'F'



The Brookside 40' SERIES

Elevation A • 3,380 sq.ft.
Elevation B • 3,350 sq.ft.


PV 137
MAY 22, 2020
JULY 9, 2020

* REVISED August 28, 2020

24x40"

24x40"

24x30"

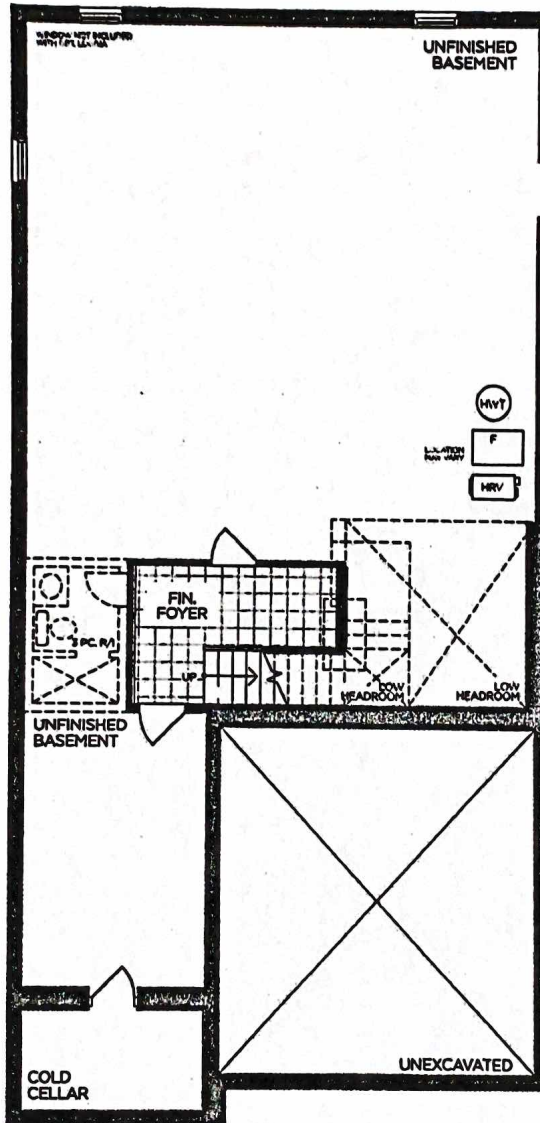

BASEMENT | ELEV. A

VENDOR

PURCHASER

PURCHASER

GOLDPARK
WORTH MORE


Prices, figures, illustrations, sizes, features and finishes are subject to change without notice. Areas and dimensions are approximate and actual usable floor space may vary from the stated area. Layout may be reverse of the unit purchased. E. & O.E. 4003

PLUMBING UPGRADES





POSI-TEMP SHOWER ONLY* W/3 FUNCTION TRANSFER VALVE
TRIM AND SLIDE BAR W/HAND SHOWER

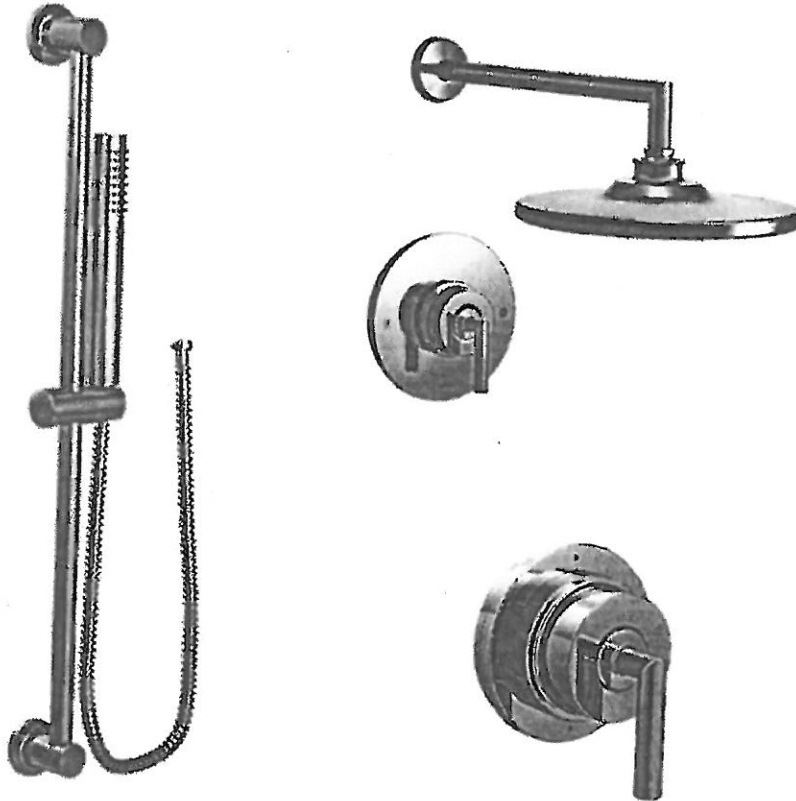MOEN - ARRIS



- ☒ CHROME
- ☐ BRUSHED NICKEL
- ☐ MATTE BLACK
- ☐ from WALL
- ☒ from CEILING

MODEL TS22002EP / 3372 / TS23005 / 62320 / 3887EP / A725

Lot# 137	
Room: MASTER ENSUITE	Signature: 
Date: MAY 22 2020	Signature: 





PINE VALLEY
FOREVERGREEN

FIREPLACE UPGRADES

Majestic Echelon II - 60"

Linear Direct Vent Gas Fireplace

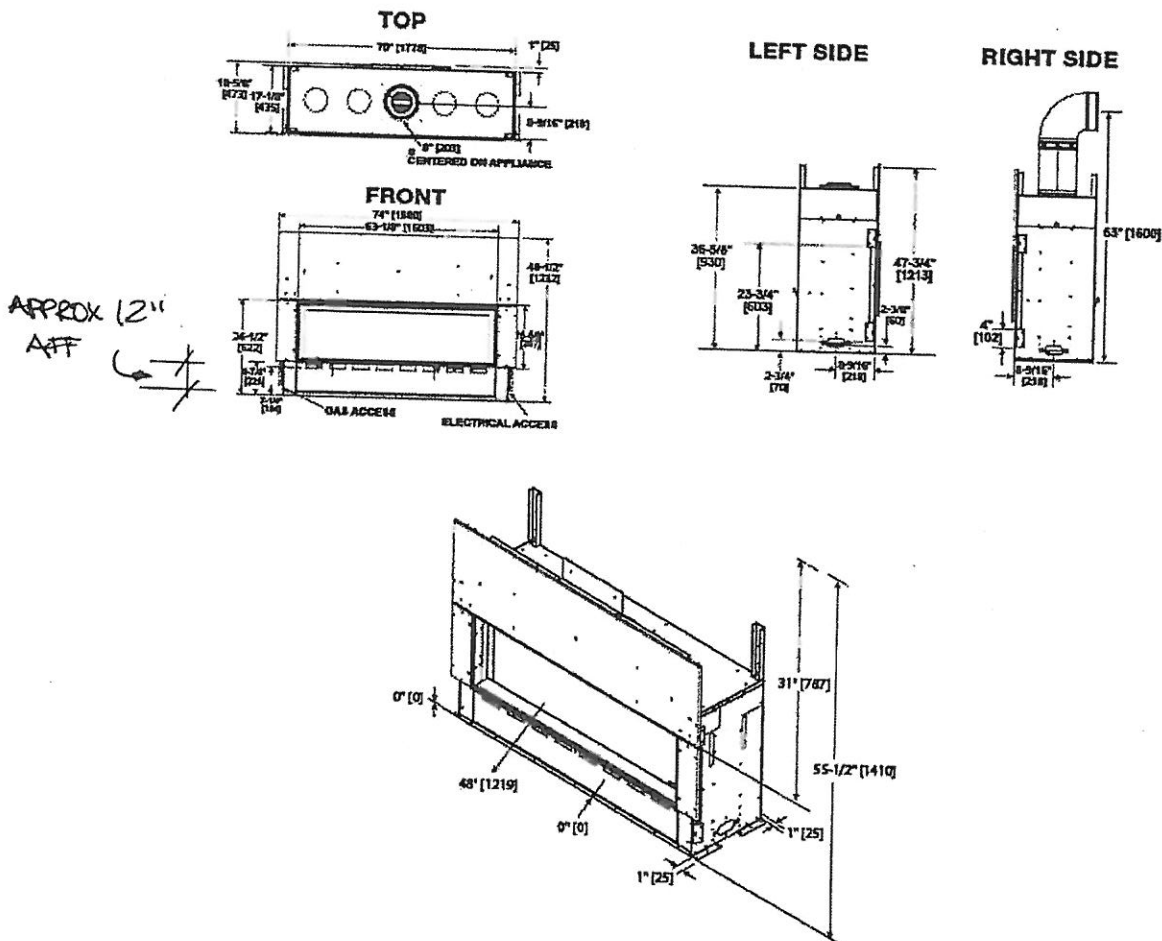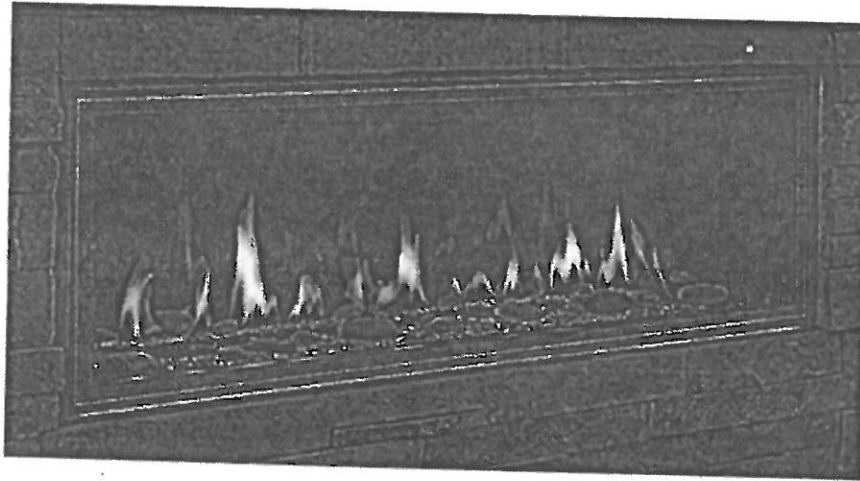

Lot#

137

Room:

GREAT ROOM

Signature:

Victor da Silva

Date:

MAY 22 2020

Signature:

Dana da Silva

GOLDPARK
WORTH MORE




PINE VALLEY
FOREVERGREEN

PLUMBING UPGRADES

POSI-TEMP SHOWER ONLY* W/ 3 FUNCTION TRANSFER
VALVE/TRIM AND SLIDE BAR W/ HAND SHOWER

MOEN - ALIGN

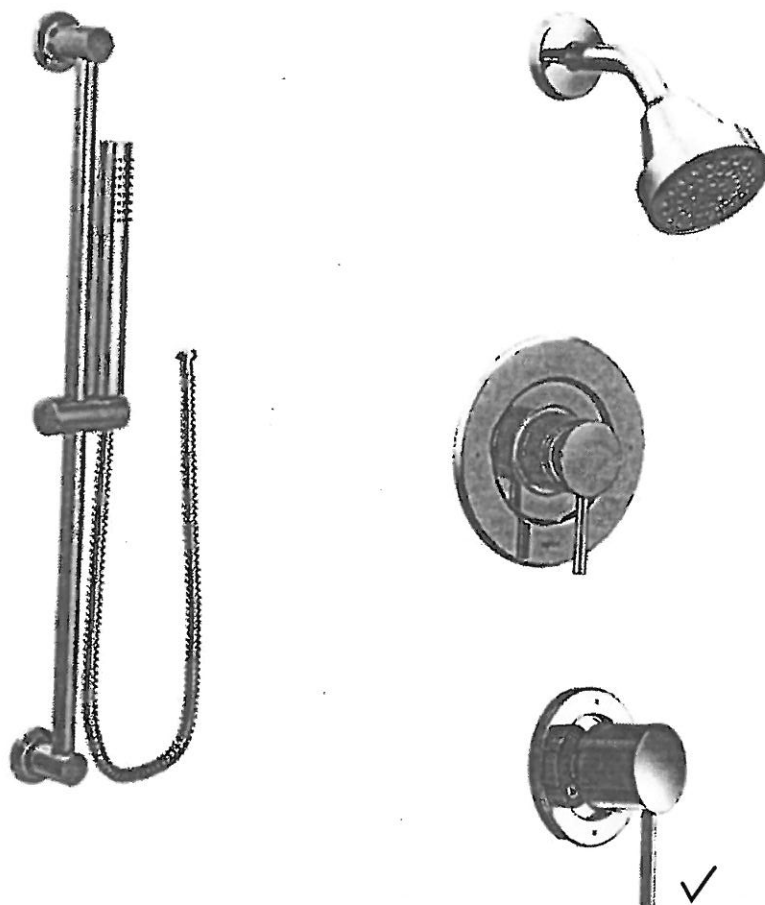

- ☒ CHROME
☐ BRUSHED GOLD
☐ MATTE BLACK

- ☒ from WALL
☐ from CEILING

MODEL T21193EP / 3372 / 128284 / T4191 / 62320 / 3887EP / A725

Lot#
137

Room:
MASTER ENSUITE

Signature:
Victor da Silva

Date:
MAY 22 2020

Signature:
Dana Da Silva

GOLDPARK
WORTH MORE