

Lot: 115
Model: 42.03 A FORESTCREST
Project/Phase: Pine Valley Forevergreen / 1

<b>APPLIANCES</b>	NCI	ES
Invoice	Qty.	Qty. Description
2336	1	.2ND FLOOR LAUNDRY: ALLOW FOR STACKING WASHER/DRYER - ELECTICAL/PLUMBING/HVAC *RELOCATE* STANDARD SINK TO OPPOSITE DOOR - SEE PLAN FOR LOCATION
06Aug20 NoCat		

CERAMIC		
Invoice	Qty.	Description
2336		.MASTER ENSUITE: SHOWER NICHE [SHAMPOO SHELF] - COMPLETE WITH MATCHING MARBLE JAMBS ON 4 SIDES, STANDARD TILE, APPROX. 12 X 18 INSTALLED VERTICALLY - SEE PLAN
06Aug20 NoCat		
2336	-	.***CUSTOM LAYOUT*** MASTER ENSUITE: RELOCATE TUB TO CENTER OF WALL
06Aug20 NoCat		
2336	<u>ы</u>	.**CUSTOM LAYOUT** MASTER ENSUITE: RELOCATE TOILET, MAKE SHOWER APPROX 12" BIGGER - SEE PLAN FOR LOCATION
06Aug20 NoCat		
2336	_	.2ND FLOOR LAUNDRY: ALLOW FOR STACKING WASHER/DRYER - ELECTICAL/PLUMBING/HVAC *RELOCATE* STANDARD SINK TO OPPOSITE DOOR - SEE PLAN FOR LOCATION
06Aug20 NoCat		
2336	<u> </u>	ENSUITE 2: REPLACE STANDARD TUB TO FRAMELESS GLASS SHOWER ENCLOSURE WITH GLASS SHOWER DOOR - COMPLETE WITH BUILDERS STANDARD OFFERINGS [TILE SHOWER BASE, POTLIGHT IN CEILING AND FRAMELESS GLASS SHOWER]
06Aug20 NoCat		

CONCE		CONCRETE AND DRAIN
Invoice	Qty.	Qty. Description
2336	1	.**CUSTOM LAYOUT** MASTER ENSUITE: RELOCATE TOILET, MAKE SHOWER APPROX 12" BIGGER - SEE PLAN FOR LOCATION
06Aug20 NoCat		

NoCat		
CROW	X	CROWN MOULDING
Invoice	Qty.	Qty. Description
2336	1	GREAT ROOM - OPT. COFFERED CEILING AS PER PLAN
06Aug20 NoCat		
2336	1	STUDY - OPT. COFFERED CEILING AS PER PLAN
06Aug20 NoCat		

DisciplineMS.rpt 26jun20 Page 1 of 9

06Aug20 NoCat

06Aug20 NoCat

2336

\_

LIVING ROOM - OPT. COFFERED CEILING AS PER PLAN

2336

.MASTER BEDROOM - OPT. 10 FOOT TRAY CEILING AS PER PLAN



Lot: 115
Model: 42.03 A FORESTCREST
Project/Phase: Pine Valley Forevergreen / 1

		NoCat
FRAMELESS GLASS SHOWER]		06Aug20
ENSUITE 2: REPLACE STANDARD TUB TO FRAMELESS GLASS SHOWER ENCLOSURE WITH GLASS SHOWER DOOR - COMPLETE WITH BUILDERS STANDARD OFFERINGS [TILE SHOWER BASE, POTLIGHT IN CEILING AND	<u> </u>	2336
TI AND DILLOLA		06Aug20 NoCat
**CUSTOM LAYOUT** CLOSE OFF OPENING AND RAILING FROM STUDY LOFT/LIVING ROOM, DELETE WALL BETWEEN LOFT AND HERS WIC, CREATING I LARGE DRESSING ROOM - COMPLETE WITH STANDARD ROD AND WIRE SHELF	_	2336
		06Aug20 NoCat
**CUSTOM LAYOUT** RELOCATE DOOR TO `HIS` WIC, TO CREATE WIC ACCESS FROM BEDROOM 2  *MOVE DOORS FROM REACH IN CLOSET *FROM* BEDROOM 2 *TO* HALLWAY - DELETE SEPARATE LINEN CLOSET CREATE I LARGE DOUBLE-DOOR LINEN CLOSET ACCESSIBLE FROM HALLWAY	ь	2336
		06Aug20 NoCat
.2ND FLOOR LAUNDRY: ALLOW FOR STACKING WASHER/DRYER - ELECTICAL/PLUMBING/HVAC *RELOCATE* STANDARD SINK TO OPPOSITE DOOR - SEE PLAN FOR LOCATION	-	2336
		06Aug20 NoCat
**CUSTOM LAYOUT** BEDROOM 4 - DELETE LINEN CLOSET *FROM HALL* TURN IT TO CREATE OPEN `NICHE` BESIDE CLOSET IN BEDROOM 4 - NO TRIM OR SHELVING		2336
		06Aug20 NoCat
.MAIN FLOOR: UPGRADE TO SOLID-CORE 9' INTERIOR DOORS	7	2336
		06Aug20 NoCat
**CUSTOM LAYOUT** STUDY:ADD WALL AND FRENCH DOOR TO STUDY - CREATING DOUBLE FRENCH DOORS (1 STANDARD + 1 EXTRA)	ь	2336
		06Aug20 NoCat
.2ND FLOOR: INCREASE HEIGHT OF DOOR TO 8FT SECOND FLOOR - PER DOOR	17	2336
		06Aug20 NoCat
.MASTER BEDROOM - OPT. 10 FOOT TRAY CEILING AS PER PLAN	ь	2336
		06Aug20 NoCat
.LIVING ROOM - OPT. COFFERED CEILING AS PER PLAN	_	2336
		06Aug20 NoCat
.STUDY - OPT. COFFERED CEILING AS PER PLAN	1	2336
		06Aug20 NoCat
.GREAT ROOM - OPT. COFFERED CEILING AS PER PLAN	ш	2336
Description	Qty.	Invoice Qty.
		7777

DisciplineMS.rpt 26jun20 Page 2 of 9
Printed and Sent: 09-Sep-20



Lot: 115
Model: 42.03 A FORESTCREST
Project/Phase: Pine Valley Forevergreen / 1

ELECTRICAL	TRIC	ÄL
2336		POWDER ROOM: ROUGH-IN FOR CAPPED CEILING OUTLET ( FUTURE LIGHT FIXTURE) - EACH
72,667 06Aug20		USE SAME SWITCH AS STANDARD LIGHT
2336 72,307 06Aug20	0	.KITCHEN: FIXTURE: RELOCATE STANDARD CEILING MOUNT FIXTURE *FROM* FOYER (BY CLOSET) *TO* ISLAND - SEE PLAN FOR LOCATION
2336 72.278	1	.KITCHEN: ADDITIONAL INTERIOR SWITCH
06Aug20		FOR LIGHT ABOVE ISLAND
2336 72,307 06Aug20	0 1	.BREAKFAST: FIXTURE: RELOCATE STANDARD CEILING MOUNT FIXTURE TO BE IN LINE WITH ISLAND - SEE PLAN FOR LOCATION
2336 72,667 06Aug20	0 1	.KITCHEN: ABOVE ISLAND ROUGH-IN FOR CAPPED CEILING OUTLET (FUTURE LIGHT FIXTURE) - EACH USE SAME SWITCH AS STANDARD LIGHT
2336 72,292 06Aug20	0 1	FRONT PORTICO:ADDITIONAL EXTERIOR COACH LIGHT ON SAME SWITCH (BUILDERS STANDARD FIXTURE) - SAME SWITCH AS STANDARD
2336 72,286 06Aug20	0 1	FRONT PORTICO: EXTERIOR RECEPTACLE: ADDITIONAL EXTERIOR GFI RECEPTACLE WITH COVER - LOCATE OPPOSITE SIDE FRONT DOOR AS STANDARD - SAME HEIGHT AS STANDARD
2336 72,292 06Aug20	0 1	.REAR ELEVATION: ADDITIONAL EXTERIOR COACH LIGHT ON SAME SWITCH (BUILDERS STANDARD FIXTURE) - OPPOSITE SIDE OF GARDEN DOOR AS STANDARD - SAME HEIGHT AS STANDARD
2336 72,665 06Aug20	0 1	.KITCHEN: 240v WALL RECEPTACLE ON SEPARATE CIRCUIT FOR BUILT-INS APPROX. LOCATION AS PER ATTACHED DRAWINGS
2336 06Aug20 NoCat	0 1	*NOTE* THRU OUT: CEILING LIGHT TO BE CENTERED AS MUCH AS POSSIBLE, EXCEPT WHERE OTHERWISE NOTED
2336 72,289 06Aug20	0 6	.MAIN HALL: 4" E/S LED INTERIOR POT LIGHT - GROUND FLOOR - EACH - DELETE STANDARD CEILING LIGHTS, USE STANDARD SWITCHES - SEE PLAN FOR LOCATION INCLUDED IN APS
2336 06Aug20 NoCat	1 0 Cat	.**CUSTOM LAYOUT** MASTER ENSUITE: RELOCATE TOILET, MAKE SHOWER APPROX 12" BIGGER - SEE PLAN FOR LOCATION
2336	1	.2ND FLOOR LAUNDRY: ALLOW FOR STACKING WASHER/DRYER - ELECTICAL/PLUMBING/HVAC *RELOCATE* STANDARD SINK TO OPPOSITE DOOR - SEE PLAN FOR LOCATION
NoCat	Cat	



Lot: 115
Model: 42.03 A FORESTCREST
Project/Phase: Pine Valley Forevergreen / 1

#### ELECTRICAL

06Aug20 NoCat 2336 \_ ENSUITE 2: REPLACE STANDARD TUB TO FRAMELESS GLASS SHOWER ENCLOSURE WITH GLASS SHOWER DOOR - COMPLETE WITH BUILDERS STANDARD OFFERINGS [TILE SHOWER BASE, POTLIGHT IN CEILING AND FRAMELESS GLASS SHOWER] Description

### **EXTERIOR COLOURS**

Invoice Oty		Description
2336	_	.MASTER BEDROOM - OPT. 10 FOOT TRAY CEILING AS PER PLAN
06Aug20		
2336	1	.MAIN FLOOR: UPGRADE TO SOLID-CORE 9' INTERIOR DOORS
06Aug20 NoCat		
2336	-	**CUSTOM LAYOUT** CLOSE OFF OPENING AND RAILING FROM STUDY LOFT/LIVING ROOM, DELETE WALL BETWEEN LOFT AND HERS WIC, CREATING I LARGE DRESSING ROOM - COMPLETE WITH STANDARD ROD AND WIRE SHELF
06Aug20 NoCat		WIND SHELF
2255 72,672 09Sep20	2	DELETE - BASEMENT WINDOWS - EGRESS BASEMENT WINDOW 47 " X 35" - 8" FRAME.
2255	2	BASEMENT WINDOWS - UPGRADE BASEMENT WINDOW SIZE TO 30 " X 24" - 8" FRAME.
09Sep20 NoCat		
2419	2	.**DELETE** BASEMENT WINDOWS - EGRESS BASEMENT WINDOW 47 " X 35" - 8" FRAME)
09Sep20 NoCat		DELETE FROM ORDER PE 2255
2419	2	BASEMENT WINDOWS: UPGRADE BASEMENT WINDOW SIZE TO 30 X 40" AT REAR.
09Sep20 NoCat		IN LIEU OF 47X35" DELETED PRODUCT ( NOT AVAILABLE)

DisciplineMS.rpt 26jun20 Page 4 of 9



Lot: 115
Model: 42.03 A FORESTCREST
Project/Phase: Pine Valley Forevergreen / 1

FRAMING	<b>1</b>	
2336 72,484 06Aug20	- K	.GREAT ROOM - OPT. COFFERED CEILING AS PER PLAN
2336 72,487 06Aug20	-	.STUDY - OPT. COFFERED CEILING AS PER PLAN
2336 72,498 06Aug20	<b>⊢</b>	.LIVING ROOM - OPT. COFFERED CEILING AS PER PLAN
2336 72,494 06Aug20	-	.MASTER BEDROOM - OPT. 10 FOOT TRAY CEILING AS PER PLAN
2336 72,644 06Aug20	17	.2ND FLOOR: INCREASE HEIGHT OF DOOR TO 8FT SECOND FLOOR - PER DOOR
2336 06Aug20 NoCat	ь	**CUSTOM LAYOUT** STUDY:ADD WALL AND FRENCH DOOR TO STUDY - CREATING DOUBLE FRENCH DOORS (I STANDARD + 1 EXTRA)
2336 06Aug20	7	.MAIN FLOOR: UPGRADE TO SOLID-CORE 9' INTERIOR DOORS
2336 72,631 06Aug20	_	.MASTER ENSUITE: SHOWER NICHE [SHAMPOO SHELF] - COMPLETE WITH MATCHING MARBLE JAMBS ON 4 SIDES, STANDARD TILE, APPROX. 12 X 18 INSTALLED VERTICALLY - SEE PLAN
2336 06Aug20	_	.***CUSTOM LAYOUT*** MASTER ENSUITE: RELOCATE TUB TO CENTER OF WALL
2336 06Aug20 NoCat	-	.**CUSTOM LAYOUT** MASTER ENSUITE: RELOCATE TOILET, MAKE SHOWER APPROX 12" BIGGER - SEE PLAN FOR LOCATION
2336 06Aug20 NoCat	_	**CUSTOM LAYOUT** BEDROOM 4 - DELETE LINEN CLOSET *FROM HALL* TURN IT TO CREATE OPEN `NICHE` BESIDE CLOSET IN BEDROOM 4 - NO TRIM OR SHELVING
2336 06Aug20 NoCat	-	.2ND FLOOR LAUNDRY: ALLOW FOR STACKING WASHER/DRYER - ELECTICAL/PLUMBING/HVAC *RELOCATE* STANDARD SINK TO OPPOSITE DOOR - SEE PLAN FOR LOCATION
2336 06Aug20 NoCat	-	**CUSTOM LAYOUT** RELOCATE DOOR TO `HIS` WIC, TO CREATE WIC ACCESS FROM BEDROOM 2 *MOVE DOORS FROM REACH IN CLOSET *FROM* BEDROOM 2 *TO* HALLWAY - DELETE SEPARATE LINEN CLOSET, CREATE I LARGE DOUBLE-DOOR LINEN CLOSET ACCESSIBLE FROM HALLWAY



		Lot: 115 Model: 42.03 A FORESTCREST Project/Phase: Pine Valley Forevergreen / 1
FRAMING	ON	
Invoice	Qty.	Description
 2336	1	**CUSTOM LAYOUT** CLOSE OFF OPENING AND RAILING FROM STUDY LOFT/LIVING ROOM, DELETE WALL BETWEEN LOFT AND HERS WIC, CREATING I LARGE DRESSING ROOM - COMPLETE WITH STANDARD ROD AND WIRE SHELF
06Aug20 NoCat		
2336 72,350	1	ENSUITE 2: REPLACE STANDARD TUB TO FRAMELESS GLASS SHOWER ENCLOSURE WITH GLASS SHOWER DOOR - COMPLETE WITH BUILDERS STANDARD OFFERINGS [TILE SHOWER BASE, POTLIGHT IN CEILING AND FRAMELESS GLASS SHOWER]
06Aug20		
2255	2	BASEMENT WINDOWS - UPGRADE BASEMENT WINDOW SIZE TO 30 " X 24" - 8" FRAME.
 09Sep20 NoCat		
2419	2	**DELETE** BASEMENT WINDOWS - EGRESS BASEMENT WINDOW 47 " X 35" - 8" FRAME
 09Sep20 NoCat		DELETE FROM ORDER PE. 2255
2419	1	BASEMENT WINDOWS: UPGRADE BASEMENT WINDOW SIZE TO 30 X 40" AT REAR
09Sep20 NoCat		IN LIEU OF 47X35 DELETED PRODUCT (NOT AVAILABLE)

#### GLASS AND MIRROR

Invoice	Qty.	Qty. Description
2336	1	.**CUSTOM LAYOUT** MASTER ENSUITE: RELOCATE TOILET, MAKE SHOWER APPROX 12" BIGGER - SEE PLAN FOR LOCATION
06Aug20 NoCat		
2336	ь	ENSUITE 2: REPLACE STANDARD TUB TO FRAMELESS GLASS SHOWER ENCLOSURE WITH GLASS SHOWER DOOR - COMPLETE WITH BUILDERS STANDARD OFFERINGS [TILE SHOWER BASE, POTLIGHT IN CEILING AND FRAMELESS GLASS SHOWER]
06Aug20 NoCat		

HVAC		
Invoice	Qty.	Qty. Description
2336	1	.2ND FLOOR LAUNDRY: ALLOW FOR STACKING WASHER/DRYER - ELECTICAL/PLUMBING/HVAC *RELOCATE* STANDARD SINK TO OPPOSITE DOOR - SEE PLAN FOR LOCATION
06Aug20 NoCat		

DisciplineMS.rpt 26jun20 Page 6 of 9
Printed and Sent: 09-Sep-20



Lot: 115
Model: 42.03 A FORESTCREST
Project/Phase: Pine Valley Forevergreen / 1

# INTERIOR TRIM AND DOORS

Invoice	Qty.	Description
2336	-	.GREAT ROOM - OPT. COFFERED CEILING AS PER PLAN
06Aug20 NoCat	i i	
2336	1	.STUDY - OPT. COFFERED CEILING AS PER PLAN
06Aug20 NoCat	#	
2336	1	.LIVING ROOM - OPT. COFFERED CEILING AS PER PLAN
06Aug20 NoCat	Ħ	
2336		.MASTER BEDROOM - OPT. 10 FOOT TRAY CEILING AS PER PLAN
06Aug20 NoCat	=	
2336	17	.2ND FLOOR: INCREASE HEIGHT OF DOOR TO 8FT SECOND FLOOR - PER DOOR
06Aug20 NoCat	#	
2336	1	**CUSTOM LAYOUT** STUDY:ADD WALL AND FRENCH DOOR TO STUDY - CREATING DOUBLE FRENCH DOORS (1 STANDARD + 1 EXTRA)
06Aug20 NoCat	ıt	
2336	7	.MAIN FLOOR: UPGRADE TO SOLID-CORE 9' INTERIOR DOORS
06Aug20 NoCat	ıt	
2336	1	**CUSTOM LAYOUT** BEDROOM 4 - DELETE LINEN CLOSET *FROM HALL* TURN IT TO CREATE OPEN `NICHE` BESIDE CLOSET IN BEDROOM 4 - NO TRIM OR SHELVING
06Aug20 NoCat	ıt	
2336	1	**CUSTOM LAYOUT** RELOCATE DOOR TO 'HIS' WIC, TO CREATE WIC ACCESS FROM BEDROOM 2  *MOVE DOORS FROM REACH IN CLOSET *FROM* BEDROOM 2 *TO* HALLWAY - DELETE SEPARATE LINEN  CLOSET CREATE LLABGE DOUBLE DOOR LINEN CLOSET ACCESSIBLE EBOOM HALLWAY
06Aug20 NoCat	ıt .	CEOSEI, CREATE I LANGE DOOBLE-DOOK LINEN CLOSEI ACCESSIBLE INOM HALLWAT
2336		**CUSTOM LAYOUT** CLOSE OFF OPENING AND RAILING FROM STUDY LOFT/LIVING ROOM, DELETE WALL BETWEEN LOFT AND HERS WIC, CREATING I LARGE DRESSING ROOM - COMPLETE WITH STANDARD ROD AND WIRE SHELF
06Aug20 NoCat	ı.	

#### Invoice NETWORK AND WIRING Qty. Description

06Aug20	72,260	2336
		1
	OF ATTIC	CONDUIT PIPE - FROM ATTIC TO BASEMENT - FROM NEAR ELECTRICAL PANEL IN BASMENT TO APPROX. CENTER

DisciplineMS.rpt 26jun20 Page 7 of 9
Printed and Sent: 09-Sep-20



Lot: 115
Model: 42.03 A FORESTCREST
Project/Phase: Pine Valley Forevergreen / 1

		d
FAIN I Invoice	Qty.	Description
2336	1	.GREAT ROOM - OPT. COFFERED CEILING AS PER PLAN
06Aug20 NoCat		
2336	-	.STUDY - OPT. COFFERED CEILING AS PER PLAN
06Aug20 NoCat		
2336	-	.LIVING ROOM - OPT. COFFERED CEILING AS PER PLAN
06Aug20 NoCat		
2336	-	.MASTER BEDROOM - OPT. 10 FOOT TRAY CEILING AS PER PLAN
06Aug20 NoCat		
2336	17	.2ND FLOOR: INCREASE HEIGHT OF DOOR TO 8FT SECOND FLOOR - PER DOOR
06Aug20 NoCat		
2336	_	**CUSTOM LAYOUT** STUDY:ADD WALL AND FRENCH DOOR TO STUDY - CREATING DOUBLE FRENCH DOORS (1 STANDARD + 1 EXTRA)
06Aug20 NoCat		
2336	-	.MAIN FLOOR: UPGRADE TO SOLID-CORE 9' INTERIOR DOORS
06Aug20 NoCat		
2336	1	**CUSTOM LAYOUT** BEDROOM 4 - DELETE LINEN CLOSET *FROM HALL* TURN IT TO CREATE OPEN `NICHE` BESIDE CLOSET IN BEDROOM 4 - NO TRIM OR SHELVING
06Aug20 NoCat		
2336	_	**CUSTOM LAYOUT** RELOCATE DOOR TO `HIS` WIC, TO CREATE WIC ACCESS FROM BEDROOM 2 *MOVE DOORS FROM REACH IN CLOSET *FROM* BEDROOM 2 *TO* HALLWAY - DELETE SEPARATE LINEN CLOSET, CREATE I LARGE DOUBLE-DOOR LINEN CLOSET ACCESSIBLE FROM HALLWAY
06Aug20 NoCat		
2336	1	**CUSTOM LAYOUT** CLOSE OFF OPENING AND RAILING FROM STUDY LOFT/LIVING ROOM, DELETE WALL BETWEEN LOFT AND HERS WIC, CREATING I LARGE DRESSING ROOM - COMPLETE WITH STANDARD ROD AND WIRE SHELF
06Aug20 NoCat		
2336	_	ENSUITE 2: REPLACE STANDARD TUB TO FRAMELESS GLASS SHOWER ENCLOSURE WITH GLASS SHOWER DOOR - COMPLETE WITH BUILDERS STANDARD OFFERINGS [TILE SHOWER BASE, POTLIGHT IN CEILING AND FRAMELESS GLASS SHOWER]
NoCat		

DisciplineMS.rpt 26jun20 Page 8 of 9
Printed and Sent: 09-Sep-20



Lot: 115
Model: 42.03 A FORESTCREST
Project/Phase: Pine Valley Forevergreen / 1

#### **PLUMBING**

		06Aug20 NoCat
ENSUITE 2: REPLACE STANDARD TUB TO FRAMELESS GLASS SHOWER ENCLOSURE WITH GLASS SHOWER DOOR - COMPLETE WITH BUILDERS STANDARD OFFERINGS [TILE SHOWER BASE, POTLIGHT IN CEILING AND FRAMELESS GLASS SHOWER]	Ľ	2336
		06Aug20 NoCat
.2ND FLOOR LAUNDRY: ALLOW FOR STACKING WASHER/DRYER - ELECTICAL/PLUMBING/HVAC *RELOCATE* STANDARD SINK TO OPPOSITE DOOR - SEE PLAN FOR LOCATION	1	2336
		06Aug20 NoCat
.**CUSTOM LAYOUT** MASTER ENSUITE: RELOCATE TOILET, MAKE SHOWER APPROX 12" BIGGER - SEE PLAN FOR LOCATION	-	2336
		06Aug20 NoCat
.***CUSTOM LAYOUT*** MASTER ENSUITE: RELOCATE TUB TO CENTER OF WALL	-	2336
		06Aug20 NoCat
MASTER ENSUITE: UPGRADE TO MOEN 'RIZON' RAINSHOWER (from ceiling) + HAND SHOWER + SLIDE BAR CHROME #T2812EP/3372/T2081/62320/3669EP/A725	1	2336
Qty. Description	Qty.	Invoice

### STAIRS AND RAILINGS

Invoice	Qty.	Qiy. Description
2336	1	**CUSTOM LAYOUT** CLOSE OFF OPENING AND RAILING FROM STUDY LOFT/LIVING ROOM, DELETE WALL
		BETWEEN LOFT AND HERS WIC, CREATING I LARGE DRESSING ROOM - COMPLETE WITH STANDARD ROD AND
		WIRE SHELF
06Aug20 NoCat		
1,000		

### WINDOWS - BASEMENT Invoice Qty. Description


2255 72,351 09Sep20	2	.BASEMENT WINDOWS - UPGRADE BASEMENT WINDOW SIZE TO 30 " X 24" - 8" FRAME
2419 72,672	2	**DELETE** BASEMENT WINDOWS - EGRESS BASEMENT WINDOW 47" X 35" - 8" FRAME
09Sep20		DELETE FROM ORDER PE.2255
2419	2	BASEMENT WINDOWS: UPGRADE BASEMENT WINDOW SIZE TO 30 X 40" AT REAR
09Sep20		IN LIEU OF 47X35" not available


### WINDOWS AND DOORS Invoice Qty. Description

36 I THRU OUT: UPGRADE TO BLACK INTERIOR WINDOWS  g20 NoCat

DisciplineMS.rpt 26jun20 Page 9 of 9
Printed and Sent: 09-Sep-20



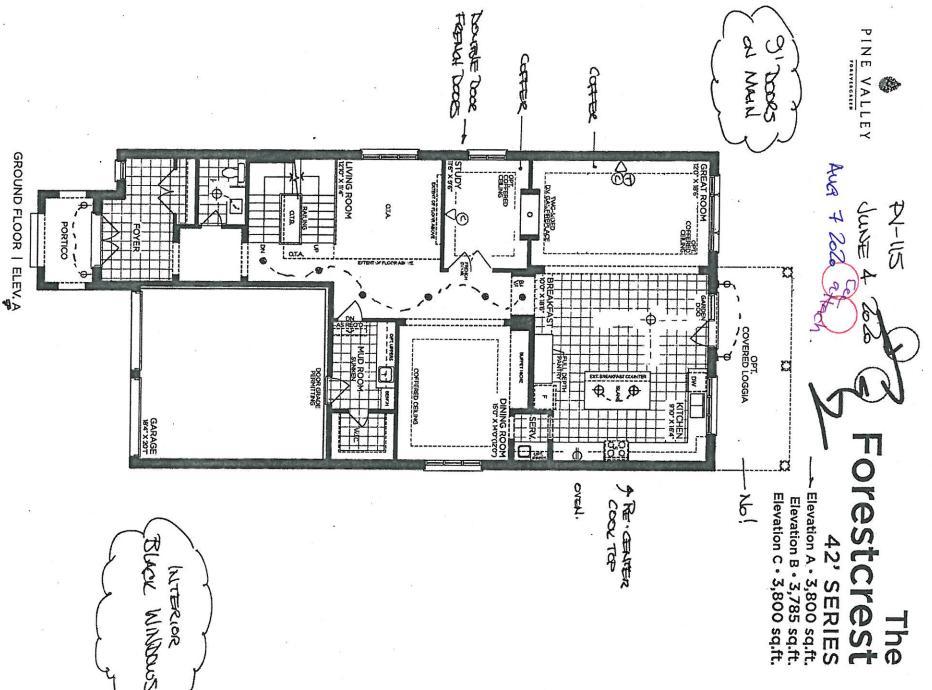

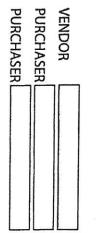



### GOLDPARK

WORTH MORE

Prices, figures, illustrations, sizes, features and finishes are subject to change without notice. Areas and dimensions are approximate and actual usable floor space may vary from the stated area. Layout may be reverse of the unit purchased. E. & O.E. 4203

#### SCHEDULE 'F'

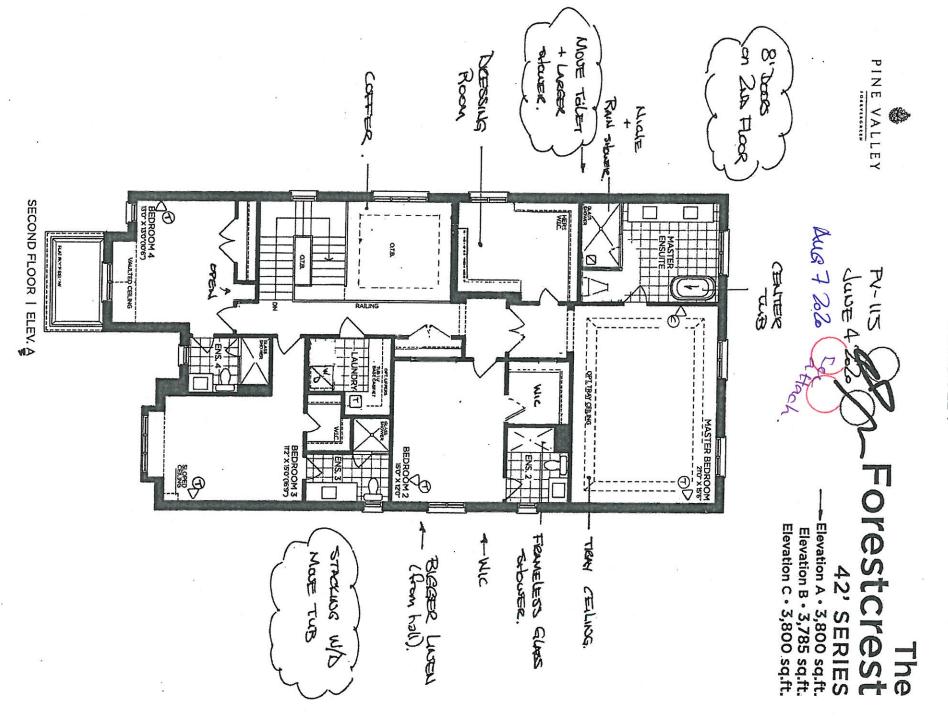


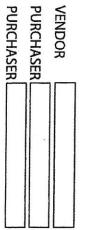

### GOLDPARK WORTH MORE

Prices, figures, illustrations, sizes, features and finishes are subject to change without notice. Areas and dimensions are approximate and actual usable floor space may vary from the stated area. Layout may be reverse of the unit purchased. E. & O.E. 4203

#### SCHEDULE'F'

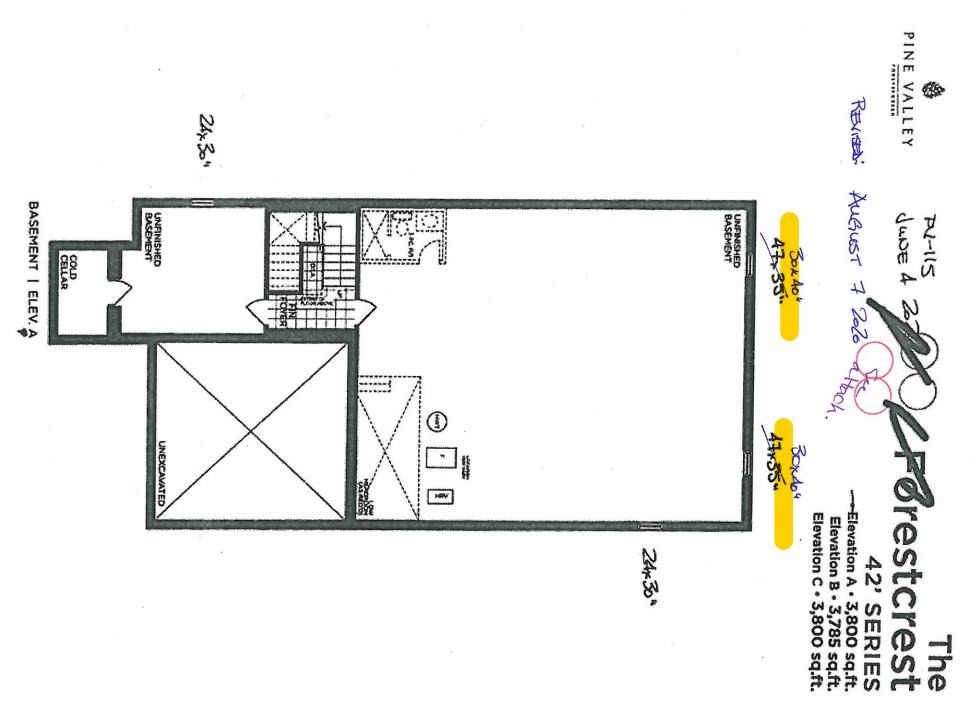



VENDOR PURCHASER PURCHASER

GOLDPARK WORTH MORE

is, figures, illustrations, sizes, features and finishes are pubject to change without te. Areas and dimensions are approximate and echual usable floor space may very from the stated area, Layout may be reverse of the unit purchased, E. & Q.E., 4203



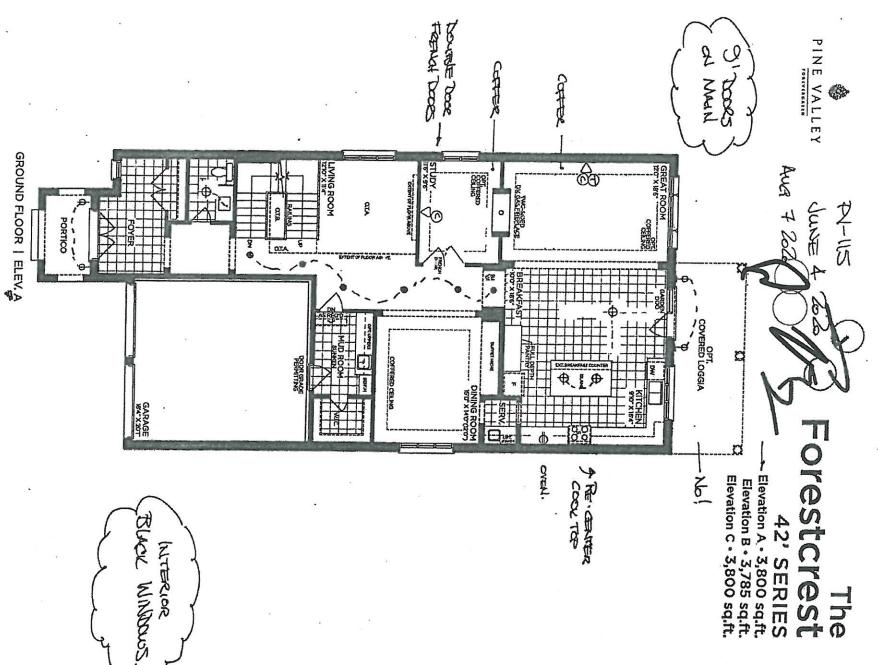


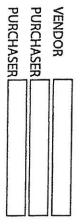

#### GOLDPARK WORTH MORE

Prices, figures, flustrations, sizes, features and finishes are subject to change without notice. Areas and dimensions are approximate and actual usable floor space may vary from the stated area. Layout may be reverse of the unit purchased. E. & O.E. 4203

#### SCHEDULE'F'

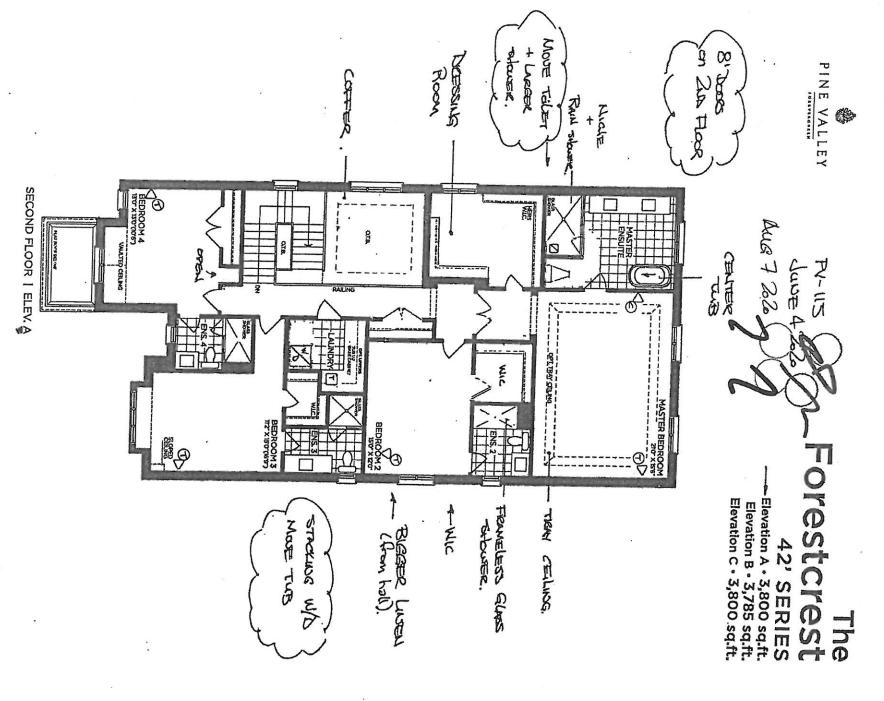



VENDOR PURCHASER PURCHASER

GOLDPARK WORTH MORE

Prices, figures, illustrations, sizes, features and finishes are subject to change without notice. Areas and dimensions are approximate and actual usable floor space may vary from the stated area. Layout may be reverse of the unit purchased. E. & O.E. 4203

#### SCHEDULE'F'

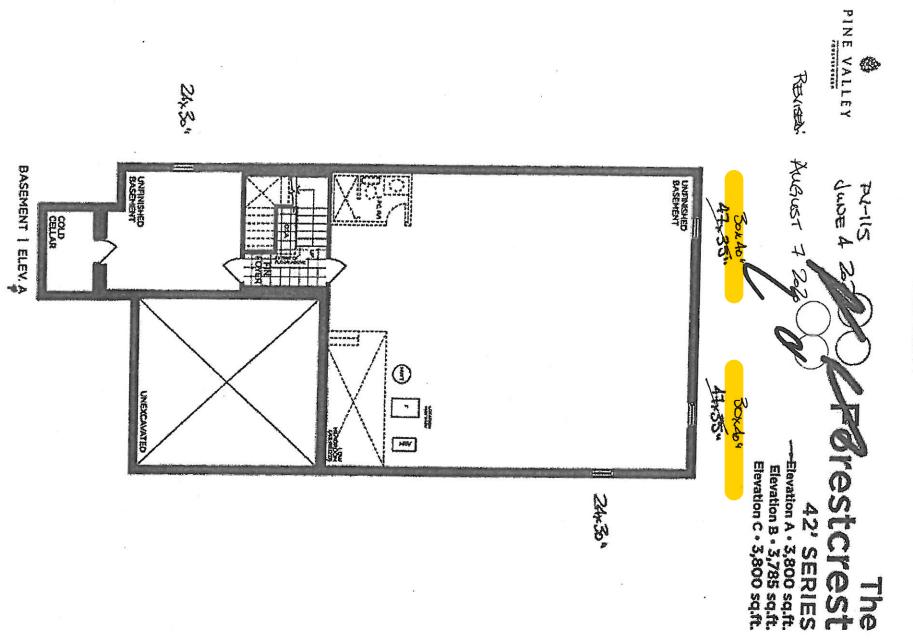

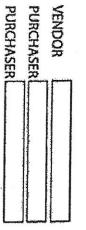

### GOLDPARK WORTH MORE

Pricts, figures, illustrasions, sizes, features and finishes are subject to change without notice. Areas and dimensions are approximate and exhibit usable floor space may vary from the stated area, Layout may be reverse of the unit purchasets, E. & Q.E. (202).