

INTERIOR DOORS AND TRIM		
Invoice	Qty.	Description
2438 72,402 14Sep20	1	STUDY: MODEL OPTIONS 40.03 - STUDY - OPT. 8 FOOT HIGH DOUBLE FRENCH DOORS WITH FLAT CLEAR GLASS COMPLETE WITH BUILDERS STANDARD OFFERINGS

INTERIOR TRIM AND DOORS		
Invoice	Qty.	Description
2438 14Sep20 NoCat	1	.BREAKFAST ROOM: UPGRADE TO 96" EXTERIOR FRENCH DOOR ASSEMBLY

KITCHEN AND BATH CABINETRY		
Invoice	Qty.	Description
2438 14Sep20 NoCat	1	KITCHEN: *NOTE* ROTATE ISLAND - SEE PLAN FOR LOCATION
2438 14Sep20 NoCat	1	KITCHEN: FIXTURE: UNDER CABINET FLUORESCENT LIGHT FIXTURES - DOES NOT INCLUDE (AND REQUIRES) LIGHT VALANCE

MASONRY		
Invoice	Qty.	Description
2438 14Sep20 NoCat	7	FRONT EXTERIOR ELEVATION: EXTERIOR LED SOFFIT POT LIGHT - EACH - SEE ATTACHED DRAWING FOR LOCATION UPPER SOFFIT AT CURVED WINDOWx 2 UPPER SOFFIT AT BALCONY x2 CENTERED ABOVE GARAGE DOORS (in lieu of std coach lights) x2 CENTERED IN PORTICO CEILING x1

NETWORK AND WIRING		
Invoice	Qty.	Description
2438 72,259 14Sep20	1	GREAT ROOM: CONDUIT PIPE - FOR WALL MOUNT TV - LOCATE APPROX 66" A.F.F. ABOVE FIREPLACE, THRU BASEMENT, TERMINATE BY CABLE
2438 72,258 14Sep20	1	GREAT ROOM: ADDITIONAL CAT6 ETHERNET OUTLET - EACH SEE PLAN
2438 72,258 14Sep20	1	STUDY: ADDITIONAL CAT6 ETHERNET OUTLET - EACH SEE PLAN
2438 72,258 14Sep20	1	MEDIA ROOM: ADDITIONAL CAT6 ETHERNET OUTLET - EACH SEE PLAN

**Lot: 143****Model: 40.03 B BROOKSIDE****Project/Phase: Pine Valley Forevergreen / 1**

PAINT

Invoice	Qty.	Description
2438 14Sep20 NoCat	1	.GREAT ROOM: MODEL OPTIONS 40.03 - GREAT ROOM - OPT. COFFERED CEILING AS PER PLAN INCLUDED IN APS
2438 14Sep20 NoCat	1	.BREAKFAST ROOM: UPGRADE TO 96" EXTERIOR FRENCH DOOR ASSEMBLY

PLUMBING FIXTURES

Invoice	Qty.	Description
2438	1	MASTER ENSUITE: MOEN 'ARRIS' 3-FUNCTION RAIN SHOWER (from ceiling) + HAND SHOWER + SLIDE BAR - CHROME #TS22002EP/3372/TS23005/62320/3887EP/A725116651
14Sep20 NoCat		

WINDOWS AND DOORS

Invoice	Qty.	Description
2438	1	BREAKFAST ROOM: UPGRADE TO 96" EXTERIOR FRENCH DOOR ASSEMBLY
14Sep20 NoCat		

SCHEDULE 'F'




PV-143. Sept. 2 2020 See attach.

The Brookside

40' SERIES

Elevation A • 3,380 sq.ft.
Elevation B • 3,350 sq.ft.

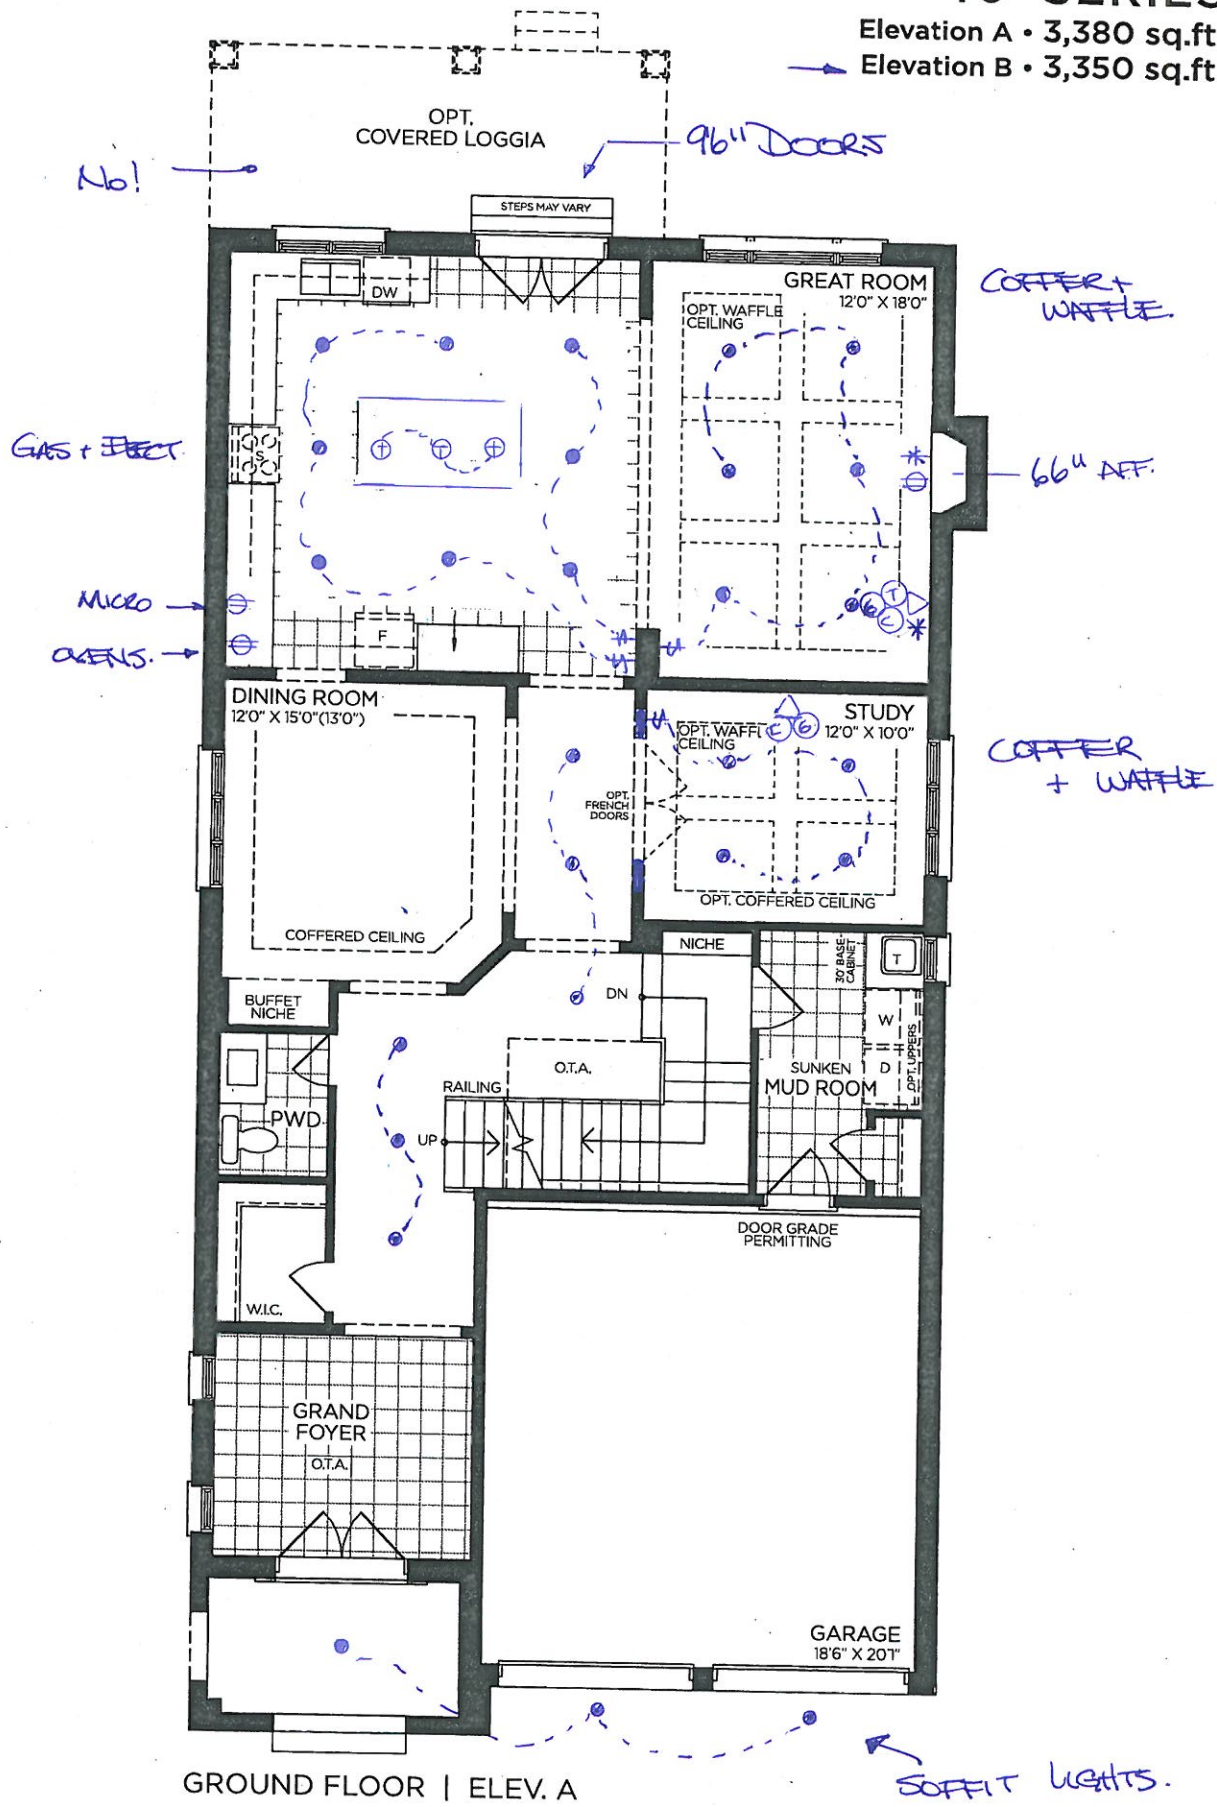

GROUND FLOOR | ELEV. A

VENDOR

PURCHASER

PURCHASER

GOLDPARK
WORTH MORE™

Prices, figures, illustrations, sizes, features and finishes are subject to change without notice. Areas and dimensions are approximate and actual usable floor space may vary from the stated area. Layout may be reverse of the unit purchased. E. & O.E. 4003

SCHEDULE 'F'




PV-143
Sept. 2 2020
See sketch.

The Brookside
40' SERIES

Elevation A • 3,380 sq.ft.
→ Elevation B • 3,350 sq.ft.

GA

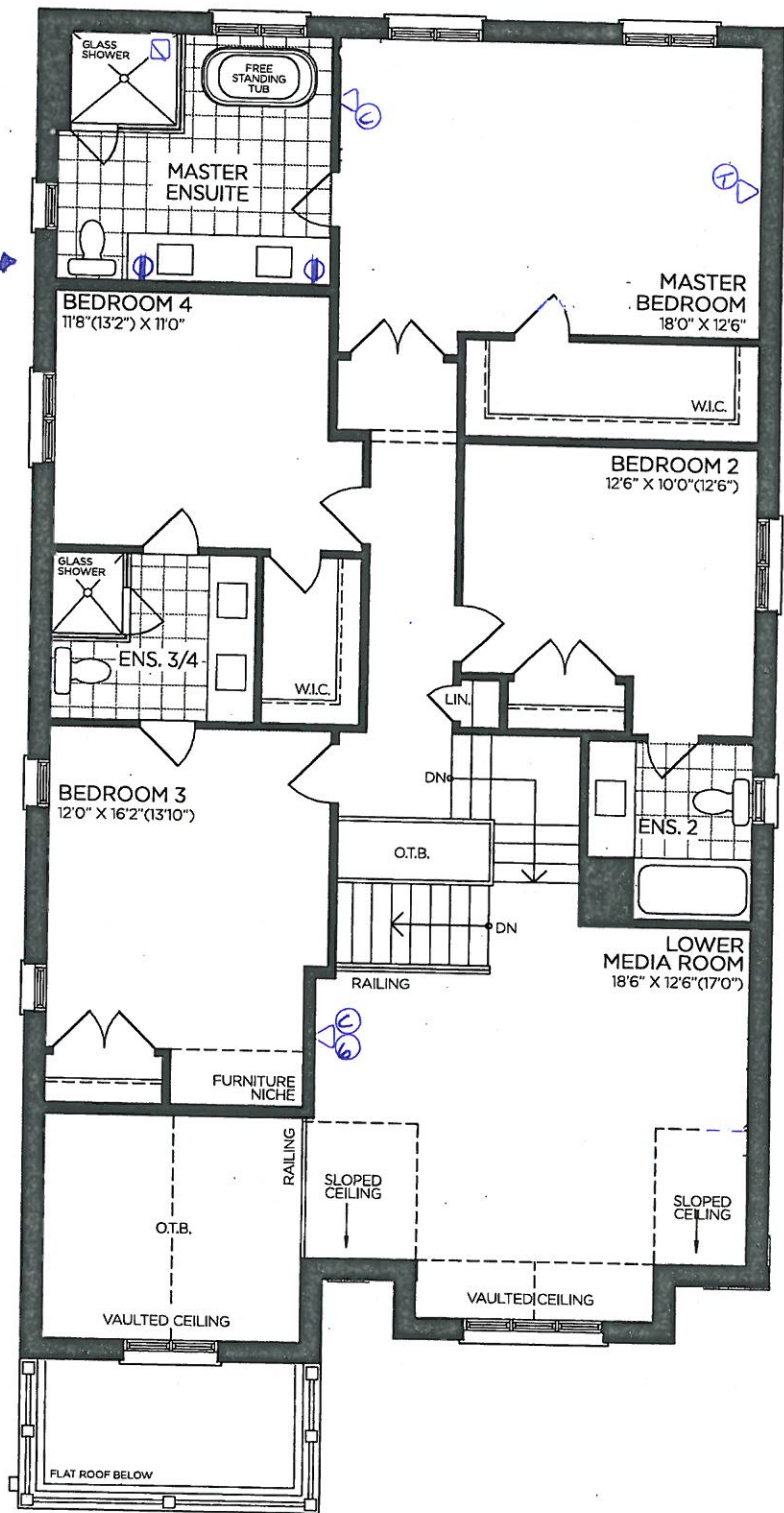

No PHONES in
B 2/3/4

SECOND FLOOR | ELEV. A

VENDOR	
PURCHASER	
PURCHASER	

GOLDPARK
WORTH MORE™

Prices, figures, illustrations, sizes, features and finishes are subject to change without notice. Areas and dimensions are approximate and actual usable floor space may vary from the stated area. Layout may be reverse of the unit purchased. E. & O.E. 4003



SCHEDULE 'F'

PV-143

Sept. 2 2020

on attach.

The Brookside


40' SERIES

Elevation A • 3,380 sq.ft.

→ Elevation B • 3,350 sq.ft.

W.O.D.

STD.
16x30" →

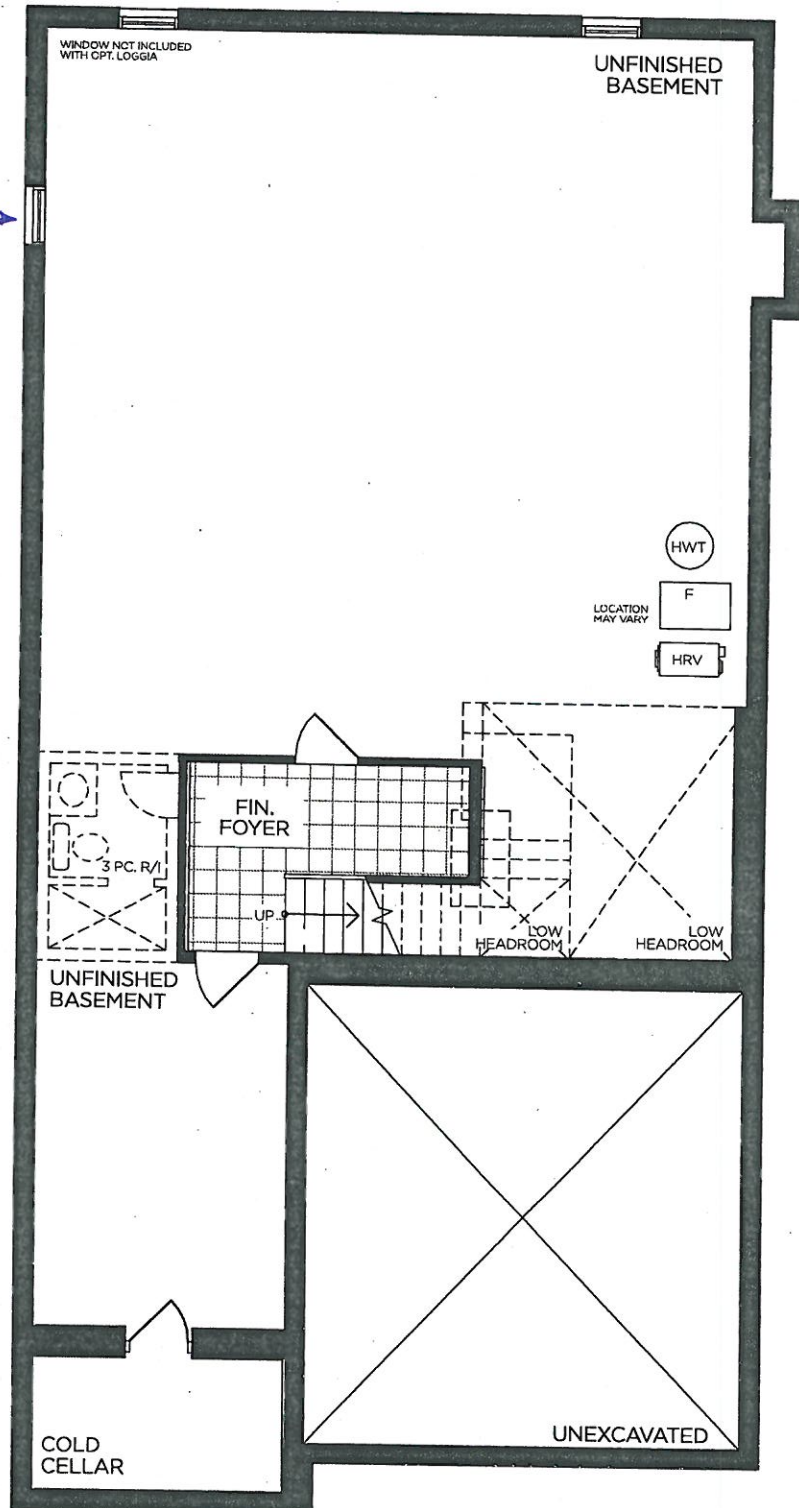

BASEMENT | ELEV. A

VENDOR

PURCHASER

PURCHASER

GOLDPARK

WORTH MORE™

Prices, figures, illustrations, sizes, features and finishes are subject to change without notice. Areas and dimensions are approximate and actual usable floor space may vary from the stated area. Layout may be reverse of the unit purchased. E. & O.E. 4003



SCHEDULE 'F'

PV-143.

Sept. 2, 2020


on attach.

The Brookside


40' SERIES

Elevation A • 3,380 sq.ft.


→ Elevation B • 3,350 sq.ft.

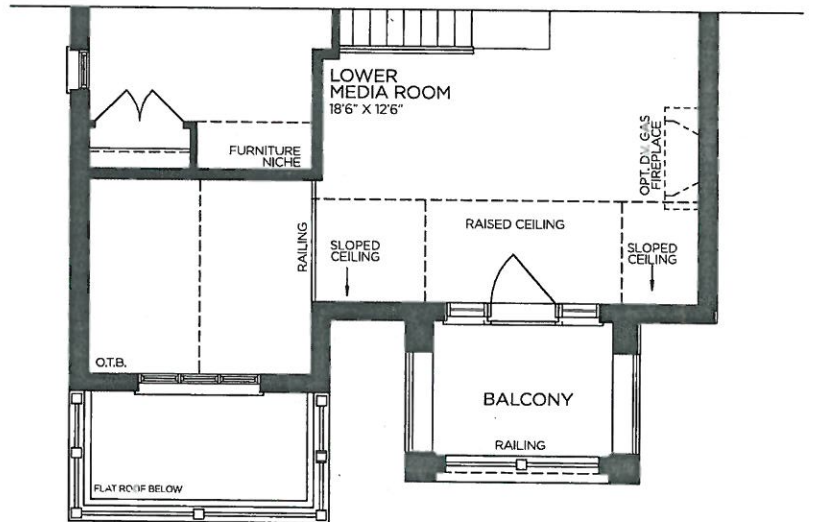


→ PART. SECOND FLOOR | ELEV. B

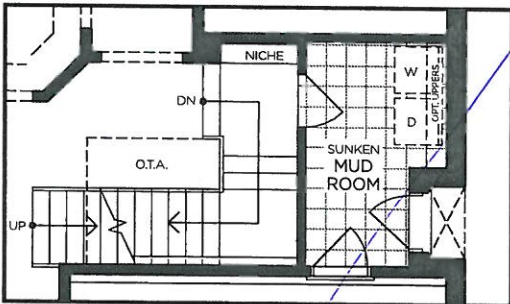

PART. OPT. GROUND FLOOR
W/ OPT. SIDE ENTRANCE | ELEV. A
(ELEV. B SIMILAR)

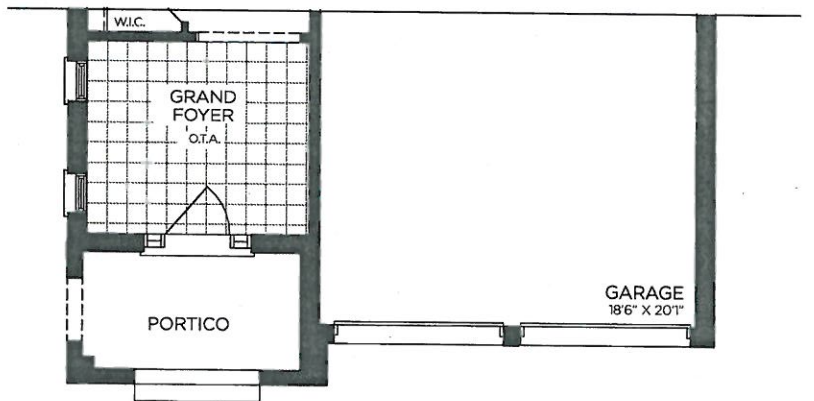

→ PART. GROUND FLOOR | ELEV. B

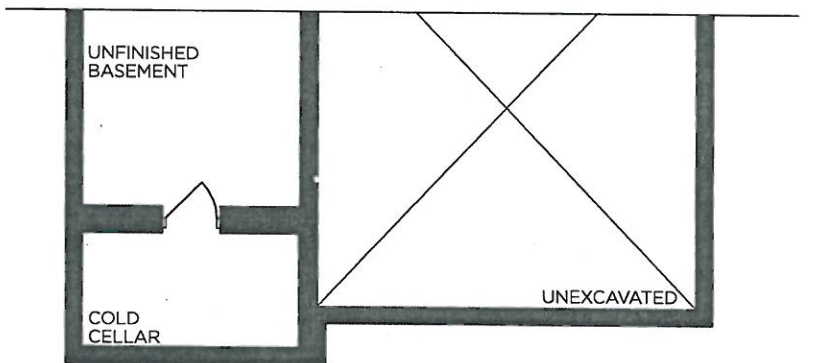

→ PART. BASEMENT | ELEV. B

VENDOR	<input type="text"/>
PURCHASER	<input type="text"/>
PURCHASER	<input type="text"/>

GOLDPARK
WORTH MORE™

Prices, figures, illustrations, sizes, features and finishes are subject to change without notice. Areas and dimensions are approximate and actual usable floor space may vary from the stated area. Layout may be reverse of the unit purchased. E. & O.E. 4003



PLUMBING UPGRADES

POSI-TEMP TUB/SHOWER FAUCET W/3 FUNCTION TRANSFER
VALVE/TRIM AND SLIDE BAR W/HANDSHOWER

MOEN - ARRIS





- ☒ CHROME
- ☐ BRUSHED NICKEL
- ☐ MATTE BLACK
- ☐ from WALL
- ☒ from CEILING
- Ceiling Shower Arm:

→ Chrome (116651)

Matte Black (116651WR)

MODEL TS22003EP / 3372 / 128284 / TS23005 / 62320 / 3887EP / A725

Lot# 143		
Room: MASTER ENSUITE	Signature:  See attach.	
Date: Sept. 2 2020	Signature: 	



Elevation B - 3,350 sq.ft.

PV-143

Sept. 2, 2020

2020
Sept. 2, 2020


SCHEDULE 'F'



PV-143. *AP*
 Sept. 2 2020 *(initials)*

The Brookside 40' SERIES

Elevation A • 3,380 sq.ft.
 Elevation B • 3,350 sq.ft.

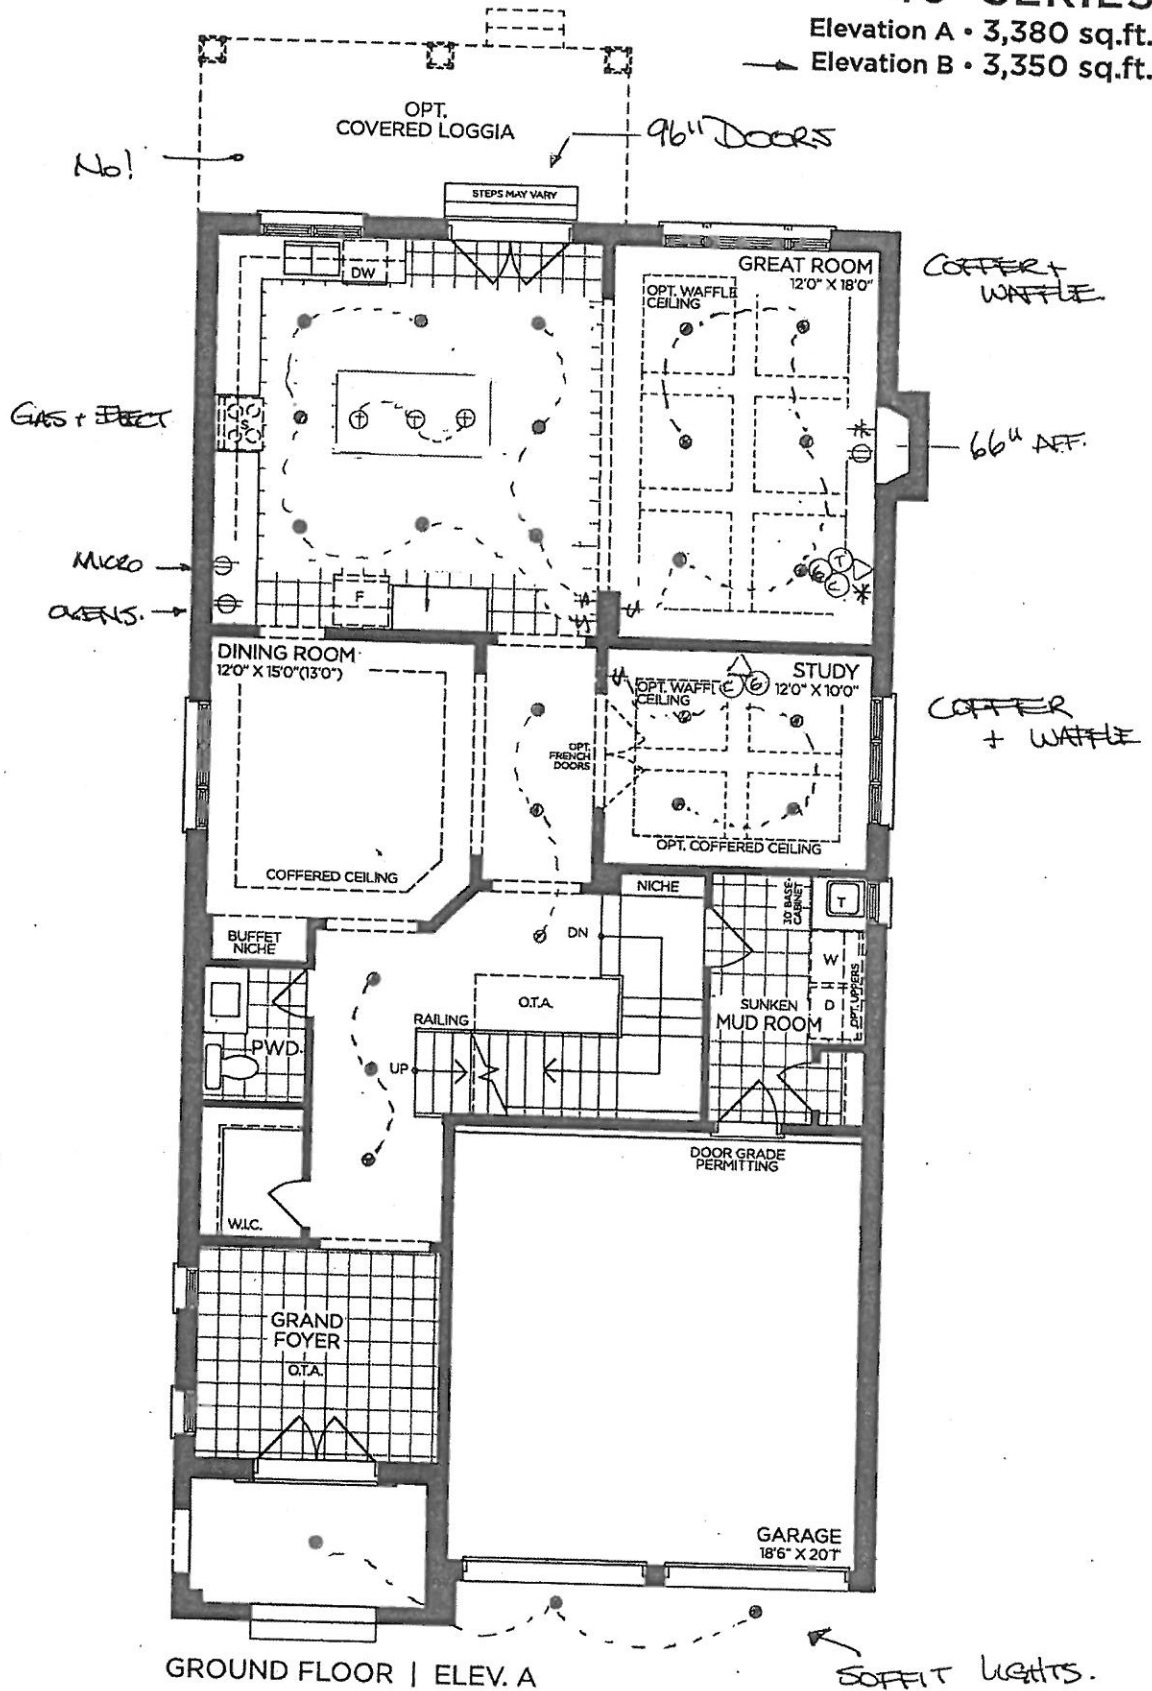

VENDOR

PURCHASER

PURCHASER

GOLDPARK
 WORTH MORE™

Prices, figures, illustrations, sizes, features and finishes are subject to change without notice. Areas and dimensions are approximate and actual usable floor space may vary from the stated area. Layout may be reverse of the unit purchased. E. & O.E. 4003


SCHEDULE 'F'



PV-143 ^{AP}
 Sept. 2 2020

The Brookside 40' SERIES

Elevation A • 3,380 sq.ft.
 → Elevation B • 3,350 sq.ft.

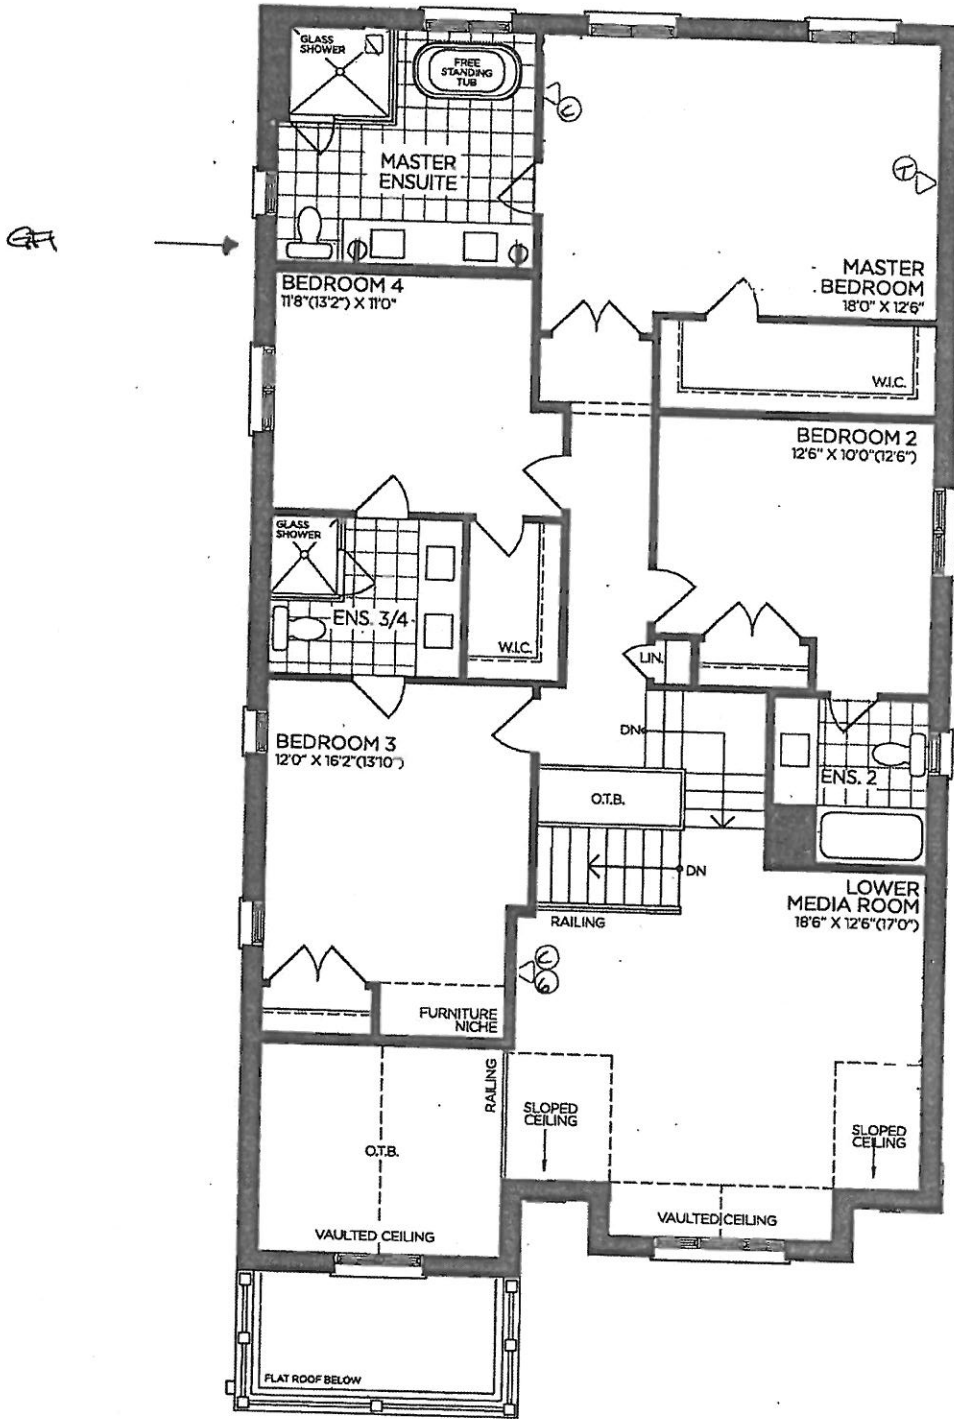

No PHONES in
 B 2/3/4

SECOND FLOOR | ELEV. A

VENDOR

PURCHASER

PURCHASER

GOLDPARK
 WORTH MORE™

Prices, figures, illustrations, sizes, features and finishes are subject to change without notice. Areas and dimensions are approximate and actual usable floor space may vary from the stated area. Layout may be reverse of the unit purchased. E. & O.E. 4003



SCHEDULE 'F'

PV-143
Sept. 2 2020

AP

Handwritten initials in a circle


The Brookside

40' SERIES

Elevation A • 3,380 sq.ft.
→ Elevation B • 3,350 sq.ft.

Wob.

STD.
16x30" →

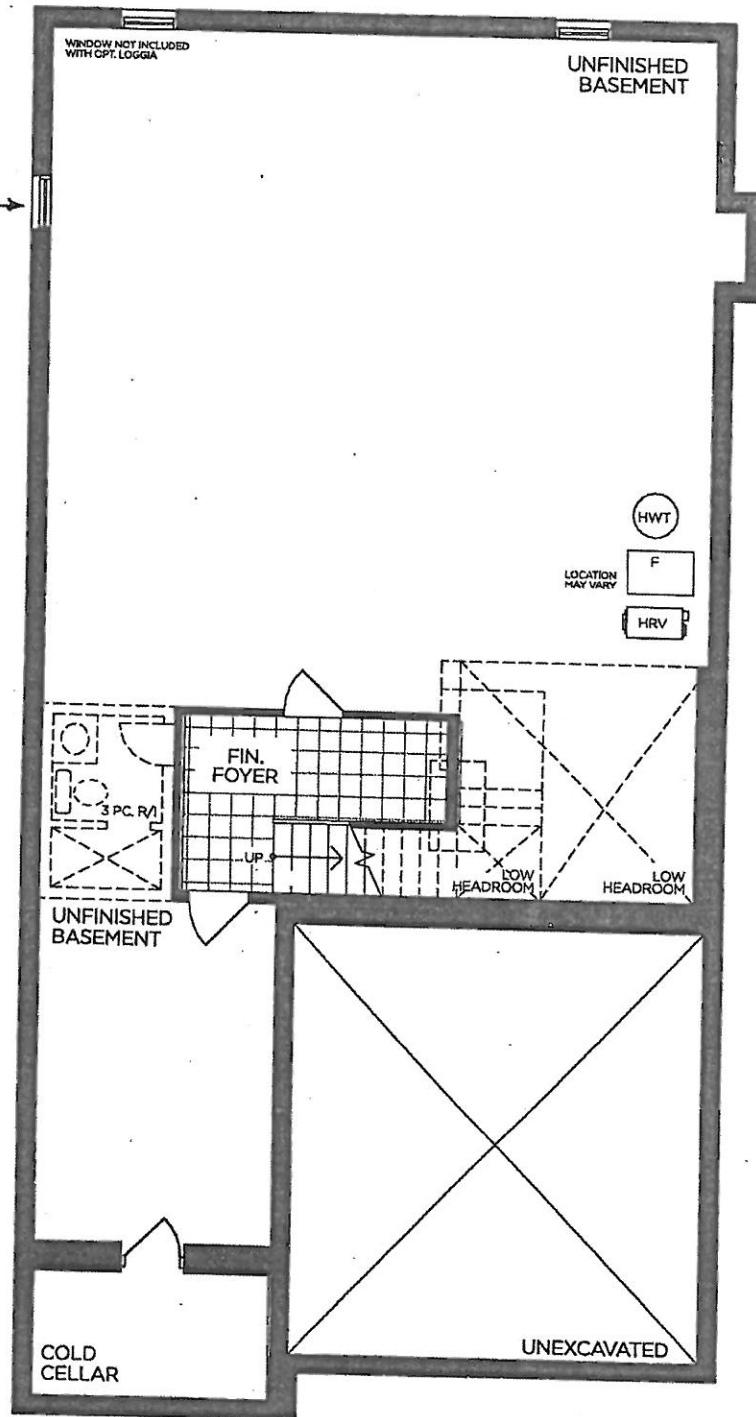

BASEMENT | ELEV. A

VENDOR	<input type="text"/>
PURCHASER	<input type="text"/>
PURCHASER	<input type="text"/>

GOLDPARK

WORTH MORE™

Prices, figures, illustrations, sizes, features and finishes are subject to change without notice. Areas and dimensions are approximate and actual usable floor space may vary from the stated area. Layout may be reverse of the unit purchased. E. & O.E. 4003




SCHEDULE 'F'

PV-143. ^{AP} _{DF}
Sept. 2, 2020


The Brookside 40' SERIES

Elevation A • 3,380 sq.ft.


→ Elevation B • 3,350 sq.ft.

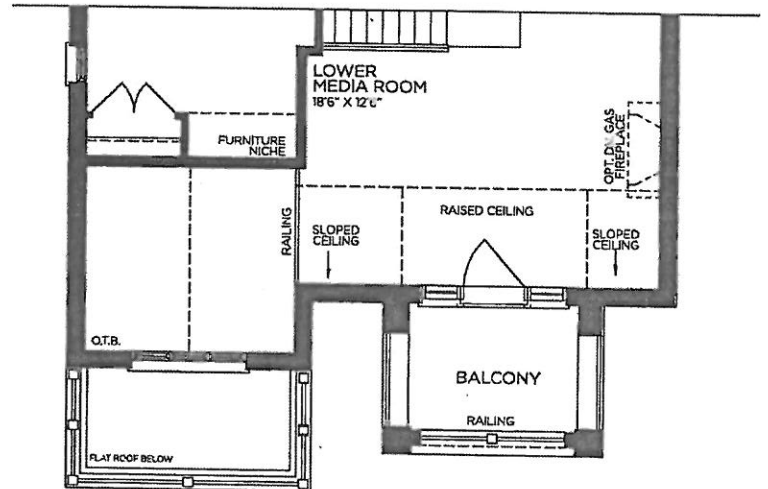


→ PART. SECOND FLOOR | ELEV. B

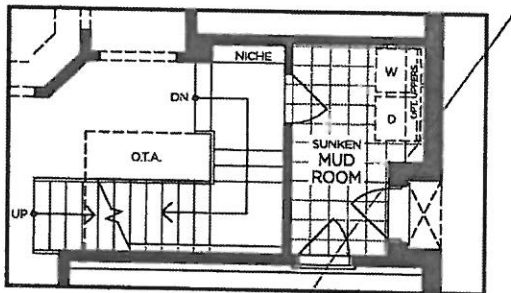

PART. OPT. GROUND FLOOR
W/ OPT. SIDE ENTRANCE | ELEV. A
(ELEV. B SIMILAR)

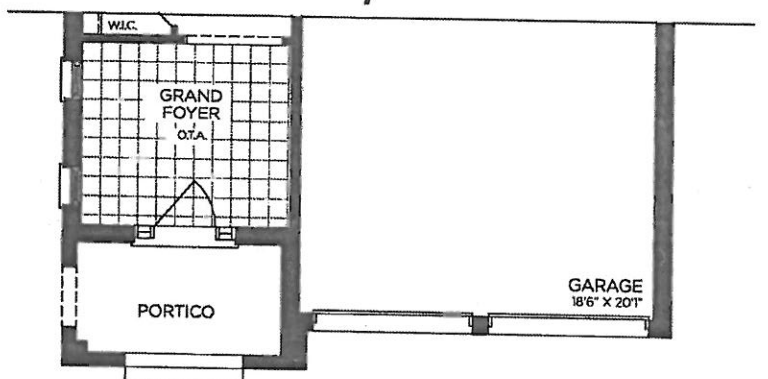

→ PART. GROUND FLOOR | ELEV. B

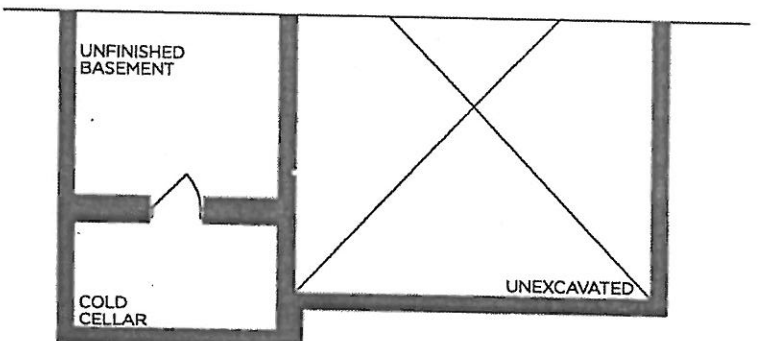

→ PART. BASEMENT | ELEV. B

VENDOR
PURCHASER
PURCHASER


GOLDPARK
WORTH MORE™

Prices, figures, illustrations, sizes, features and finishes are subject to change without notice. Areas and dimensions are approximate and actual usable floor space may vary from the stated area. Layout may be reverse of the unit purchased. E. & O.E. 4003

PLUMBING UPGRADES

POSI-TEMP TUB/SHOWER FAUCET W/3 FUNCTION TRANSFER
VALVE/TRIM AND SLIDE BAR W/HANDSHOWER

MOEN - ARRIS

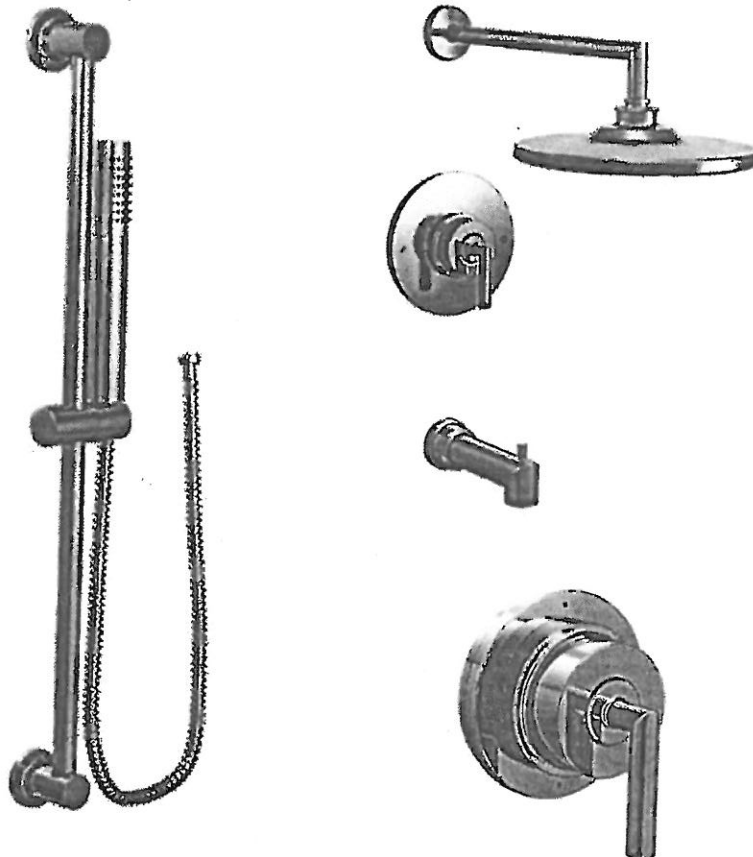

☒ CHROME

☐ BRUSHED NICKEL

☐ MATTE BLACK

☐ from WALL

☒ from CEILING
Ceiling Shower Arm:

→ Chrome (116651)
Matte Black (116651WR)

MODEL TS22003EP / 3372 / 128284 / TS23005 / 62320 / 3887EP / A725

Lot#

143

Room:

MASTER ENSUITE

Signature:



Date:

Sept. 2 2020

Signature:





Elevation B - 3,350 sq.ft.

PV-143 (AP)
Sept. 2, 2020 (JK)