

GOLDPARK

WORTH MORE™

CONSTRUCTION SUMMARY

Lot: 150

Model: 40.00 A BRIARWOOD

Project/Phase: Pine Valley Forevergreen / 1

APPLIANCES		
Invoice	Qty.	Description
2331	1	See attached signed appliance specifications. Fridge/bottom mount freezer, double electric free standing range, beverage fridge, dishwasher, washer/dryer with pedestals.
15Sep20 NoCat		**See attached signed appliance specifications**

CERAMIC		
Invoice	Qty.	Description
2331	1	.MASTER ENSUITE: DELETE WALL AND DOOR AT WATER CLOSET
24Jul20 NoCat		
2331	1	.MASTER ENSUITE: SHOWER NICHE [SHAMPOO SHELF] - COMPLETE WITH MATCHING MARBLE JAMBS ON 4 SIDES, STANDARD TILE, APPROX. 12 X 18 INSTALLED VERTICALLY - SEE PLAN
24Jul20 NoCat		

CONCRETE AND DRAIN		
Invoice	Qty.	Description
2304	1	.BACK-FLOW PREVENTER VALVE
24Jul20 NoCat		

DRYWALL		
Invoice	Qty.	Description
2304	4	.BASEMENT WINDOWS - UPGRADE BASEMENT WINDOW SIZE TO 30 " X 24" - 8" FRAME (QTY:4)
24Jul20 NoCat		
2331	1	.MASTER ENSUITE: DELETE WALL AND DOOR AT WATER CLOSET
24Jul20 NoCat		
2331	1	.GREAT ROOM: FIREPLACE
24Jul20 NoCat		
2331	1	.**CUSTOM LAYOUT** CHANGE LINEN CLOSET TO 1/2 LINEN + HALF PANTRY WITH 2 DOORS ACCESSIBLE FROM KITCHEN, COMPLETE WITH 4 FIXED SHELVES ON PANTRY SIDE
24Jul20 NoCat		
2331	1	MASTER BEDROOM: RELOCATE DOOR TO ENSUITE TO CREATE LARGER WALK-IN CLOSET (7` closet, if possible - REDUCE SIZE OF ENSUITE DOOR, IF NECESSARY)
24Jul20 NoCat		
2331	1	.**CUSTOM LAYOUT** INCREASE NIBB WALLS TO APPROX. 30" WIDE AT BREAKFAST / GREAT ROOM + SERVERY- -SEE PLAN FOR LOCATION
24Jul20 NoCat		

DisciplineMS.rpt 26jun20

Page 1 of 7
Printed and Sent: 15-Sep-20

GOLDPARK

WORTH MORE™

CONSTRUCTION SUMMARY

Lot: 150

Model: 40.00 A BRIARWOOD

Project/Phase: Pine Valley Forevergreen / 1

ELECTRICAL

Invoice	Qty.	Description
2331 72,310 24Jul20	2	.UPPER HALL: UPGRADE STANDARD CEILING MOUNT FIXTURE TO (1) LED POT LIGHT - SECOND FLOOR - SEE PLAN FOR LOCATION
2331 72,290 24Jul20	6	.UPPER HALL: 4" E/S LED INTERIOR POT LIGHT (INSULATED CEILING) - SECOND FLOOR - EACH USE STANDARD SWITCHES
2331 24Jul20 NoCat	1	.GREAT ROOM: FIREPLACE - ADD HEAT ACTIVATED FAN

EXTERIOR COLOURS

Invoice	Qty.	Description
2331 24Jul20 NoCat	1	EXTERIOR COLOUR PACKAGE # BR.1

FIREPLACE

Invoice	Qty.	Description
2331 24Jul20 NoCat	1	.GREAT ROOM: FIREPLACE - ADD HEAT ACTIVATED FAN

FORMING

Invoice	Qty.	Description
2304 24Jul20 NoCat	4	.BASEMENT WINDOWS - UPGRADE BASEMENT WINDOW SIZE TO 30 " X 24" - 8" FRAME (QTY:4)

DisciplineMS.rpt 26jun20

Page 2 of 7
Printed and Sent: 15-Sep-20

2
SCHEDULE 'F'



PV-150

MAY 28 2020

PV-150


June 2, 2020

See attached.

The Briarwood

40' SERIES

→ Elevation A • 2,870 sq.ft.
Elevation B • 2,860 sq.ft.

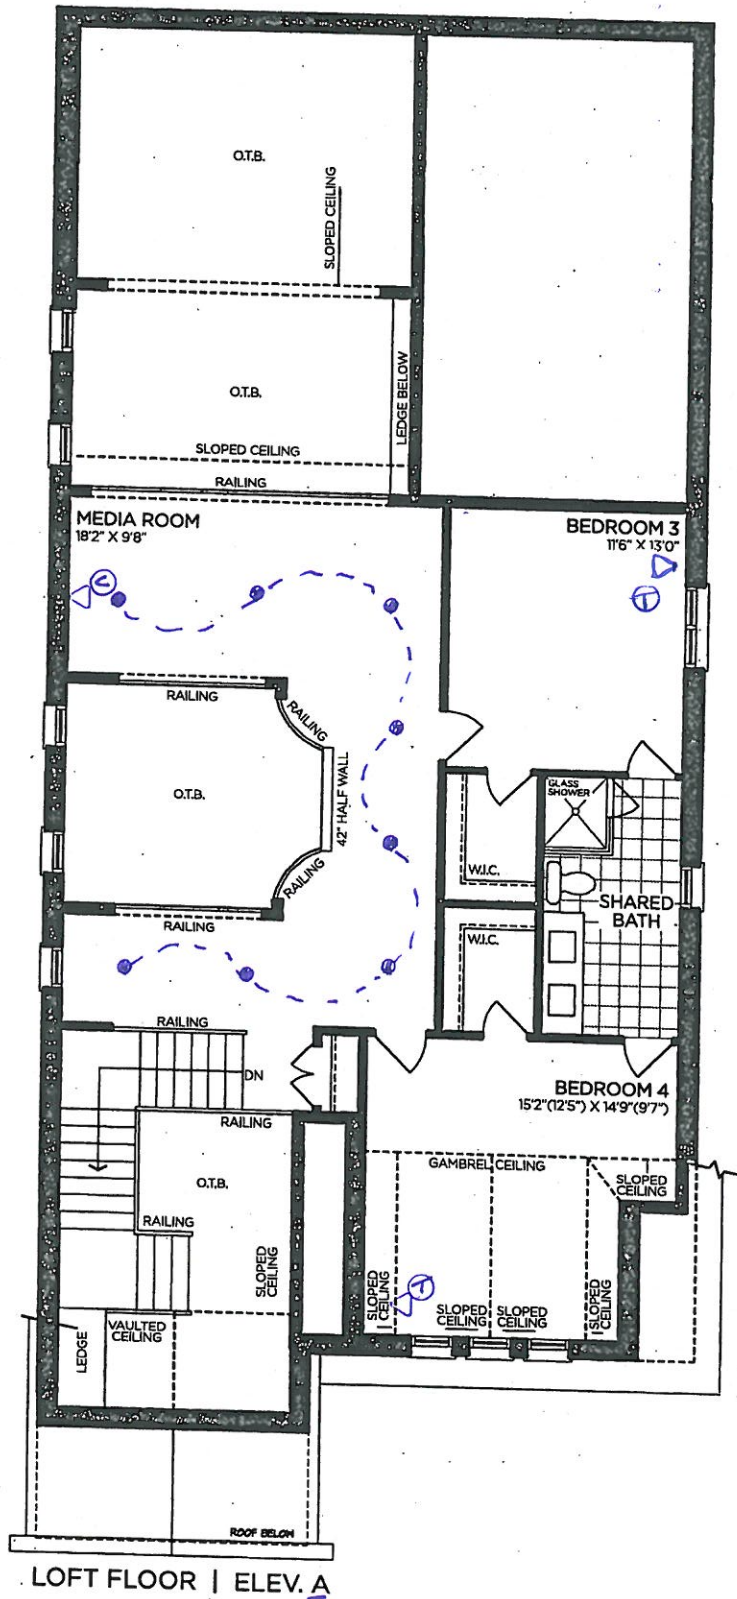

VENDOR

PURCHASER

PURCHASER

GOLDPARK
WORTH MORE™


Prices, figures, illustrations, sizes, features and finishes are subject to change without notice. Areas and dimensions are approximate and actual usable floor space may vary from the stated area. Layout may be reverse of the unit purchased. E. & O.E. 4000

SCHEDULE 'F'



PV-150
 MAY 28 2020
 PV-150
 June 2, 2020

The
Briarwood
 40' SERIES
 → Elevation A - 2,870 sq.ft.
 Elevation B - 2,860 sq.ft.

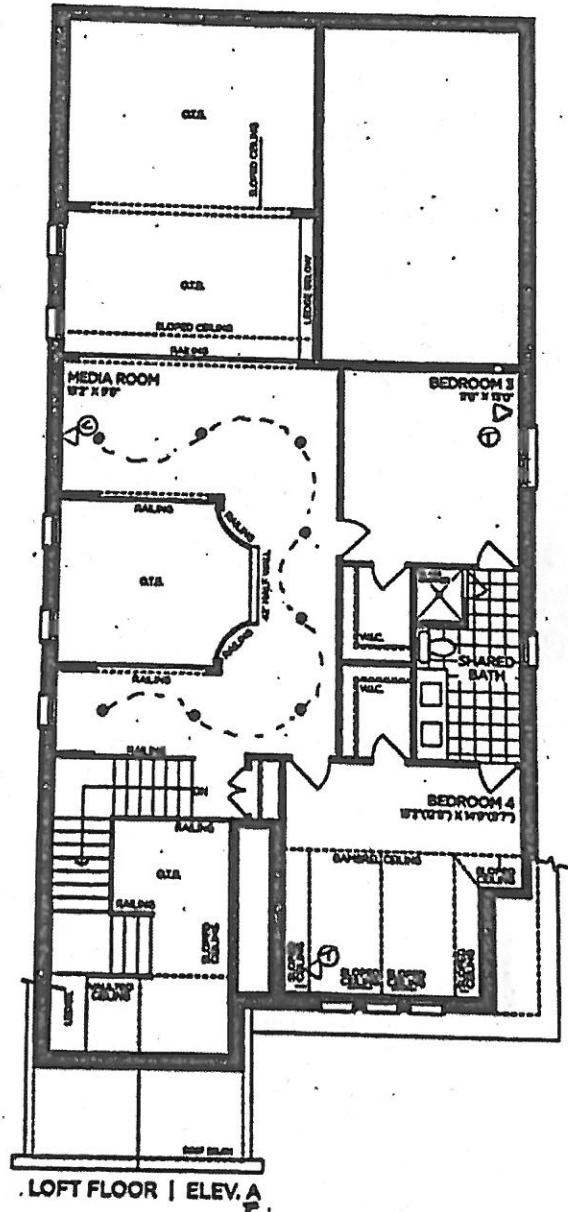

VENDOR

PURCHASER

PURCHASER

GOLDPARK
 WORTH MORE

Prices, figures, illustrations, sizes, features and finishes are subject to change without notice. Areas and dimensions are approximate and actual usable floor space may vary from the stated area. Layout may be reverse of the unit purchased. E. & O.B. 4000



Model: 40.00 A BRIARWOOD

Project/Phase: Pine Valley Forevergreen / 1

PAINT

Invoice	Qty.	Description
2331 24Jul20 NoCat	1	.MASTER ENSUITE: DELETE WALL AND DOOR AT WATER CLOSET
2331 24Jul20 NoCat	1	.GREAT ROOM: FIREPLACE
2331 24Jul20 NoCat	1	.**CUSTOM LAYOUT** CHANGE LINEN CLOSET TO 1/2 LINEN + HALF PANTRY WITH 2 DOORS ACCESSIBLE FROM KITCHEN, COMPLETE WITH 4 FIXED SHELVES ON PANTRY SIDE
2331 24Jul20 NoCat	1	MASTER BEDROOM: RELOCATE DOOR TO ENSUITE TO CREATE LARGER WALK-IN CLOSET (7' closet, if possible - REDUCE SIZE OF ENSUITE DOOR, IF NECESSARY)
2331 24Jul20 NoCat	1	.**CUSTOM LAYOUT** INCREASE NIBB WALLS TO APPROX. 30" WIDE AT BREAKFAST / GREAT ROOM + SERVERY- -SEE PLAN FOR LOCATION

PLUMBING

Invoice	Qty.	Description
2304 24Jul20 NoCat	1	.BACK-FLOW PREVENTER VALVE
2331 72,332 24Jul20	1	.KITCHEN: ROUGH-IN 1/4" COLD WATER LINE TO FRIDGE
2331 24Jul20 NoCat	1	.MASTER ENSUITE: DELETE WALL AND DOOR AT WATER CLOSET

WINDOWS - BASEMENT

Invoice	Qty.	Description
2304 72,351 24Jul20	4	.BASEMENT WINDOWS - UPGRADE BASEMENT WINDOW SIZE TO 30 " X 24" - 8" FRAME (QTY:4)

SCHEDULE 'F'




PV-150

MAY 28 2020

[Handwritten signatures and initials]

The Briarwood 40' SERIES

→ Elevation A • 2,870 sq.ft.
Elevation B • 2,860 sq.ft.

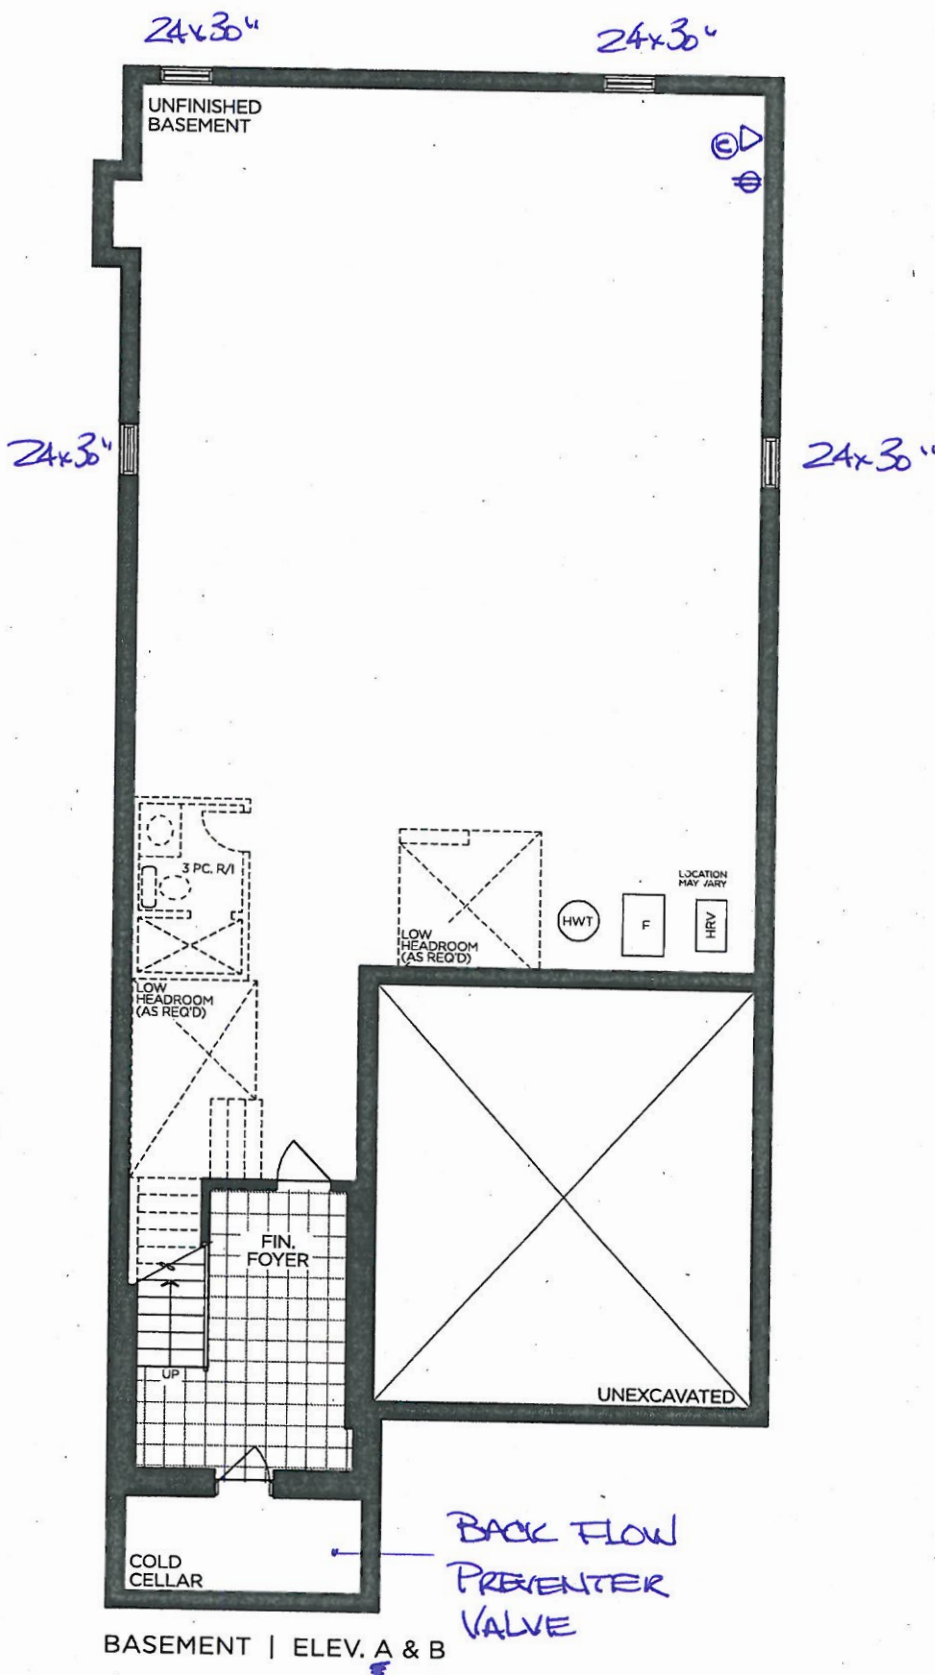

VENDOR

PURCHASER


PURCHASER

GOLDPARK
WORTH MORE™

Prices, figures, illustrations, sizes, features and finishes are subject to change without notice. Areas and dimensions are approximate and actual usable floor space may vary from the stated area. Layout may be reverse of the unit purchased. E. & O.E. 4000

AL-150 *DD* *AK*
MAY 28 2026

This Plan shows
opt Ground floor.

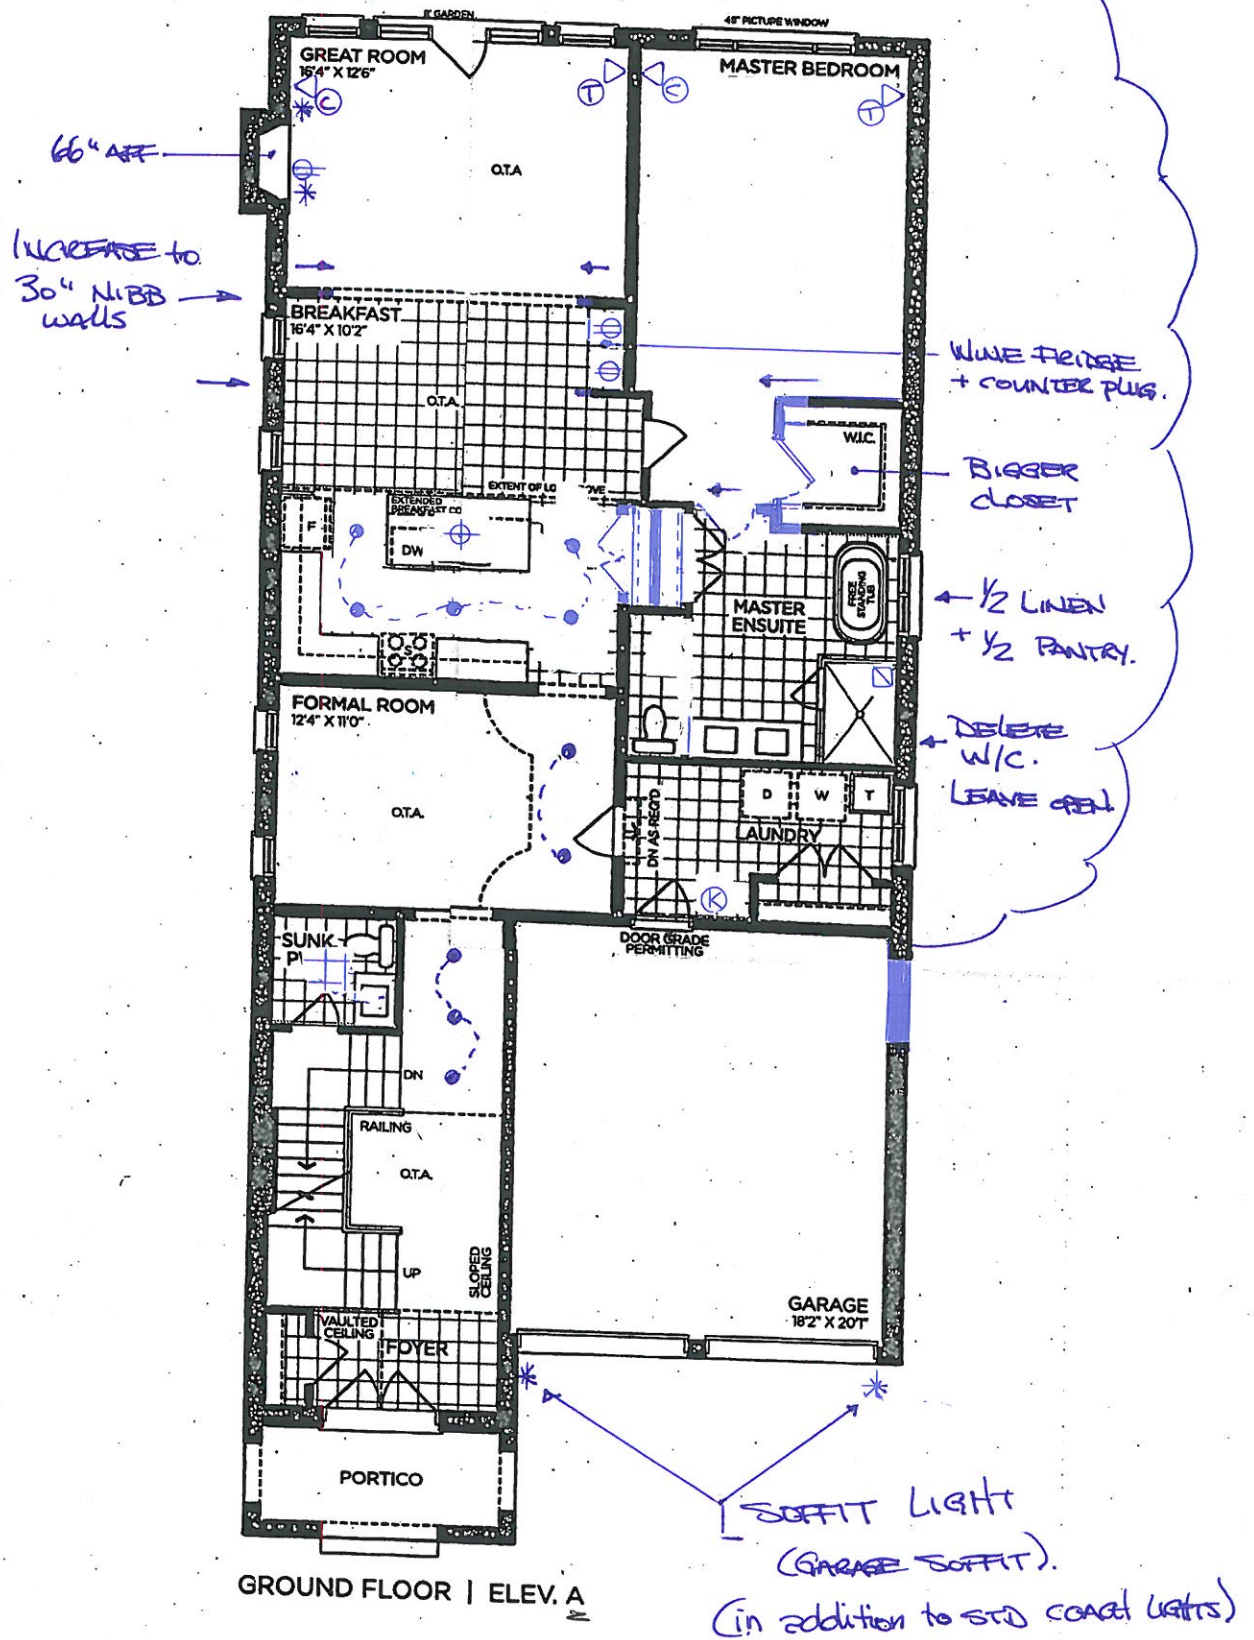

GROUND FLOOR | ELEV. A

VENDOR
PURCHASER
PURCHASER

GOLDPARK
WORTH MORE™

Prices, figures, illustrations, sizes, features and finishes are subject to change without notice. Areas and dimensions are approximate and actual usable floor space may vary from the stated area. Layout may be reverse of the unit purchased. E. & O.E. 4000

SCHEDULE 'F'




PV-150
MAY 28 2020

The Briarwood

40' SERIES

→ Elevation A • 2,870 sq.ft.
Elevation B • 2,860 sq.ft.

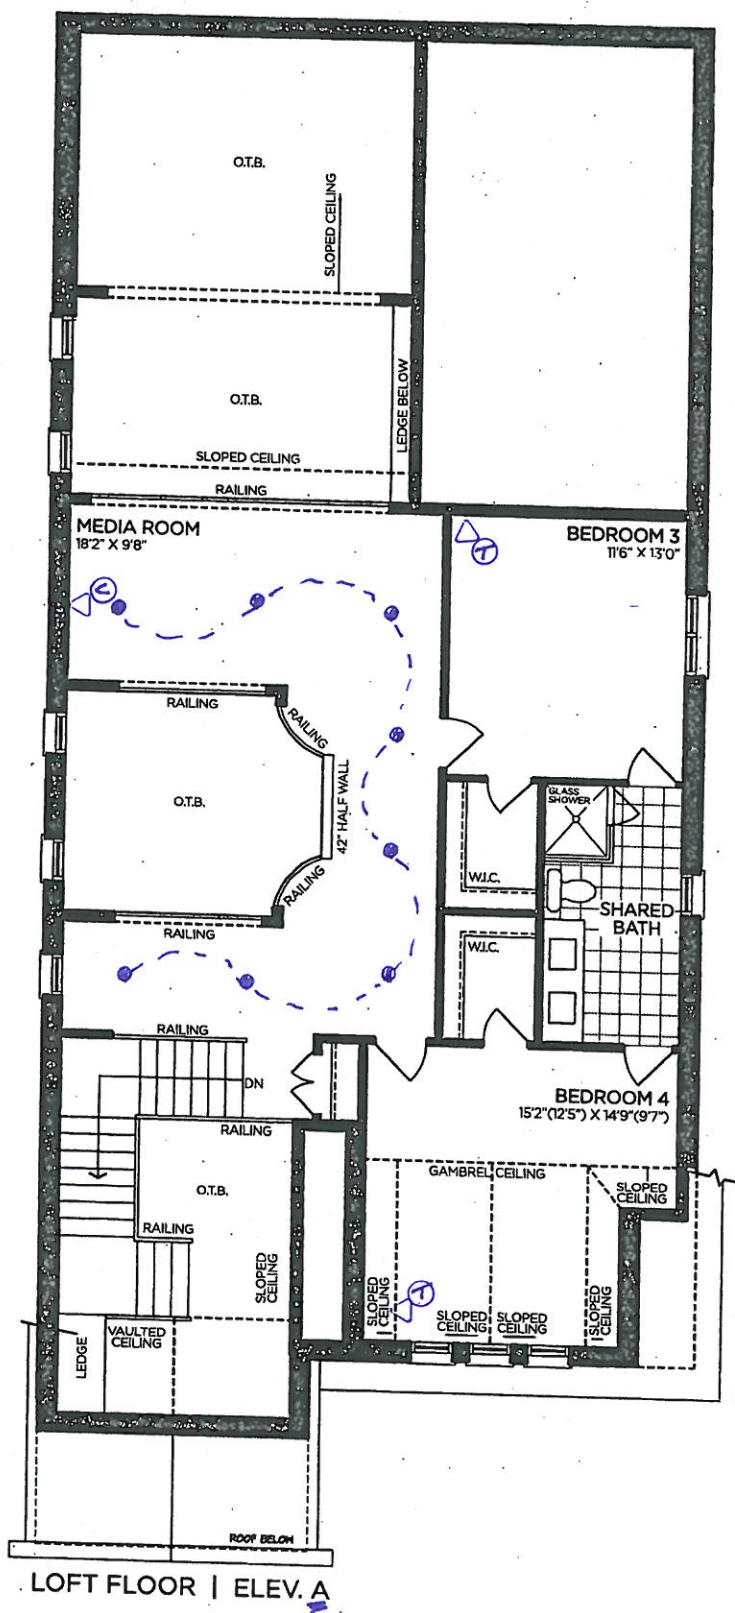

VENDOR

PURCHASER

PURCHASER

GOLDPARK

WORTH MORE™

Prices, figures, illustrations, sizes, features and finishes are subject to change without notice. Areas and dimensions are approximate and actual usable floor space may vary from the stated area. Layout may be reverse of the unit purchased. E. & O.E. 4000