

CONSTRUCTION SUMMARY

Lot: 110

Model: 38-9 Elev.B PUCCINI OPT - GFA1

Project/Phase: Brampton Encore / 2

APPLIANCES		
Invoice	Qty.	Description
2173 30745 26May20 NoCat	1	PACKAGE OF 5 APPLIANCES - STAINLESS STEEL FRIDGE/ RANGE/ DISHWASHER + WHITE WASHER/DRYER-MODEL INCLUDED IN APS

CENTRAL VAC AND WIRING		
Invoice	Qty.	Description
2173 30747 26May20	1	CONDUIT PIPE- FROM ATTIC TO ELECTRICAL PANEL- LOCATE APPROX CENTER OF ATTIC
2173 30751 26May20	1	THRU OUT: ADD CAT6 WIRING - SEE PLAN FOR LOCATIONS. (TOTAL OF 12 CAT6) ***purchaser to deal directly with Martco Wiring to discuss locations*** **3 x PACKAGE PRICE**

CERAMIC		
Invoice	Qty.	Description
2173 30782 26May20 NoCat	1	FOYER / POWDER ROOM / KITCHEN / LOWER LANDING AT GROUND FLOOR: UPGRADE 5 - 24X24" FLOOR TILE
2173 30783 26May20 NoCat	1	GROUND FLOOR BATH: UPGRADE 5 FLOOR TILE - 24X24"

CONCRETE AND DRAIN		
Invoice	Qty.	Description
2116 29706 26May20 **	1	ROUGH-IN - 3PC BASEMENT ROUGH-IN

DRYWALL		
Invoice	Qty.	Description
2173 34082 26May20 NoCat	1	MASTER BEDROOM: OPTIONAL 10 FOOT TRAY CEILING - MASTER BEDROOM (AS PER PLAN)
2173 34086 26May20 NoCat	1	MAIN FLOOR: EXTENDED HEIGHT ARCHWAY - 96"

GOLDPARK

WORTH MORE™

CONSTRUCTION SUMMARY

Lot: 110

Model: 38-9 Elev.B PUCCINI OPT - GFA1

Project/Phase: Brampton Encore / 2

FORMING

Invoice	Qty.	Description
2116 29704 26May20	1	SIDE DOOR- HOME TO EXTERIOR- AS PER PLAN AND GRADE PERMITTING Included in aps
2116 29705 26May20 **	1	MANDOOR - GARAGE TO HOUSE- AS PER PLAN AND GRADE PERMITING Included in aps
2116 29707 26May20 **	2	BASEMENT WINDOWS - UPGRADE EXISTING BASEMENT WINDOW TO 30 INCH X 24 INCH - MAY REQUIRE INSTALLATION OF WINDOW WELL

FRAMING

Invoice	Qty.	Description
2116 29705 26May20	1	MANDOOR - GARAGE TO HOUSE- AS PER PLAN AND GRADE PERMITING Included in aps
2116 29769 26May20 NoCat	1	SIDE DOOR - AS PER PLAN AND GRADE PERMITTING
2173 32276 26May20	1	MASTER BEDROOM: OPTIONAL 10 FOOT TRAY CEILING - MASTER BEDROOM (AS PER PLAN)
2173 34085 26May20 NoCat	10	MAIN FLOOR: EXTENDED HEIGHT ARCHWAY - 96"
2173 34087 26May20 NoCat	2	MAIN FLOOR: STANDARD DOOR EXTENDED HEIGHT 96" -MAIN FLOOR 3 STOREY MODELS - 96"

GRANITE MARBLE QUARTZ

Invoice	Qty.	Description
2173 30779 26May20 NoCat	1	KITCHEN: COOK TOP CUT OUT
2173 30780 26May20 NoCat	1	KITCHEN: UPGRADE 2 QUARTZ COUNTER TOP
2173 30781 26May20 NoCat	1	KITCHEN: FLUSH BREAKFAST BAR

ryDiscipline.rpt 06May20

Page 3 of 7

Printed and Sent: 26-May-20

GOLDPARK

WORTH MORE™

CONSTRUCTION SUMMARY

Lot: 110

Model: 38-9 Elev.B PUCCHINI OPT - GFA1

Project/Phase: Brampton Encore / 2

HARDWOOD

Invoice	Qty.	Description
2173 30784 26May20 NoCat	1	MAIN FLOOR: UPGRADE 4 HARDWOOD - 3/4 X 5" WHITE OAK HANDSCRAPED

HVAC

Invoice	Qty.	Description
2173 30742 26May20 NoCat	1	A/C - 4.0 TON INCLUDED IN APS
2173 30743 26May20	1	KITCHEN: GAS LINE ROUGH - MAIN FLOOR - (3 STOREY MODELS) INCLUDED IN APS
2173 30765 26May20	1	HUMIDIFIER: WB3 - 18 (UP TO 4,000 SQ.FT.)

INTERIOR TRIM AND DOORS

Invoice	Qty.	Description
2116 29704 26May20 **	1	SIDE DOOR- HOME TO EXTERIOR- AS PER PLAN AND GRADE PERMITTING Included in aps
2173 30737 26May20	2	MAIN FLOOR: STANDARD DOOR EXTENDED HEIGHT 96" (PRICE PER DOOR) MAIN FLOOR 3 STOREY MODELS - 96" INCLUDED IN APS
2173 30739 26May20	10	MAIN FLOOR: EXTENDED HEIGHT ARCHWAY (PRICE PER DOORWAY) - 96"
2173 34081 26May20 NoCat	1	MASTER BEDROOM: OPTIONAL 10 FOOT TRAY CEILING - MASTER BEDROOM (AS PER PLAN)
2173 34084 26May20 NoCat	1	GARAGE MANDOOR - AS PER PLAN AND GRADE PERMITTING

ryDiscipline.rpt 06May20

Page 4 of 7

Printed and Sent: 26-May-20

KITCHEN AND BATH CABINETRY

Invoice	Qty.	Description
2173 30768 26May20 NoCat	1	KITCHEN: RE-DESIGN KITCHEN TO ACCOMMODATE 36" COOK TOP
2173 30769 26May20 NoCat	1	KITCHEN: PREMIUM SPRAY STAIN
2173 30770 26May20 NoCat	1	KITCHEN: DOUBLE APPLIANCE CABINET + COOK TOP CABINET (with doors below)
2173 30771 26May20 NoCat	1	KITCHEN: DEEP GABLE AT OVENS
2173 30772 26May20 NoCat	1	KITCHEN: RELOCATE STANDARD BANK OF 4 DRAWERS TO ISLAND
2173 30773 26May20 NoCat	2	KITCHEN: 2-TIER SPICE PULL OUT EITHER SIDE OF COOK TOP
2173 30775 26May20 NoCat	1	KITCHEN: RECYCLE CENTER - 2 BIN, PULL OUT ATTACHED TO DOOR
2173 30776 26May20 NoCat	1	KITCHEN: DELETE UPPERS ABOVE STOVE, FINISH SIDES OF CABINETS. LEAVE APPROX. 42" FOR FUTURE 36" CHIMNEY-STYLE HOOD FAN.
2173 30777 26May20 NoCat	1	KITCHEN: CABINETRY VALANCE (NO ELECTRICAL PURCHASED)
2173 30778 26May20 NoCat	1	KITCHEN: UPGRADE HARDWARE
2173 30788 26May20 NoCat	1	LAUNDRY: OPTIONAL UPPERS (STANDARD LEVEL)

MISC.

Invoice	Qty.	Description
2173 31652 26May20 NoCat	1	Purchaser has attended an appointment at the Decor Centre & has DECLINED any additional upgrades and accepts & acknowledges that there will be no further changes/additions/deletions to be made upon signing on March 18, 2020 A minimum \$500 fee to re-open file will apply for any changes.

PAINT

Invoice	Qty.	Description
2116 29705 26May20 **	1	MANDOOR - GARAGE TO HOUSE- AS PER PLAN AND GRADE PERMITING Included in aps
2173 30787 26May20 NoCat	1	MAIN FLOOR: STAIN STAIRS TO MATCH HARDWOOD AS CLOSE AS POSSIBLE.
2173 34083 26May20 NoCat	1	MASTER BEDROOM: OPTIONAL 10 FOOT TRAY CEILING - MASTER BEDROOM (AS PER PLAN)
2173 34089 26May20 NoCat	2	MAIN FLOOR: STANDARD DOOR EXTENDED HEIGHT 96" -MAIN FLOOR 3 STOREY MODELS - 96"
2173 34091 26May20 NoCat	1	SIDE DOOR - AS PER PLAN AND GRADE PERMITTING

PLUMBING

Invoice	Qty.	Description
2116 29706 26May20	1	ROUGH-IN - 3PC BASEMENT ROUGH-IN
2173 30763 26May20	1	KITCHEN: ROUGH-IN - WATERLINE FOR FRIDGE
2173 34092 26May20 NoCat	1	KITCHEN: BLANCO QUATRUS STAINLESS STEEL UNDERMOUNT SINK # R15U2

PLUMBING FIXTURES

Invoice	Qty.	Description
2173 30789 26May20 NoCat	1	KITCHEN: BLANCO QUATRUS STAINLESS STEEL UNDERMOUNT SINK # R15U2

STAIRS AND RAILINGS

Invoice	Qty.	Description
2173 30786 26May20 NoCat	1	MAIN STAIRS: EUROLINE 2 + V GROOVE

WINDOWS - BASEMENT

Invoice	Qty.	Description
2116 29707 26May20	2	BASEMENT WINDOWS - UPGRADE EXISTING BASEMENT WINDOW TO 30 INCH X 24 INCH - MAY REQUIRE INSTALLATION OF WINDOW WELL

WINDOWS AND DOORS

Invoice	Qty.	Description
2116 29704 26May20 **	1	SIDE DOOR- HOME TO EXTERIOR- AS PER PLAN AND GRADE PERMITTING Included in aps
2116 29705 26May20 **	1	MANDOOR - GARAGE TO HOUSE- AS PER PLAN AND GRADE PERMITING Included in aps
2173 34088 26May20 NoCat	2	MAIN FLOOR: STANDARD DOOR EXTENDED HEIGHT 96" -MAIN FLOOR 3 STOREY MODELS - 96"

*** NOTE: This is not an approved document. Document must be locked ***

Scheduled Closing Date:

Purchasers: ABHISHEK BHOWMIK & Sanchyaita Bhowmik Property: 110

Telephone Res. / Bus:

Project: Brampton Encore - Phase 2

Decor Advisor: Yolande Somerville

Model and Elevation: 38-9 Elev.B PUCCINI OPT - GFA1

Layout Changes: ☐ Yes ☒ NoSketch Attached: ☒ Yes ☐ No

Exterior Colour Scheme:

1. Cabinetry

	Style and Colour	Counter	Hardware
Kitchen / Breakfast	Siena oak *'Graphite'	*Quartz 'Cloudy Carrara'	*CH-32
Laundry Room	Varese pvc 'Mystic'	n/a	cs1-23
Powder Room	n/a	n/a	n/a
Ground Floor Bath	Varese pvc 'Mystic'	P-Lam #6698-46	cs1-23
Master Ensuite Bathroom	Varese pvc 'Mystic'	P-Lam #6698-46	cs1-23
Second Ensuite Bathroom (If Applicable)	Varese pvc 'Mystic'	P-Lam #6698-46	cs1-23
Twin Bath	Varese pvc 'Mystic'	P-Lam #6698-46	cs1-23

Comment

2. Floor Tile

	Selection
Entrance Vestibule	*24x24" Eterna London polished 'Imperial Grey'
Main Hall	n/a
Kitchen / Breakfast	*24x24" Eterna London polished 'Imperial Grey' (not breakfast)
Laundry Room	13x13" New Reeds 'Brown'
Powder Room	*24x24" Eterna London polished 'Imperial Grey'
Ground floor Bath	*24x24" Eterna London polished 'Imperial Grey'
Master Ensuite Bathroom	13x13" New Reeds 'Brown'
Second Ensuite Bathroom (If Applicable)	13x13" New Reeds 'Brown'
Lower Landing (If Applicable)	*24x24" Eterna London polished 'Imperial Grey'
Twin Bathroom	13x13" New Reeds 'Brown'

Comment

3. Wall Tile

	Selection	Listello/Inserts	Describe
M. Ens. Tub skirt/splash	8x10" Weave 'White'	<input type="radio"/> Yes <input checked="" type="radio"/> No	
Master Ensuite Bathroom			
Tub Deck	8x10" Weave 'White'	<input type="radio"/> Yes <input checked="" type="radio"/> No	
Shower Stall	8x10" Weave 'White'	<input type="radio"/> Yes <input checked="" type="radio"/> No	
Bathroom Walls	n/a	<input type="radio"/> Yes <input checked="" type="radio"/> No	
Second Ensuite Bathroom (If Applicable)	8x10" Weave 'White'	<input type="radio"/> Yes <input checked="" type="radio"/> No	
Twin Bath	8x10" Weave 'White'	<input type="radio"/> Yes <input checked="" type="radio"/> No	
Kitchen Backsplash	<input type="radio"/> Yes <input checked="" type="radio"/> No	Backsplash Behind Fridge	

Comment

Ground Floor Bath: 8x10" Weave 'White'

*** NOTE: This is not an approved document. Document must be locked ***

Scheduled Closing Date:

Purchasers: ABHISHEK BHOWMIK & Sanchyaita Bhowmik Property: 110

Telephone Res. / Bus:

Project: Brampton Encore - Phase 2

Decor Advisor: Yolande Somerville

Model and Elevation: 38-9 Elev.B PUCCINI OPT - GFA1

4. Plumbing Fixtures

<input type="checkbox"/>	Second Ensuite	<input type="checkbox"/>	Powder Room	<input type="checkbox"/>
Master Ensuite Bathroom <input type="checkbox"/>	Other Room - Specify <input type="checkbox"/>	<input type="checkbox"/>	Other Washroom	<input type="checkbox"/>
Comment Standard except kitchen sink				

5. Hardwood Flooring

	Type and Stain		Type and Stain
Main Hall	*5" Hand Scrape 'Gotham'	Upper Landing	*5" Hand Scrape 'Gotham'
Kitchen / Breakfast	*5" Hand Scrape 'Gotham' (bfast)	Upper Hall	*5" Hand Scrape 'Gotham'
Living Room	*5" Hand Scrape 'Gotham'	Master Bedroom	n/a
Dining Room	*5" Hand Scrape 'Gotham'	Bedroom #2	n/a
Family Room	*5" Hand Scrape 'Gotham'	Bedroom #3	n/a
Den/Library	n/a	Bedroom #4	n/a
Entrance Vestibule	n/a	Bedroom #5	n/a
Lower Landing (If Applicable)	*5" Hand Scrape 'Gotham' (stairs)	Other Room - Specify	

Comment

6. Carpeting

	Upgrade	Description
Ground Floor	<input type="checkbox"/>	STD 'Pearl White' with std u/pad
Second Floor	<input type="checkbox"/>	STD 'Pearl White' with std u/pad
	<input type="checkbox"/>	

Upgrade Underpad	Type	Area
Carpet on Stairs	Capped	Runner - *Upgrade

Comment

7. Fireplace

	Living Room			Family Room			Other Room - Specify		
	Purchased	As Per Plan	N/A	Purchased	As Per Plan	N/A	Purchased	As Per Plan	N/A
Fireplace Type	<input type="radio"/>	<input type="radio"/>	<input checked="" type="radio"/>	<input type="radio"/>	<input checked="" type="radio"/>	<input type="radio"/>	<input type="radio"/>	<input type="radio"/>	<input checked="" type="radio"/>
Mantle Type				Standard Gas					
Colour / Stain				NF-20					
Surround				White					
Hearth				Nero Marquina					
				none					

Comment

Purchasers: ABHISHEK BHOWMIK & Sanchyaita Bhowmik Property: 110

Telephone Res. / Bus:

Project: Brampton Encore - Phase 2

Decor Advisor: Yolande Somerville

Model and Elevation: 38-9 Elev.B PUCCINI OPT - GFA1

8. Trim Carpentry

Interior Doors ☒ Standard ☐ Front Door Glass Inserts ☒ Standard ☐ Door Handles ☒ Standard ☐

Interior Trim ☒ Standard ☐

Comment

9. Plaster Mouldings and Medallions

Standard Throughout ☐ Yes ☐ No ☒ N/A

Entrance Vestibule	<input type="checkbox"/>	<input type="checkbox"/>	Kitchen/Breakfast	<input type="checkbox"/>	<input type="checkbox"/>
Main Hall	<input type="checkbox"/>	<input type="checkbox"/>	Den/Library	<input type="checkbox"/>	<input type="checkbox"/>
Living Room	<input type="checkbox"/>	<input type="checkbox"/>	Lower Landing	<input type="checkbox"/>	<input type="checkbox"/>
Dining Room	<input type="checkbox"/>	<input type="checkbox"/>	Other Room - Specify	<input type="checkbox"/>	<input type="checkbox"/>
Family Room	<input type="checkbox"/>	<input type="checkbox"/>			

Comment

10. Railings and Spindles

Railing Package ☒ Euroline 2 + V Groove ☐

Railing Colour ☒ Gotham ☐

Stringer / Riser ☒ Gotham ☐

Spindle Colour ☒ Black ☐

Treads ☒ Gotham ☐

Oak Stairs ☒ Yes ☐ No ☐ N/A

Comment

11. Wall Paint / Ceilings

Throughout Finished Areas ☒ Warm Grey ☐

Trim Paint ☒ White ☐

Smooth Ceilings

Ground Floor ☐

Second Floor ☐

Note ☒ STD on Main floor ☐

Comment

*** NOTE: This is not an approved document. Document must be locked ***

Scheduled Closing Date:

Purchasers: ABHISHEK BHOWMIK & Sanchyaita Bhowmik Property: 110

Telephone Res. / Bus:

Project: Brampton Encore - Phase 2

Decor Advisor: Yolande Somerville

Model and Elevation: 38-9 Elev.B PUCCINI OPT - GFA1

12. Electrical

Hood Fan ☐ White ☐ Stainless ☒ N/A

Above Kitchen Cabinet Light ☐ Yes ☒ No

Below Kitchen Cabinet Light ☐ Yes ☒ No

Standard Appliances ☐

Over The Range Microwave ☐

Chimney Style Fan ☒

Comment

13. Heating and Air Conditioning

Air Conditioning YES ☐

Gas Provisions Stove YES ☐

Gas Provisions Dryer NO ☐

Gas Provisions Barbecue STD ☐

Comment

14. Additional Comments

15. Disclaimers and Notes

- 1) Colours of all materials are as close as possible to builder's selection, but not necessarily identical due to variances in manufacturing.
- 2) Any extras listed above are null and void unless accompanied by a separate invoice/amendment. Said invoice must be paid in full.
- 3) The Purchaser acknowledges that after Interior Colour Selection form is signed and dated, no further changes will be permitted other than re-selection due to unavailability. ☒ Purchaser's Initials
- 4) The Purchaser acknowledges reading and accepting the "Gold Park Homes Decor Centre Disclaimers" form. This document contains other miscellaneous disclaimers.

This Interior Colour Selection is final and approved by:

Signature: Abhishek Bhowmik Date: 13-APR-20

encore
BRAMPTON


BE2-110
Nov 11 2019

The
Puccini
38' SERIES

BE2-110

March 19 2020

Elevation A • 3,700 sq.ft. | Elevation B • 3,700 sq.ft.

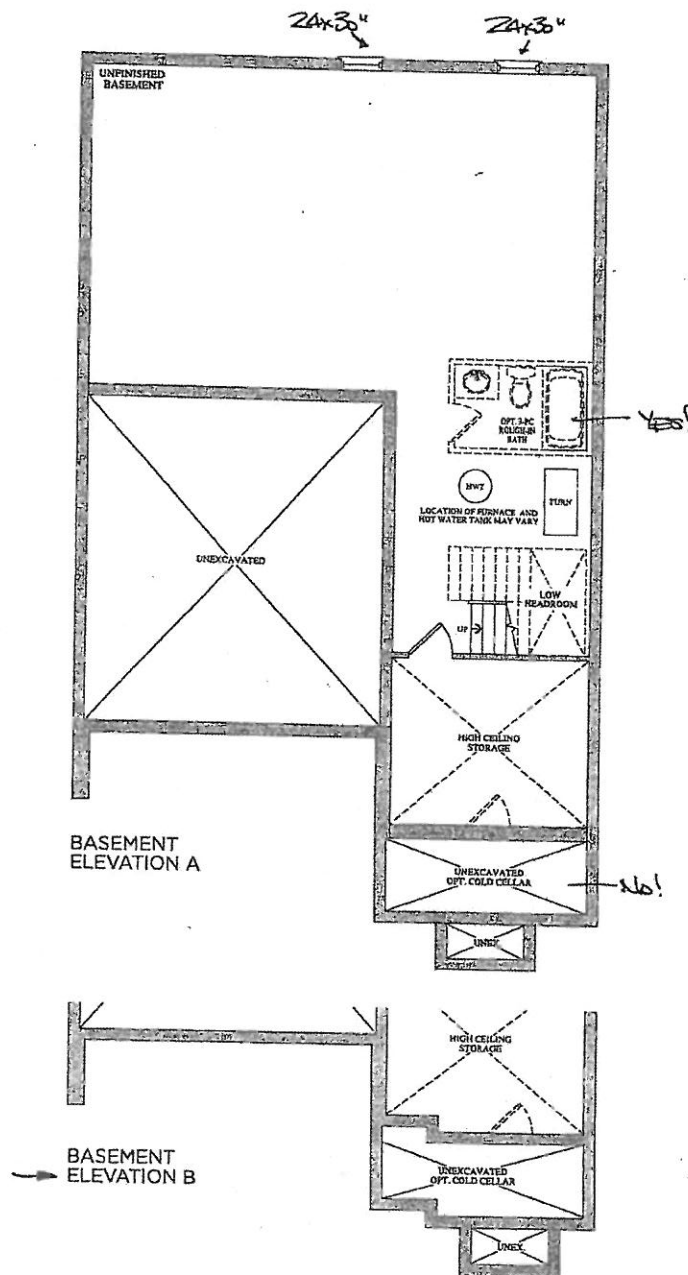

Prices, figures, illustrations, sizes, features and finishes are subject to change without notice, E.&O.E. Areas and dimensions are approximate and actual usable floor space may vary from the stated area. Layout may be reverse of the unit purchased, E. & O.E.

GOLDPARK
HOMES


encore
BRAMPTON

BE2-110
Nov 11 2019

The Puccini
38' SERIES

BE2-110
March 19 2020

Elevation A • 3,700 sq.ft. | Elevation B • 3,700 sq.ft.

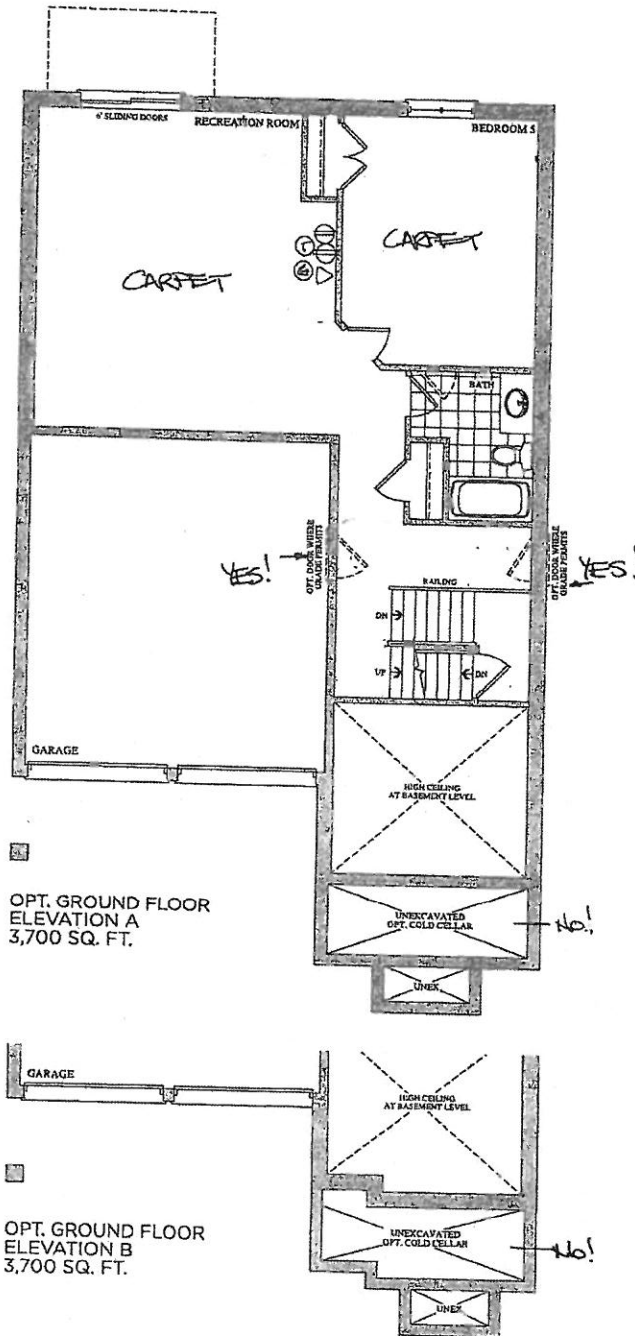


Prices, figures, illustrations, sizes, features and finishes are subject to change without notice. E&O.E. Areas and dimensions are approximate and actual usable floor space may vary from the stated area. Layout may be reverse of the unit purchased. E. & O.E.

GOLDPARK
HOMES

BEZ-116
Nov. 11 2019

BE2-110
MARCH 19 2020

Elevation A • 3,700 sq.ft. | Elevation B • 3,700 sq.ft.

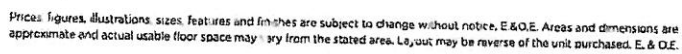


GOLDPARK
HOMES

BEZ-110
Nov 11 2019

Elevation A • 3,700 sq.ft. | Elevation B • 3,700 sq.ft.

BEZ 110
MAR 19 2020

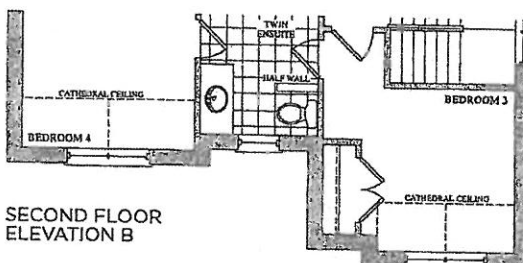

GOLDPARK
HOMES

BEZ-110
Feb 6 2020

80/11

QUOTATION

Date: 06/23/16

Trade Name: Gold Park Homes

Site location: Brampton


Model: 38-9

Address:

Project: Encore

Phase:

This layout has been explained to the purchaser by Cortina Kitchens Inc. and is understood by the purchaser.

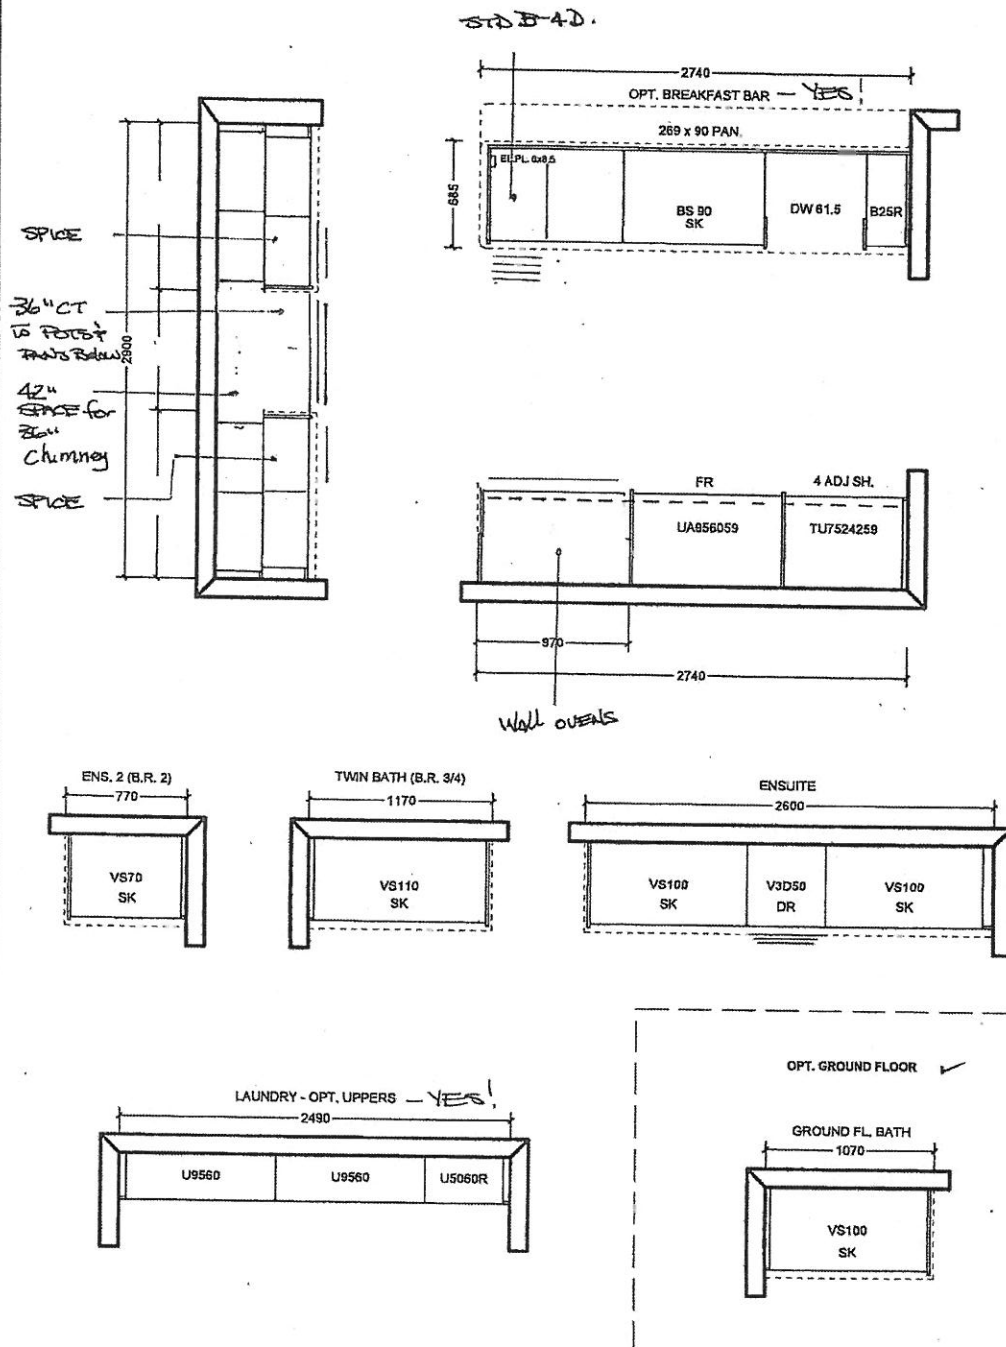

All prices subject to confirmation from head office.
This quotation is subject to the terms & conditions set out
in Cortina's Agreement of Purchase and Sale

All agreements are contingent upon strikes, accidents, and delay beyond our control.
Please provide our Installer with template for sinkholes or \$150.00 will be charged for callback.

ACCEPTED DATE: 13-APR-20

[Signature]
CUSTOMER SIGNATURE

SALESPERSON SIGNATURE



CORTINA HEAD OFFICE APPROVAL

ITEM A. Wood grain and colour are characteristics of the product. we cannot guarantee that such grain and colour will always match
ITEM B. Cortina Kitchens reserves the right to alter dimensions and make technical changes without notice.

PLUMBING UPGRADES

GOLDPARK
WORTH MORE

Blanco Quatrus R-15 U 1-3/4" #401520

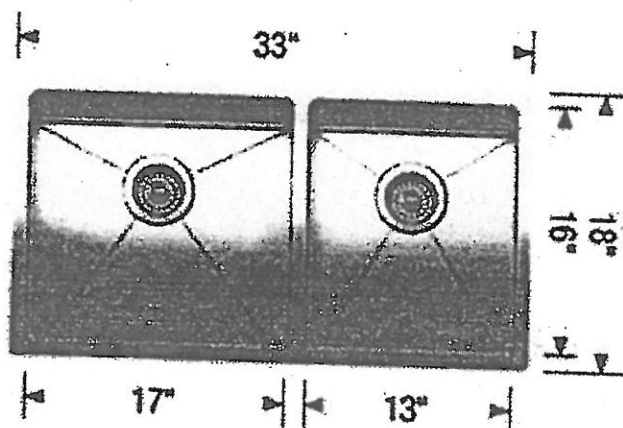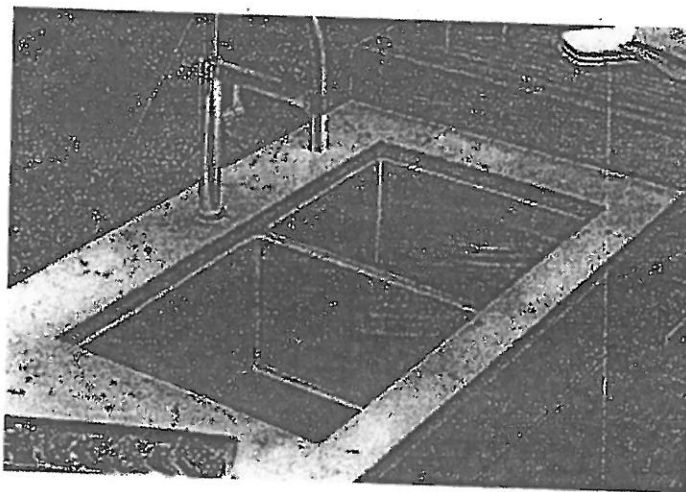

*FAUCET CENTERED TO DIVISION
(NOT OPENING).









LOT # 110	
ROOM: Kitchen	SIGNATURE: <i>[Signature]</i>
DATE: March 19 2020	SIGNATURE: <i>[Signature]</i>

ARTINA

UPGRADE HARDWARE

BED-110
MAR 19 2020

UPGRADE HARDWARE

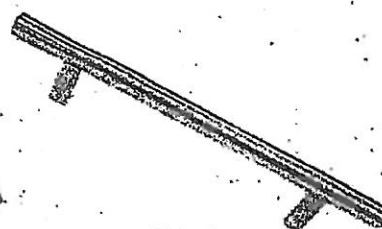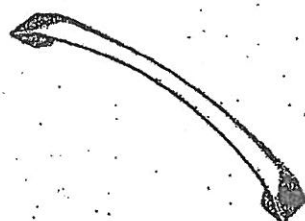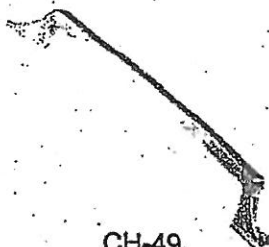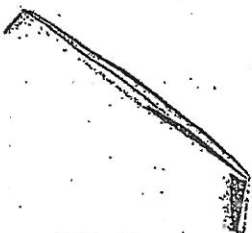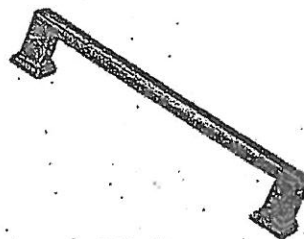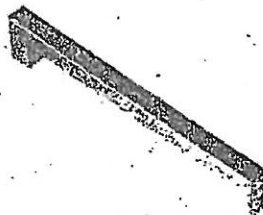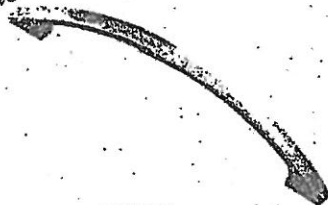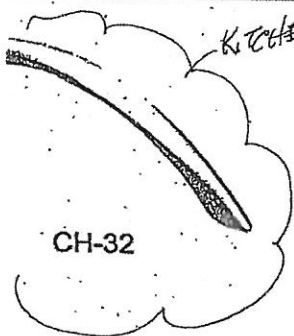

NOTES:
IMAGES ARE FOR QUICK REFERENCE PURPOSES ONLY
ACTUAL SIZES AND FINISHES AS PER HARDWARE
SAMPLE BOARD PROVIDED TO DECOR CENTRE

ARTINA
STANDARD HARDWARE

BE2-110
March 19 2020

MODIFIED: 19/05/16 M

STANDARD HARDWARE




CSI-6



CSI-10



CSI-14

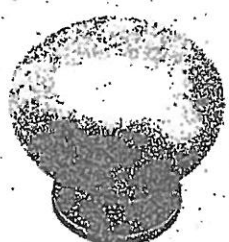

CSI-16



CSI-18



CSI-19



CSI-20


Laundry
+ Bathrooms




CSI-21




CSI-22

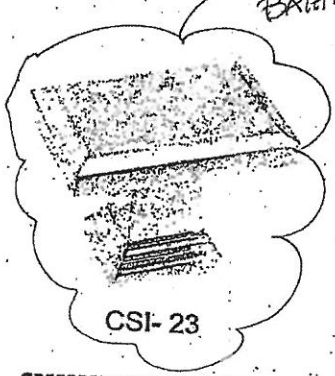

CSI-23

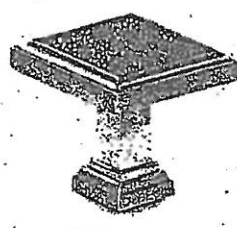

CSI-24

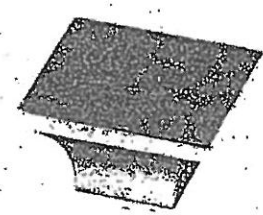

CSI-25

*NOTES:
- IMAGES ARE FOR QUICK REFERENCE PURPOSES ONLY
- ACTUAL SIZES AND FINISHES AS PER HARDWARE
SAMPLE BOARD PROVIDED TO DECOR CENTRE

GOLDPARK
HOMES



Granite, Marble,
Engineered Surfaces

- Standard 2CM & 3CM
- Upgrade 1 2CM & 3CM
- Upgrade 1 4 CM
- Upgrade 2

20mm (3/4") Profiles



FE 20

30mm (1 1/4") Profiles

FE30

H30

V330

C30

FE30

H30

V330

C30

FE30



BATHROOM ACCESSORIES

PROJECT: ENCORE 2


LOT: 110


INSTALL STANDARD BATHROOM ACCESSORIES
THRU OUT (TOWEL BAR, SOAP DISH, TISSUE
HOLDER) **location as per vendor's discretion



DO *NOT* INSTALL STANDARD BATHROOM
ACCESSORIES THRU OUT (TOWEL BAR, SOAP
DISH, TISSUE HOLDER)



SIGNATURE: 

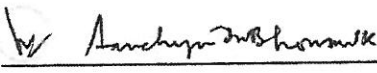SIGNATURE: 

DATE: MARCH 19 2020



30" (76.2 cm) and 36" (91.4 cm) Wall-Mount Canopy Range Hood


PRODUCT MODEL NUMBERS

WWW57UC0F WWW57UC6F

ELECTRICAL REQUIREMENTS

A 120-volt, 60-Hz., AC-only, 15-amp, fused electrical circuit is required.

CABINET DIMENSIONS

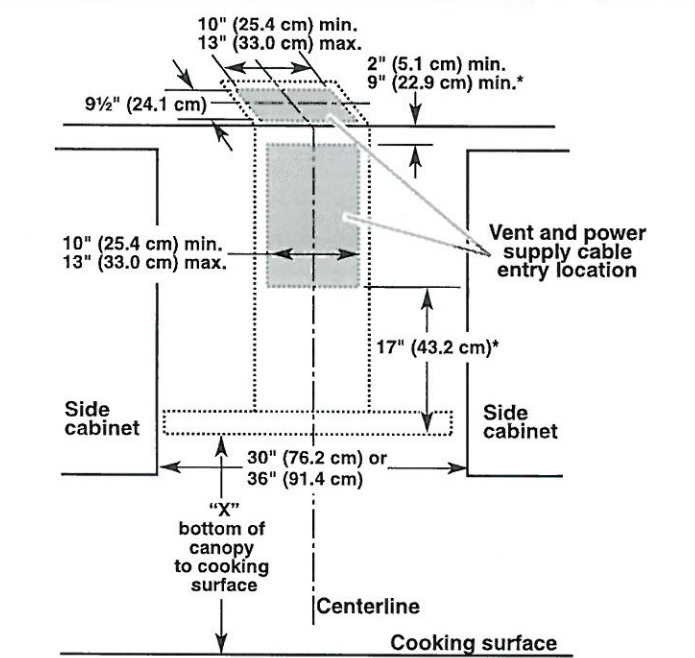

* For non-vented (recirculating) installations

IMPORTANT:

- Minimum distance "X": 24" (61 cm) from electric cooking surface
- Minimum distance "X": 27" (68.6 cm) from gas cooking surface
- Suggested maximum distance "X": 36" (91.4 cm)


The chimneys can be adjusted for different ceiling heights. See the following chart.

Vented Installations		
	Min. ceiling height	Max. ceiling height
Electric cooking surface	7' 5" (2.26 m)	9' 6" (2.9 m)
Gas cooking surface	7' 8" (2.34 m)	9' 6" (2.9 m)

Non-Vented (Recirculating) Installations		
	Min. ceiling height	Max. ceiling height
Electric cooking surface	7' 5" (2.26 m)	9' 10" (3 m)
Gas cooking surface	7' 8" (2.34 m)	9' 10" (3 m)

NOTE: The range hood chimneys are adjustable and designed to meet varying ceiling or soffit heights depending on the distance "X" between the bottom of the range hood and the cooking surface. For higher ceilings, a Stainless Steel Chimney Extension Kit Part Number EXTKIT25FS is available from your dealer or an authorized parts distributor. The chimney extension replaces the upper chimney shipped with the range hood.

PRODUCT DIMENSIONS

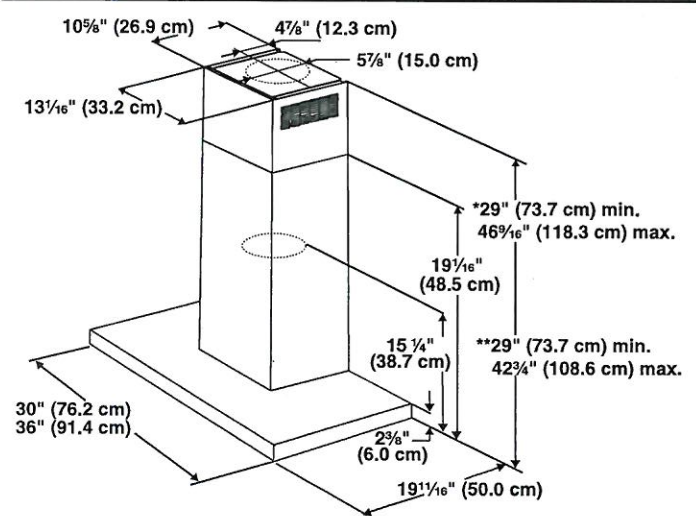

* For non-vented (recirculating) installations

** For vented installations.


VENTING REQUIREMENTS

- Vent system must terminate to the outdoors except for non-vented (recirculating) installations.
 - Do not terminate the vent system in an attic or other enclosed area.
 - Do not use 4" (10.2 cm) laundry-type wall cap.
 - Use metal vent only. Rigid metal vent is recommended. Plastic or metal foil vent is not recommended.
 - The length of vent system and number of elbows should be kept to a minimum to provide efficient performance.
- For the Most Efficient and Quiet Operation:**
- Use no more than three 90° elbows.
 - Make sure there is a minimum of 24" (61 cm) of straight vent between the elbows if more than 1 elbow is used.
 - Do not install 2 elbows together.
 - Use clamps to seal all joints in the vent system.
 - The vent system must have a damper. If the roof or wall cap has a damper, do not use the damper supplied with the range hood.
 - Use caulking to seal exterior wall or roof opening around the cap.
 - The size of the vent should be uniform.

* See attach *
BE2-110
September 14 2020

For Non-Vented (Recirculating) Installations

If it is not possible to vent cooking fumes and vapors to the outside, the hood can be used in the non-vented (recirculating) version, using a Recirculation Kit (which includes charcoal filters and a deflector). To order, see the "Assistance or Service" section.

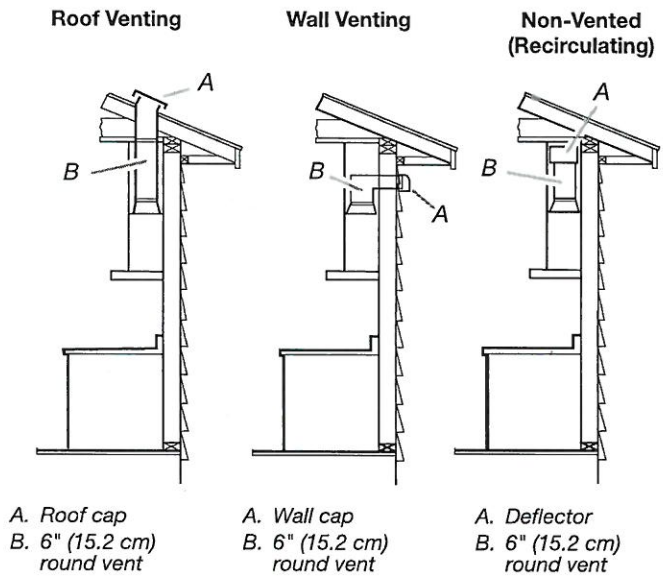


Calculating Vent System Length

To calculate the length of the system you need, add the equivalent feet (meters) for each vent piece used in the system.

Vent Piece	6" (15.2 cm) Round	
45° elbow	2.5 ft (0.8 m)	
90° elbow	5 ft (1.5 m)	

Maximum equivalent vent length is 35 ft (10.7 m).

Example Vent System

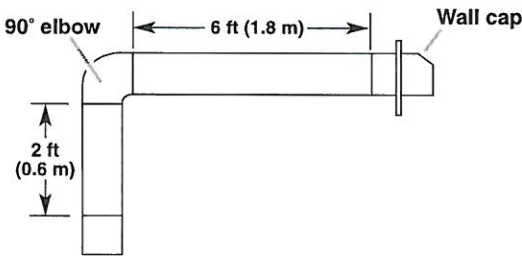

The following example falls within the maximum recommended vent length of 35 ft (10.7 m).

1 - 90° Elbow	= 5 ft (1.5 m)
1 - Wall cap	= 0 ft (0 m)
8 ft (2.4 m) straight	= 8 ft (2.4 m)
Length of system	= 13 ft (3.9 m)

BE2-110 *#See attach.**
September 14 2020