



CONSTRUCTION SUMMARY

Lot: 11
Model: 42.04 A BROOKVALLEY
Project/Phase: Pine Valley Forevergreen / 1

CERAMIC

Invoice	Qty.	Description
2423 25Aug20 NoCat	1	.MASTER ENSUITE: SHOWER POT LIGHT: 6" RECESSED SHOWER POT LIGHT - SAME SWITCH AS STANDARD SHOWER LIGHT - - [RELOCATE STANDARD + ADD THIS ONE TO BE CENTERED IN SHOWER WITH RAIN SHOWER HEAD IN APPROX CENTER]
2423 25Aug20 NoCat	1	.MASTER ENSUITE: SHOWER NICHE [SHAMPOO SHELF] - COMPLETE WITH MATCHING MARBLE JAMBS ON 4 SIDES, STANDARD TILE, APPROX. 12 X 18 INSTALLED VERTICALLY - SEE PLAN FOR PREFERRED LOCATION
2423 25Aug20 NoCat	1	.ENSUITE 2: SHOWER NICHE [SHAMPOO SHELF] - COMPLETE WITH MATCHING MARBLE JAMBS ON 4 SIDES, STANDARD TILE, APPROX. 12 X 18 INSTALLED VERTICALLY - SEE PLAN FOR PREFERRED LOCATION
2423 25Aug20 NoCat	1	.SHARED ENSUITE: SHOWER NICHE [SHAMPOO SHELF] - COMPLETE WITH MATCHING MARBLE JAMBS ON 4 SIDES, STANDARD TILE, APPROX. 12 X 18 INSTALLED VERTICALLY - SEE PLAN FOR PREFERRED LOCATION

CONCRETE AND DRAIN

Invoice	Qty.	Description
2423 25Aug20 NoCat	1	.BACK-FLOW PREVENTER VALVE

CROWN MOULDING

Invoice	Qty.	Description
2423 25Aug20 NoCat	1	.DELETE KITCHEN BULKHEAD, IF POSSIBLE, SITE APPROVAL REQUIRED
2423 25Aug20 NoCat	1	.LIBRARY - OPT. COFFERED CEILING AS PER PLAN
2423 25Aug20 NoCat	1	.LIBRARY - OPT. WAFFLE CEILING, BEAM DETAIL AS PER PLAN (4 BOXES) OPTION #1 CTR-B07
2423 25Aug20 NoCat	1	.MASTER BEDROOM - OPT. 10 FOOT TRAY CEILING AS PER PLAN
2423 25Aug20 NoCat	1	.BREAKFAST - OPT. COFFERED CEILING - AS PER PLAN
2423 25Aug20 NoCat	1	.GREAT ROOM - OPT. COFFERED CEILING AS PER PLAN



CONSTRUCTION SUMMARY

Lot: 11
Model: 42.04 A BROOKVALLEY
Project/Phase: Pine Valley Forevergreen / 1

CROWN MOULDING

Invoice	Qty.	Description
2423	1	.GREAT ROOM - OPT. WAFFLE CEILING, BEAM DETAIL AS PER PLAN (15 BOXES) OPTION #1 CTR-B07
25Aug20 NoCat		

DRYWALL

Invoice	Qty.	Description
2423	1	.DELETE KITCHEN BULKHEAD, IF POSSIBLE, SITE APPROVAL REQUIRED
25Aug20 NoCat		
2423	1	.LIBRARY - OPT. COFFERED CEILING AS PER PLAN
25Aug20 NoCat		
2423	1	.LIBRARY - OPT. WAFFLE CEILING, BEAM DETAIL AS PER PLAN (4 BOXES) OPTION #1 CTR-B07
25Aug20 NoCat		
2423	1	.MASTER BEDROOM - OPT. 10 FOOT TRAY CEILING AS PER PLAN
25Aug20 NoCat		
2423	1	.BREAKFAST - OPT. COFFERED CEILING - AS PER PLAN
25Aug20 NoCat		
2423	1	.GREAT ROOM - OPT. COFFERED CEILING AS PER PLAN
25Aug20 NoCat		
2423	1	.GREAT ROOM - OPT. WAFFLE CEILING, BEAM DETAIL AS PER PLAN (15 BOXES) OPTION #1 CTR-B07
25Aug20 NoCat		
2423	1	.GREAT ROOM: UPGRADE TO 96" GARDEN DOOR ASSEMBLY
25Aug20 NoCat		
2423	1	.GREAT ROOM / DINING ROOM: DELETE HIGH WALL AND CREATE ARCH-WAY BETWEEN ROOMS - AS LARGE AN OPENING AS POSSIBLE
25Aug20 NoCat		
2446	1	SHARED ENSUITE: DELETE WALL AND DOOR BETWEEN VANITY/TOILET - INCLUDES VANITY GABLE
18Sep20 NoCat		



CONSTRUCTION SUMMARY

Lot: 11
Model: 42.04 A BROOKVALLEY
Project/Phase: Pine Valley Forevergreen / 1

ELECTRICAL

Invoice	Qty.	Description
2423 72,289 25Aug20	9	.GREAT ROOM: 4" E/S LED INTERIOR POT LIGHT - GROUND FLOOR - EACH
2423 72,278 25Aug20	1	.GREAT ROOM: ADDITIONAL INTERIOR SWITCH FOR POTLIGHTS
2423 72,289 25Aug20	6	.BREAKFAST: 4" E/S LED INTERIOR POT LIGHT - GROUND FLOOR - EACH
2423 72,278 25Aug20	1	.BREAKFAST: ADDITIONAL INTERIOR SWITCH FOR POTLIGHTS
2423 72,280 25Aug20	1	.KITCHEN: CEILING OUTLET: ADDITIONAL REINFORCED CEILING OUTLET - APPROX CENTERED ABOVE ISLAND SAME SWITCH AS STANDARD
2423 72,307 25Aug20	1	.KITCHEN: FIXTURE: RELOCATE STANDARD CEILING MOUNT FIXTURE - APPROX CENTERED ABOVE ISLAND - SEE PLAN
2423 72,289 25Aug20	4	.LIBRARY: 4" E/S LED INTERIOR POT LIGHT - GROUND FLOOR - EACH
2423 72,278 25Aug20	1	.LIBRARY: ADDITIONAL INTERIOR SWITCH FOR POTLIGHTS
2423 72,289 25Aug20	4	.MAIN HALL: 4" E/S LED INTERIOR POT LIGHT - GROUND FLOOR - EACH USE STANDARD SWITCHES
2423 72,289 25Aug20	6	.KITCHEN: 4" E/S LED INTERIOR POT LIGHT - GROUND FLOOR - EACH - INCLUDES 1 SWITCH INCLUDED IN APS
2423 72,279 25Aug20	1	.MASTER ENSUITE: SHOWER POT LIGHT: 6" RECESSED SHOWER POT LIGHT - SAME SWITCH AS STANDARD SHOWER LIGHT - - [RELOCATE STANDARD + ADD THIS ONE TO BE CENTERED IN SHOWER WITH RAIN SHOWER HEAD IN APPROX CENTER]
2423 72,279 25Aug20	1	.ENSUITE 2: ADD SHOWER POT LIGHT: 6" RECESSED SHOWER POT LIGHT COMPLETE WITH SWITCH
2423 72,274 25Aug20	1	.KITCHEN: 220V WALL RECEPTACLE ON SEPARATE CIRCUIT



CONSTRUCTION SUMMARY

Lot: 11
Model: 42.04 A BROOKVALLEY
Project/Phase: Pine Valley Forevergreen / 1

ELECTRICAL

Invoice	Qty.	Description
2423 72,273 25Aug20	1	.KITCHEN: 110V WALL RECEPTACLE ON SEPARATE CIRCUIT - GAS FIRED APPLIANCE - FOR AUX. EQUIPMENT - NOT A STOVE PLUG
2423 72,303 25Aug20	1	.KITCHEN: FIXTURE: UNDER CABINET FLUORESCENT LIGHT FIXTURES - DOES NOT INCLUDE (AND REQUIRES) LIGHT VALANCE
2423 72,281 25Aug20	1	.GREAT ROOM: INTERIOR WALL OUTLET: ADDITIONAL 110V WALL INTERIOR RECEPTACLE ON EXISTING CIRCUIT FOR WALL MOUNTED TV - LOCATE APPROX. 66" A.F.F. ABOVE FIREPLACE
2423 25Aug20 NoCat	1	.NOTE: THRU OUT - PLEASE CENTER CEILING LIGHTS IN ROOMS
2446 18Sep20 NoCat	1	SHARED ENSUITE: DELETE WALL AND DOOR BETWEEN VANITY/TOILET - INCLUDES VANITY GABLE

FORMING

Invoice	Qty.	Description
2423 25Aug20 NoCat	1	.MASTER BEDROOM - OPT. 10 FOOT TRAY CEILING AS PER PLAN
2423 25Aug20 NoCat	1	.GREAT ROOM: UPGRADE TO 96" GARDEN DOOR ASSEMBLY



CONSTRUCTION SUMMARY

Lot: 11
Model: 42.04 A BROOKVALLEY
Project/Phase: Pine Valley Forevergreen / 1

FRAMING

Invoice	Qty.	Description
2423 72,690 25Aug20	1	.DELETE KITCHEN BULKHEAD, IF POSSIBLE, SITE APPROVAL REQUIRED
2423 72,504 25Aug20	1	.LIBRARY - OPT. COFFERED CEILING AS PER PLAN INCLUDED IN APS
2423 72,503 25Aug20	1	.LIBRARY - OPT. WAFFLE CEILING, BEAM DETAIL AS PER PLAN (4 BOXES) OPTION #1 CTR-B07 INCLUDED IN APS
2423 72,512 25Aug20	1	.MASTER BEDROOM - OPT. 10 FOOT TRAY CEILING AS PER PLAN INCLUDED IN APS
2423 72,520 25Aug20	1	.BREAKFAST - OPT. COFFERED CEILING - AS PER PLAN
2423 72,507 25Aug20	1	.GREAT ROOM - OPT. COFFERED CEILING AS PER PLAN
2423 72,506 25Aug20	1	.GREAT ROOM - OPT. WAFFLE CEILING, BEAM DETAIL AS PER PLAN (15 BOXES) OPTION #1 CTR-B07
2423 72,631 25Aug20	1	.MASTER ENSUITE: SHOWER NICHE [SHAMPOO SHELF] - COMPLETE WITH MATCHING MARBLE JAMBS ON 4 SIDES, STANDARD TILE, APPROX. 12 X 18 INSTALLED VERTICALLY - SEE PLAN FOR PREFERRED LOCATION
2423 72,631 25Aug20	1	.ENSUITE 2: SHOWER NICHE [SHAMPOO SHELF] - COMPLETE WITH MATCHING MARBLE JAMBS ON 4 SIDES, STANDARD TILE, APPROX. 12 X 18 INSTALLED VERTICALLY - SEE PLAN FOR PREFERRED LOCATION
2423 72,631 25Aug20	1	.SHARED ENSUITE: SHOWER NICHE [SHAMPOO SHELF] - COMPLETE WITH MATCHING MARBLE JAMBS ON 4 SIDES, STANDARD TILE, APPROX. 12 X 18 INSTALLED VERTICALLY - SEE PLAN FOR PREFERRED LOCATION
2423 25Aug20 NoCat	1	.GREAT ROOM: UPGRADE TO 96" GARDEN DOOR ASSEMBLY
2423 25Aug20 NoCat	1	.GREAT ROOM / DINING ROOM: DELETE HIGH WALL AND CREATE ARCH-WAY BETWEEN ROOMS - AS LARGE AN OPENING AS POSSIBLE
2446 18Sep20 NoCat	1	SHARED ENSUITE: DELETE WALL AND DOOR BETWEEN VANITY/TOILET - INCLUDES VANITY GABLE BASED ON STANDARD FINISHES



CONSTRUCTION SUMMARY

Lot: 11
Model: 42.04 A BROOKVALLEY
Project/Phase: Pine Valley Forevergreen / 1

HVAC

Invoice	Qty.	Description
2423 72,224 25Aug20	1	.KITCHEN: GAS LINE ROUGH-IN - MAIN FLOOR FOR APPLIANCE - GAS RANGE

INTERIOR TRIM AND DOORS

Invoice	Qty.	Description
2423 25Aug20 NoCat	1	.LIBRARY - OPT. COFFERED CEILING AS PER PLAN
2423 25Aug20 NoCat	1	.LIBRARY - OPT. WAFFLE CEILING, BEAM DETAIL AS PER PLAN (4 BOXES) OPTION #1 CTR-B07
2423 25Aug20 NoCat	1	.MASTER BEDROOM - OPT. 10 FOOT TRAY CEILING AS PER PLAN
2423 25Aug20 NoCat	1	.BREAKFAST - OPT. COFFERED CEILING - AS PER PLAN
2423 25Aug20 NoCat	1	.GREAT ROOM - OPT. COFFERED CEILING AS PER PLAN
2423 25Aug20 NoCat	1	.GREAT ROOM - OPT. WAFFLE CEILING, BEAM DETAIL AS PER PLAN (15 BOXES) OPTION #1 CTR-B07
2423 25Aug20 NoCat	1	.GREAT ROOM: UPGRADE TO 96" GARDEN DOOR ASSEMBLY
2423 25Aug20 NoCat	1	.GREAT ROOM / DINING ROOM: DELETE HIGH WALL AND CREATE ARCH-WAY BETWEEN ROOMS - AS LARGE AN OPENING AS POSSIBLE
2446 18Sep20 NoCat	1	SHARED ENSUITE: DELETE WALL AND DOOR BETWEEN VANITY/TOILET - INCLUDES VANITY GABLE



CONSTRUCTION SUMMARY

Lot: 11
Model: 42.04 A BROOKVALLEY
Project/Phase: Pine Valley Forevergreen / 1

KITCHEN AND BATH CABINETRY

Invoice	Qty.	Description
2423 25Aug20 NoCat	1	.DELETE KITCHEN BULKHEAD, IF POSSIBLE, SITE APPROVAL REQUIRED
2423 25Aug20 NoCat	1	.KITCHEN: ROUGH-IN FOR KITCHEN POT FILLER (FIXTURE NOT INCLUDED)

NETWORK AND WIRING

Invoice	Qty.	Description
2423 72,259 25Aug20	1	.GREAT ROOM: CONDUIT PIPE - FOR WALL MOUNT TV - LOCATE APPROX 66" A.F.F. ABOVE FIREPLACE , THRU BASEMENT AND TERMINATE AT CABLE LOCATION
2423 72,260 25Aug20	1	.CONDUIT PIPE - FROM ATTIC TO BASEMENT - FROM NEAR ELECTRICAL PANEL IN BASEMENT TO APPROX CENTER OF ATTIC

PAINT

Invoice	Qty.	Description
2423 25Aug20 NoCat	1	.LIBRARY - OPT. COFFERED CEILING AS PER PLAN
2423 25Aug20 NoCat	1	.LIBRARY - OPT. WAFFLE CEILING, BEAM DETAIL AS PER PLAN (4 BOXES) OPTION #1 CTR-B07
2423 25Aug20 NoCat	1	.MASTER BEDROOM - OPT. 10 FOOT TRAY CEILING AS PER PLAN
2423 25Aug20 NoCat	1	.BREAKFAST - OPT. COFFERED CEILING - AS PER PLAN
2423 25Aug20 NoCat	1	.GREAT ROOM - OPT. COFFERED CEILING AS PER PLAN
2423 25Aug20 NoCat	1	.GREAT ROOM - OPT. WAFFLE CEILING, BEAM DETAIL AS PER PLAN (15 BOXES) OPTION #1 CTR-B07
2423 25Aug20 NoCat	1	.GREAT ROOM / DINING ROOM: DELETE HIGH WALL AND CREATE ARCH-WAY BETWEEN ROOMS - AS LARGE AN OPENING AS POSSIBLE



CONSTRUCTION SUMMARY

Lot: 11
Model: 42.04 A BROOKVALLEY
Project/Phase: Pine Valley Forevergreen / 1

PLUMBING

Invoice	Qty.	Description
2423 72,346 25Aug20	1	.KITCHEN: ROUGH-IN FOR KITCHEN POT FILLER (FIXTURE NOT INCLUDED)
2423 72,332 25Aug20	1	.ROUGH-IN 1/4" COLD WATER LINE TO FRIDGE
2423 25Aug20 NoCat	1	.MASTER ENSUITE: UPGRADE TO MOEN 90* 3-FUNCTION SHOWER SYSTEM COMPLETE WITH RAIN SHOWER (from ceiling) AND HAND SHOWER + SLIDE BAR #TS2712EP/3372/TS4172/62320/S3879EP/A721/116651
2423 25Aug20 NoCat	1	.MASTER ENSUITE: SHOWER POT LIGHT: 6" RECESSED SHOWER POT LIGHT - SAME SWITCH AS STANDARD SHOWER LIGHT - - [RELOCATE STANDARD + ADD THIS ONE TO BE CENTERED IN SHOWER WITH RAIN SHOWER HEAD IN APPROX CENTER]

WINDOWS AND DOORS

Invoice	Qty.	Description
2423 25Aug20 NoCat	1	.GREAT ROOM: UPGRADE TO 96" GARDEN DOOR ASSEMBLY




SCHEDULE 'F'

PL-11
August 13 2020
* September 1, 2020

The
Brookvalley
42' SERIES

→ Elevation A • 3,665 sq.ft.
Elevation B • 3,705 sq.ft.

DELETE high
wall - leave
arch

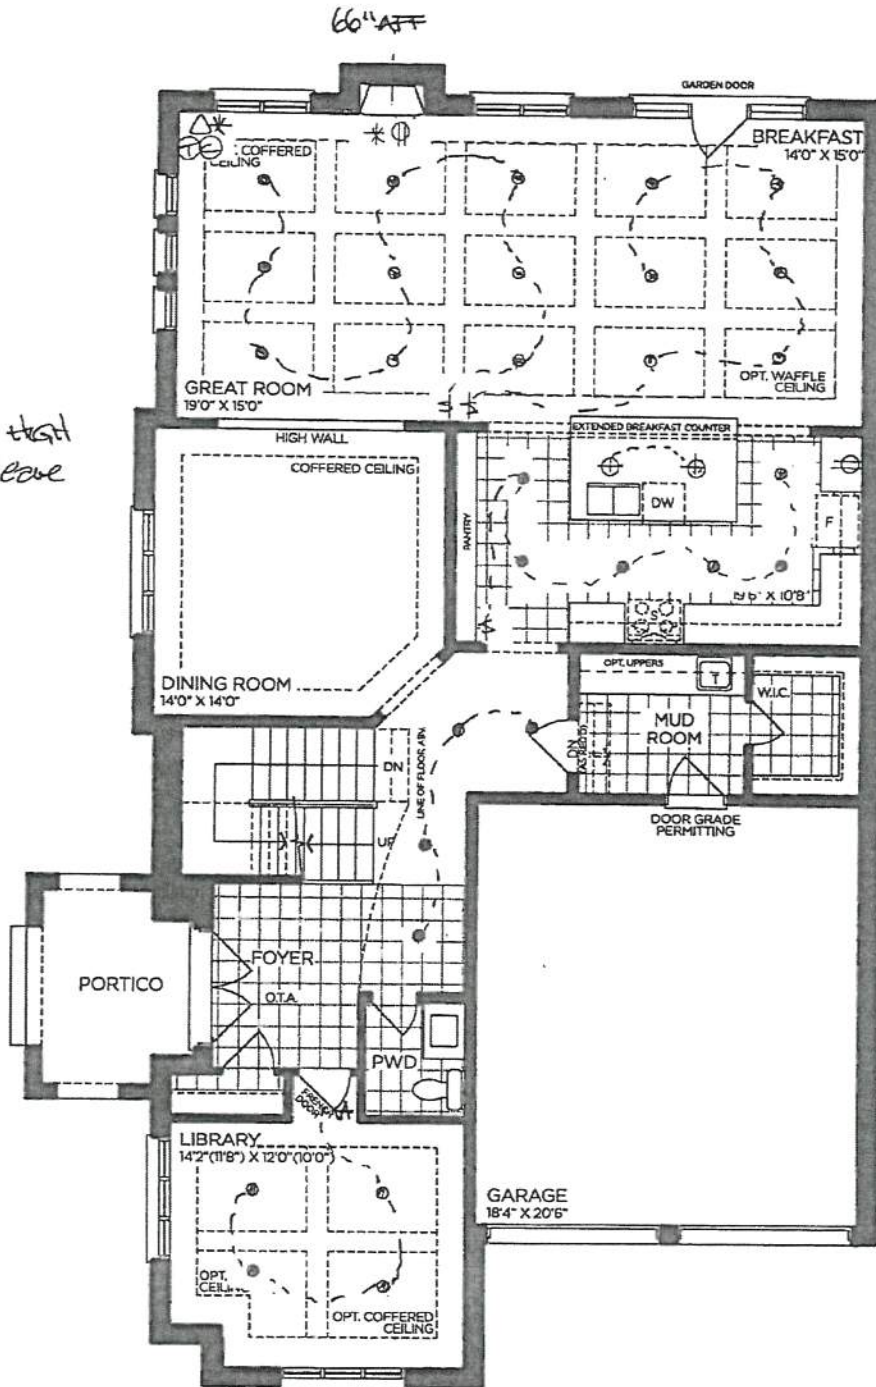

GROUND FLOOR | ELEV. A

VENDOR
PURCHASER
PURCHASER

GOLDPARK
WORTH MORE™

Prices, figures, illustrations, sizes, features and finishes are subject to change without notice. Areas and dimensions are approximate and actual usable floor space may vary from the stated area. Layout may be reverse of the unit purchased. E. & O.E. 4204



SCHEDULE 'F'


PV-11
August 13 2020
* REVISED *
September 1, 2020.

See
attach.

See
attach.

The
Brookvalley
42' SERIES

→ Elevation A • 3,665 sq.ft.
Elevation B • 3,705 sq.ft.

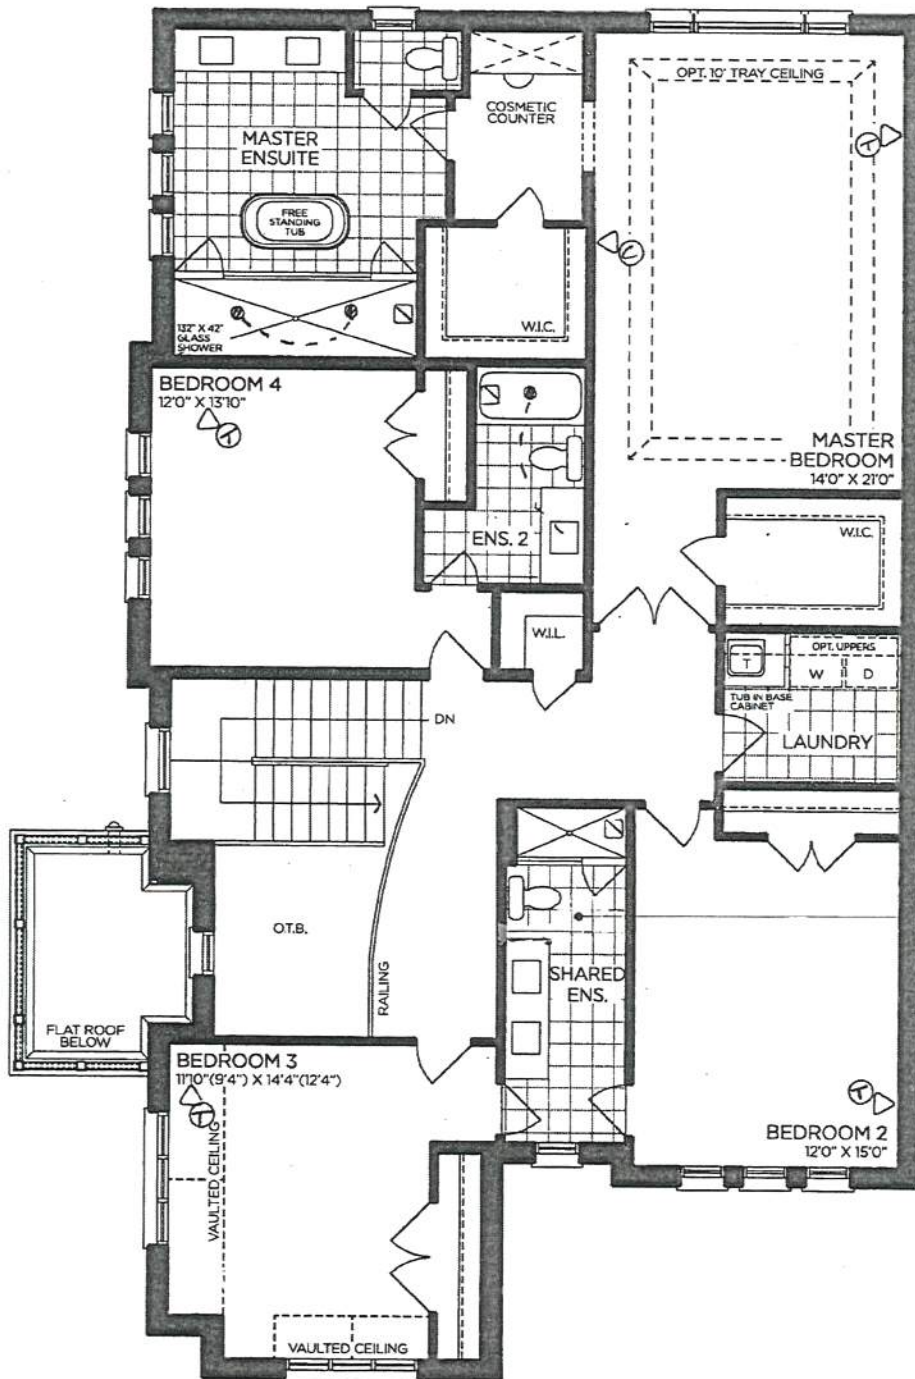

SECOND FLOOR | ELEV. A

VENDOR
PURCHASER
PURCHASER

GOLDPARK
WORTH MORE™

Prices, figures, illustrations, sizes, features and finishes are subject to change without notice. Areas and dimensions are approximate and actual usable floor space may vary from the stated area. Layout may be reverse of the unit purchased. E. & O.E. 4204


SCHEDULE 'F'



PV-11 *See attach.*
August 13 2020
* September 1, 2020 *See attach.*

The Brookvalley
42' SERIES

Elevation A • 3,665 sq.ft.
Elevation B • 3,705 sq.ft.

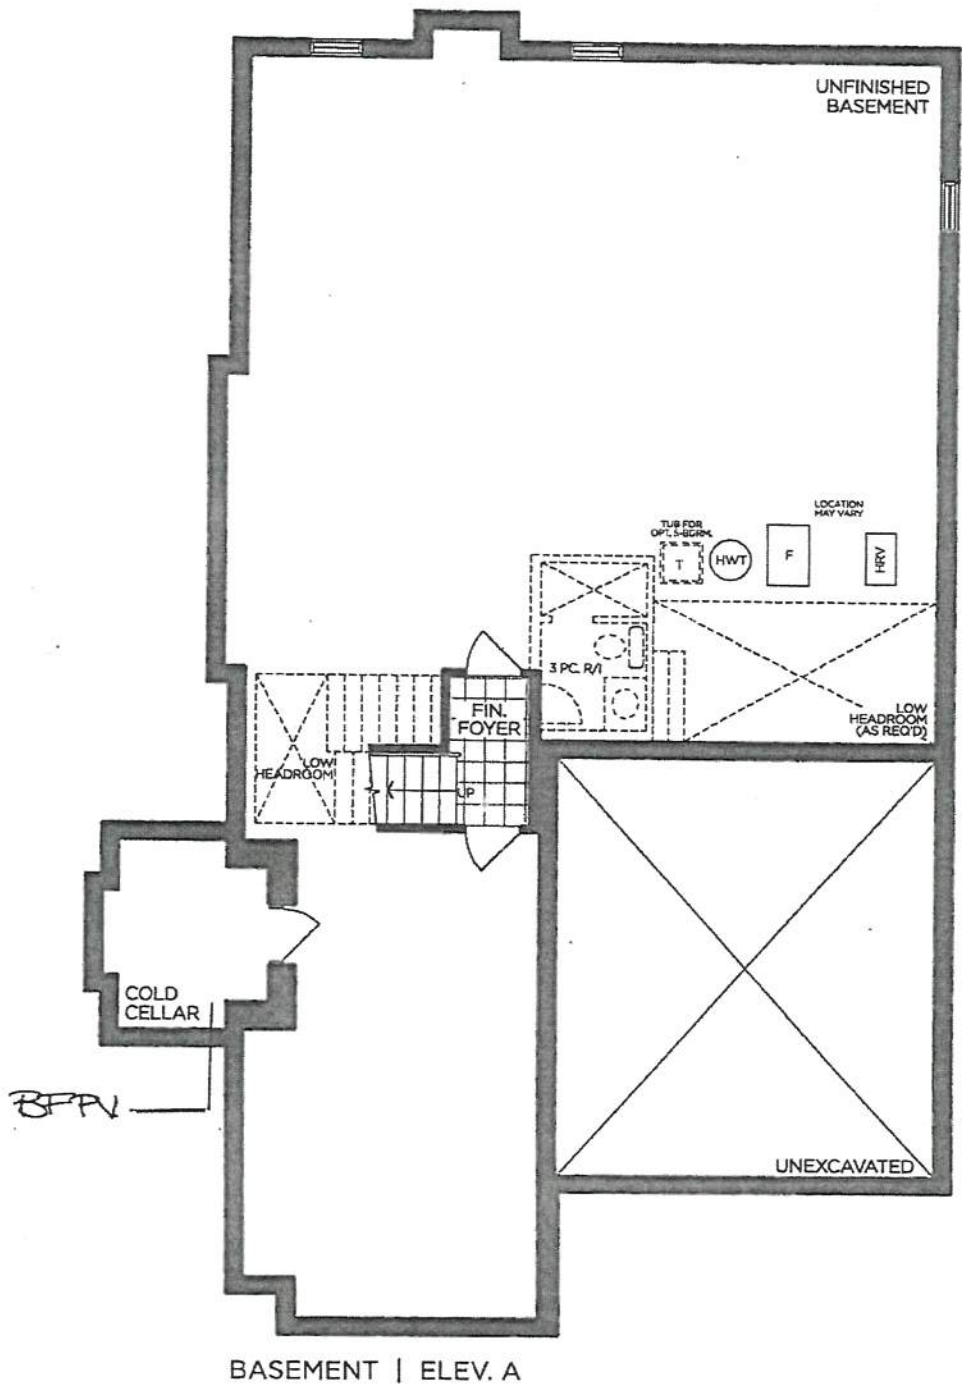

VENDOR

PURCHASER

PURCHASER

GOLDPARK
WORTH MORE™

Prices, figures, illustrations, sizes, features and finishes are subject to change without notice. Areas and dimensions are approximate and actual usable floor space may vary from the stated area. Layout may be reverse of the unit purchased. E. & O.E. 4204


SCHEDULE 'F'



PK-11
August 13 2020
* September 1, 2020

The Brookvalley
42' SERIES
Elevation A • 3,665 sq.ft.
Elevation B • 3,705 sq.ft.

DELETE this
wall - leave
orch

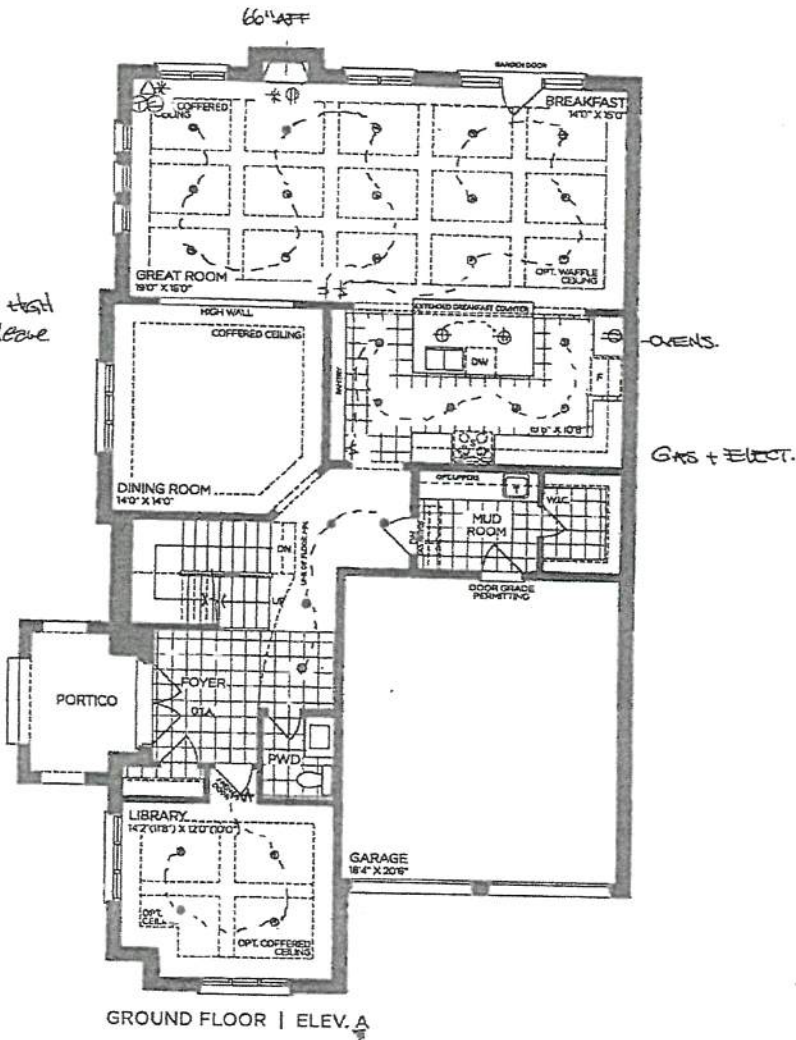

VENDOR

PURCHASER

PURCHASER

GOLDPARK
WORTH MORE™


Prices, figures, illustrations, sizes, features and finishes are subject to change without notice. Areas and dimensions are approximate and actual usable floor space may vary from the stated area. Layout may be reverse of the unit purchased. E. & O.E. 4204

SCHEDULE 'F'



PV-11
August 13 2020
REVISED
September 1, 2020

The Brookvalley
42' SERIES
Elevation A • 3,665 sq.ft.
Elevation B • 3,705 sq.ft.

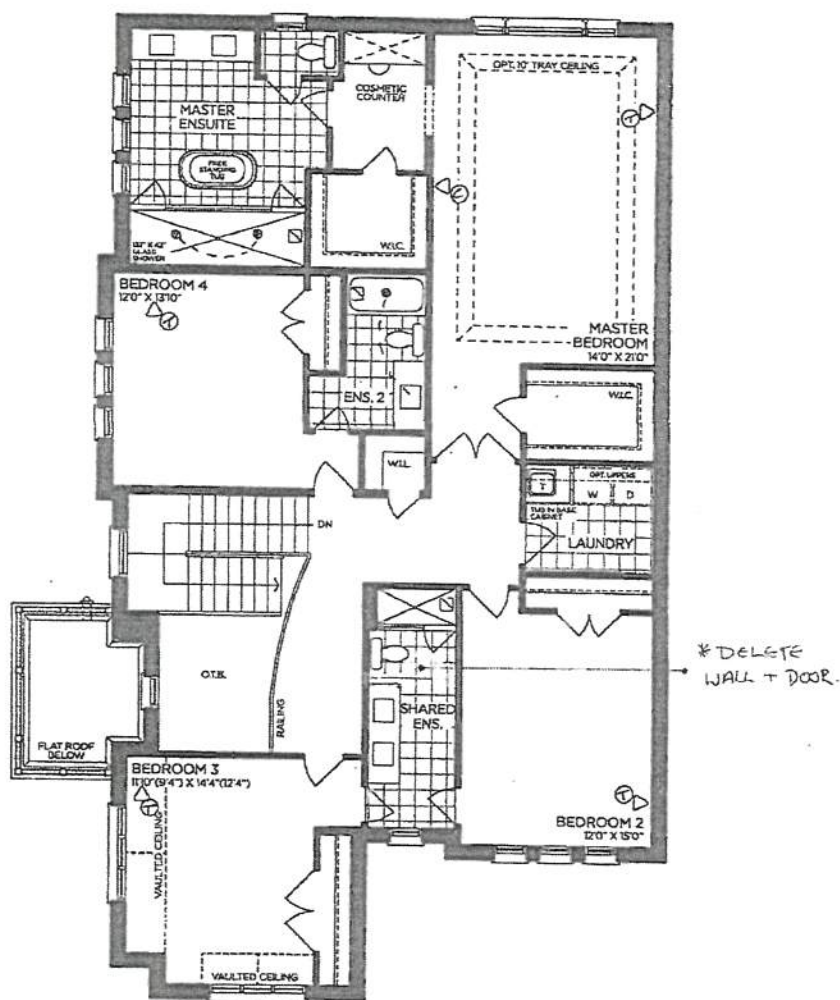

SECOND FLOOR | ELEV. A

VENDOR

PURCHASER

PURCHASER

GOLDPARK
WORTH MORE


Prices, figures, illustrations, sizes, features and finishes are subject to change without notice. Areas and dimensions are approximate and actual usable floor space may vary from the stated area. Layout may be reverse of the unit purchased. E & O.E. 4204

SCHEDULE 'F'



PV-11
August 13 200
* September 1, 2010

The Brookvalley
42' SERIES
Elevation A • 3,665 sq.ft.
Elevation B • 3,705 sq.ft.

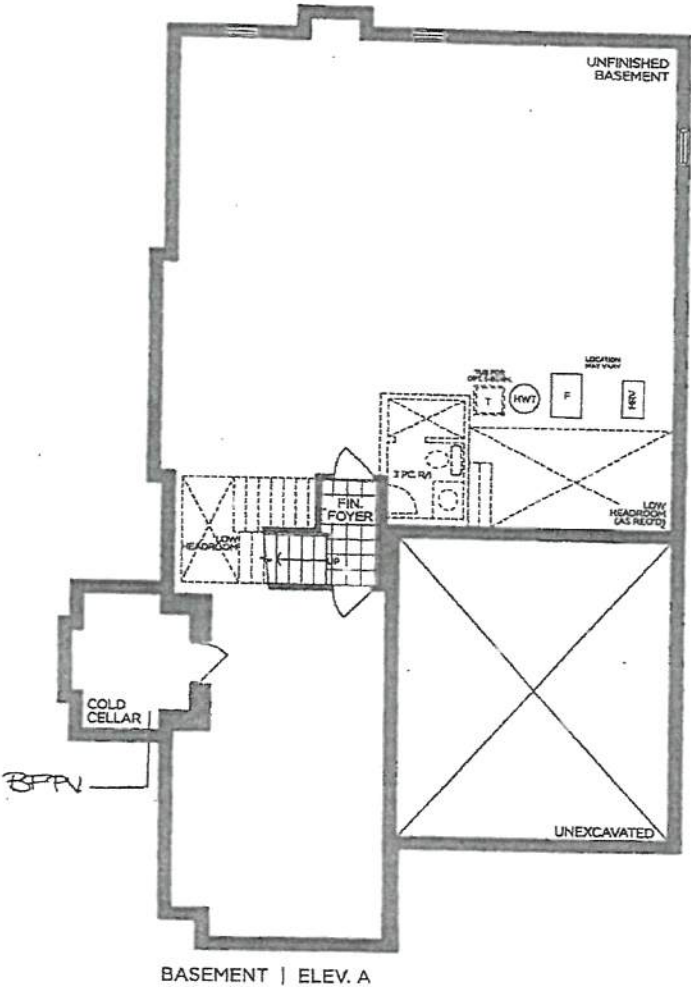

VENDOR

PURCHASER

PURCHASER

GOLDPARK
WORTH MORE

Prices, figures, illustrations, sizes, features and finishes are subject to change without notice. Areas and dimensions are approximate and actual usable floor space may vary from the stated area. Layout may be reverse of the unit purchased. E. & O.E. 4204