

Lot: 123

Model: 40.06 B LILAC

Project/Phase: Pine Valley Forevergreen / 1

CERAMIC

Qty.	Description
-	.BASEMENT - OPT. 3PC. BATHROOM COMPLETE WITH BATHROOM COMPLETE WITH BUILDERS STANDARD TOILET, PARTITION SHOWER STALL & FIXTURES.
	1

CONCRETE AND DRAIN

Invoice	Qty.	Description
2289	1	.BACK-FLOW PREVENTER VALVE
24Aug20 NoCat		
2289	1	.BASEMENT - OPT. 3PC. BATHROOM COMPLETE WITH BATHROOM COMPLETE WITH BUILDERS STANDARD TOILET, PARTITION SHOWER STALL & FIXTURES.
24Aug20 NoCat		

CROW Invoice		TOULDING Description
2289	1	.LIBRARY - OPT. LIBRARY COFFERED CEILING AS PER PLAN
24Aug20 NoCat		
2289	1	.LIBRARY - OPT. WAFFLE CEILING, BEAM DETAIL AS PER PLAN (4 BOXES) OPTION #1 CTR-B07
24Aug20 NoCat		
2289	1	.GREAT ROOM - OPT. COFFERED CEIILING AS PER PLAN
24Aug20 NoCat		
2289	1	.GREAT ROOM - OPT. WAFFLE CEILING, BEAM DETAIL AS PER PLAN (9 BOXES) OPTION # 1 CTR-B07
24Aug20 NoCat		

DisciplineMS.rpt 26jun20 Page 1 of 8



Lot: 123

Model: 40.06 B LILAC

Project/Phase: Pine Valley Forevergreen / 1

DRYWALL

Invoice	Qty.	Description
2289	1	.LIBRARY - OPT. LIBRARY COFFERED CEILING AS PER PLAN
24Aug20 NoCat		
2289	1	.LIBRARY - OPT. WAFFLE CEILING, BEAM DETAIL AS PER PLAN (4 BOXES) OPTION #1 CTR-B07
24Aug20 NoCat		
2289	1	.GREAT ROOM - OPT. COFFERED CEIILING AS PER PLAN
24Aug20 NoCat		
2289	1	.GREAT ROOM - OPT. WAFFLE CEILING, BEAM DETAIL AS PER PLAN (9 BOXES) OPTION # 1 CTR-B07
24Aug20 NoCat		



Lot: 123

Model: 40.06 B LILAC

Project/Phase: Pine Valley Forevergreen / 1

ELECTRICAL

ELECT Invoice		Description Description
		-
2289 72,289	6	.GREAT ROOM: 4" E/S LED INTERIOR POT LIGHT - GROUND FLOOR - EACH
24Aug20		INCLUDED IN APS
2289 72,289	2	.GREAT ROOM: 4" E/S LED INTERIOR POT LIGHT - GROUND FLOOR - EACH
24Aug20		USE SAME SWITCH AS STANDARD
2289 72,309 24Aug20	1	.LIBRARY: UPGRADE STANDARD CEILING MOUNT FIXTURE TO (1) LED POT LIGHT - GROUND FLOOR - SEE PLAN FOR LOCATION
2289 72,289	3	.LIBRARY: 4" E/S LED INTERIOR POT LIGHT - GROUND FLOOR - EACH
24Aug20		USE SAME SWITCH AS STANDARD
2289 72,306 24Aug20	2	.KITCHEN: RELOCATE KITCHEN SINK AND DISHWASHER FROM STANDARD LOCATION - APPROX. "NEW" LOCATION AS PER ATTACHED DRAWINGS
2289 72,268 24Aug20	5	.THRU OUT: POWDER ROOM / BASEMENT BATH / MASTER ENSUITE / ENSUITE 2 / SHARED BATH: INTERIOR WALL OUTLET: 110V WALL INTERIOR RECEPTACLE ON EXISTING CIRCUIT. LOCATE RIGHT SIDE BEHIND TOILET APPROX. 9" A.F.F. FOR FUTURE BIDET SEAT
2289 72,289	4	.KITCHEN: 4" E/S LED INTERIOR POT LIGHT - GROUND FLOOR - EACH
24Aug20		SEE PLAN FOR LOCATION
2289 72,278	1	.KITCHEN: ADDITIONAL INTERIOR SWITCH
24Aug20		FOR POTLIGHTS
2289 72,289 24Aug20	4	.DINING ROOM: 4" E/S LED INTERIOR POT LIGHT - GROUND FLOOR - EACH
2289 72,278	1	.DINING ROOM: ADDITIONAL INTERIOR SWITCH
24Aug20		FOR POTLIGHTS
2289	1	.BASEMENT - OPT. 3PC. BATHROOM COMPLETE WITH BATHROOM COMPLETE WITH BUILDERS STANDARD TOILET, PARTITION SHOWER STALL & FIXTURES.
24Aug20 NoCat		
2429	1	.KITCHEN ISLAND: ADD APPROX. 27" MICROWAVE SHELF WITH POT DRAWER BELOW - [ELECTRICAL NOT INCLUDED - PURCHASER TO ADD OWN ELECTRICAL AFTER CLOSING
24Aug20 NoCat		

DisciplineMS.rpt 26jun20 Page 3 of 8



Lot: 123

Model: 40.06 B LILAC

Project/Phase: Pine Valley Forevergreen / 1

EXTERIOR COLOURS

Invoice	Qty.	Description
2289	1	EXTERIOR COLOUR PKG # BR. 2
24Aug20 NoCat		

FORMING

Invoice	Qty.	Description
2289	1	BASEMENT WINDOWS - UPGRADE BASEMENT WINDOW SIZE TO 30 " X 24" - 8" FRAME.
72,351		
24Aug20		

FRAM	FRAMING		
Invoice	Qty.	Description	
2289 72,435 24Aug20	1	.LIBRARY - OPT. LIBRARY COFFERED CEILING AS PER PLAN	
2289 72,434 24Aug20	1	.LIBRARY - OPT. WAFFLE CEILING, BEAM DETAIL AS PER PLAN (4 BOXES) OPTION #1 CTR-B07	
2289 72,438 24Aug20	1	.GREAT ROOM - OPT. COFFERED CEIILING AS PER PLAN	
2289 72,437 24Aug20	1	.GREAT ROOM - OPT. WAFFLE CEILING, BEAM DETAIL AS PER PLAN (9 BOXES) OPTION # 1 CTR-B07	
2289 72,442 24Aug20	1	.BASEMENT - OPT. 3PC. BATHROOM COMPLETE WITH BATHROOM COMPLETE WITH BUILDERS STANDARD TOILET, PARTITION SHOWER STALL & FIXTURES.	
2289 24Aug20 NoCat	1	.THRU OUT: POWDER ROOM / BASEMENT BATH / MASTER ENSUITE / ENSUITE 2 / SHARED BATH: INTERIOR WALL OUTLET: 110V WALL INTERIOR RECEPTACLE ON EXISTING CIRCUIT. LOCATE RIGHT SIDE BEHIND TOILET APPROX. 9" A.F.F. FOR FUTURE BIDET SEAT	
2403 24Aug20 NoCat	1	KITCHEN: UPGRADE STANDARD CROWN (COMTXL) + H MOLDING + FURRING RAIL TO SERIES 3 MDF -SPRAYED FINISH NOTE: THESE **WILL NOT** MATCH REST OF CABINETRY IN COLOUR/TEXTURE/FINISH	

DisciplineMS.rpt 26jun20 Page 4 of 8



Lot: 123

Model: 40.06 B LILAC

Project/Phase: Pine Valley Forevergreen / 1

GRANITE MARBLE QUARTZ

Invoice	Qty.	Description
2289	1	.KITCHEN: RELOCATE KITCHEN SINK AND DISHWASHER FROM STANDARD LOCATION - APPROX. "NEW" LOCATION AS PER ATTACHED DRAWINGS
24Aug20 NoCat		
2403	-	KITCHEN: RAISE UPPERS (2 doors) ABOVE SINK CABINET TO APPROX. 30" CLEARANCE (COUNTER TO BOTTOM OF UPPERS) + FINISH SIDE GABLES
24Aug20 NoCat		

HVAC

Invoice	Qty.	Description
2289	1	.2ND FLOOR LAUNDRY: GAS LINE ROUGH-IN TO 2ND FLOOR OR ROOM ABOVE GARAGE FOR APPLIANCE - SEE
72,222		PLAN FOR LOCATION
24Aug20		



Lot: 123

Model: 40.06 B LILAC

Project/Phase: Pine Valley Forevergreen / 1

INTERIOR TRIM AND DOORS

Invoice	_	Description
	Qty.	Description
2289	1	.LIBRARY - OPT. LIBRARY COFFERED CEILING AS PER PLAN
24Aug20 NoCat		
2289	1	.LIBRARY - OPT. WAFFLE CEILING, BEAM DETAIL AS PER PLAN (4 BOXES) OPTION #1 CTR-B07
24Aug20 NoCat		
2289	1	.GREAT ROOM - OPT. COFFERED CEIILING AS PER PLAN
24Aug20 NoCat		
2289	1	.GREAT ROOM - OPT. WAFFLE CEILING, BEAM DETAIL AS PER PLAN (9 BOXES) OPTION # 1 CTR-B07
24Aug20 NoCat		
2289	1	.BASEMENT - OPT. 3PC. BATHROOM COMPLETE WITH BATHROOM COMPLETE WITH BUILDERS STANDARD TOILET, PARTITION SHOWER STALL & FIXTURES.
24Aug20 NoCat		
2403 153,343	1	UPGRADE 3 1/2" STEP BB CASING, 7 1/4" BASE BOARD
24Aug20		UPGRADE
2403	1	UPGRADE 3 1/2" STEP BB CASING, 7 1/4" BASE BOARD
24Aug20 ** NoCat		
2403	1	UPGRADE 3 1/2" STEP BB CASING, 7 1/4" BASE BOARD
24Aug20 ** NoCat		
2403	1	UPGRADE 3 1/2" STEP BB CASING, 7 1/4" BASE BOARD
24Aug20 ** NoCat		
2403	1	UPGRADE 3 1/2" STEP BB CASING, 7 1/4" BASE BOARD
24Aug20 ** NoCat		



Lot: 123

Model: 40.06 B LILAC

Project/Phase: Pine Valley Forevergreen / 1

KITCHEN AND BATH CABINETRY

Invoice		Description
2289	1	.KITCHEN: RELOCATE KITCHEN SINK AND DISHWASHER FROM STANDARD LOCATION - APPROX. "NEW" LOCATION AS PER ATTACHED DRAWINGS
24Aug20 NoCat		
2403 156,129	2	KITCHEN: Pots and Pans: Convert Full-Door Base Cabinet With Standard White Interior Into Base Pots & Pans Drawers Cabinet With Standard White Interior Including White 3/4" Extension Drawers (27"W-39"W Cabinet Size) - B3D - PRICE IS per cabinet - LEVEL 1
24Aug20		LEVEL I
2403	1	KITCHEN: UPGRADE STANDARD CROWN (COMTXL) + H MOLDING + FURRING RAIL TO SERIES 3 MDF -SPRAYED FINISH
24Aug20 NoCat		NOTE: THESE **WILL NOT** MATCH REST OF CABINETRY IN COLOUR/TEXTURE/FINISH
2403	1	KITCHEN: RAISE UPPERS (2 doors) ABOVE SINK CABINET TO APPROX. 30" CLEARANCE (COUNTER TO BOTTOM OF UPPERS) + FINISH SIDE GABLES
24Aug20 NoCat		
2403	4	KITCHEN: CONVERT DOOR TO CLEAR, PLAIN GLASS LOCATE 2 DOORS ON EITHER SIDE OF HOOD FAN
24Aug20 NoCat		STANDARD WHITE INTERIOR CABINET TO REMAIN
2403 156,434 24Aug20	1	Add Base Pots & Pans Drawers Cooktop Cabinet With Elite Evo Grey Interior Including Elite Anthracite Full-Extension Drawers In Stove Location (Appliance Specifications Required) (Specify Request For Push-To-Open Version) - B3DCT - PRICE IS per cabinet - LEVEL 2
2403 156,434	1	Add Base Pots & Pans Drawers Cooktop Cabinet With Elite Evo Grey Interior Including Elite Anthracite Full-Extension Drawers In Stove Location (Appliance Specifications Required) (Specify Request For Push-To-Open Version) - B3DCT - PRICE IS per cabinet - LEVEL 2
24Aug20		
2403 156,434	1	Add Base Pots & Pans Drawers Cooktop Cabinet With Elite Evo Grey Interior Including Elite Anthracite Full-Extension Drawers In Stove Location (Appliance Specifications Required) (Specify Request For Push-To-Open Version) - B3DCT - PRICE IS per cabinet -
24Aug20		LEVEL 2
2429	1	.KITCHEN ISLAND: ADD APPROX. 27" MICROWAVE SHELF WITH POT DRAWER BELOW - [ELECTRICAL NOT INCLUDED - PURCHASER TO ADD OWN ELECTRICAL AFTER CLOSING]
24Aug20 NoCat		

NETWORK AND WIRING

Invoice Qty. Description	
2289 72,260 24Aug20 1 CONDUIT PIPE - FROM ATTIC TO BASEMENT - FROM BASEMENT BY ELECTRICAL PANEL TO AP	PPROX CENTER OF

DisciplineMS.rpt 26jun20 Page 7 of 8



Lot: 123

Model: 40.06 B LILAC

Project/Phase: Pine Valley Forevergreen / 1

PAINT

Invoice	Qty.	Description
2289	1	.LIBRARY - OPT. LIBRARY COFFERED CEILING AS PER PLAN
24Aug20 NoCat		
2289	1	.LIBRARY - OPT. WAFFLE CEILING, BEAM DETAIL AS PER PLAN (4 BOXES) OPTION #1 CTR-B07
24Aug20 NoCat		
2289	1	.GREAT ROOM - OPT. COFFERED CEIILING AS PER PLAN
24Aug20 NoCat		
2289	1	.GREAT ROOM - OPT. WAFFLE CEILING, BEAM DETAIL AS PER PLAN (9 BOXES) OPTION # 1 CTR-B07
24Aug20 NoCat		

PLUMBING

	0.4	D
Invoice	Qty.	Description

2289	1	.BASEMENT - OPT. 3PC. BATHROOM COMPLETE WITH BATHROOM COMPLETE WITH BUILDERS STANDARD TOILET, PARTITION SHOWER STALL & FIXTURES.
24Aug20 NoCat		
2289	1	.KITCHEN: RELOCATE KITCHEN SINK AND DISHWASHER FROM STANDARD LOCATION - APPROX. "NEW" LOCATION AS PER ATTACHED DRAWINGS
24Aug20 NoCat		
2289	1	.THRU OUT: POWDER ROOM / BASEMENT BATH / MASTER ENSUITE / ENSUITE 2 / SHARED BATH: INTERIOR WALL
		OUTLET: 110V WALL INTERIOR RECEPTACLE ON EXISTING CIRCUIT. LOCATE RIGHT SIDE BEHIND TOILET APPROX. 9" A.F.F. FOR FUTURE BIDET SEAT
24Aug20 NoCat		
_	1	

WINDOWS - BASEMENT

Invoice	Qty.	Description

	٠,	•
2289	1	.BASEMENT WINDOWS - UPGRADE BASEMENT WINDOW SIZE TO 30 " X 24" - 8" FRAME
24Aug20 NoCat		

DisciplineMS.rpt 26jun20 Page 8 of 8

GOLDPARK
WORTH MORE* *** NOTE: This is not an approved document. Document must be locked ***
Scheduled Closing Date: Wednesday. December 16, 2020

Scheduled Closing Date: Wednesday, December 16, 2020

Purchaser:

Heung Kim

Property: 123 of Plan -

Telephone Res. / Bus: / (416) 588-9798

Project: Pine Valley Forevergreen - Phase 1

Page 1 of 4

Decor Advisor: Yola	ande Somerville M	odel and Elevation: 40.06 B LILA	iC			
Layout Changes: Yes (No Sketch Attached:	Yes O No Exterior Colour S	Scheme:			
−1. Cabinetry	Style and Colour	Counter				
Kitchen / Breakfast	Chesapeake tfoil 'classic wht	Granite: Arctic White	Hardware h309-03			
Laundry Room	*Chesapeake tfoil 'classic wht	P-Lam std white	h309-03			
Powder Room	Chesapeake tfoil 'classic wht	Quartz: Ice Snow	h309-03			
Shared Ensuite Bath	Chesapeake tfoil 'classic wht	Quartz: Ice Snow	h309-03			
Master Ensuite	Chicagodito troit diadele with	Startz. Ice Onlow	11309-03			
Bathroom	Chesapeake tfoil 'classic wht	Quartz: Ice Snow	h309-03			
Second Ensuite Bathroom (If Applicable)	Chesapeake tfoil 'classic wht	Quartz: Ice Snow	h309-03			
Basement Bath	Chesapeake tfoil 'classic wht	Quartz: Ice Snow	h309-03			
Comment						
-2. Floor Tile Entrance Vestibule	Selection 13x13" Costa matte 'White'					
Main Hall		LID DOOM				
Kitchen / Breakfast	13x13" Costa matte 'White' (MI	UD ROOM)				
Laundry Room	13x13" Costa matte 'White'					
Powder Room	13x13" Costa matte 'White'					
Basement Bathroom	13x13" Costa matte 'White'					
Master Ensuite Bathroom	13x13" Costa matte 'White'					
Second Ensuite Bathroom (If Applicable)	13x13" Costa matte 'White'					
Lower Landing (If Applicable)	13x13" Costa 'White' (basemer	nt foyer)				
Shared Ensuite Bath	13x13" Costa matte 'White'					
Comment						
-3. Wall Tile		1				
Basement Bath	Selection -8x10"-Weave-White'-	Listello/Inserts Describe				
Master Ensuite Bathroon		te Glassy"				
	Deck n/a	○ Yes ● No				
	Stall -8x10" Weave 'White' 10 x1					
Bathroom V		White Signal Yes No				
Second Ensuite Bathroom (If Applicable)	8x10" Weave "White" 10" x1	Yes No				
Shared Ensuite Bath	-8x10" Weave 'White' 10" v	Yes No				
Kitchen Backsplash	Yes No No Linda Series "	White Gloss Backsplash Behind F	ridge			
Comment						
	REVISED Sept. 17, 2020		July 87.1020			
	Assolution of the state of the		The ch			

GOLDPARK INTERIOR COLOUR SCHEME *** NOTE: This is not an approved document. Document must be locked *** Scheduled Closing Date: Wednesday, December 16, 2020 Purchaser: Heung Kim Property: 123 of Plan -Telephone Res. / Bus: / (416) 588-9798 Project: Pine Valley Forevergreen - Phase 1 **Decor Advisor:** Yolande Somerville Model and Elevation: 40.06 B LILAC 4. Plumbing Fixtures Second Ensuite **Powder Room** Master Ensuite Bathroom Other Room - Specify Other Washroom Comment Standard thru out 5. Hardwood Flooring Type and Stain Type and Stain Main Hall **Upper Landing** Kitchen / Breakfast Upper Hall **Living Room Master Bedroom Dining Room** Bedroom #2 **Family Room** Bedroom #3 Den/Library Bedroom #4 **Entrance Vestibule** Bedroom #5 **Lower Landing** Other Room - Specify 3/4x3-5/16" Mirage rd oak 'Havana' (If Applicable) ALL STD AREAS Comment STAIR LANDINGS TO BE 3/4X3-1/4" RED OAK STAINED TO MATCH STAIRS 6. Carpeting Upgrade Description **Ground Floor** n/a Second Floor n/a Type **Upgrade Underpad** Capped Runner - *Upgrade **Carpet on Stairs** Comment 7. Fireplace Living Room **Family Room** Other Room - Specify Purchased As Per Plan N/A Purchased As Per Plan N/A Purchased As Per Plan N/A \bigcirc Fireplace Type Standard Gas

Standard Mediterranean

Std Arctic White

n/a

n/a

Sept. 17, 2020

* 20 at ache d *

7,2020.

PV-123

Mantle Type

Surround

Comment

Hearth

Colour / Stain

GOLDPARK

INTERIOR COLOUR SCHEME

WORTH MORE: *** NOTE: This is not an approved document. Document must be locked ***

Scheduled Closing Date: Wednesday, December 16, 2020

Purchaser:

Heung Kim

Property: 123 of Plan -

Telephone Res. / Bus: / (416) 588-9798

Project: Pine Valley Forevergreen - Phase 1

Decor Advisor:

Yolande Somerville

Model and Elevation: 40.06 B LILAC

Railings and Spindles Railing Package Standard 2- oak Railing Colour Havana Stringer / Riser Havana Treads Havana Oak Stairs Yes No N/A Stair Landings to have 3/4x3-1/4" red oak smooth stained, same as stairs. Stair stains are to compliment hardwood floors, not an exact match Wall Paint / Ceilings Throughout Finished Areas Warm Grey Trim Paint White Smooth Ceilings Ground Floor Second Floor Note Comment		Std Carrara		Glass Inserts Standard	Door Handl	es Standard
Plaster Mouldings and Medallions Standard Throughout		Upgrade 3-1/2" 5	Step BB Casing +	7-1/4" Base Board		
Standard Throughout Yes No N/A Entrance Vestibule	Comment					
Standard Throughout Yes No N/A Entrance Vestibule						
Standard Throughout Yes No N/A Entrance Vestibule						
Standard Throughout Yes No N/A Entrance Vestibule						
Standard Throughout Yes No N/A Entrance Vestibule	Dioctor Mau	ldinas and M	III	¥		
Entrance Vestibule Main Hall Den/Library Living Room Comment			_	. I/A	v 1	
Main Hall Den/Library Lower Landing Other Room - Specify Comment Railings and Spindles Colour Havana Spindle Colour Havana Treads Havana Oak Stairs Yes No N/A Stair Landings to have 3/4x3-1/4" red oak smooth stained, same as stairs. Stair stains are to compliment hardwood floors, not an exact match Wall Paint / Ceilings Throughout Finished Areas Warm Grey Trim Paint White Smooth Ceilings Ground Floor Second Floor Rote Comment Comment Wall Paint / Ceilings Ground Floor Second Floor Note	otanuaru inroug	nout O res	○ No • I	N/A		
Lower Landing Dining Room Dining Room Dining Room Dining Room Domment Railings and Spindles Calling Package Calling Package Calling Package Calling Colour Havana Treads Havana Dak Stairs Oak Stairs	Entrance Vestibu	ıle		Kitchen/Breakfast		
Other Room - Specify Family Room Comment Railings and Spindles Railing Package Sandard 2 - oak Railing Colour Havana Spindle Colour Havana Treads Havana Oak Stairs Yes No NA Lair Landings to have 3/4x3-1/4" red oak smooth stained, same as stairs. Stair stains are to compliment hardwood floors, not an exact match Wall Paint / Ceilings Throughout Finished Areas Warm Grey Tim Paint White Smooth Ceilings Ground Floor Second Floor Second Floor Note Comment	Vlain Hall			Den/Library		
Railings and Spindles Railing Package Standard 2 - oak Stailing Colour Havana Stringer / Riser Havana Treads Havana Comment Comment Wall Paint / Ceilings Throughout Finished Areas Warm Grey Trim Paint White Smooth Ceilings Ground Floor Second Floor Second Floor Note Comment	Living Room			Lower Landing		
Railings and Spindles Railing Package Standard 2 - oak Railing Colour Havana Spindle Colour Havana Bringer / Riser Havana Treads Havana Comment Commen	Dining Room			Other Room - Specify	_	
Railings and Spindles Railing Package Railing Colour Havana Spindle Colour Havana Stringer / Riser Havana Oak Stairs Yes No N/A Stair Landings to have 3/4x3-1/4" red oak smooth stained, same as stairs. Stair stains are to compliment hardwood floors, not an exact match Wall Paint / Ceilings Throughout Finished Areas Warm Grey Firm Paint White Smooth Ceilings Ground Floor Second Floor Note Comment	Family Room					
Railings and Spindles Railing Package Standard 2 - oak Railing Colour Havana Spindle Colour Havana Stringer / Riser Havana Treads Havana Comment Comment Chair Landings to have 3/4x3-1/4* red oak smooth stained, same as stairs. Stair stains are to compliment hardwood floors, not an exact match Wall Paint / Ceilings Chroughout Finished Areas Warm Grey Firim Paint White Smooth Ceilings Ground Floor Second Floor Second Floor Note Comment	Comment					
Railing Package Railing Colour Havana Spindle Colour Havana Treads Havana Oak Stairs Yes No N/A Stair Landings to have 3/4x3-1/4* red oak smooth stained, same as stairs. Stair stains are to compliment hardwood floors, not an exact match Wall Paint / Ceilings Throughout Finished Areas Warm Grey Trim Paint White Smooth Ceilings Ground Floor Second Floor Note Comment				•		
Railing Package Railing Colour Havana Sprindle Colour Havana Treads Havana Oak Stairs Yes No N/A Stair Landings to have 3/4x3-1/4* red oak smooth stained, same as stairs. Stair stains are to compliment hardwood floors, not an exact match Wall Paint / Ceilings Throughout Finished Areas Warm Grey Frim Paint White Smooth Ceilings Ground Floor Second Floor Note Comment						
Railing Package Railing Colour Havana Spindle Colour Havana Treads Havana Oak Stairs Yes No N/A Stair Landings to have 3/4x3-1/4* red oak smooth stained, same as stairs. Stair stains are to compliment hardwood floors, not an exact match Wall Paint / Ceilings Throughout Finished Areas Warm Grey Trim Paint White Smooth Ceilings Ground Floor Second Floor Note Comment						
Stringer / Riser Havana Comment Comme				Spindle Colou	ır Havana	
Comment Oak Stairs Yes No N/A Stair Landings to have 3/4x3-1/4" red oak smooth stained, same as stairs. Stair stains are to compliment hardwood floors, not an exact match Wall Paint / Ceilings Throughout Finished Areas Warm Grey Trim Paint White Smooth Ceilings Ground Floor Second Floor Note Comment	Stringer / Riser	Havana		Treads		
Wall Paint / Ceilings Throughout Finished Areas Warm Grey Trim Paint White Smooth Ceilings Ground Floor Second Floor Note Comment						
Wall Paint / Ceilings Throughout Finished Areas Warm Grey Frim Paint White Smooth Ceilings Ground Floor Second Floor Note Comment	Comment			Oak Stairs	Yes	O No O N/A
Throughout Finished Areas Warm Grey Frim Paint White Smooth Ceilings Ground Floor Second Floor Note Comment		3/4x3-1/4" red oak s	smooth stained, same		10000	
Throughout Finished Areas Warm Grey Frim Paint White Smooth Ceilings Ground Floor Second Floor Note Comment		3/4x3-1/4" red oak s	smooth stained, same		10000	
Smooth Ceilings Ground Floor Second Floor Note Comment		3/4x3-1/4" red oak s	smooth stained, same		10000	
Throughout Finished Areas Warm Grey Frim Paint White Smooth Ceilings Ground Floor Second Floor Note Comment		3/4x3-1/4" red oak s	smooth stained, same		10000	
Smooth Ceilings Ground Floor Second Floor Note Comment	stair Landings to have		smooth stained, same		10000	
Smooth Ceilings Ground Floor Second Floor Note Comment	Stair Landings to have	Ceilings			10000	
Smooth Ceilings Ground Floor Second Floor Note Comment	Stair Landings to have	Ceilings			10000	
Ground Floor Second Floor Note Comment	Stair Landings to have	Ceilings —			10000	
Second Floor Note Comment PY-123	Stair Landings to have	Ceilings —			10000	
Note Comment PY-123	Stair Landings to have Wall Paint / Throughout Finis Trim Paint	Ceilings Shed Areas Wa			10000	
Comment PY-123	. Wall Paint / Throughout Finis Trim Paint Smooth Ceilings	Ceilings Wa			10000	
PY-123	. Wall Paint / Throughout Finis Trim Paint Smooth Ceilings Ground F	Ceilings Shed Areas Wa White			10000	
	Wall Paint / Throughout Finis Trim Paint Smooth Ceilings Ground F Second F	Ceilings Shed Areas Wa White			10000	
Dept. 17, 2020 July 27, 2020.	wall Paint / Throughout Finis Trim Paint Smooth Ceilings Ground F Second F Note	Ceilings Shed Areas Wa White			10000	
V	. Wall Paint / Throughout Finis Trim Paint Smooth Ceilings Ground F	Ceilings Shed Areas Wa White		e as stairs. Stair stains are to complimer	at hardwood floors	not an exact match

GOLDPARK WORTH MORE* *** NOTE: This is not an approved document. Document must be locked *** Olasian Data: Wednesday, December 16, 2020 Scheduled Closing Date: Wednesday, December 16, 2020 Purchaser: Heung Kim Property: 123 of Plan -Telephone Res. / Bus: / (416) 588-9798 Project: Pine Valley Forevergreen - Phase 1 **Decor Advisor:** Yolande Somerville Model and Elevation: 40.06 B LILAC 12. Electrical **Hood Fan** White Stainless \(\cap \) N/A Above Kitchen Cabinet Light () Yes (No Below Kitchen Cabinet Light Yes No Standard Appliances Over The Range Microwave Chimney Style Fan Comment 13. Heating and Air Conditioning Air Conditioning no **Gas Provisions Stove** no **Gas Provisions Dryer** yes Gas Provisions Barbecue std Comment 14. Additional Comments **Disclaimers and Notes**

- 1) Colours of all materials are as close as possible to builder's selection, but not necessarily identical due to variances in manufacturing.
- 2) Any extras listed above are null and void unless accompanied by a separate invoice/amendment. Said invoice must be paid in full.
- 3) The Purchaser acknowledges that after Interior Colour Selection form is signed and dated, no further changes will be permitted other than re-selection due to unavailability. _ Purchaser's Initials
- 4) The Purchaser acknowledges reading and accepting the "Gold Park Homes Decor Centre Disclaimers" form. This document contains other miscellaneous disclaimers.

This Interior Colour Selection is final and approved by:

Signature:

_ Date: July 27,2020.

Sept. 17,2020 A see attached to

GOLDPARI	INT *** NOTE: This is not an a Sche	ERIOR COLOUR SCHEME approved document. Document mu duled Closing Date: Wednesday, Decembe	ist be locked *** or 16, 2020
		Property: 123 of Plan -	
Telephone Res. / Bus: //		Project: Pine Valley Forevergre	en - Phase 1
Decor Advisor: Yo	landa Somerville M	odel and Elevation: 40.08 B LILAC	
Layout Changes: Yes			and the second s
Kitchen / Breakfast	Style and Colour	Counter	Harderers
	Chesapsake troil 'classic whit	Granite: Arctic Weste	h309-03
Laundry Room	"Chesapeake flot 'clessic with	P-Lam std white	h209-03
Powder Room	Chesepeake floil 'classic whit	Quartz. Ice Snow	h309-03
Shared Ensuite Bath	Chesapeake tfoil 'dissele whi	Quartz Ice Snow	h309-03
Master Ensuite			7120713
Bathroom	Chesapeake sfull 'classic wht	Quartz: loe Snow	h309-03
Second Ensuite Bathroom (if Applicable	Chesapeake floil 'classic with	Quarter Ice Snow	h309-03
Besement Bath	Photography Mat National	and the same of th	
Commune	Chesapeate tfoil 'classic whit	Quartz Ice Snow	h309-03
Kitchen / Breakfast Laundry Room Powder Room Basement Bethroom Master Ensuite Bathroom Second Ensuite Bathroom (if Applicable Lower Landing (if Applicable)	13x13" Costs White' (basemen		
Shared Ensuite Bath	13x13" Costs matte White'		Proceedings and
Comment			Ann an Anna and
TALL OF THE			
). Wall Tile	Selection	Listationserts Concrito	
Basement Both	6 rs0" Weave White'	O Yes O No	
Master Ensuite Bethroom	ক্ষাত্র প্রাপ্ত বিশ্ব বি	e filling	
	Deck ive	☐ O Yes ● No	
	Stall Bx10"Weine White' 10		
Bathroom \	Waite Na Com Say	O Yes No	
Second Ensuite Bathroom (If Applicable)	Bir107 Weave White'- 10	O Yes @ No	
Shared Ensuite Bath	- Ex10" Weave White 10"		
Kitchen Backsplesh	Yes No tone States	Backsplash Behind Fridge	
Comment	f		
Comment		Pycita	.
	4 CEVIDED # Sept 14 1010	my	7.1020
1	NAME	*V	2,

Printed 7/27/2020 14:04:06

GOLDPA	RK		TERIOR COLOUR S	CHEME ont. Document must be locked *** Wednesday, December 15, 2020
Purchaser: Telephone Res. / Bus	e course off ravirs	i his is not a	Property:	123 of Plan -
Decor Advisor:	Yolande Somerville		Model and Elevation:	Pine Valley Forevergreen - Phase 1 40.05 B LILAC
4. Plumbing Fix	tures			
		Second Ensu	ite [Powder Room
Master Ensulte Bal	throom	Other Room	Specify	Other Washroom
Comment Standard Prograd		<u></u>		Dulla Washirodai ;
	, 100		700	
5. Hardwood Flo	oring -			
Main Hell	Type and Stain		_	Type and State
Kitchen / Breakfast			Upper Landing	
Living Room			Upper Half Master Bedroom	
Dining Room			Sedroom #2	The second second second second
Family Room			Bedroom #3	
Den/Library .			Bedroom #4	
Entrance Ventibule	f		Bedroom #5	
Lower Landing (If Applicable)		······································	Other Room - Speak	Y SILVE ENGAGE
Comment	3/903-14" RED OWN STA	***	ALL STD AREAS	3/4x3-5/16" Mirage rd ook "Havarus"
6. Carpeting	· · · · · · · · · · · · · · · · · · ·			Alpa a sanaga makana
Ground Floor	Opprade	Deauription In/a		1
Second Floor		Wa		The state of the s
L				
Upgrade Underpad	Турь	······································		
Carpet on Stairs	Gipped		Russiar - N	Journdo
Comment		OM1 H.C. 11	Vertical Control of the Control of t	
	· · · · · · · · · · · · · · · · · · ·		The second secon	
7. Fireplace				
LM	ing Room		ly Room	Other Room - Specify
	Purchased As Par Plans 1	NA I	Produced As Par Plans MA	Professor As Par Plan HIS
Fireplace Type			dard Gas	0 0
Mantle Type Colour / Stain			dard Medierranean	
Surround		Sid /	Arolic White	
Hearth		iva	***************************************	
Comment	S STATE OF THE STA	1,00		PV-125
		33 17 10	70	by 27,2020.
	•	UN	•	13
A was a supplied to the		-111		

WOO	RK	INTERIOR COLOUR SCHEME
	ITH MOTE: T	his is not an approved document. Document must be locked
urchaser:	Houng Kim	Scheduled Closing Date: Wednesday, December 16, 2020
elephone Res. / But	8: /(416) 588-9798	Property: 123 of Plan
ecor Advisor:	Yolande Somerville	Project: Pine Valley Forevergreen - Phase 1 Model and Elevation: 40.06 B LNAC
		MOON and ENVENIOR: 40.05 B LILAC
B. Trim Carpent	try ———	
Interior Doors	d Canara From	nt Door Glass Inserte Standard Door Hending Standard
Interior Trim	pgrade 3-1/2" Step 88 (nt Door Glass Inserte Standard Door Hendles Standard Ceeing + 7-1/4" Base Board
Comment		
Add to the same of		Company of Administration of the Company of the Com
. Plaster Moule	dings and Medallio	ns ————
	hout O Yes O No	● N/A
Entranço Vestibul		
Main Half	• <u> - </u>	Kitchen/Breakfast
		Den/Library
Living Room		Lower Landing
Dining Room		Other Room - Specify
Family Room		
Comment		
- Marketine		
Railing Package	Obrelet 2 - cal	
Railing Package Railing Colour	Obraini 2 - est Hawana	Spindle Colour Haveon
Railing Package Railing Colour	Obraini 2 - est Hawana	Treads Havara
Railing Package Railing Colour Stringer / Riser Comment	Strate 2 - sat Havana Havana	Treads Havana Oak Stairs Yes O No O N/A
Railing Package Railing Colour Stringer / Riser Comment	Strate 2 - sat Havana Havana	Treads Havana
Railing Package Railing Colour Stringer / Riser Comment	Strate 2 - sat Havana Havana	Treads Havana Oak Stairs Yes O No O N/A
Railing Package Railing Colour Stringer / Riser Comment	Strate 2 - sat Havana Havana	Treads Havana Oak Stairs Yes O No O N/A
Railing Package Railing Colour Stringer / Riser Stringer / Riser Comment Start Landings to have 3	Hawana Hawana Hawana Makur ref ask secon sain	Treads Havana Oak Stairs Yes O No O N/A
Railing Package Railing Colour Stringer / Riser Stringer / Riser Comment Com	Strong 2 - eak Hawana Hawana McA-SHF red ank precept stain	Treads Havana Oak Stairs Yes O No O N/A
Railing Package Railing Colour Stringer / Riser Stringer / Riser Comment Com	Hawana Hawana Hawana Makur ref ask secon sain	Treads Havana Oak Stairs Yes O No O N/A
Railing Package Railing Colour Stringer / Riser Stringer / Riser Comment Star Landings to have 3 Stringer Wall Paint / Comment Com	Hawana Hawana Hawana Makur ref ask secon sain	Treads Havana Oak Stairs Yes O No O N/A
Railing Package Railing Colour Stringer / Riser Comment Co	Havana Havana Havana Asil-se ref ask secon state Cellings ed Areas Warm Grey	Treads Havana Oak Stairs Yes O No O N/A
Railing Package Railing Colour Stringer / Riser Stringer / Riser Comment Stringer Indiana In	Havana Havana Havana Havana Aso-sir red and sincoth stain Ceillings ed Areas Warm Grey White	Treads Havana Oak Stairs Yes O No O N/A
Railing Package Railing Colour Stringer / Riser Stringer / Riser Comment Disk Landings to have 3: Wall Paint / C Throughout Finish Trim Paint Smooth Ceilings Ground Finish	Havana Havana Havana Havana Aso-sir red and sincoth stain Ceillings ed Areas Warm Grey White	Treads Havana Oak Stairs Yes O No O N/A
Railing Package Railing Colour Stringer / Riser Stringer / Riser Comment State Landings to have 3 Wall Paint / C Throughout Finish Trim Paint Smooth Ceilings Ground Flor Second Flor	Hawana Hawana Hawana McA-SHF red onk process stain Ceillings and Areas Werm Grey White	Treads Havana Oak Stairs Yes O No O N/A
Railing Package Railing Colour Stringer / Riser Stringer / Riser Comment Disk Landings to have 3: Wall Paint / C Throughout Finish Trim Paint Smooth Ceilings Ground Finish	Havana Havana Havana Havana Aso-sir red and sincoth stain Ceillings ed Areas Warm Grey White	Treads Havana Oak Stairs Yes O No O N/A
Railing Package Railing Colour Stringer / Riser Stringer / Riser Comment Dial Landings to have a Wall Paint / C Throughout Finish Trim Paint Smooth Ceilings Ground Flo Second Flo Note	Havana Havana Havana Havana Aso-sir red and sincoth stain Ceillings ed Areas Warm Grey White	Treads Havana Oak Stairs Yes O No O N/A
Railing Package Railing Colour Stringer / Riser Stringer / Riser Comment District Landings to have a Land	Havana Havana Havana Havana Aso-sir red and sincoth stain Ceillings ed Areas Warm Grey White	Treads Havana Oak Stairs Yes O No O N/A
Railing Package Railing Colour Stringer / Riser Stringer / Riser Comment Dair Landren to have a Landren to	Havana Havana Havana Havana Aso-sir red and sincoth stain Ceillings ed Areas Warm Grey White	Treads Oak Stairs O Yes O No O N/A red, same as stairs. Such stairs are to compliment hardwood licens, not an exact match
Railing Colour Stringer / Riser Stringer / Riser Comment Star Landings to have 3	Havana Havana Havana Havana Aso-sir red and sincoth stain Ceillings ed Areas Warm Grey White	Treads Oak Stairs O Yes O No O N/A red, same as stairs. Such stairs are to compliment hardwood licens, not an exact match


Page 3 of 4

Printed 7/27/2020 14:04:06

WORN ROTH	" NOTE: This is not	INTERIOR COLOUR SCHEME an approved document. Documents Scheduled Closing Date: Wednesday	mont must be feeter a
		Scheduled Closing Date: Wednesday	December 18, 2020
1,1-000,138	P Name P	Property: 123 of Plan	- nevenints so' that
elephone Res. / Bus: / (416)	588-9798		Forevergreen - Phase 1
4 4 4	Somerville	Model and Elevation: 40.05 B LIL	Caprergreen - P7866 1
The same of the sa		model with Environ: 4000 8 CIC	KG
12. Electrical		The state of the s	
Hood Fan O White	Stainless () N/A	Above Kitchen Ca	binet Light 🔘 Yes 🚳 No
Standard Appliances		Below Kitchen Ca	blinet Light O Yes No
	Li		
Over The Range Microwave			
Chimney Style Fan	2		
Comment			
	***************************************	Mariana Commission	
3. Heating and Air Con		The second secon	
	amoning ———	1 Control to	-
A	yes	Gas Provisions Stove	ho
Comment	yes	Gas Provisions Barbecus	istd
	Winner		
			- 2.00
	Marine P. S. Agents	Total Control of the	***
4. Additional Comment	8-		

049.73			
			*
2 34			
**			1
			*
The second secon			
. Disclaimers and Note	-	Minneson of the Control of the Contr	
		***************************************	-
Colors of all restorate are an element	as possible to buildar's selecte	un, but not necessarily identical due to reptendes	n manufacturing.
t) Any extres listed allows gry nult and	vold unless accompanied by a	separate involverement and, fluid involve must	be paid in full.
 The Purchaser administrations due: then re-selection due to universalists 	the Interior Colour Selection for Purchasers	rivins aigned and deled, no further changes will be Inflate	provided other
		Homes Decor Cerine Disclamery* form, Tels &	cument combine
his interior Colour Selection is final			
Su			
ignature: Thanh	Anna India	4-1	
APRICATION IN THE REAL PROPERTY.	LAMBER SEA WALL		
90 164	- July	83/1670.	
PY-123		1,1010	Page 4 of 4




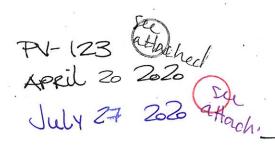

The Lilac

40' SERIES

Elevation A • 3,425 sq.ft. Elevation B • 3,385 sq.ft.

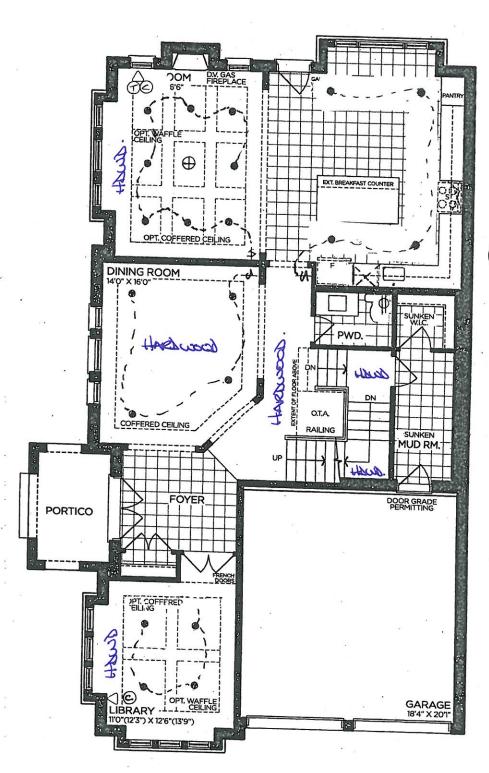

RELICONIE SINK : DIETURATER

GROUND FLOOR | ELEV. A


VENDOR
PURCHASER
PURCHASER

GOLDPARK

WORTH MORE

Prices, figures, illustrations, sizes, features and finishes are subject to change without notice. Areas and dimensions are approximate and actual usable floor space may vary from the stated area. Layout may be reverse of the unit purchased. E. & O.E. 4006




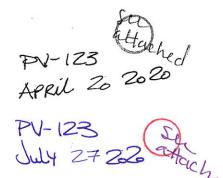

The Lilac

40' SERIES

Elevation A • 3,425 sq.ft. Elevation B • 3,385 sq.ft.

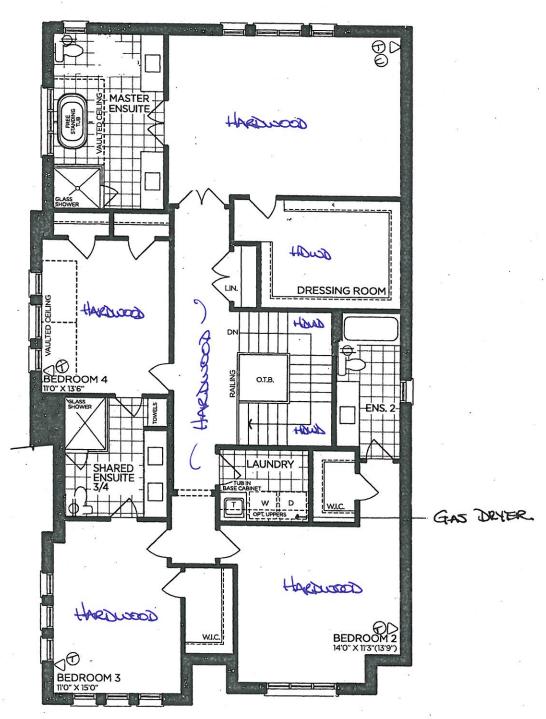


SECOND FLOOR | ELEV. A

VENDOR
PURCHASER
PURCHASER

GOLDPARK

WORTH MORE

Prices, figures, illustrations, sizes, features and finishes are subject to change without notice. Areas and dimensions are approximate and actual usable floor space may vary from the stated area. Layout may be reverse of the unit purchased. E. & O.E. 4006

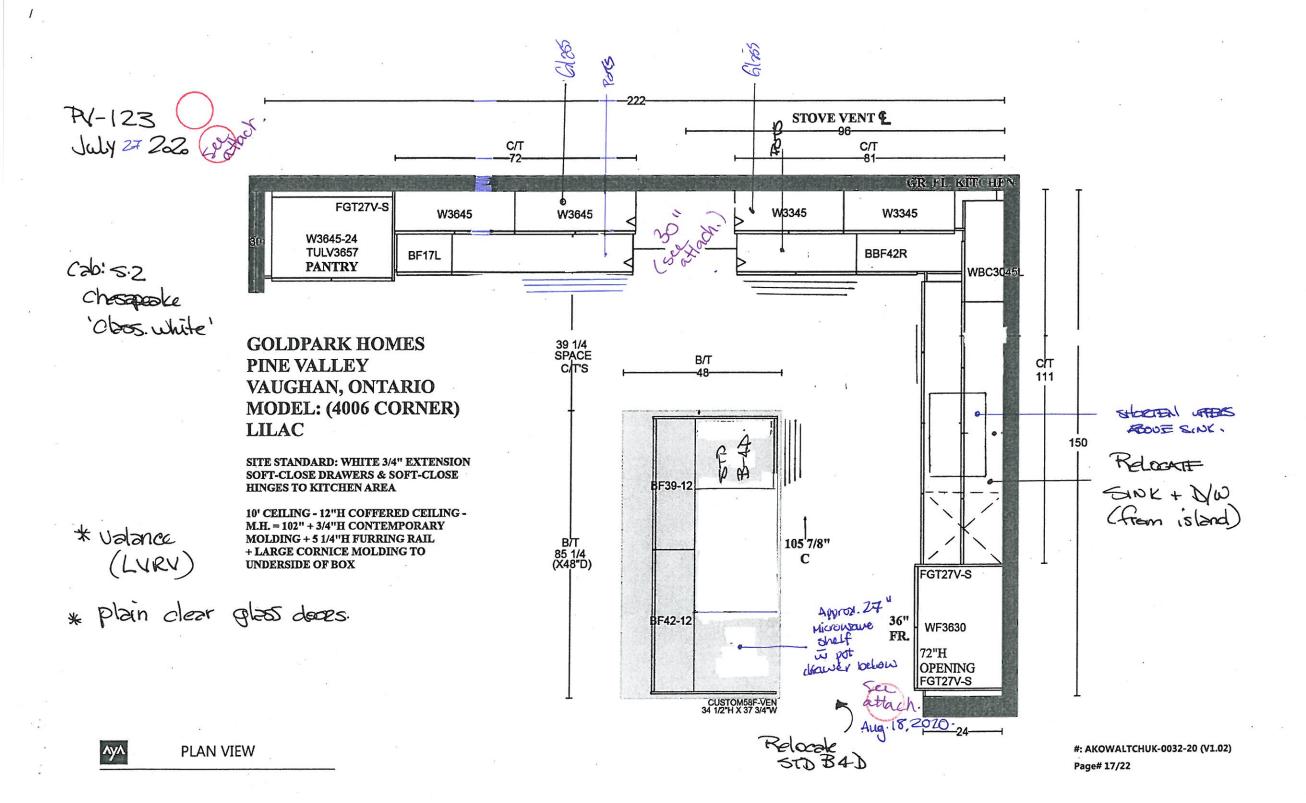



FINISHED BATH

BACK-FLOW PRETATION

VALUE

April 20 220 TV-123 April 20 20 attach

The 40' SERIES

Elevation A • 3,425 sq.ft. B • 3,385 sq.ft.

LOB UNFINISHED BASEMENT HRV (нwт) HEADROOM COLD CELLAR

BASEMENT | ELEV. A


UNFINISHED BASEMENT

VENDOR PURCHASER PURCHASER

GOLDPARK

Prices, figures, illustrations, sizes, features and finishes are subject to change without notice. Areas and dimensions are approximate and actual usable floor space may vary from the stated area. Layout may be reverse of the unit purchased. E. & O.E. 4006


UNEXCAVATED

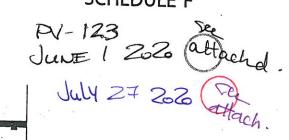


The


40' SERIES


Elevation A • 3,425 sq.ft. Elevation B • 3,385 sq.ft.

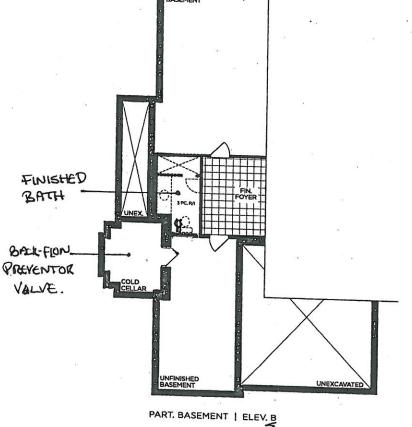

PINE VALLEY

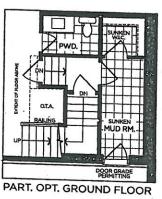

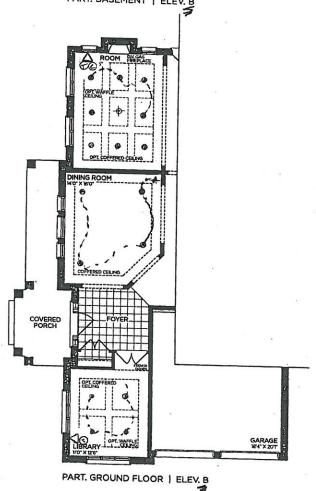


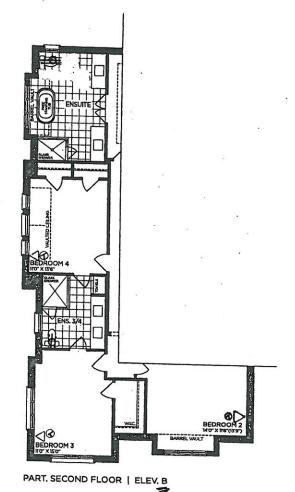

VENDOR PURCHASER PURCHASER

GOLDPARK

Prices, figures, illustrations, sizes, features and finishes are subject to change without notice. Areas and dimensions are approximate and actual usable floor space may vary from the stated area. Layout may be reverse of the unit purchased. E. & O.E. 4006

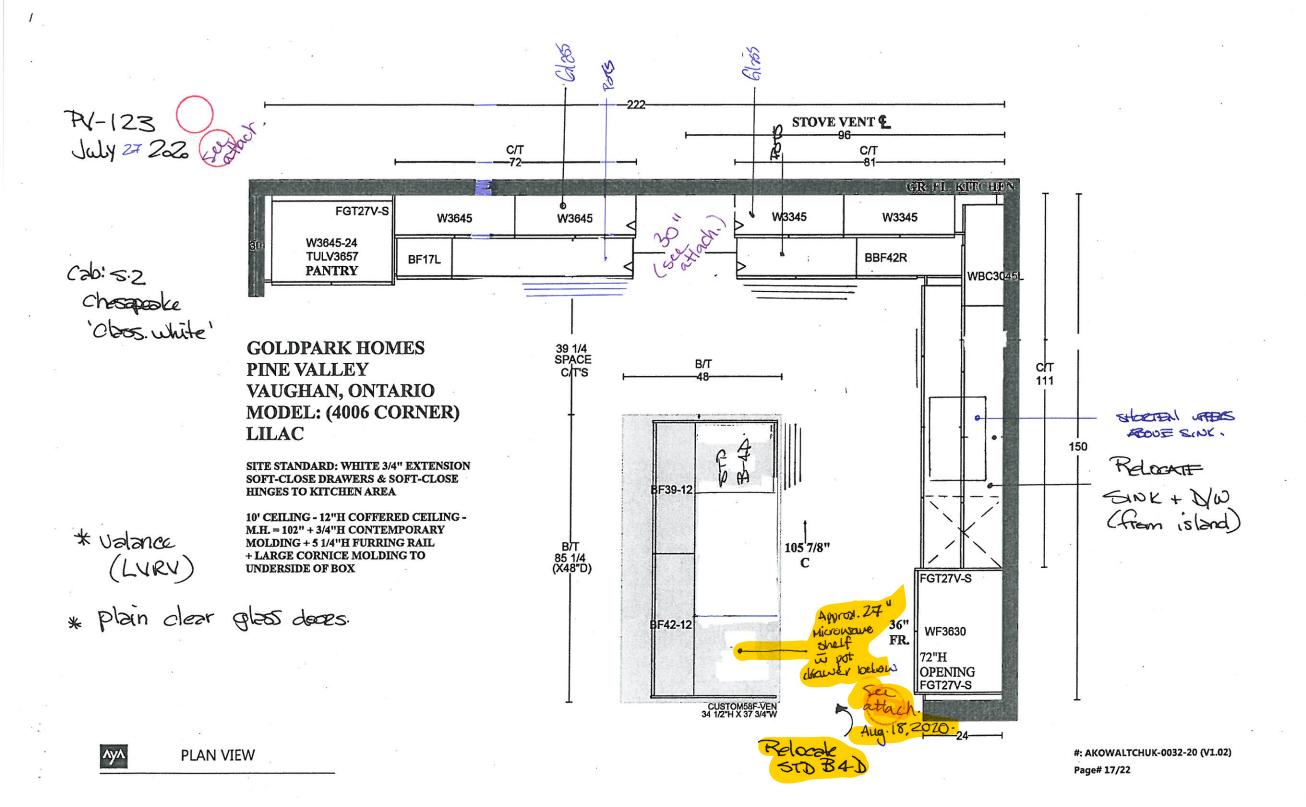






GOLDPARK HOMES PINE VALLEY VAUGHAN, ONTARIO MODEL: (4006 CORNER) LILAC


SITE STANDARD: WHITE 3/4" EXTENSION SOFT-CLOSE DRAWERS & STANDARD SLAM DOOR HINGES TO VANITIES


ONE TOP DRAWER WHERE POSSIBLE THROUGHOUT EACH VANITY, ONE BANK OF DRAWERS WHERE POSSIBLE THROUGHOUT EACH MASTER ENSUITE VANITY

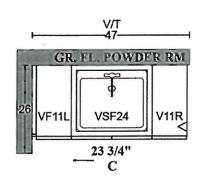


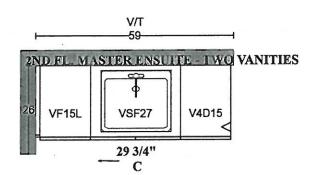

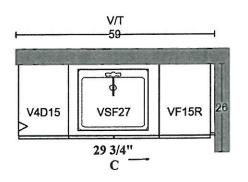

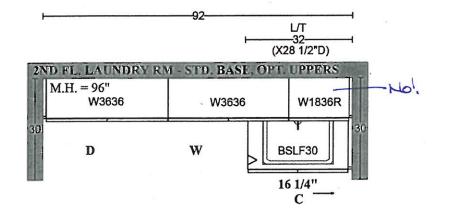

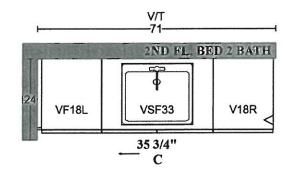

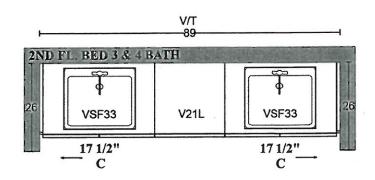





H001-02	H001-03	H001-04
H009-03	H009-09	
H011-03	H011-05	H011-06
		ı
H033-01	H039-03 THRU	PUT.
Typo* Aug.17,2020.		
LOT # 123 DATE:	7 220	
SIGNATURE: Signature: atach.	· ·	
SIGNATURE:		



STONE EDGE PROFILES

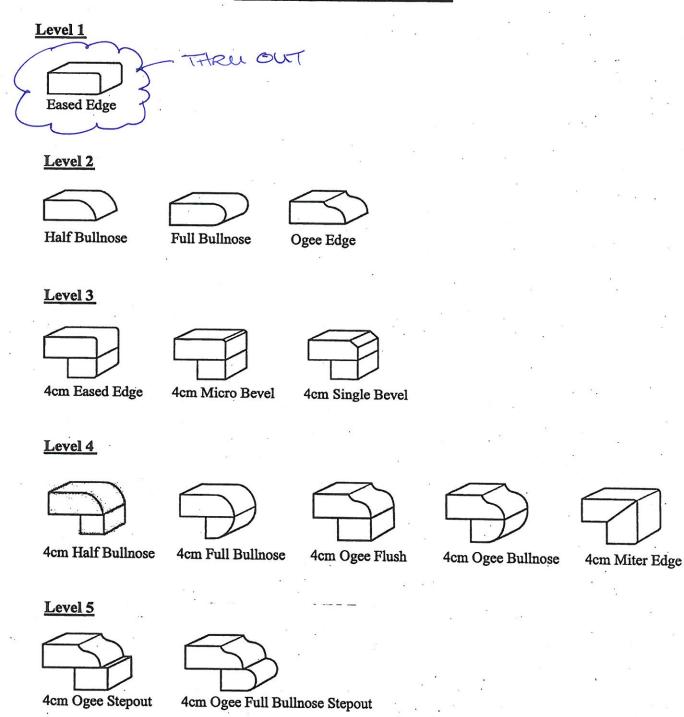

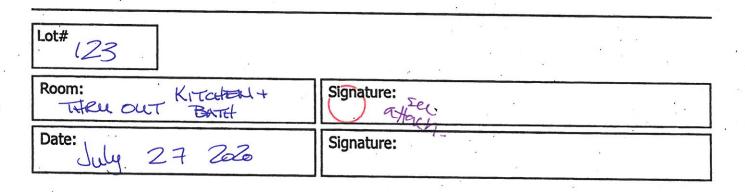









Towel Bar Mason - Chrome



INSTALL STANDARD BATHROOM ACCESSORIES THRU OUT (tissue holder + towel bar) *location as per vendors discretion*

DO NOT INSTALL STANDARD BATHROOM ACCESSORIES
THRU OUT *tissue holder + towel bar will not be provided*

LOT# 123	DATE: July 27 2020	
SIGNATURE: SEL	Sh-	
SIGNATURE:		


	NOTE: This is not an a	uled Closing Date: We	Document must be locked * dnesday, December 16, 2020
ırchaser: Heung K		Property: 123	
lephone Res. / Bus: / (416) 5			e Valley Forevergreen - Phase 1
and the second		del and Elevation: 40 (06 B LILAC
ayout Changes: Yes N	o Sketch Attached:	Yes No Exterior	Colour Scheme:
. Cabinetry	tyle and Colour	Counter	Hardware
The second secon	hesapeake tfoil 'classic wht	Granite: Arctic White	h309-03
Laundry Room	Chesapeake tfoil 'classic wht	P-Lam std white	hac9-03
	hesapeake tfoil 'classic wht	Quartz Ice Snow	h309-03
	hesapeake tfoil 'classic wht	Quartz (ce Snow	h309-03
Master Ensuite			
Bathroom	hesapeake tfoil 'classic wht	Quartz: Ice Snow	h309-03
Second Ensuite Bathroom (If Applicable)	hesapeake tfoll 'classic wht	Quartz Ice Snow	h309-03
Basement Bath	hesaceake tfoil 'classic wht	Quartz, Ice Snow	h309-03
Comment	ne apeara non classic wit	Straitz, ica Strow	181000-00
Main Hall Kitchen / Breakfast	13x13" Costa matte 'White' 13x13" Costa matte 'White' (M 13x13" Costa matte 'White' 13x13" Costa matte 'White'	ÚÐ ROOM)	
,	13x13" Costa matte 'White'		
S. St. March St. M. Chemin	13x13" Costa matte "White"		
Master Ensuite Bathroom	13x13" Costa matte 'White'		
Second Ensuite Bathroom (If Applicable)	13x13* Costa matte 'White'		
Lower Landing (If Applicable)	13x13" Costa White' (baseme	nt foyer)	
Shared Ensuite Bath	13x13" Costa matte "White"		
Comment			
3. Wall Tile Basement Bath	Selection 3x10" Weave "White"	£istello/inserto	Describe
Master Ensuite Bathroom	Landy		
	k n/a	○ Yes No	
Tub Dec	II 8x10" Weave White'	O Yes No	
	III 9X IO AASSAS AATIITS		1
Shower Sta Bathroom Wal	Control of the second s	Yes No	The second secon
Shower Sta Bathroom Wal Second Ensuite	Control of the second s	Yes No	
Shower Sta Bathroom Wal Second Ensuite Bathroom (If Applicable)	ls n/a 8x10" Weave "White"	○ Yes ● No	
Shower Sta Bathroom Wal Second Ensuite Bathroom (If Applicable) Shared Ensuite Bath	ls n/a 8x10" Weave 'White' 8x10" Weave 'White'	O Yes ● No	n Behind Fridge
Shower Sta Bathroom Wal Second Ensuite Bathroom (If Applicable)	ls n/a 8x10" Weave "White"	O Yes ● No	n Behind Fridge

OLDPAR	K		INTERIOR COLOL					
WORTH	HORE *** NOTE:		an approved doc					
		S	cheduled Closing D				er 16, 20	20
chaser:	Heung Kim			erty: 12				
	/ (416) 588-9798					Forevergr	een - Pha	ise 1
cor Advisor:	Yolande Somerville		Model and Eleval	tion: 40	.06 B LIL	AC		
Plumbing Fixtu	ires				-	 		
		Second Eng	suite		Powder	Room		
Master Ensuite Bath	room	Other Room	n - Specify		Ofher W	ashroom	F	1
Comment					Outo, 11		<u> </u>	
Standard thru out		THE PERSON NAMED OF THE PE	Committee of the Commit	- /			*	
								1
marine etterholistikus ja alagan ett			*					
Hardwood Floo	oring ———		and the state of t					
Main Hall	Type and Stain		Hannel www.	is .	Type and	Stain		
			Upper Landing	9	-			
Kitchen / Breakfast			Upper Hall				<u> </u>	
Living Room			Master Bedroo	om				
Dining Room			Bedroom #2					
Family Room			Bedroom #3			***		
Den/Library			Bedroom #4			* 40 Mg-y		*********
	parties of the special special service and the special services.				,			
Entrance Vestibule		C. 1884 (1994 - 1994) 150 150 150 150 150	Badroom #5		1			
Entrance Vestibule				Specific	L			
Entrance Vertibule Lower Landing (If Applicable) Comment STAR LANDINGS TO BE	3/4X3-1/4" RED OAK ST	AINED TO MATC	Other Room -		3/4x3-5	r16" Mirag	erd oak '	Havana'
Lower Landing (If Applicable) Comment STAR LANDINGS TO BE	3/4X3-1/4" RED OAK S.I	AINED TO MATC	Other Room -		3/4×3 5	16" Mirag	erdoak	Havana'
Lower Landing (If Applicable) Comment STAR LANDINGS TO BE	3/4X3-1/4" RED OAK S	Description	Other Room -		3/4×3 5	/16" Miraq	erdoak'	Havana'
Lower Landing (If Applicable) Comment STAR LANDINGS TO BE Carpeting Ground Floor	Systematical designation of the second	Description rVa	Other Room -		3/4×3 5	/16" Mirag	erdoak'	Havana'
Lower Landing (If Applicable) Comment STAR LANDINGS TO BE Carpeting Ground Floor	Systematical designation of the second	Description	Other Room -		3/4x3 5	/16° Miceg	erd oak '	Havana'
Lower Landing (If Applicable) Comment STAR LANDINGS TO BE Carpeting Ground Floor	Systematical designation of the second	Description rVa	Other Room -		3/4x3-5	/16" Mirag	erdoak	Havana'
Lower Landing (If Applicable) Comment STAR LANDINGS TO BE Carpeting Ground Floor	Systematical designation of the second	Description rVa	Other Room - ALL STD AREA H STAIRS		3/4x3 5	/16" Mirag	e rd oak	Havana'
Lower Landing (If Applicable) Comment STAIR LANDINGS TO BE Carpeting Ground Floor Second Floor	Upgrade	Description rVa	Other Room - ALL STD AREA H STAIRS	AS	3/45/3 5	A 6" Miceg	e rd oak '	Havana'
Lower Landing (If Applicable) Comment STAIR LANDINGS TO BE Carpeting Ground Floor Second Floor	Upgrade	Description rVa	Other Room - ALL STD AREA H STAIRS	AS		/16° Mirag	erdoak '	Havana'
Lower Landing (If Applicable) Comment STAIR LANDINGS TO BE Carpeting Ground Floor Second Floor	Upgrade	Description rVa	Other Room - ALL STD AREA H STAIRS	rós		/16° Mirag	erdoak	Havana'
Lower Landing (If Applicable) Comment STAIR LANDINGS TO BE Carpeting Ground Floor Second Floor Upgrade Underpad	Upgrade	Description rVa	Other Room - ALL STD AREA H STAIRS	rós		/16" Mirag	ard oak	Havana'
Lower Landing (If Applicable) Comment STAR LANDINGS TO BE Carpeting Ground Floor Second Floor Upgrade Underpad Carpet on Stairs	Upgrade	Description rVa	Other Room - ALL STD AREA H STAIRS	rós		A 6" Miceg	e rd oak '	Havana'
Lower Landing (if Applicable) Comment STAR LANDINGS TO BE Carpeting Ground Floor Second Floor Upgrade Underpad Carpet on Stairs	Upgrade	Description rVa	Other Room - ALL STD AREA H STAIRS	rós		/16° Micag	erdoak '	Havana'
Lower Landing (if Applicable) Comment STAR LANDINGS TO BE Carpeting Ground Floor Second Floor Upgrade Underpad Carpet on Stairs	Upgrade	Description rVa	Other Room - ALL STD AREA H STAIRS	rós		/16° Mirag	erdoak '	Havana'
Lower Landing (If Applicable) Comment SDUR LANDINGS TO BE Carpeting Ground Floor Second Floor Upgrade Underpad Carpet on Stairs Comment	Upgrade	Description rVa	Other Room - ALL STD AREA H STAIRS	rós	pgrade			Havana'
Lower Landing (If Applicable) Comment SDUR LANDINGS TO BE Carpeting Ground Floor Second Floor Upgrade Underpad Carpet on Stairs Comment	Upgrade Type Capped	Description n/a n/a	Other Room - ALL STD ARE/ H STAIRS	réa unner - "U	pgrade	ther Room -	Specify [
Lower Landing (If Applicable) Comment STURTANDINGS TO BE Carpeting Ground Floor Second Floor Upgrade Underpad Carpet on Stairs Comment	Upgrade Type Capped Ving Room Purchased As Per Plan	Description n/a n/a	Other Room - ALL STD AREA H STAIRS	róa unnor - U	pgrade	ther Room -		
Lower Landing (if Applicable) Comment STARTANDINGS TO BE Carpeting Ground Floor Second Floor Upgrade Underpad Carpet on Stairs Comment	Upgrade Type Capped	Description n/a h/a	Cither Room- ALL STD AREA H STAIRS Family Room Purchased As Per Pl	réa unner - "U	pgrade	ther Room - Purchased	Specify (
Lower Landing (if Applicable) Comment STAR LANDINGS TO BE Carpeting Ground Floor Second Floor Upgrade Underpad Carpet on Stairs Comment Fireplace Li Fireplace Type	Upgrade Type Capped Ving Room Purchased As Per Plan	Description n/a h/a	Cither Room- ALL STD AREA H STAIRS RI RI Purchased As Per Plan	réa unner - U	pgrade	ther Room - Purchased	Specify (
Lower Landing (If Applicable) Comment STAIR LANDINGS TO BE Carpeting Ground Floor Second Floor Upgrade Underpad Carpet on Stairs Comment Fireplace Li Fireplace Type Mantle Type	Upgrade Type Capped Ving Room Purchased As Per Plan	Description n/a h/a	Cither Room- ALL STD AREA H STAIRS Family Room Purchased As Per Pl Standard Gas Standard Mediterran	réa unner - U	pgrade	ther Room - Purchased	Specify (
Lower Landing (If Applicable) Comment STAIR LANDINGS TO BE Carpeting Ground Floor Second Floor Upgrade Underpad Carpet on Stairs Comment Fireplace Li Fireplace Type Mantle Type Colour / Stain	Upgrade Type Capped Ving Room Purchased As Per Plan	Description n/a h/a	Family Room Purchased As Per Pl	réa unner - U	pgrade	ther Room - Purchased	Specify (
Lower Landing (If Applicable) Comment SDAR LANDINGS TO BE Carpeting Ground Floor Second Floor Upgrade Underpad Carpet on Stairs Comment Fireplace Li Fireplace Type Mantle Type Colour / Stain Surround	Upgrade Type Capped Ving Room Purchased As Per Plan	Description n/a h/a	Family Room: Purchased As Per Pl	réa unner - U	pgrade	ther Room - Purchased	Specify (
Lower Landing (If Applicable) Comment STAIR LANDINGS TO BE Carpeting Ground Floor Second Floor Upgrade Underpad Carpet on Stairs Comment Fireplace Li Fireplace Type Mantle Type Colour / Stain	Upgrade Type Capped Ving Room Purchased As Per Plan	Description n/a h/a	Family Room Purchased As Per Pl	réa unner - U	pgrade	they Rooms- Parchised	Specify [As Per Plan O	

	K WAS NOTE:		approved document.			ed *
haser:	Heung Kim	Sci	heduled Closing Date: Wed	-	cember 16, 2020	
maser: phone Res. / Bus:			Property: 123		vergreen - Phase 1	
or Advisor:	Yolande Somerville	•	Model and Elevation: 40.06		vergreen - Filase i	
OI AUVISOE.	Totalide Somerville		model and clevation: 40.0	DULAG	opinionities statistics and security considerable	
Trim Carpentry	у					
nterior Doors Std	Carrara Fi	ont Door Glass	Inserts Standard D	oor Handl	ss Standard	-
nterior Trim Up	grade 3-1/2" Step BI	3 Casing + 7-1/4"	Base Board			
omment					the second secon	-,
The state of the s						- Alopa
	n man A co					
	ings and Medall		and the spiritings and the spiriting of	the second beautiful to the second		
	out O Yes O N	to N/A				
Intrance Vestibule	<u> </u>		Kitchen/Breakfast			
lain Hall			Den/Library			
iving Room			Lower Landing			
Dining Room			Other Room - Specify			
amily Room			1 L	-		-
Comment			-			
						1997
. Railings and	Spindles					
Railing Package	Sandard 2 - oak					
Kailing Package Railing Colour			Spindle Colour	Havana		
Railing Package	Sandard 2 - oak		Treads	Havana		
Railing Package Railing Cofour Stringer / Riser Comment	inndard 2 - oak Havana Havana		Treads Oak Stairs	Havana Yes	ONO ON	/A
Railing Package Railing Cofour Stringer / Riser Comment	inndard 2 - oak Havana Havana	atained, same as sta	Treads	Havana Yes	~ ~	/A
Railing Package Railing Cofour Stringer / Riser Comment	inndard 2 - oak Havana Havana	stained, same as sta	Treads Oak Stairs	Havana Yes	~ ~	/A
Railing Package Railing Cofour Stringer / Riser Comment Stair Lendings to have 3	Havana Havana Havana 14x3-1/4" red cak smooth	atained, same as sta	Treads Oak Stairs	Havana Yes	~ ~	/A
Railing Package Railing Cofour Stringer / Riser Comment Stair Landings to have 3	Havana Havana Havana 14x3-1/4" red cak smooth		Treads Oak Stairs	Havana Yes	~ ~	/A
Railing Package Railing Cofour Stringer / Riser Comment Stair Landings to have 3	Mandard 2 - oak Havana Havana Maya-1/4" red oak smooth		Treads Oak Stairs	Havana Yes	~ ~	/A
Railing Package Railing Cofour Stringer / Riser Comment Stair Landings to have 3	Mandard 2 - oak Havana Havana Maya-1/4" red oak smooth		Treads Oak Stairs	Havana Yes	~ ~	/A
Railing Package Railing Cofour Stringer / Riser Comment Stair Landings to have 3 Wall Paint / C Throughout Finish	Havana Havana Havana Havana		Treads Oak Stairs	Havana Yes	~ ~	/A
Railing Package E Railing Cofour Stringer / Riser Comment Stair Landings to have 3/	Havana Havana Havana Havana H		Treads Oak Stairs	Havana Yes	~ ~	/A
Railing Package Railing Cofour Stringer / Riser Comment Stair Lendings to have 3 Wall Paint / C Throughout Finish Trim Paint Smooth Ceilings Ground Flo	Finderd 2 - oak Havana Havana 4x8-1/4" red oak smooth Ceillings and Areas Warm Gr White		Treads Oak Stairs	Havana Yes	~ ~	/A
Railing Package Railing Cofour Stringer / Riser Comment Stair Landings to have 3 Wall Paint / C Throughout Finish Trim Paint Smooth Ceilings	Finderd 2 - oak Havana Havana 4x8-1/4" red oak smooth Ceillings and Areas Warm Gr White		Treads Oak Stairs	Havana Yes	~ ~	/A
Railing Package Railing Cofour Stringer / Riser Comment Stair Landings to have 3 Wall Paint / C Throughout Finish Trim Paint Smooth Ceilings Ground Flo Second Flo Note	Finderd 2 - oak Havana Havana 4x8-1/4" red oak smooth Ceillings and Areas Warm Gr White		Treads Oak Stairs	Havana Yes	~ ~	/A
Railing Package Railing Cofour Stringer / Riser Comment Stair Lendings to have 3 Wall Paint / C Throughout Finish Trim Paint Smooth Ceilings Ground Flo Second Flo	Finderd 2 - oak Havana Havana 4x8-1/4" red oak smooth Ceillings and Areas Warm Gr White		Treads Oak Stairs	Havana Yes	~ ~	

GOLDPAR WORTH M	OFF "" NOTE: This is no	INTERIOR COLOUR SCHEME of an approved document, Document must be locked *** Scheduled Closing Date: Wednesday, December 16, 2020
	Heung Kim	Property: 123 of Plan -
lephone Res. / Bus:		Project: Pine Valley Forevergreen - Phase 1
ecor Advisor:	Yolande Somerville	Model and Elevation: 40.06 B LILAC
2. Electrical		And the second s
Hood Fan O White	Stainless O N/A	Above Kitchen Cabinet Light O Yes No
		Below Kitchen Cabinet Light 🔘 Yes 🛑 No
Standard Appliances		
Over The Range Micr	owave	*
Chimney Style Fan	Z	
	Section 24	
Comment		
	and the second s	Annah da ana ana ana ana ana ana ana ana ana
3. Heating and Al	r Conditioning	
Air Conditioning	no	Gas Provisions Stove no
Gas Provisions Drye	And the same of th	Gas Provisions Barbecue std
Comment	* ····································	System of the second se
1	······································	enightende de de 1600 de de 1600 de 16
	and the second second	
,		
,		
5. Disclaimers a	SERVICE COLUMN SECURIOR CONTRACTOR CONTRACTO	·
		election, but not necessarily identical due to variances in manufacturing.
2) Any extras listed above	are null and void unless accompanied	f by a separate invoice/amendment. Said invoice must be paid in full.
The Purchaser acknowledge than re-selection due for the selection due for the selec	ledges that after Interior Culour Select	ion form is signed and dated, no further changes will be permitted other baser's initials
		leavers trimess Id Park Homes Decor Centre Disclaimers* form. This document contains
other miscellaneous di	scilliners.	Control to see page to the second control of the second control of the second s
This Interior Colour Seleg	high is final and approved by:	
xtx	m	
Signature: (X)	Date: Ju	ly 37,7020.
Trev-	123	Page 4 of 4
	Telephone of	, mgc , c. ,




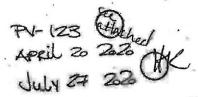

The Lilac

40' SERIES

Elevation A • 3,425 sq.ft. Elevation B • 3,385 sq.ft.

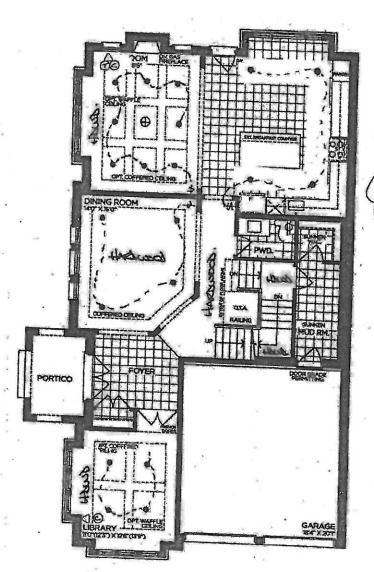

BLOOK! SINK! DISTURBER


GROUND FLOOR | ELEV. A

VENDOR	"
PURCHASER	
PURCHASER	

GOLDPARK


Prices, Rigures, dissertations, state, features and finishes are subject to change without notice. Areas and dimensions are approximate and actual usable floor space may vary from the stated area. Legout may be interested in the one without prices.



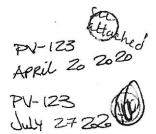


The

40' SERIES Elevation A • 3,425 sq.ft. Elevation®• 3,385 sq.ft.

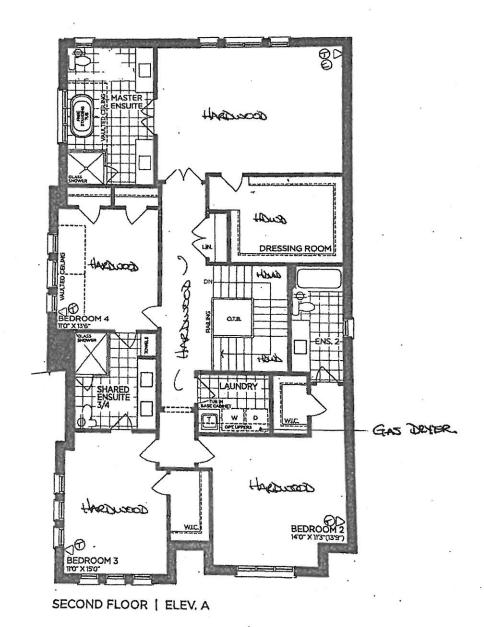

VENDOR PURCHASER PURCHASER


es, rightes, inustrations, sizes, restores and actual usable floor space may vary from the stated area, Layout may be reverse of the unit purchased, E. & O.E. 4006

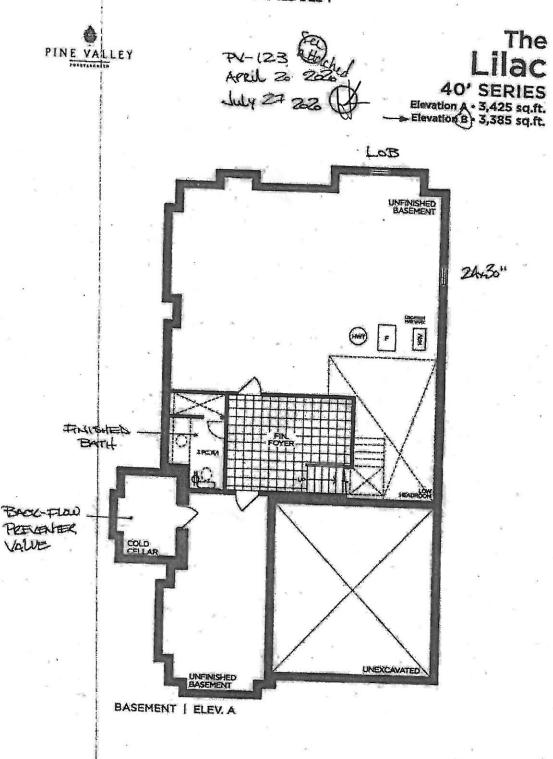


VENDOR
PURCHASER
PURCHASER


GOLDPARK

Prices, figures, illustrations, stock, features and finishes are subject to change without notice, Areas and climanslorie are approximate and actual coable floor space may very from the stated area, Leyout may be reverse of the unit purchased £ 8.0£, 4006

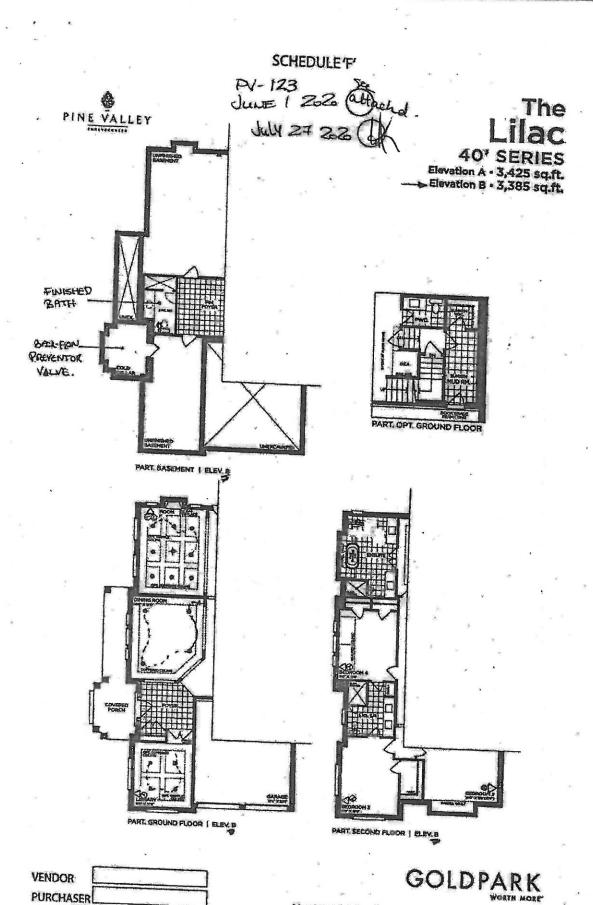

PURCHASER

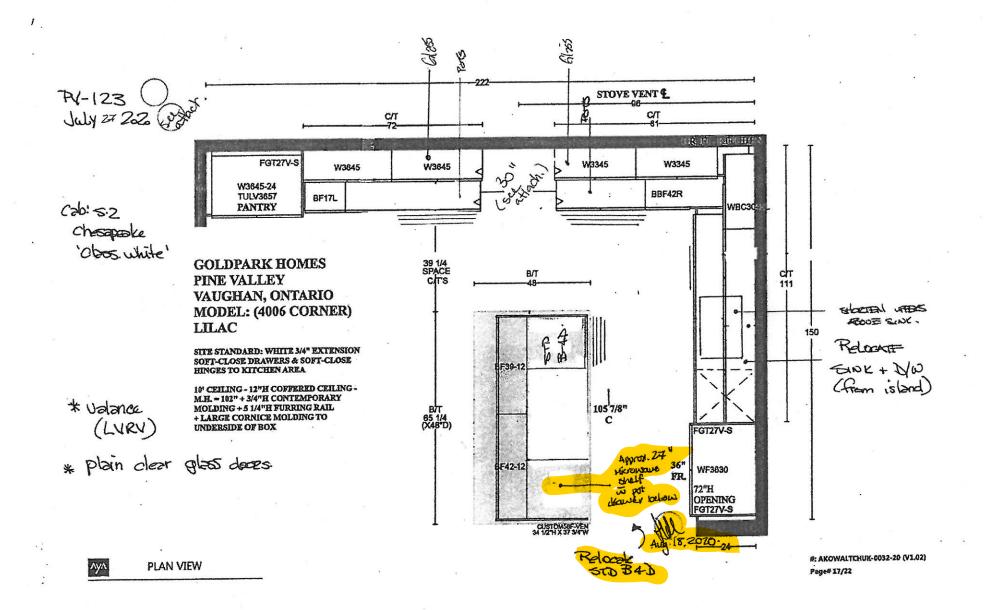

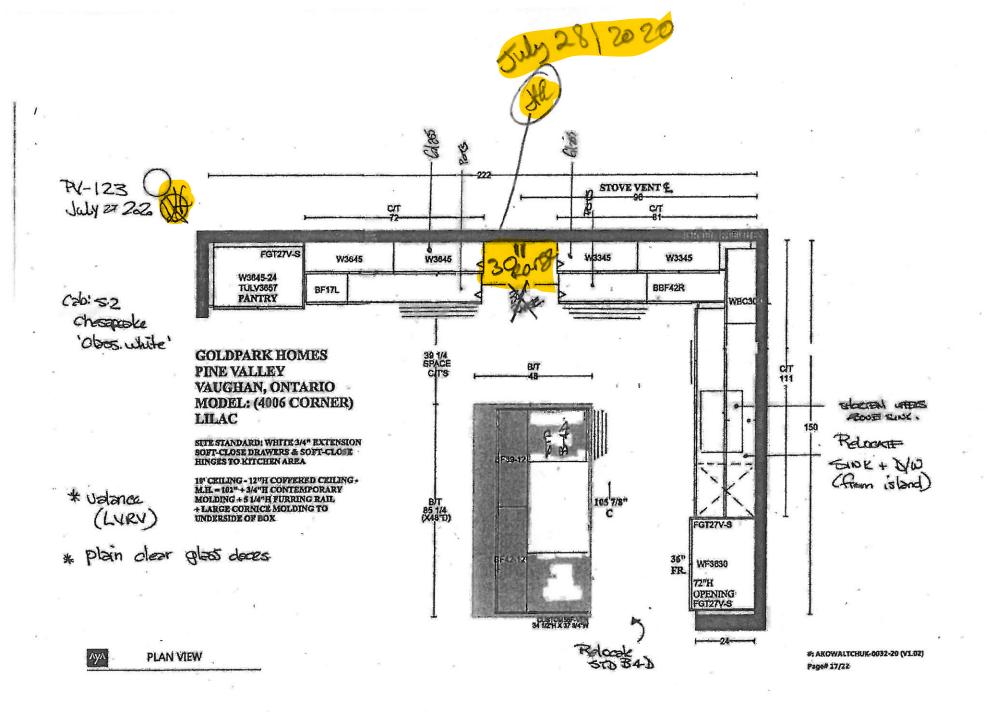



TV-123 July 27 22 00


GOLDPARK HOMES PINE VALLEY VAUGHAN, ONTARIO MODEL: (4006 CORNER) LILAC


SITE STANDARD: WHITE 3/4" EXTENSION SOFT-CLOSE DRAWERS & STANDARD SLAM DOOR HINGES TO VANITIES


ONE TOP DRAWER WHERE POS. IBLE THROUGHOUT EACH VANITY, ONE BANK OF DRAWERS WHERE POSSIBLE THROUGHOUT EACH MASTER ENSUITE VANITY

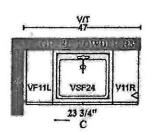


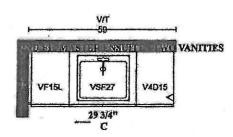

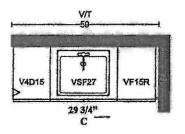

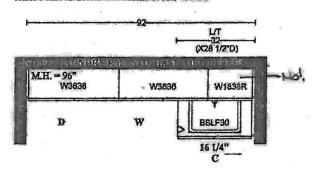

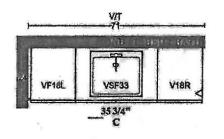


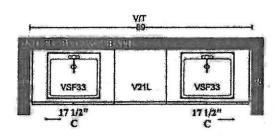


		8
STANDARD HARDWARE		VALLEY
H001-02	H001-03	H001-04
H009-03	H009-09	
H011-03		£011-06
H033-01	H039-03 THRU EUT.	
Typo# Aug. 17, 2020.		
LOT # 123 DATE July 27	226	
SIGNATURE: Fac.	*	
SIGNATURE:		
uc.		GOLDPARK




STONE EDGE PROFILES

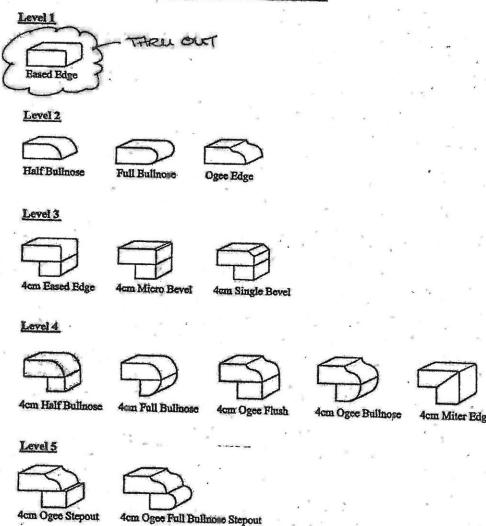


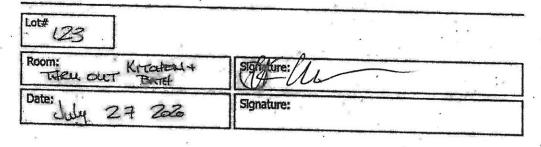



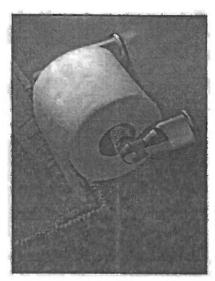



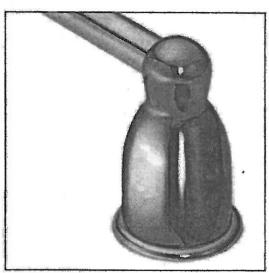

Towel Bar Mason - Chrome

- INSTALL STANDARD BATHROOM ACCESSORIES THRU OUT (tissue holder + towel bar) *location as per vendors discretion*
- *DO NOT* INSTALL STANDARD BATHROOM ACCESSORIES
 THRU OUT *tissue holder + towel bar will not be provided*

LOT# 123	DATE: July 27 2026	
SIGNATURE	h	
SIGNATURE:)	