

DRYWALL

Invoice	Qty.	Description
2374 19Jun20 NoCat	3	.BREAKFAST ROOM: UPGRADE EXTERIOR GARDEN DOOR ASSEMBLY TO 96" TALL
2374 19Jun20 NoCat	1	.BREAKFAST: - OPT. COFFERED CEILING AS PER PLAN
2374 19Jun20 NoCat	1	.BREAKFAST ROOM: - OPT. WAFFLE CEILING, BEAM DETAIL AS PER PLAN (6 BOXES) OPTION # 1 CTR-B07
2374 19Jun20 NoCat	1	.GREAT ROOM - OPT. COFFERED CEILING AS PER PLAN
2374 19Jun20 NoCat	1	.GREAT ROOM - OPT. WAFFLE CEILING, BEAM DETAIL AS PER PLAN (9 BOXES) OPTION # 1 CTR-B07
2374 19Jun20 NoCat	1	.LIBRARY PART. OPT. GROUND FLOOR - OPT. COFFERED CEILING DETAIL AS PER PLAN
2374 19Jun20 NoCat	1	.LIBRARY PART. OPT. GROUND FLOOR - OPT.WAFFLE CEILING DETAIL, BEAM DETAIL AS PER PLAN (4 BOXES) OPTION # 1 CTR-B07
2374 19Jun20 NoCat	1	.MASTER BEDROOM - OPT. 10 FOOT TRAY CEILING AS PER PLAN
2431 18Sep20 NoCat	1	**CUSTOM LAYOUT** DELETE HIGH WALL BETWEEN GREAT ROOM AND DINING ROOM
2431 18Sep20 NoCat	1	**CUSTOM LAYOUT** UPGRADE TO CURVED ARCHWAYS: MAIN HALL TO DINING + MAIN HALL TO KITCHEN

ELECTRICAL		
Invoice	Qty.	Description
2374 72,289 19Jun20	4	.DINING ROOM: 4" E/S LED INTERIOR POT LIGHT - GROUND FLOOR - EACH
2374 72,278 19Jun20	1	.DINING ROOM: ADDITIONAL INTERIOR SWITCH FOR POT LIGHTS
2374 72,310 19Jun20	2	.UPPER HALL: UPGRADE STANDARD CEILING MOUNT FIXTURE TO (1) LED POT LIGHT - SECOND FLOOR - SEE PLAN
2374 72,290 19Jun20	5	.UPPER HALL: 4" E/S LED INTERIOR POT LIGHT (INSULATED CEILING) - SECOND FLOOR - EACH USE SAME SWITCH AS STANDARD
2374 72,280 19Jun20	1	.MASTER ENSUITE: CEILING OUTLET: ADDITIONAL REINFORCED CEILING OUTLET - LOCATE APPROX CENTER ABOVE TUB
2374 72,278 19Jun20	1	.MASTER ENSUITE: ADDITIONAL INTERIOR SWITCH FOR LIGHT ABOVE TUB
2374 72,279 19Jun20	2	.MASTER ENSUITE: SHOWER POT LIGHT: 6" RECESSED SHOWER POT LIGHT SAME SWITCH AS STANDARD
2374 19Jun20 NoCat	1	MASTER ENSUITE: ADD 2ND SEPARATE SHOWER
2431 72,291 18Sep20	10	EXTERIOR LED SOFFIT POT LIGHT - EACH (LOCATION TO BE DETERMINED AT COLOUR APPOINTMENT) INCLUDED IN APS
2431 18Sep20 NoCat	1	GREAT ROOM: ROUGH IN ELECTRICAL FOR WALL SCONCES ON FIREPLACE WALL - APPROX 80" A.F.F. + SINGLE POLE SWITCH - SEE PLAN
2431 18Sep20 NoCat	1	**CUSTOM LAYOUT** DELETE HIGH WALL BETWEEN GREAT ROOM AND DINING ROOM
2460 72,291 25Sep20	10	EXTERIOR LED SOFFIT POT LIGHT - EACH - includes 1 switch in foyer INCLUDED IN APS SEE ATTACHED ELEVATION FOR APPROX LOCATIONS
2460 72,291 25Sep20	2	EXTERIOR LED SOFFIT POT LIGHT - EACH see attached elevation for approx locations



CONSTRUCTION SUMMARY

Lot: 131

Model: 42.04 A BROOKVALLEY

Project/Phase: Pine Valley Forevergreen / 1

EXTERIOR COLOURS

Invoice	Qty.	Description
2261 19Jun20 NoCat	1	EXTERIOR COLOUR PACKAGE # BR.5
2431 18Sep20 NoCat	1	EXTERIOR BRICK PACKAGE BR5

FORMING

Invoice	Qty.	Description
2261 19Jun20 NoCat	1	DELETE - EGRESS BASEMENT WINDOW 47 " X 35" - 8" FRAME
2374 19Jun20 NoCat	2	.BASEMENT WINDOWS - UPGRADE BASEMENT WINDOW SIZE TO 30 " X 24" - 8" FRAME



SCHEDULE 'F'


"All" AS BUILT

TV-131
April 1 2020

June 18 2020
August 19 2020 *see attached*

The Brookvalley 42' SERIES

→ Elevation A • 3,665 sq.ft.
Elevation B • 3,705 sq.ft.

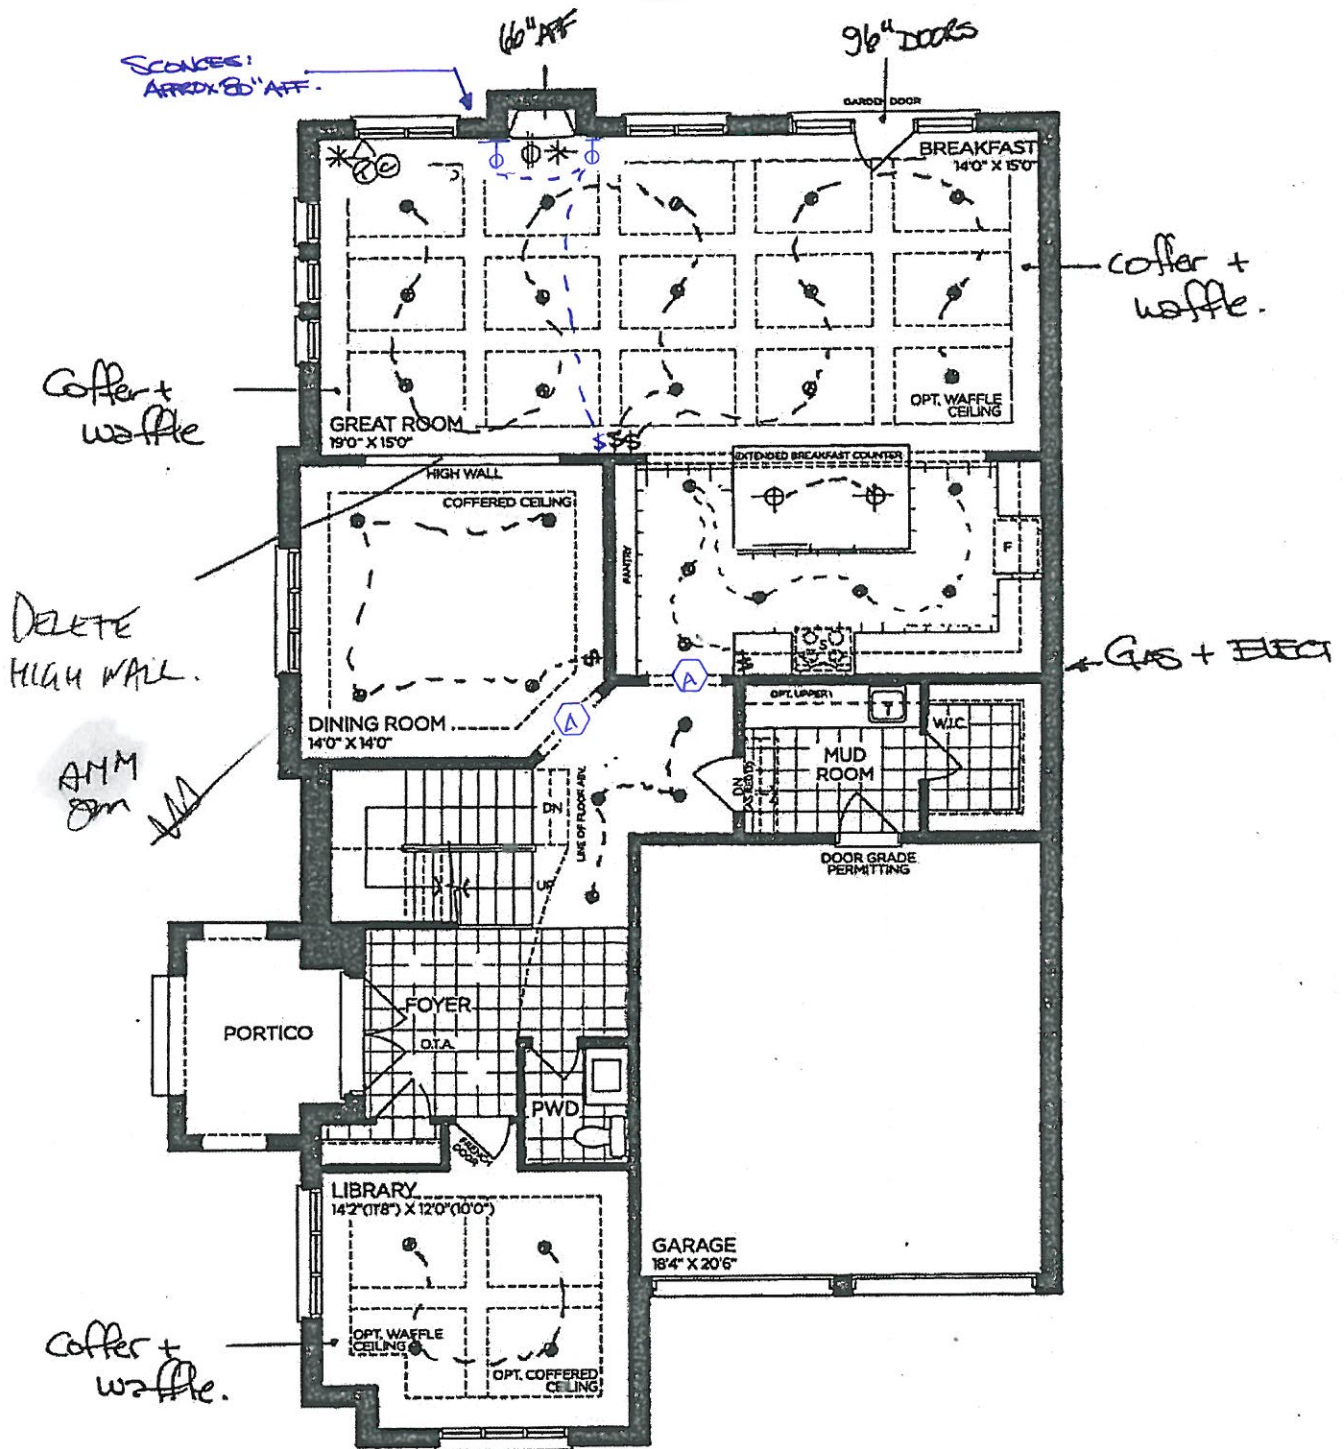

GROUND FLOOR | ELEV. A

(A) = CURVED Arch

[Handwritten signature]

VENDOR

PURCHASER

PURCHASER

AMM
<i>[Signature]</i>

GOLDPARK
WORTH MORE™

Prices, figures, illustrations, sizes, features and finishes are subject to change without notice. Areas and dimensions are approximate and actual usable floor space may vary from the stated area. Layout may be reverse of the unit purchased. E. & O.E. 4204



SCHEDULE 'F'


"A" AS BUILT

PV-131
APRIL 1 2020
JUNE 18 2020
AUGUST 19 2020 *see attached*

The Brookvalley

42' SERIES

Elevation A • 3,665 sq.ft.
Elevation B • 3,705 sq.ft.

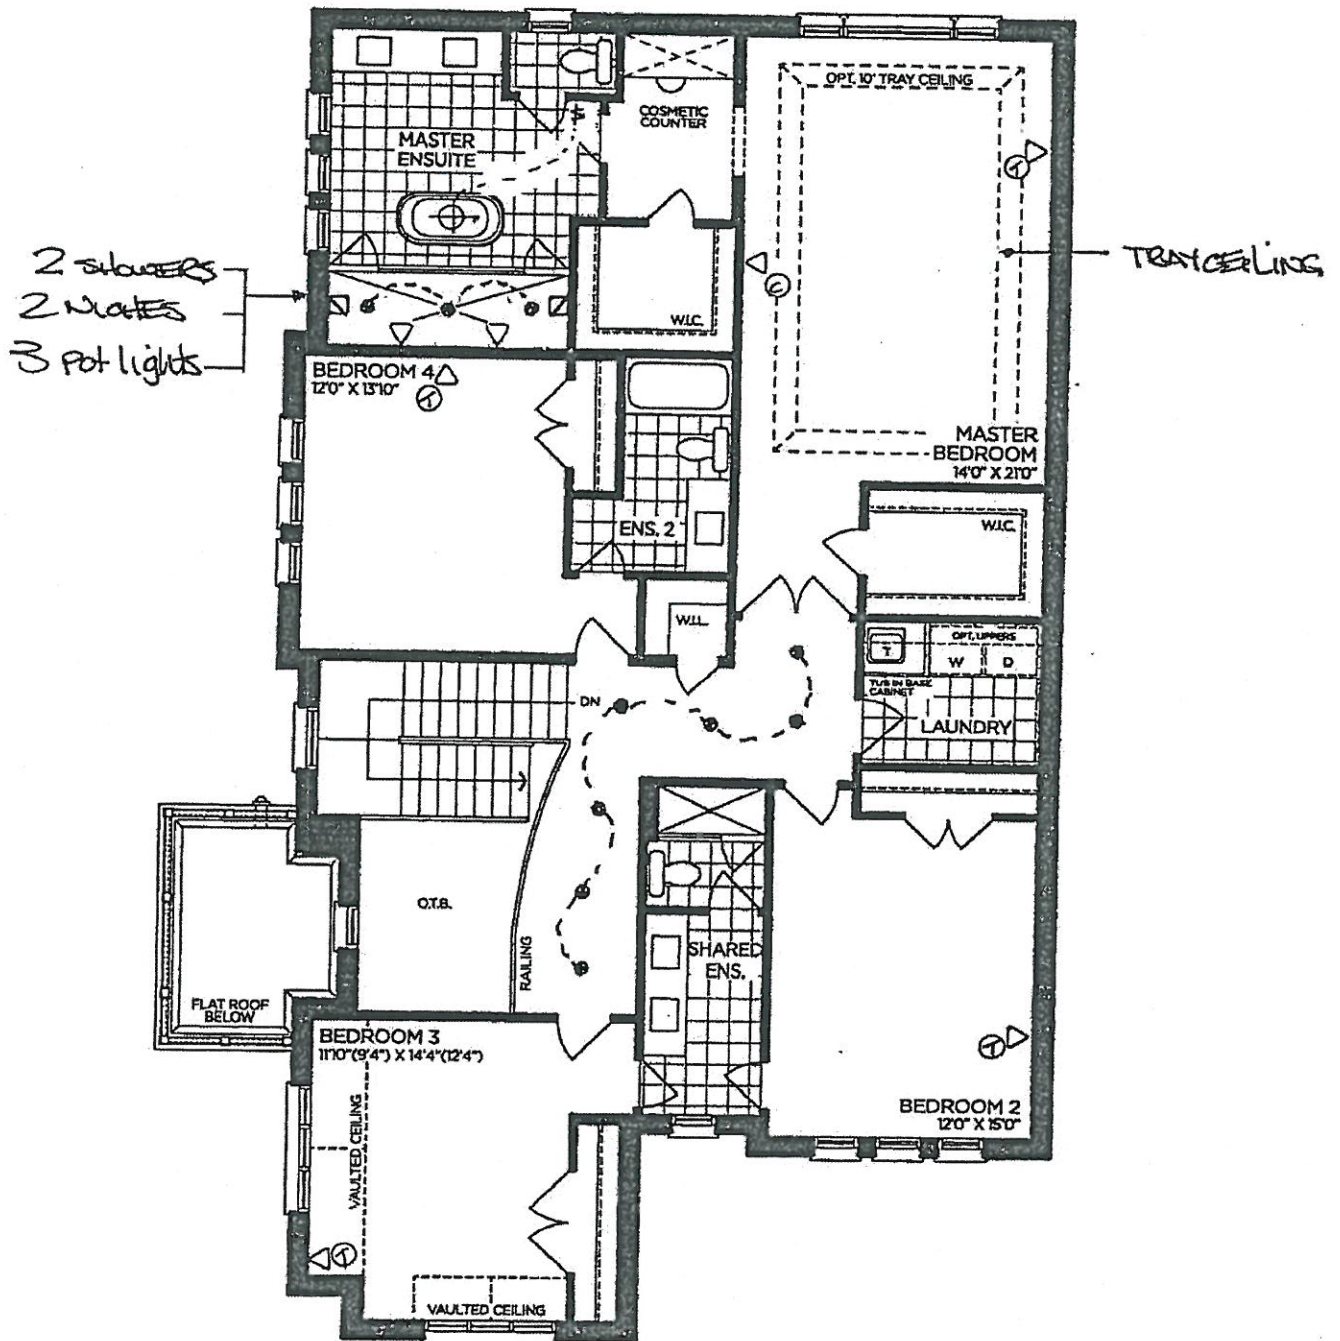

SECOND FLOOR | ELEV. A

VENDOR
PURCHASER
PURCHASER

GOLDPARK
WORTH MORE™

Prices, figures, illustrations, sizes, features and finishes are subject to change without notice. Areas and dimensions are approximate and actual usable floor space may vary from the stated area. Layout may be reverse of the unit purchased. E. & O.E. 4204



SCHEDULE 'F'

"A" AS BUILT

The Brookvalley

42' SERIES

Elevation A • 3,665 sq.ft.
Elevation B • 3,705 sq.ft.


PV-131

April 1 2020

REVISED June 18 2020

August 19 2020

see attached

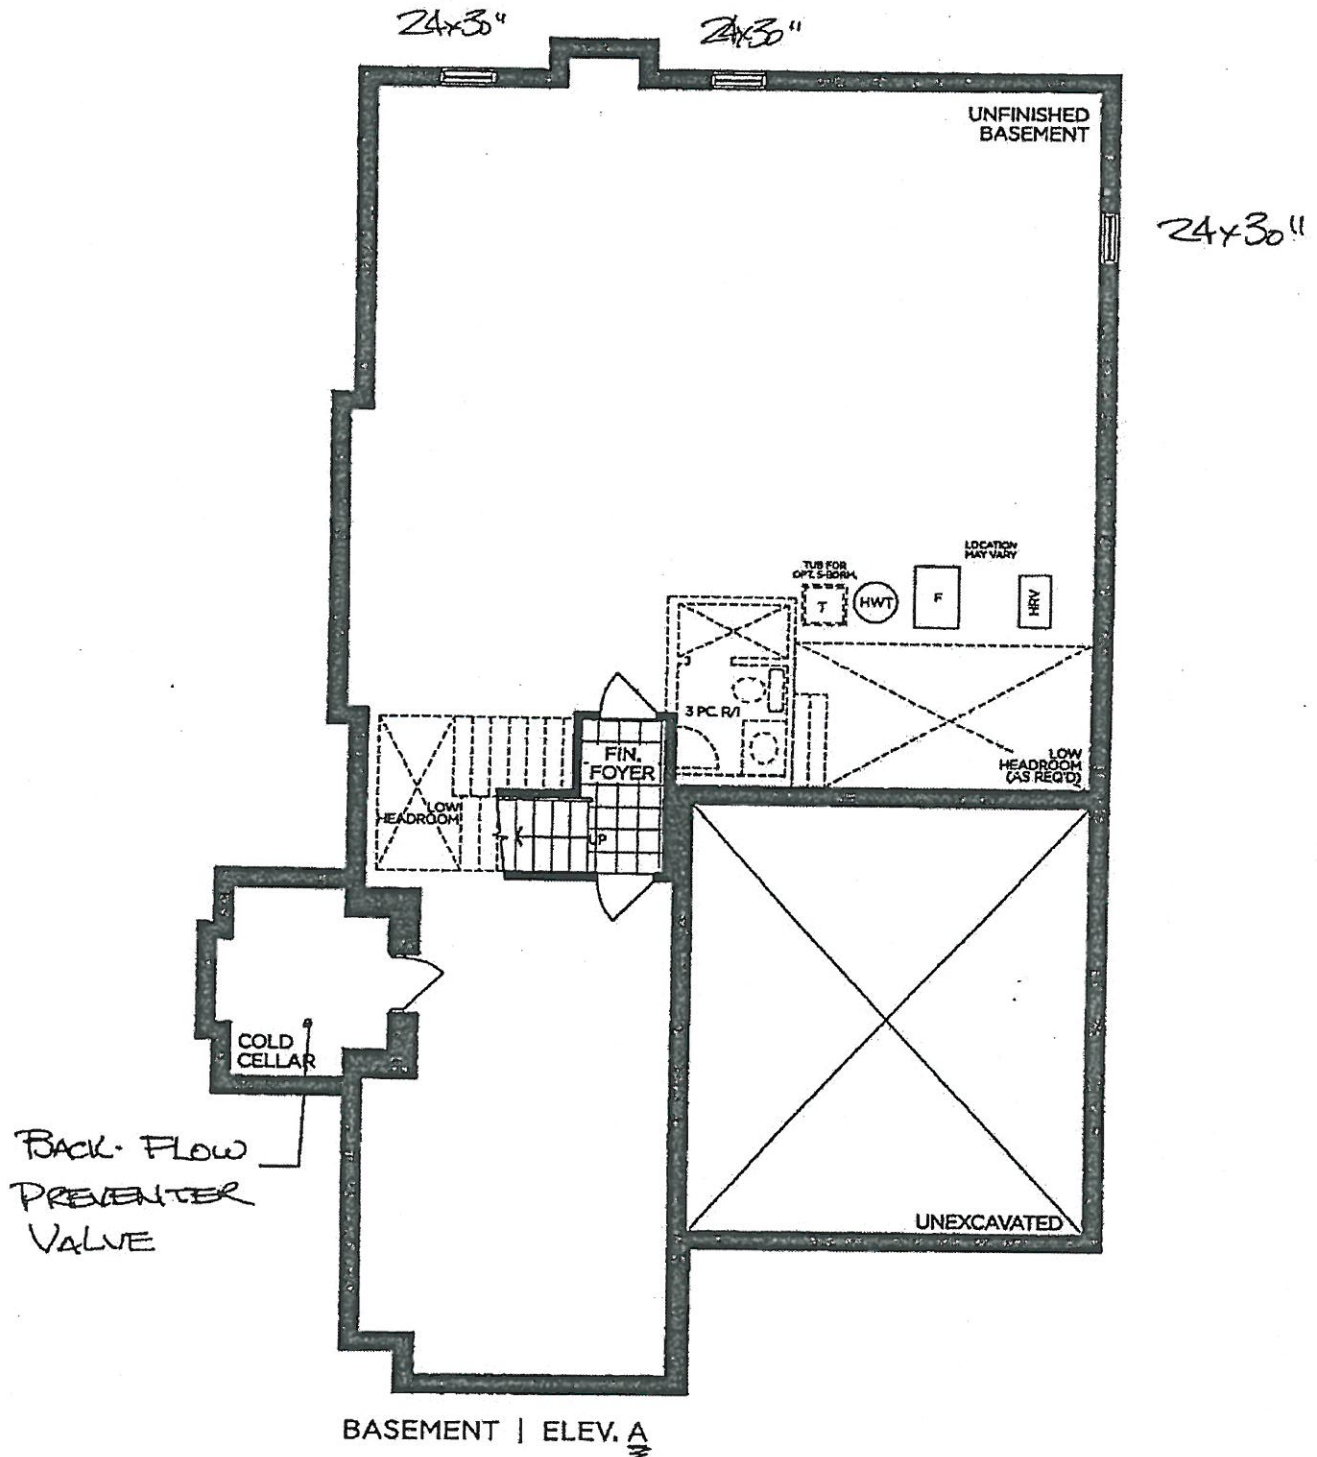

BACK-FLOW
PREVENTER
VALVE

BASEMENT | ELEV. A

[Handwritten signature]

VENDOR
PURCHASER
PURCHASER

GOLDPARK
WORTH MORE™

Prices, figures, illustrations, sizes, features and finishes are subject to change without notice. Areas and dimensions are approximate and actual usable floor space may vary from the stated area. Layout may be reverse of the unit purchased. E. & O.E. 4204



SCHEDULE 'F'

"All"

AS BUILT

PV-131

April 1 2020

June 18 2020


August 19 2020

AMM

The Brookvalley

42' SERIES

Elevation A • 3,665 sq.ft.
Elevation B • 3,705 sq.ft.

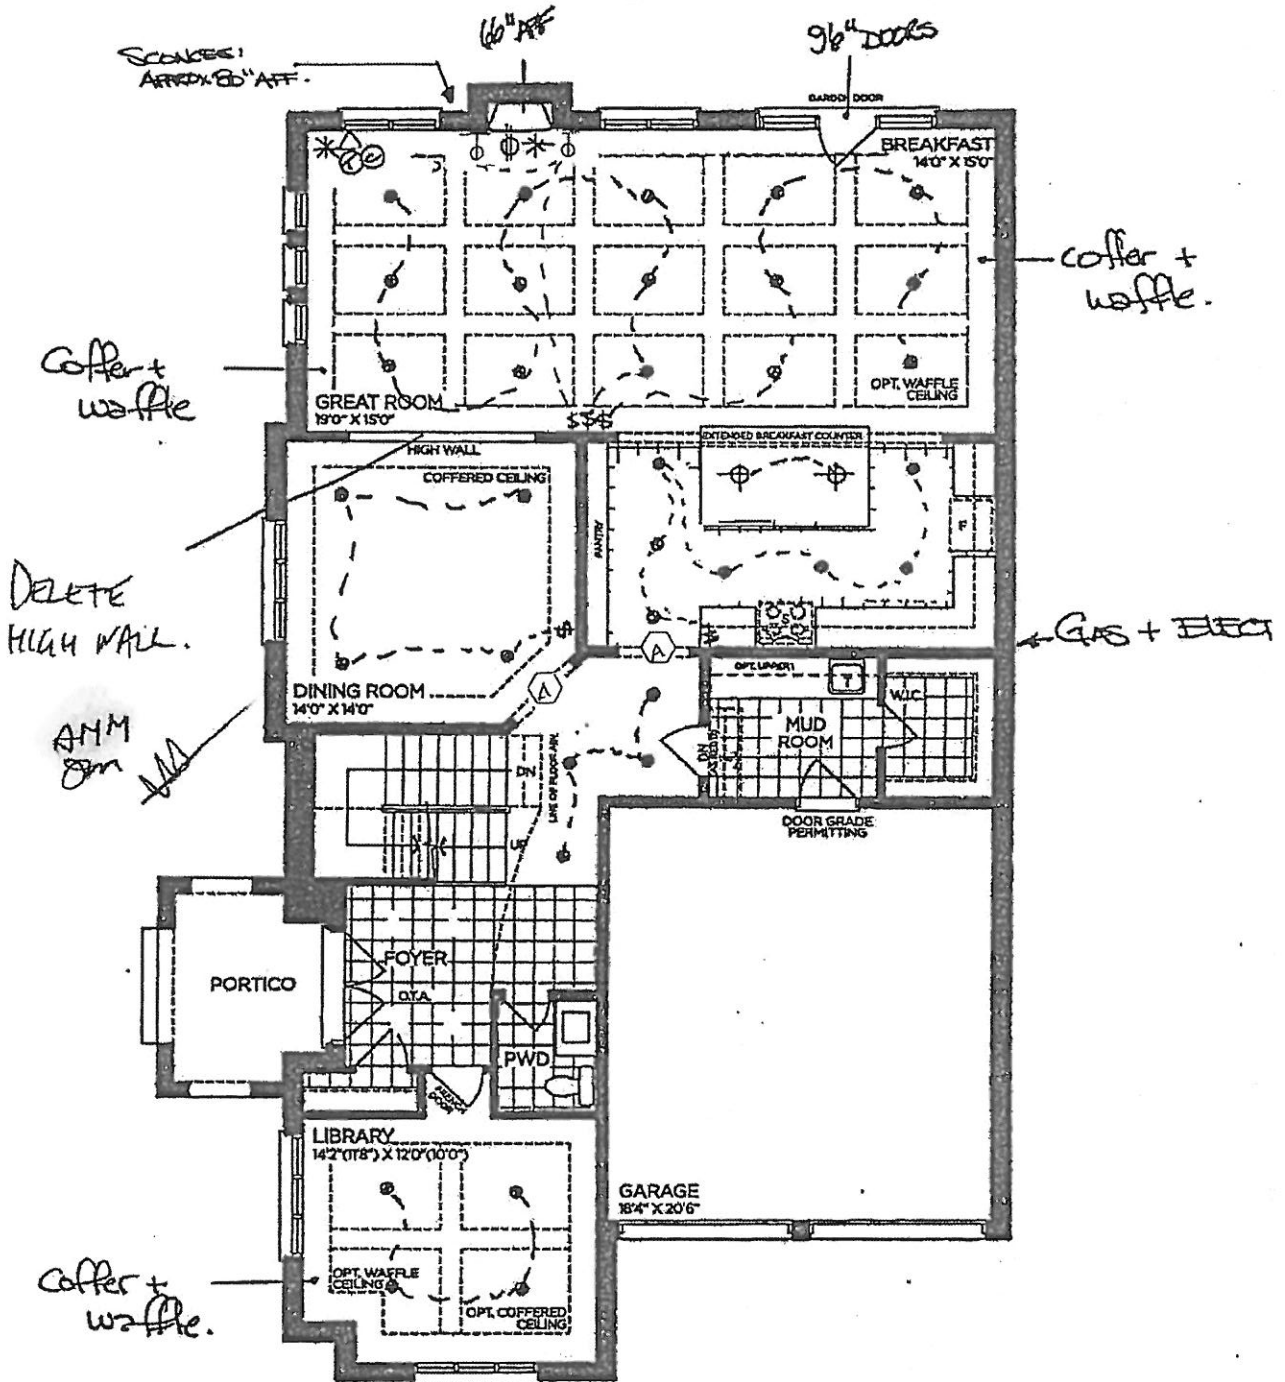

GROUND FLOOR | ELEV. A

(A) = CURVED ARCH

VENDOR

PURCHASER

PURCHASER

AMM
AMM

GOLDPARK
WORTH MORE™

Prices, figures, illustrations, sizes, features and finishes are subject to change without notice. Areas and dimensions are approximate and actual usable floor space may vary from the stated area. Layout may be reverse of the unit purchased. E. & O.E. 4204



SCHEDULE 'F'

AS BUILT

PV-131

APRIL 1 2020

JUNE 18 2020


AUGUST 19 2020

gm

AMM

The Brookvalley 42' SERIES

Elevation A • 3,665 sq.ft.
Elevation B • 3,705 sq.ft.

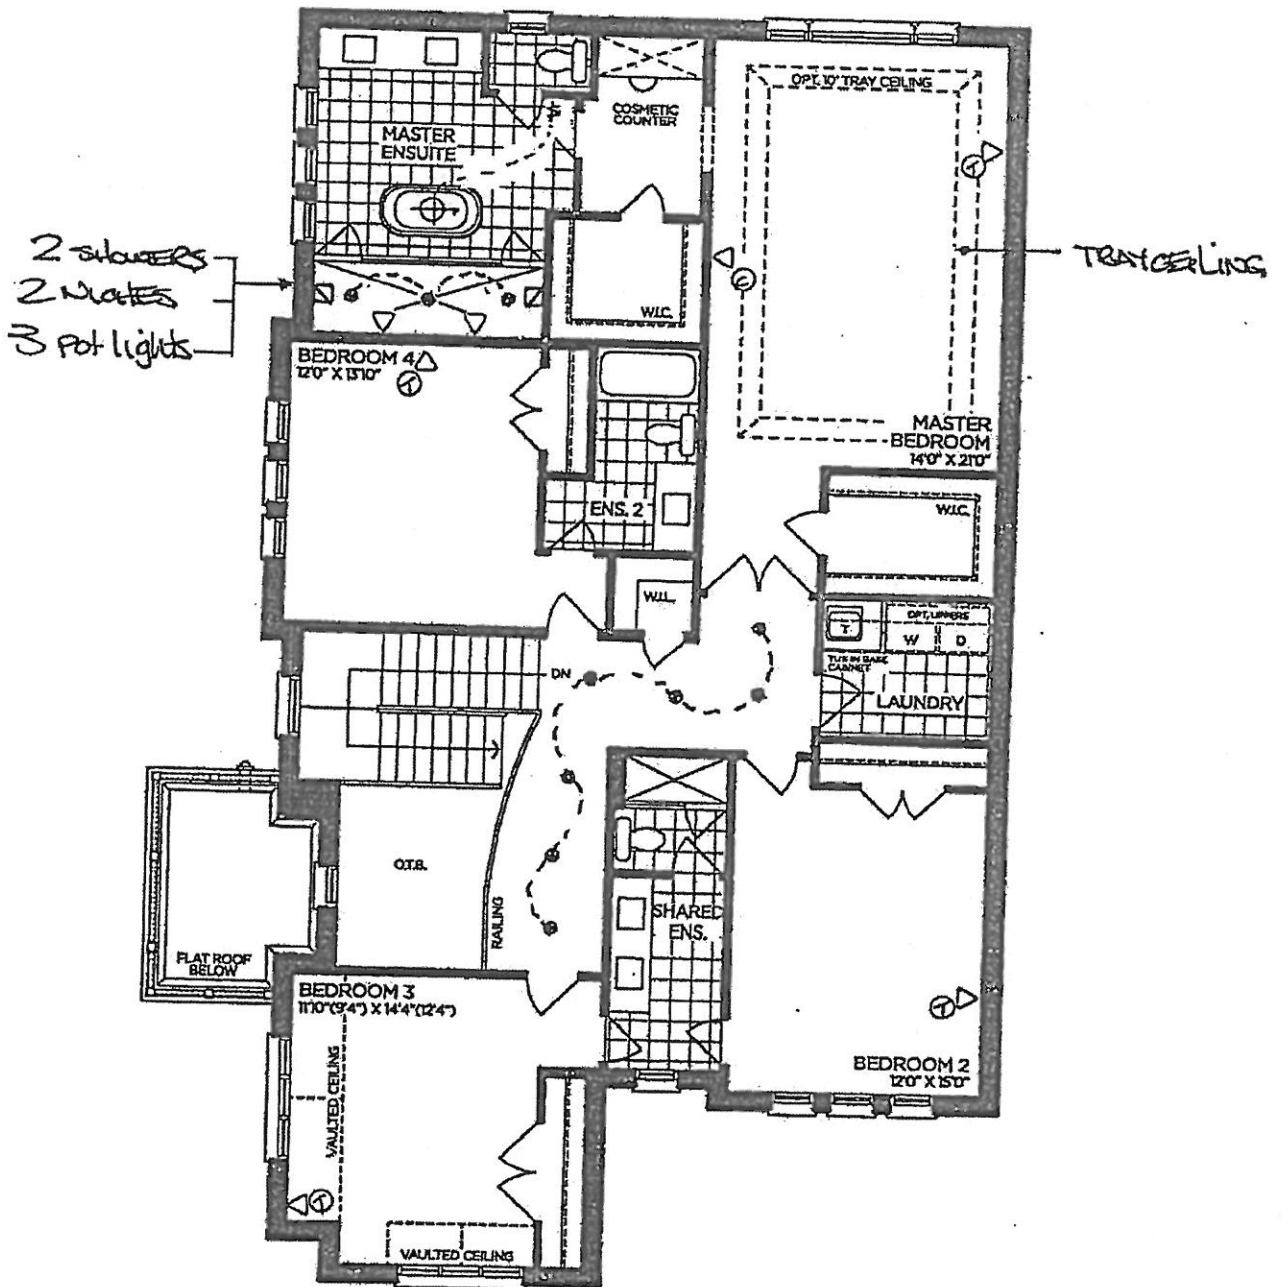

SECOND FLOOR | ELEV. A

VENDOR
PURCHASER
PURCHASER

GOLDPARK
WORTH MORE

Prices, figures, illustrations, sizes, features and finishes are subject to change without notice. Areas and dimensions are approximate and actual usable floor space may vary from the stated area. Layout may be reverse of the unit purchased. E & OE, 4204



SCHEDULE 'F'

"A" AS BUILT

PV-131

April 1 2020

REVISED June 18 2020

August 19 2020


The Brookvalley

42' SERIES

→ Elevation A • 3,665 sq.ft.
Elevation B • 3,705 sq.ft.

8M

AMM

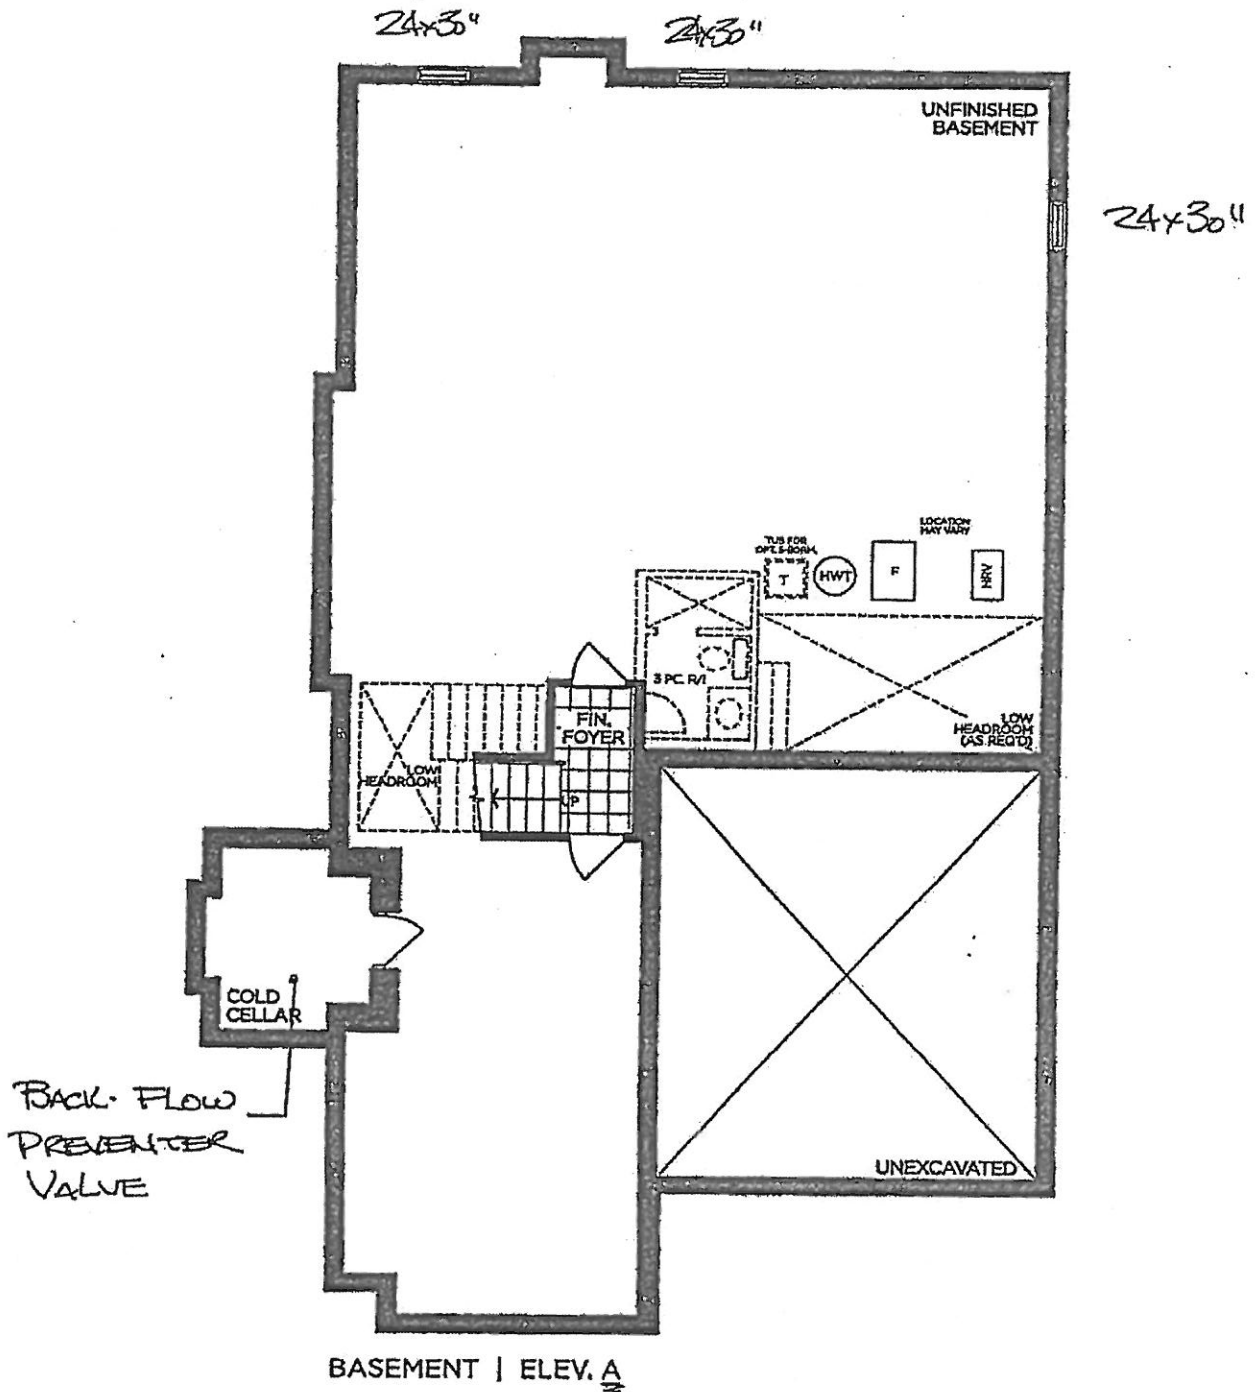

[Handwritten signature]

VENDOR

PURCHASER

PURCHASER

GOLDPARK
WORTH MORE®

Prices, figures, illustrations, sizes, features and finishes are subject to change without notice. Areas and dimensions are approximate and actual usable floor space may vary from the stated area. Layout may be reverse of the unit purchased. E. & O.E. 4204



Plus: (2) at other side
approx. 24" from corners.

TOTAL: 12 SOFFIT LIGHTS.

see attached
PV-131
SEPT 24 2020