



CONSTRUCTION SUMMARY

Lot: 13

Model: 42.02 A ROSEDALE

Project/Phase: Pine Valley Forevergreen / 1

BASEMENT WINDOWS

Invoice	Qty.	Description
2471 72,675 05Oct20	2	BASEMENT WINDOWS - UPGRADE BASEMENT WINDOW SIZE TO 30 " X 24" - 10" FRAME

CONCRETE AND DRAIN

Invoice	Qty.	Description
2471 05Oct20 NoCat	1	BACK-FLOW PREVENTER VALVE

ELECTRICAL

Invoice	Qty.	Description
2471 72,281 05Oct20	1	GREAT ROOM: INTERIOR WALL OUTLET: ADDITIONAL 110V WALL INTERIOR RECEPTACLE ON EXISTING CIRCUIT FOR WALL MOUNTED TV - LOCATE APPROX 66" A.F.F. ABOVE FIREPLACE
2471 72,289 05Oct20	6	KITCHEN: 4" E/S LED INTERIOR POT LIGHT - GROUND FLOOR - EACH - INCLUDES 1 SWITCH INCLUDED IN APS
2471 72,307 05Oct20	1	KITCHEN: FIXTURE: RELOCATE STANDARD CEILING MOUNT FIXTURE APPROX CENTER ABOVE ISLAND
2471 72,272 05Oct20	1	KITCHEN ISLAND: 110V WALL RECEPTACLE ON SEPARATE CIRCUIT - FOR MICROWAVE - MICROWAVE NOT INCLUDED

FORMING

Invoice	Qty.	Description
2471 72,205 05Oct20	1	PINE VALLEY MODEL 42.02 ROSEDALE ELEV A - 9 FOOT BASEMENT CEILING HEIGHT IN LIEU OF STANDARD 8 FOOT CEILING.

FRAMING

Invoice	Qty.	Description
2471 05Oct20 NoCat	1	**CUSTOM LAYOUT** DELETE REACH IN CLOSETS IN LAUNDRY AND BEDROOM 4. CREATE 1 LARGE WIC FROM ACCESSIBLE BEDROOM 4, COMPLETE WITH STANDARD FINISHES - SEE PLAN FOR LOCATION

INTERIOR TRIM AND DOORS

Invoice	Qty.	Description
2471 05Oct20 NoCat	1	**CUSTOM LAYOUT** DELETE REACH IN CLOSETS IN LAUNDRY AND BEDROOM 4. CREATE 1 LARGE WIC FROM ACCESSIBLE BEDROOM 4, COMPLETE WITH STANDARD FINISHES - SEE PLAN FOR LOCATION



CONSTRUCTION SUMMARY

Lot: 13
Model: 42.02 A ROSEDALE
Project/Phase: Pine Valley Forevergreen / 1

NETWORK AND WIRING

Invoice	Qty.	Description
2471 72,259 05Oct20	1	GREAT ROOM: CONDUIT PIPE - FOR WALL MOUNT TV - LOCATE APPROX 66" A.F.F. ABOVE FIREPLACE, THRU BASEMENT, TERMINATING AT CABLE - SEE PLAN FOR LOCATION
2471 72,260 05Oct20	1	CONDUIT PIPE - FROM ATTIC TO BASEMENT - FROM BASEMENT NEAR ELECTRICAL PANEL TO APPROX CENTER OF ATTIC
2471 72,264 05Oct20	1	MUD ROOM: ROUGH - IN FOR EXTRA SECURITY KEY PAD

PAINT

Invoice	Qty.	Description
2471 05Oct20 NoCat	1	**CUSTOM LAYOUT** DELETE REACH IN CLOSETS IN LAUNDRY AND BEDROOM 4. CREATE 1 LARGE WIC FROM ACCESSIBLE BEDROOM 4, COMPLETE WITH STANDARD FINISHES - SEE PLAN FOR LOCATION

PLUMBING FIXTURES

Invoice	Qty.	Description
2471 05Oct20 NoCat	1	MASTER ENSUITE: UPGRADE TO MOEN 'ALIGN' RAIN SHOWER (from ceiling) + HAND SHOWER WITH SLIDE BAR CHROME #T219EP/3372/T4191/62320/3887EP/A725/116651

The

Rosedale


42' SERIES

→

Elevation A • 3,655 sq.ft.

Elevation B • 3,605 sq.ft.

Elevation C • 3,590 sq.ft.

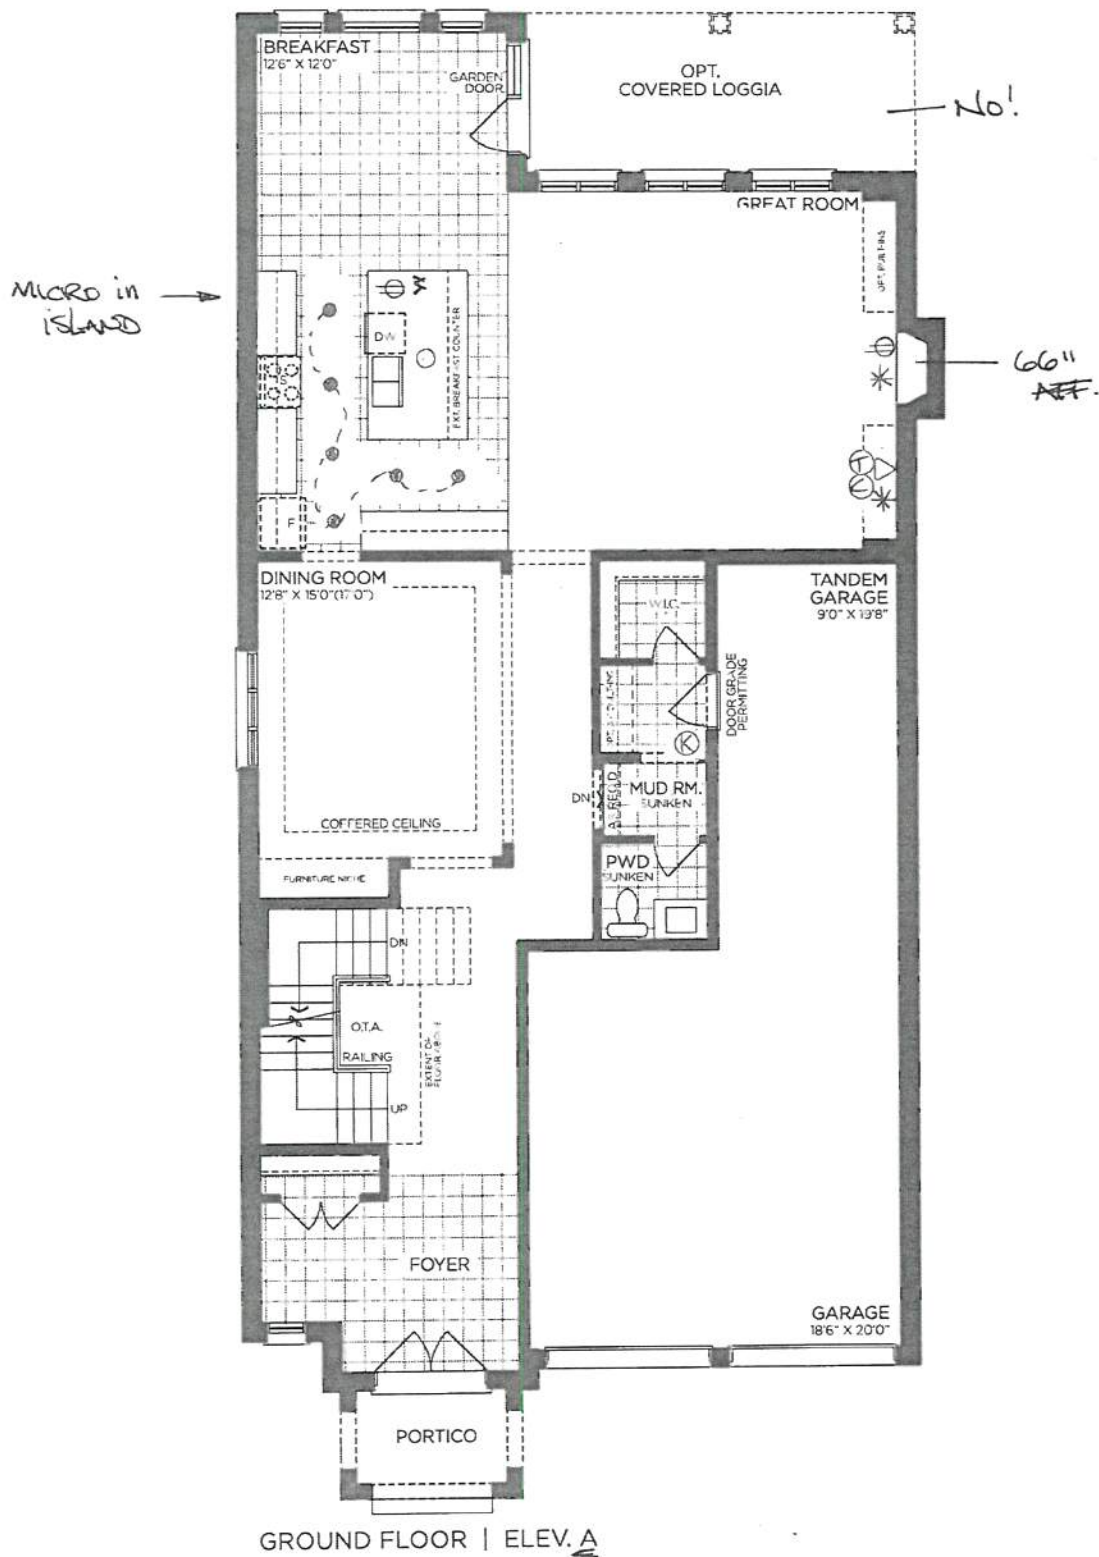

VENDOR

PURCHASER

PURCHASER

GOLDPARK

WORTH MORE™

Prices, figures, illustrations, sizes, features and finishes are subject to change without notice. Areas and dimensions are approximate and actual usable floor space may vary from the stated area. Layout may be reverse of the unit purchased. E. & O.E. 4202

SCHEDULE 'F'




PV-13

OCT 5 2020

The
Rosedale
42' SERIES

- Elevation A • 3,655 sq.ft.
- Elevation B • 3,605 sq.ft.
- Elevation C • 3,590 sq.ft.

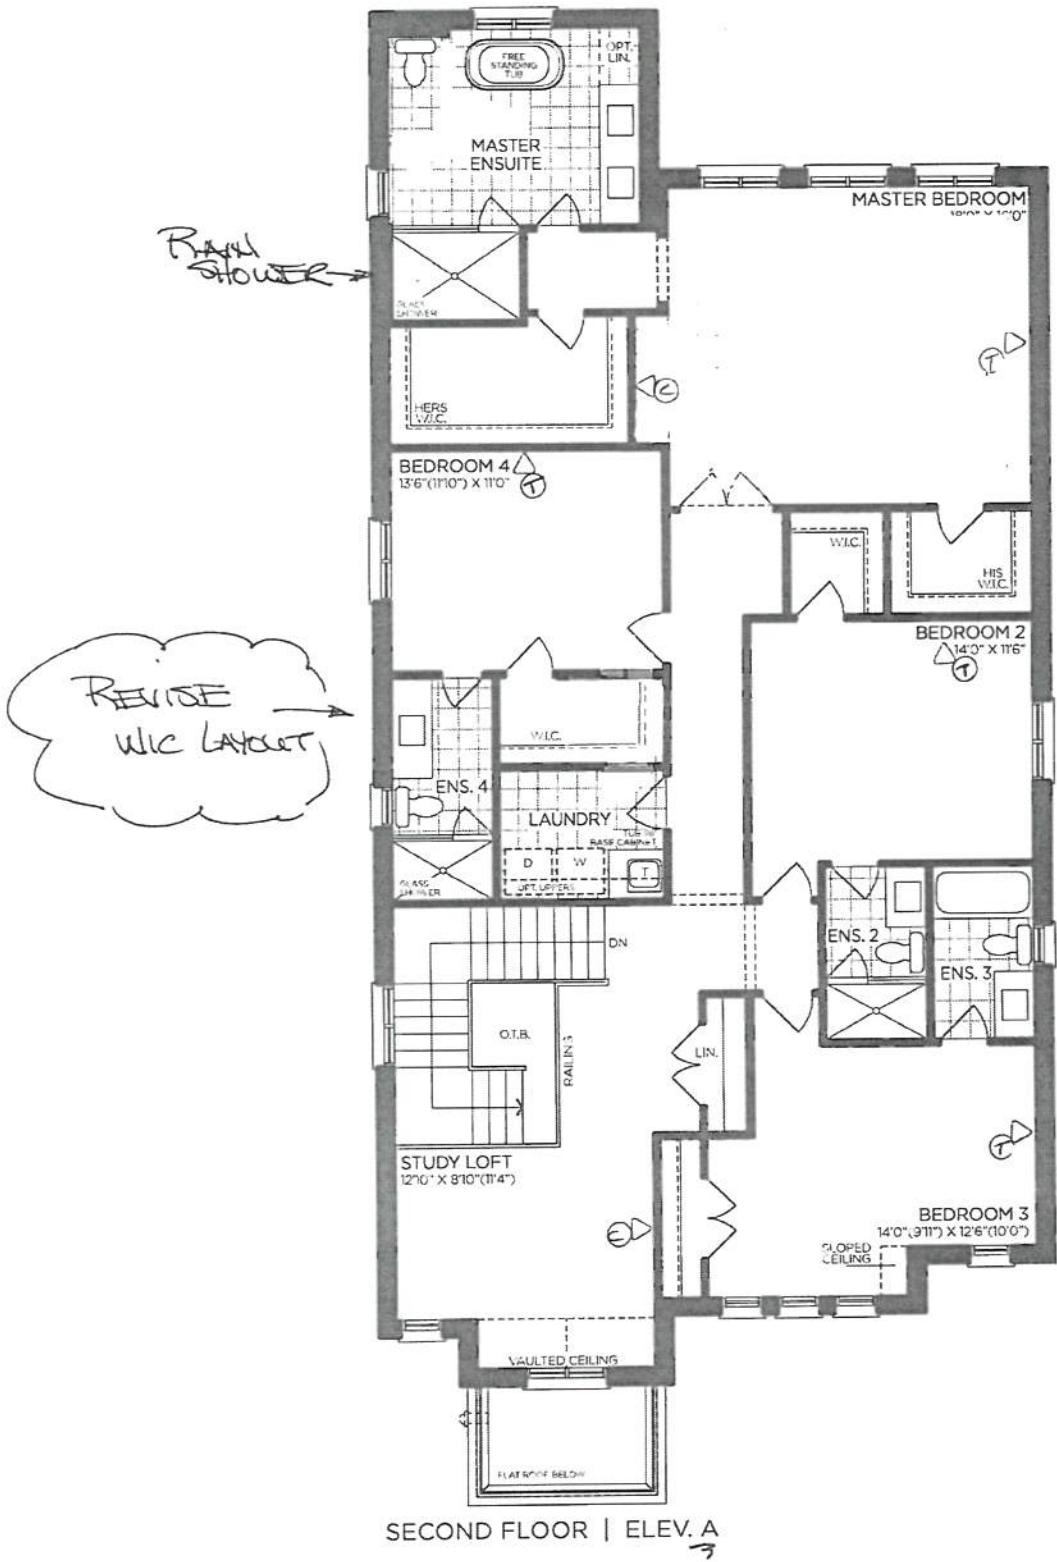

VENDOR	
PURCHASER	
PURCHASER	

GOLDPARK
WORTH MORE™

Prices, figures, illustrations, sizes, features and finishes are subject to change without notice. Areas and dimensions are approximate and actual usable floor space may vary from the stated area. Layout may be reverse of the unit purchased. E. & O.E. 4202

SCHEDULE 'F'




Handwritten initials and a circle

PV-13

Oct 5 2020

The
Rosedale
42' SERIES

- Elevation A • 3,655 sq.ft.
- Elevation B • 3,605 sq.ft.
- Elevation C • 3,590 sq.ft.

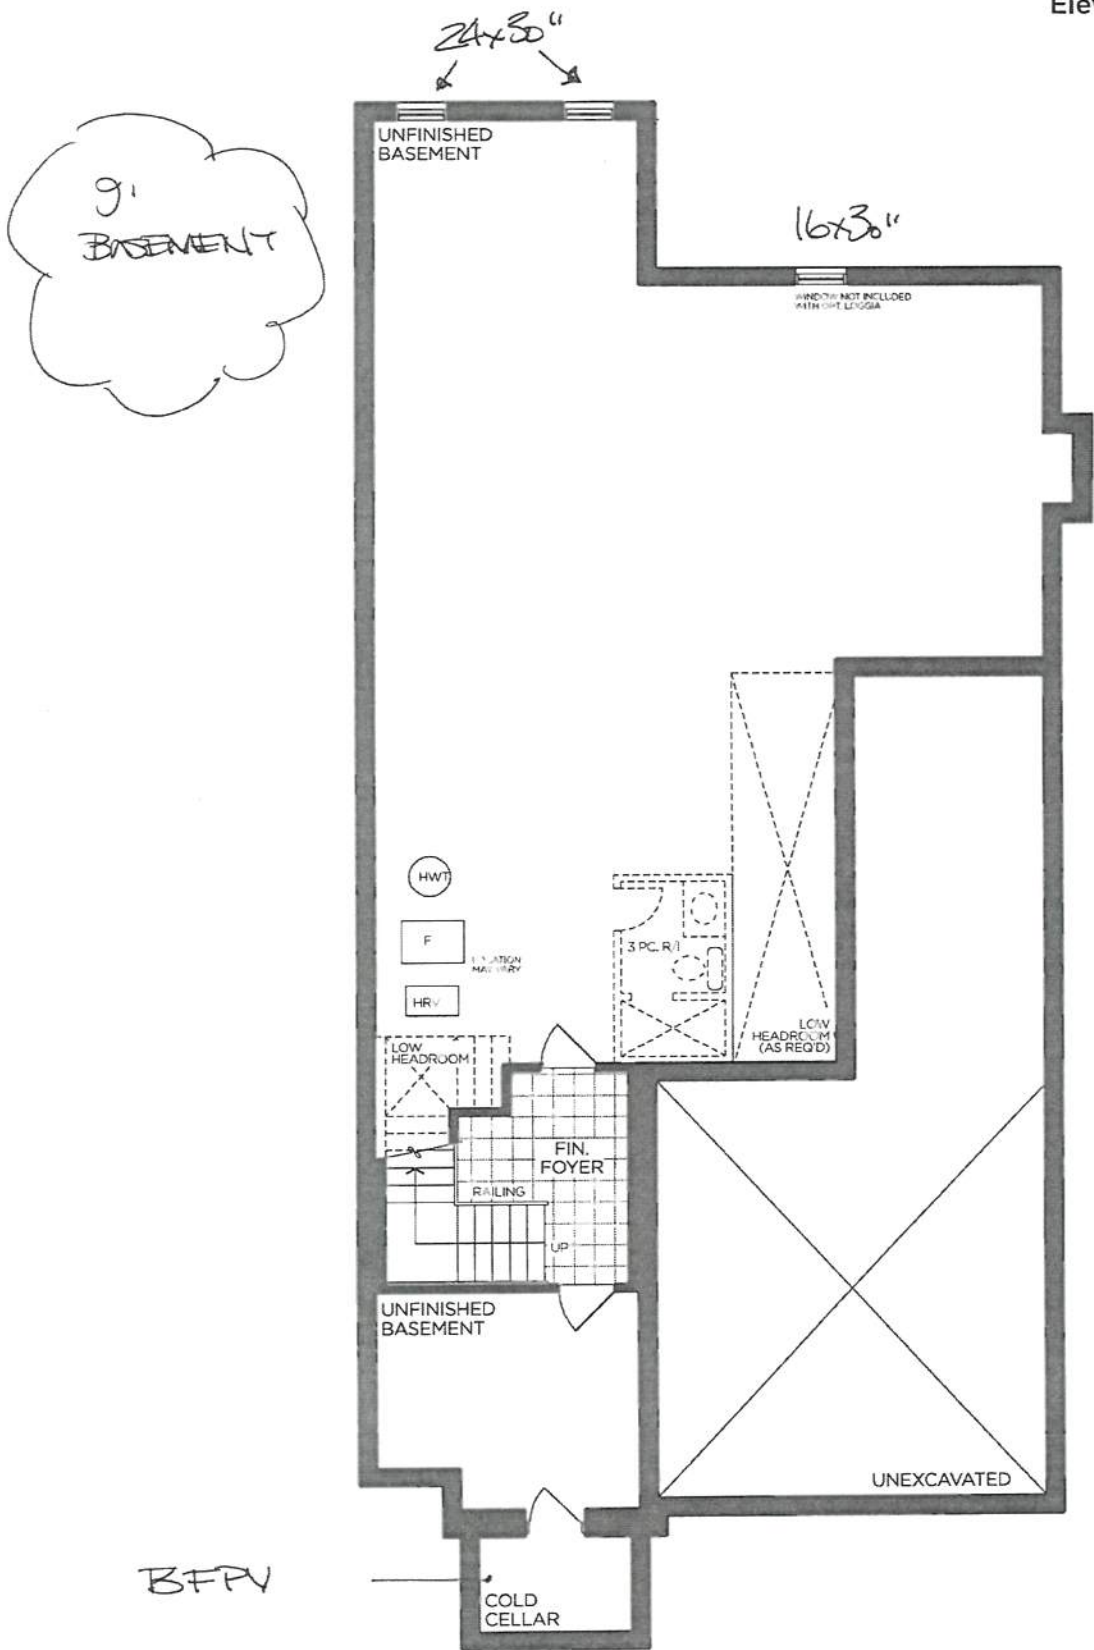

BASEMENT | ELEV. A

VENDOR

PURCHASER

PURCHASER

GOLDPARK
WORTH MORE™


Prices, figures, illustrations, sizes, features and finishes are subject to change without notice. Areas and dimensions are approximate and actual usable floor space may vary from the stated area. Layout may be reverse of the unit purchased. E. & O.E. 4202

PLUMBING UPGRADES



POSI-TEMP SHOWER ONLY* W/ 3 FUNCTION TRANSFER VALVE/TRIM AND SLIDE BAR W/ HAND SHOWER

MOEN - ALIGN

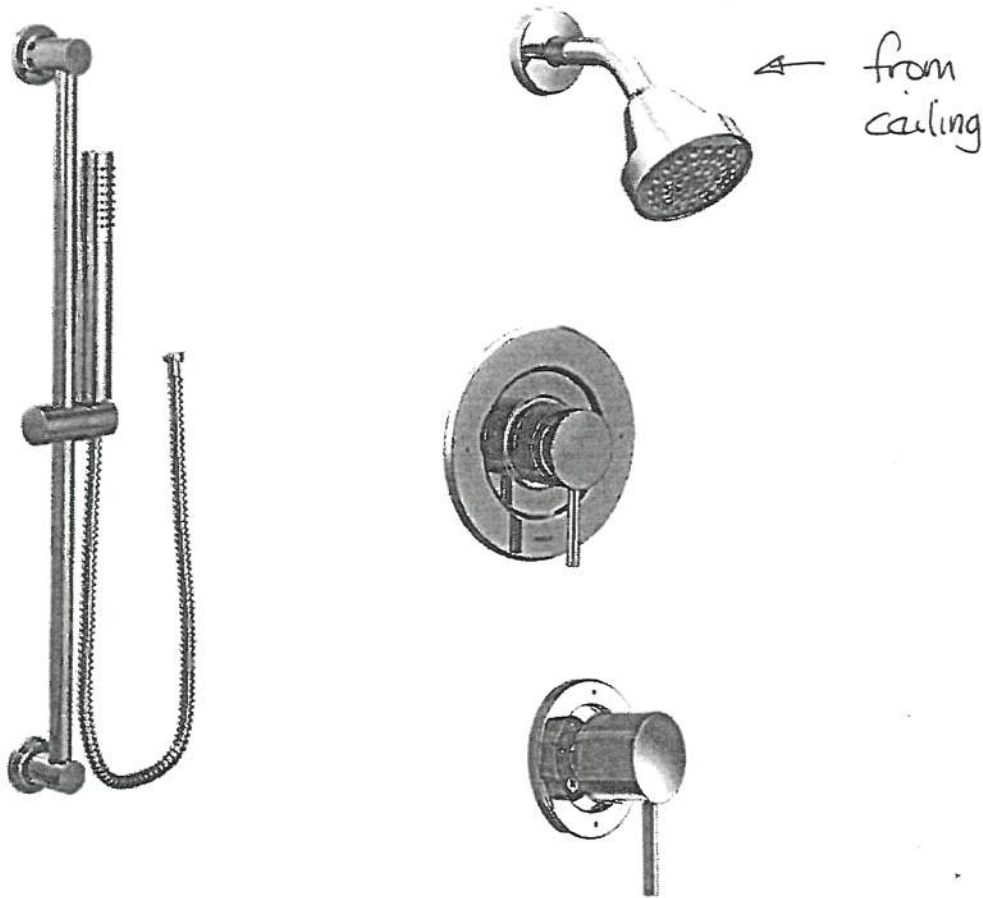

- ☒ CHROME
- ☐ BRUSHED GOLD
- ☐ MATTE BLACK
- ☐ from WALL
- ☒ from CEILING
Ceiling Shower Arm:
Chrome (116651)
Matte Black (116651WR)

MODEL T2192EP / 3372 / T4191 / 62320 / 3887EP / A725

Lot# PV-13

Room: Master Ensuite

Signature: [Signature]

Date: October 5, 2020

Signature: [Signature]