

PURCHASER'S EXTRAS QUOTATION Brampton Encore - Phase 2					TEL: RES.: 416-785-5566	
PURCHASER: GOLDPARK HOMES INVENTORY						
LOT NUMBER		PHASE	HOUSE TYPE			
80		2	38-8 Elev.B CORELLI OPT -GFAI			
ITEM	EXTRA / CHANGE		QTY	UNIT PRICE	EXTENDED	
*1 28841 38556	SIDE DOOR- HOME TO EXTERIOR- AS PER PLAN AND GRADE PERMITTING		1	\$0.00	\$0.00	
*2 28842 38557	MANDOOR - GARAGE TO HOUSE- AS PER PLAN AND GRADE PERMITING		1	\$0.00	\$0.00	
3 28916 38561	BASEMENT WINDOWS - UPGRADE EXISTING BASEMENT WINDOW TO 30 INCH X 24 INCH - MAY REQUIRE INSTALLATION OF WINDOW WELL		3	\$290.00	\$870.00	
*4 28822 38563	KITCHEN: ROUGH - IN CEILING OUTLET ON SAME SWITCH - DOES NOT INCLUDE FIXTURE - LOCATE APRPOX CENTER ABOVE ISLAND		1	\$115.00	\$115.00	
5 38564	KITCHEN: SINGLE POLE SWITCH FOR LIGHT ABOVE ISLAND		1	\$120.00	\$120.00	
6 28811 38575	200 AMP ELECTRICAL SERVICE		1	\$1,150.00	\$1,150.00	
*7 28810 38576	KITCHEN: 220V WALL RECEPTICAL ON DEDICATED CIRCUIT- FOR 4 WIRE BUILT-IN WALL OVEN - SEE PLAN FOR LOCATION		1	\$350.00	\$350.00	
*8 28808 38577	KITCHEN: 110V WALL RECEPTACLE ON DEDICATED CIRCUIT - GAS FIRED APPLIANCE - FOR AUX. EQUIPMENT - NOT A STOVE PLUG		1	\$280.00	\$280.00	
*9 28872 38578	KITCHEN: GAS LINE ROUGH - 2ND FLOOR- (3-STOREY MODELS)		1	\$1,200.00	\$1,200.00	
*10 28885 38579	MAIN FLOOR: EXTENDED HEIGHT ARCHWAY (PRICE PER DOORWAY) - 96"		8	\$300.00	\$2,400.00	
*11 28884 38580	MAIN FLOOR: STANDARD DOOR EXTENDED HEIGHT 96" (PRICE PER DOOR) MAIN FLOOR 3 STOREY MODELS		5	\$400.00	\$2,000.00	
12 38581	**REVISED LAYOUT** MAIN FLOOR: DELETE ARCHWAY (x2) AT LIBRARY. ADD DOUBLE FRENCH DOORS WITH CLEAR GLASS - OPENING APPROX CENTERED ALONG WALL OPPOSITE KITCHEN. SEE PLAN FOR LOCATION		1	\$3,150.00	\$3,150.00	
13 28894 38582	ROUGH-IN - 3PC BASEMENT ROUGH-IN		1	\$1,725.00	\$1,725.00	

*****Enter TAX number*****

PREPARED BY: Yolande Somerville

PRINTED: 2-Oct-20 at 11:24 am

GolInvoiceSQL.rpt 07aug20

Initials:

CONSTRUCTION SCHEDULING APPROVAL

PER: _____

DATE: _____

PURCHASER'S EXTRAS QUOTATION

Brampton Encore - Phase 2

PURCHASER: GOLDPARK HOMES INVENTORY

TEL: RES.: 416-785-5566

LOT NUMBER	PHASE	HOUSE TYPE
80	2	38-8 Elev.B CORELLI OPT - GFA1

ITEM	EXTRA / CHANGE	QTY	UNIT PRICE	EXTENDED
\$13,360.00 Sub Total \$1,736.80 HST \$15,096.80 Total				

This is your direction to install the above extras in accordance with the following terms and conditions:

- In the event the work on the house has progressed beyond the point where the items covered by this extra cannot be installed without entailing any unusual expense, then this order is to be cancelled and any deposit paid in connection with the same is to be refunded to the purchaser.
- The Vendor will undertake to incorporate the work covered by the sales extra in the construction of the house but will not be liable to the purchaser in any way, if for any reason the work covered by the extra is not carried out. In that event, any monies paid in connection with the same shall be returned to the purchaser.
- It is understood and agreed that if for any reason whatsoever the transaction of Purchase and Sale is not completed, the total cost of extras ordered are not refundable to the Purchaser(s).
- Extras or changes will not be processed unless signed by the Vendor.
- These extras may not be amended without the written consent of Fieldwalk Investments Inc.
- The purchaser(s) and the builder acknowledge and agree that this "Purchaser's Extra" form shall not be deemed to be part of the agreement of purchase and sale entered into between them. nor an addendum thereto.
- Prices are estimates only and guaranteed for a period of 5 days only.
- No post dated cheques will be accepted.
- No Estimates or orders will be accepted once construction has commenced.
- All extras/selections are final with signature. All enquiries to re-open a file and/or request changes to any extras/selections is subject to a fee of \$500.00 (five hundred dollars).
- No estimates will be considered official orders until resubmitted on a signed Purchaser Extras Form, accompanied by payment in full.

Payment Summary

Paid By	Amount
Total Payment:	

Bonus Summary

Bonus Package offering (includes taxes) from Gold Park Homes Décor Centre is being applied to this order.

Any remaining balance(s) will be applied accordingly to extras purchased.

Bonus Package Offering

Invoice Number	Date	Amount
----------------	------	--------

Total Bonus Used:

Remaining Balance:

PURCHASER:

GOLDPARK HOMES INVENTORY

02-Oct-20

DATE

VENDOR:

PER: Fieldwalk Investments Inc.

CONSTRUCTION SCHEDULING APPROVAL

PER:



DATE:



The Corelli

38' SERIES


Elevation A • 3,878 sq.ft. | Elevation B • 3,878 sq.ft.

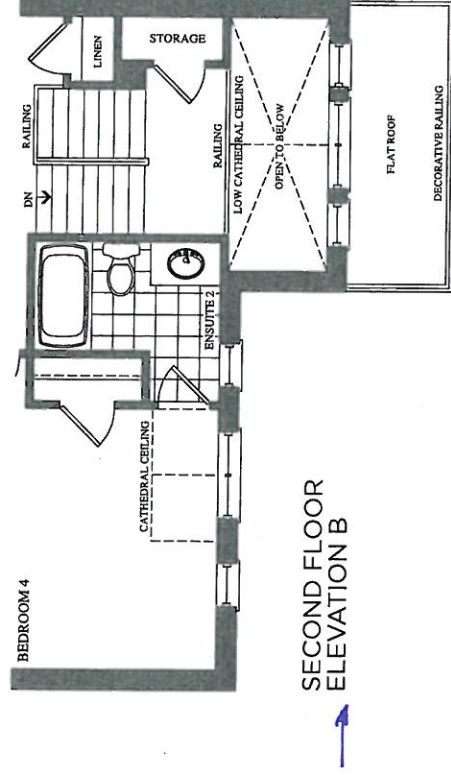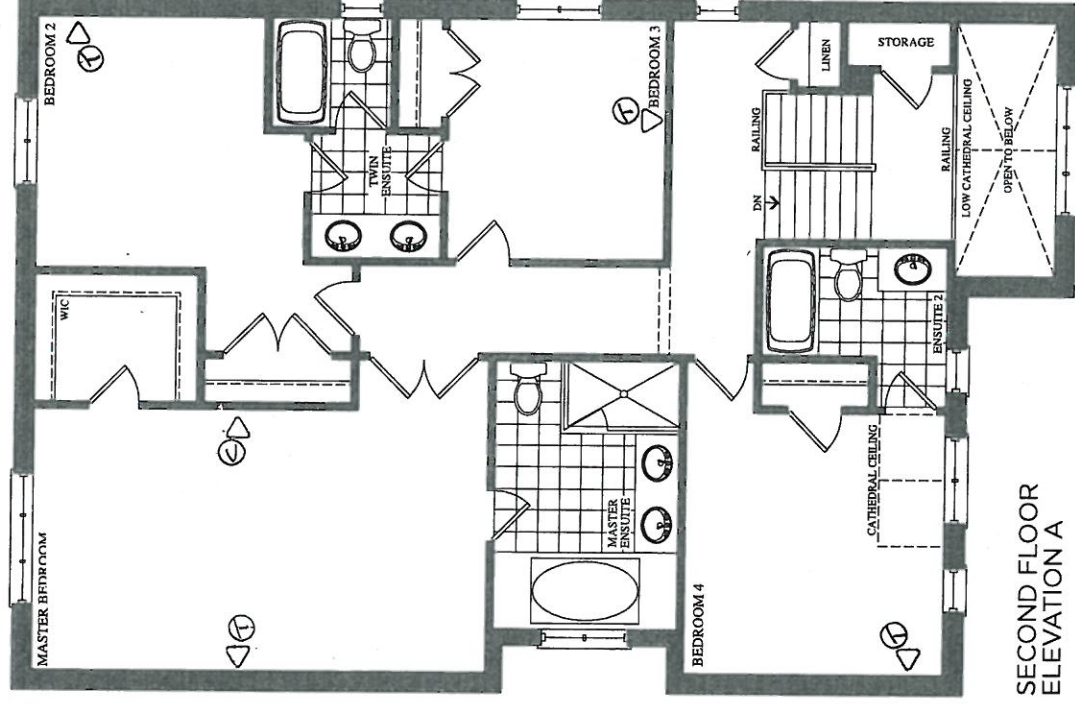

BE2-80
Oct 2 2020

The Corelli 38' SERIES

Elevation A • 3,878 sq.ft. | Elevation B • 3,878 sq.ft.

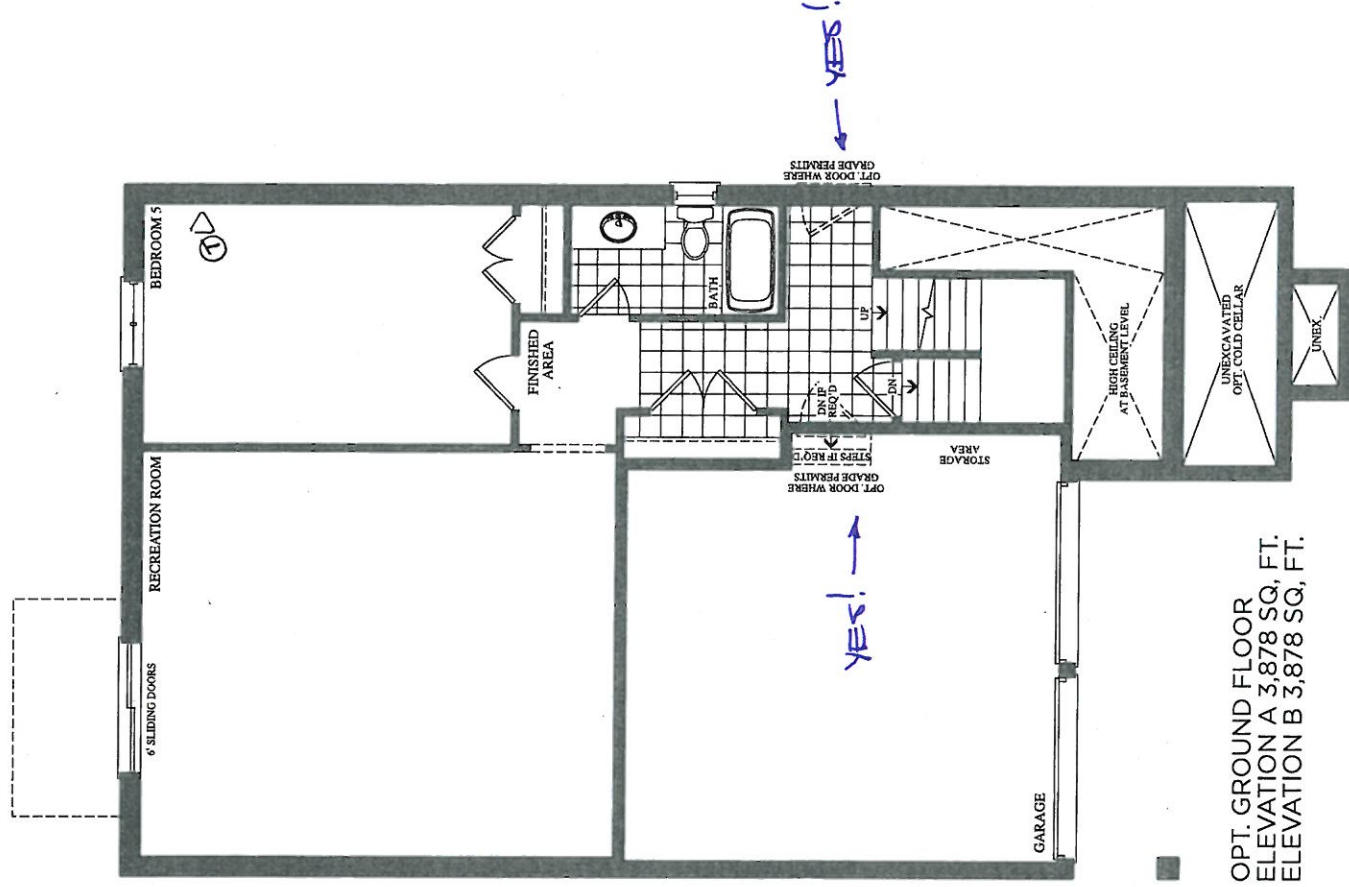

OPT. GROUND FLOOR
ELEVATION A 3,878 SQ. FT.
ELEVATION B 3,878 SQ. FT.

The Corelli 38' SERIES

Elevation A • 3,878 sq.ft. | Elevation B • 3,878 sq.ft.

