

**Lot: 80**

Model: 38-8 Elev.B CORELLI ~~OPT~~ - GFA1

Project/Phase: Brampton Encore / 2

ELECTRICAL

Invoice	Qty.	Description
2465 28,822 06Oct20	1	KITCHEN: ROUGH - IN CEILING OUTLET ON SAME SWITCH - DOES NOT INCLUDE FIXTURE - LOCATE APRPOX CENTER ABOVE ISLAND
2465 06Oct20 NoCat	1	KITCHEN: SINGLE POLE SWITCH FOR LIGHT ABOVE ISLAND
2465 28,811 06Oct20	1	200 AMP ELECTRICAL SERVICE
2465 28,810 06Oct20	1	KITCHEN: 220V WALL RECEPTICAL ON DEDICATED CIRCUIT- FOR 4 WIRE BUILT-IN WALL OVEN - SEE PLAN FOR LOCATION
2465 28,808 06Oct20	1	KITCHEN: 110V WALL RECEPTACLE ON DEDICATED CIRCUIT - GAS FIRED APPLIANCE - FOR AUX. EQUIPMENT - NOT A STOVE PLUG


FORMING

Invoice	Qty.	Description
2465 28,841 06Oct20	1	SIDE DOOR- HOME TO EXTERIOR- AS PER PLAN AND GRADE PERMITTING
2465 28,842 06Oct20 **	1	MANDOOR - GARAGE TO HOUSE- AS PER PLAN AND GRADE PERMITING
2465 28,916 06Oct20 **	3	BASEMENT WINDOWS - UPGRADE EXISTING BASEMENT WINDOW TO 30 INCH X 24 INCH - MAY REQUIRE INSTALLATION OF WINDOW WELL
2465 06Oct20 NoCat	1	**REVISED LAYOUT** MAIN FLOOR: DELETE ARCHWAY (x2) AT LIBRARY. ADD DOUBLE FRENCH DOORS WITH CLEAR GLASS - OPENING APPROX CENTERED ALONG WALL OPPOSITE KITCHEN. SEE PLAN FOR LOCATION

BEZ-80
Oct 2 2020

The
Corelli
38' SERIES



Elevation A • 3,878 sq.ft. | Elevation B • 3,878 sq.ft.

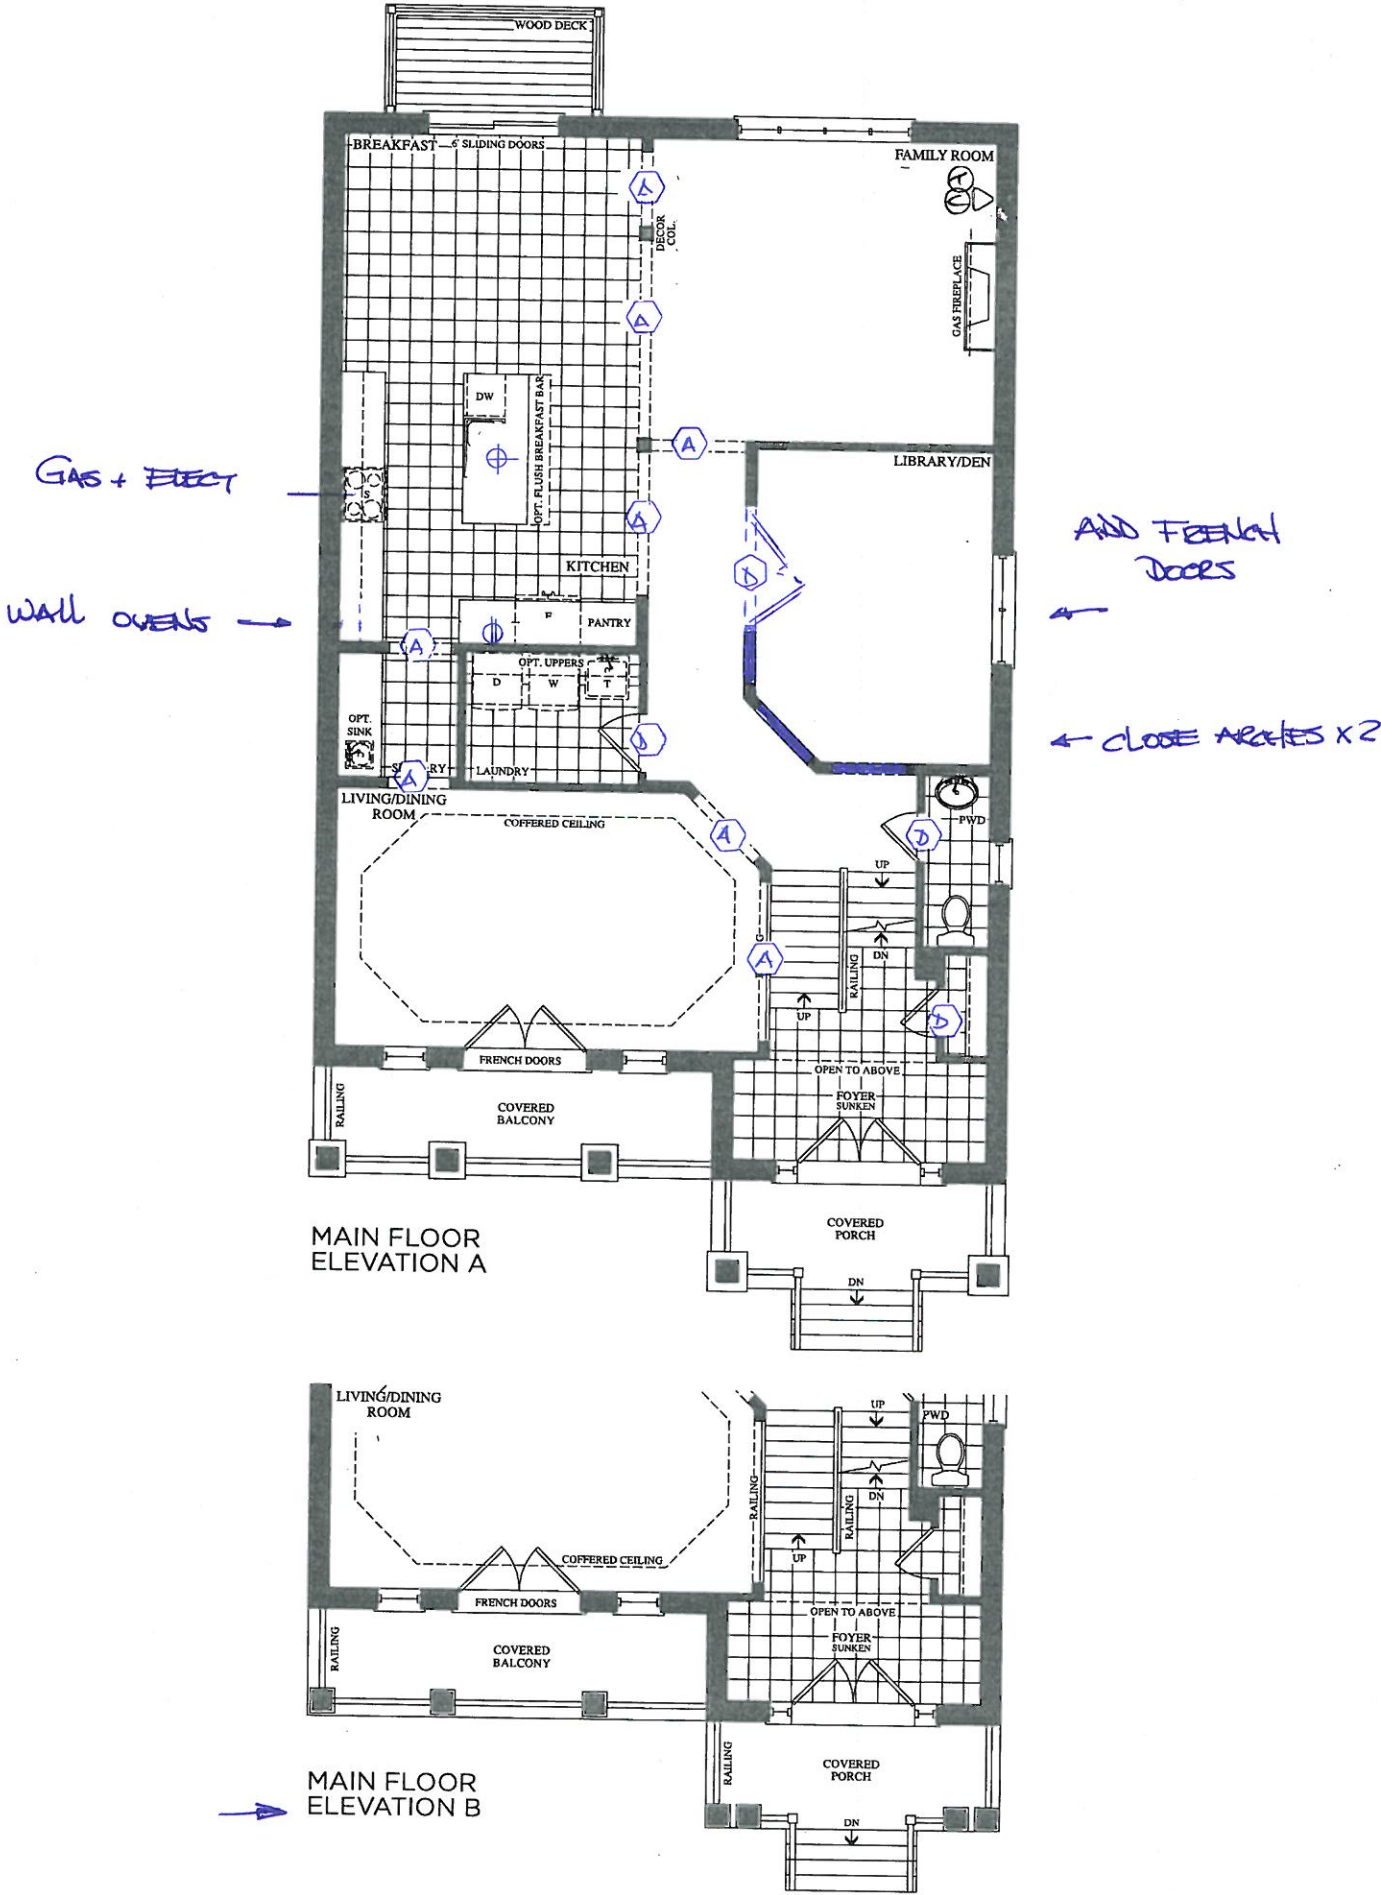

BE2-80
Oct 2 2020

The
Corelli
38' SERIES


Elevation A • 3,878 sq.ft. | Elevation B • 3,878 sq.ft.

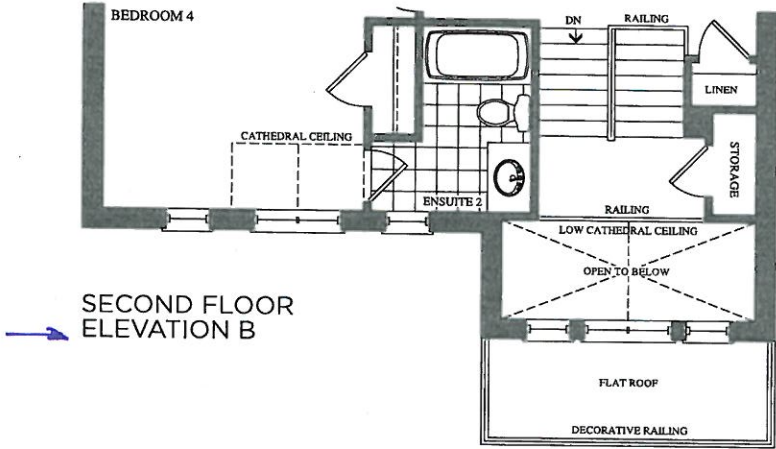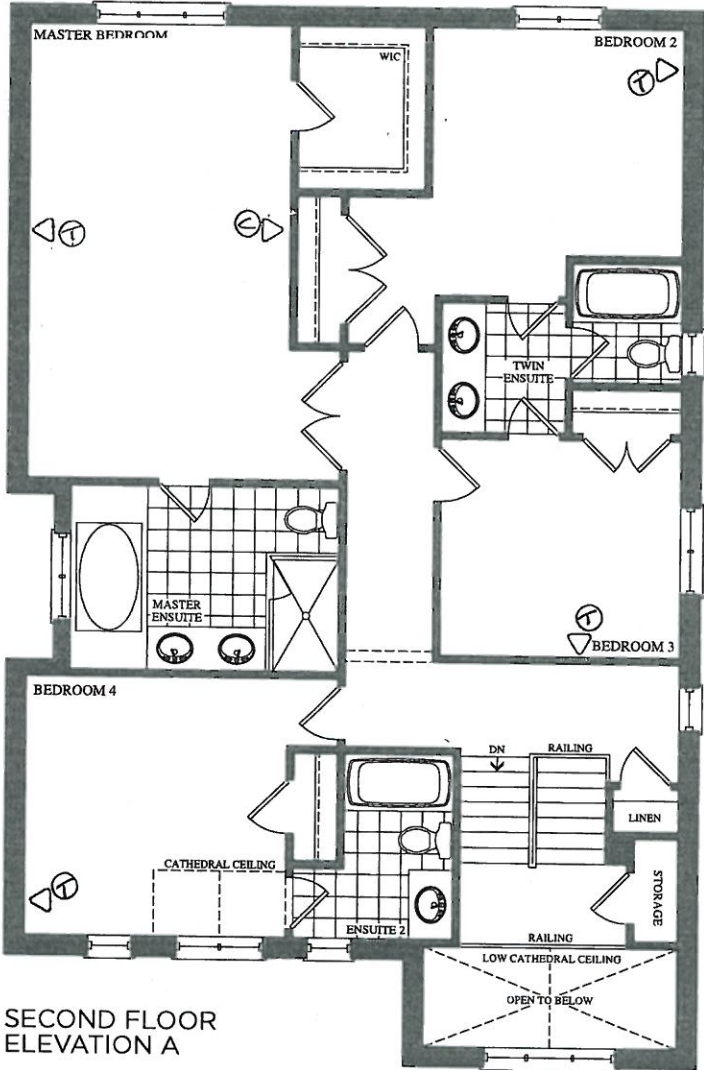

BE2-80
OCT 2 2020

The
Corelli
38' SERIES

Elevation A • 3,878 sq.ft. | Elevation B • 3,878 sq.ft.

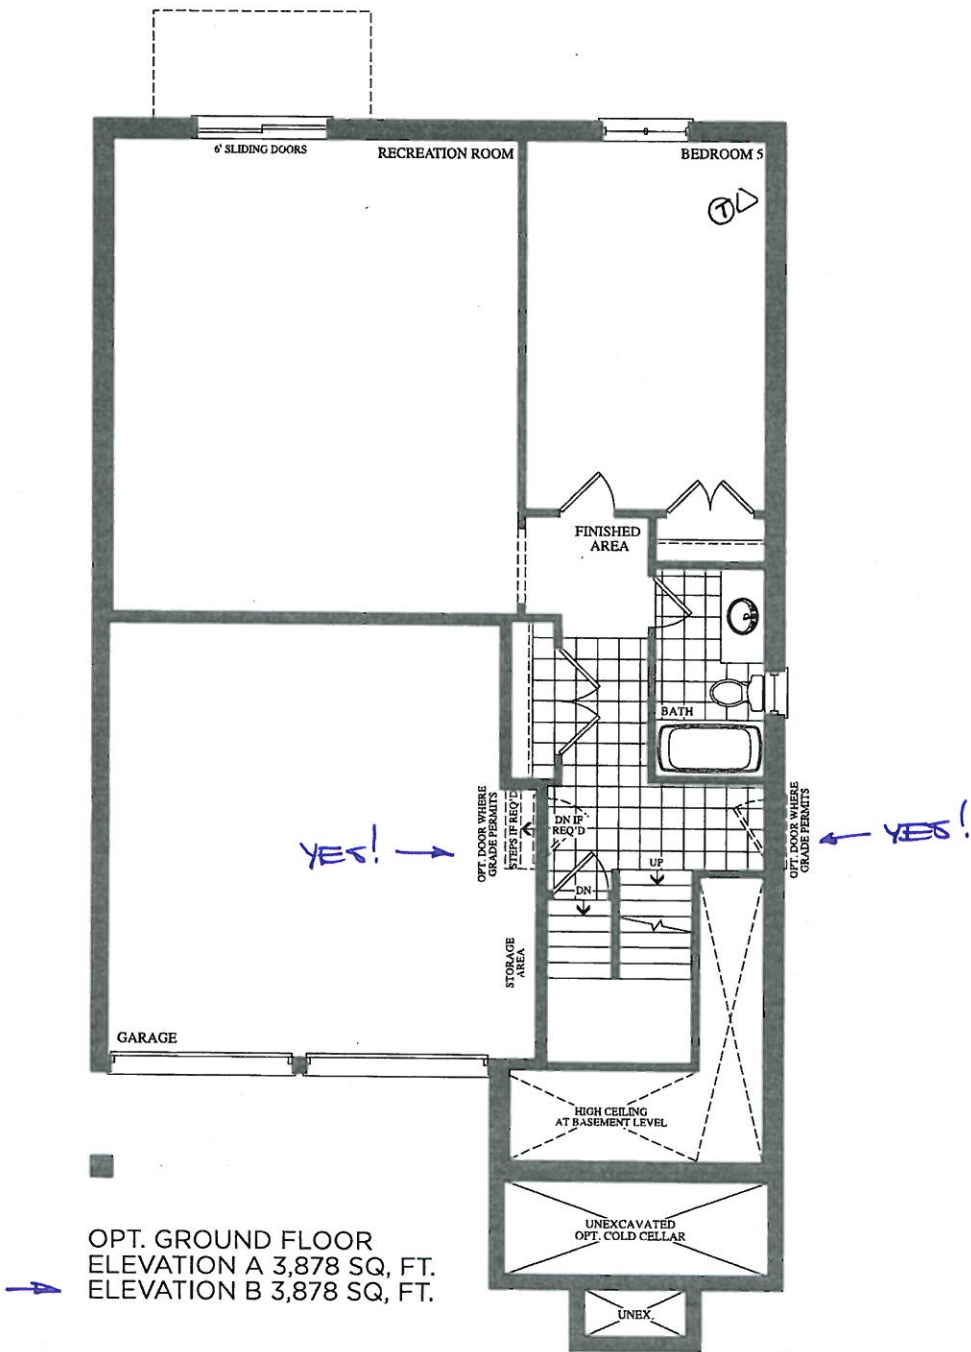

BE2-80
Oct 2 2020

The
Corelli
38' SERIES

Elevation A • 3,878 sq.ft. | Elevation B • 3,878 sq.ft.

