




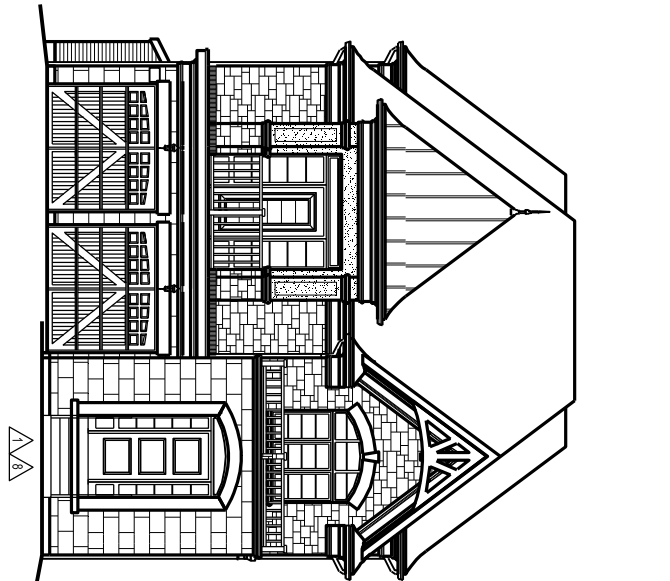


LOT NUMBER: 153
UNIT NAME: BROOKSIDE
ELEVATION: B (REV)
UNIT NUMBER: 4003

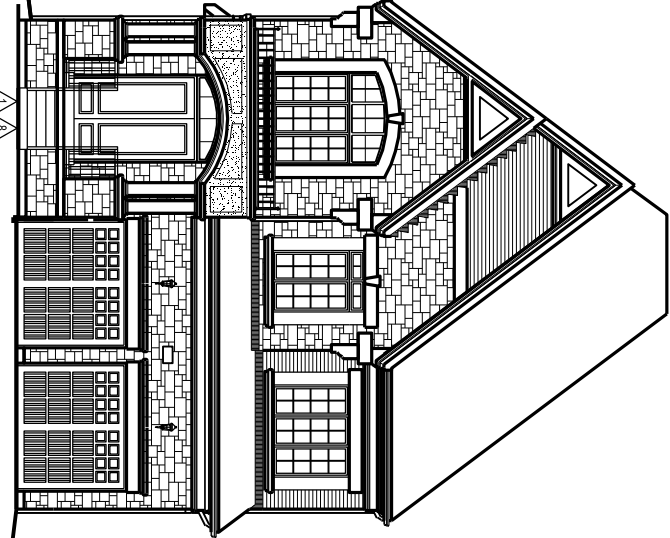


LOT NUMBER: 152
UNIT NAME: VALLEYVIEW
ELEVATION: A
UNIT NUMBER: 4002

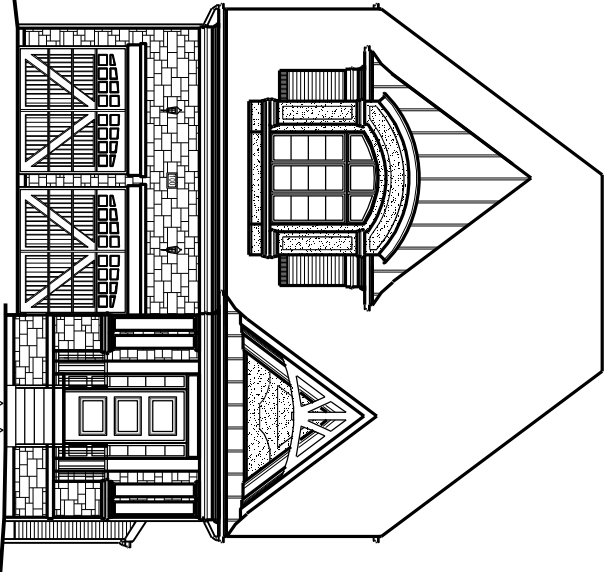


LOT NUMBER: 151
UNIT NAME: THE BRIARWOOD
ELEVATION: B (REV)
UNIT NUMBER: 4000

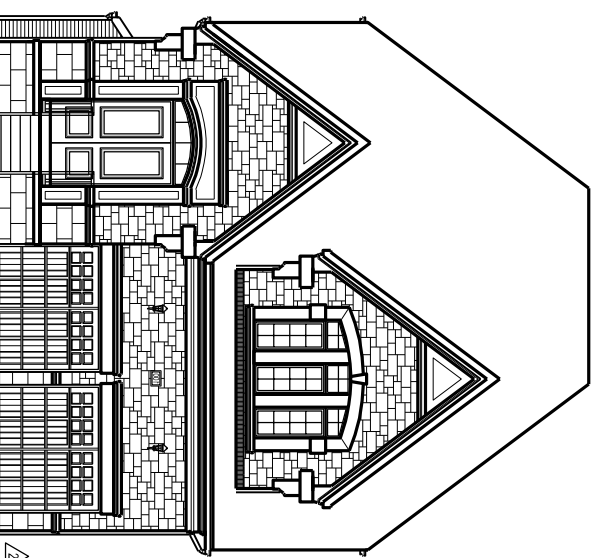


LOT NUMBER: 150
UNIT NAME: THE BRIARWOOD
ELEVATION: A
UNIT NUMBER: 4000

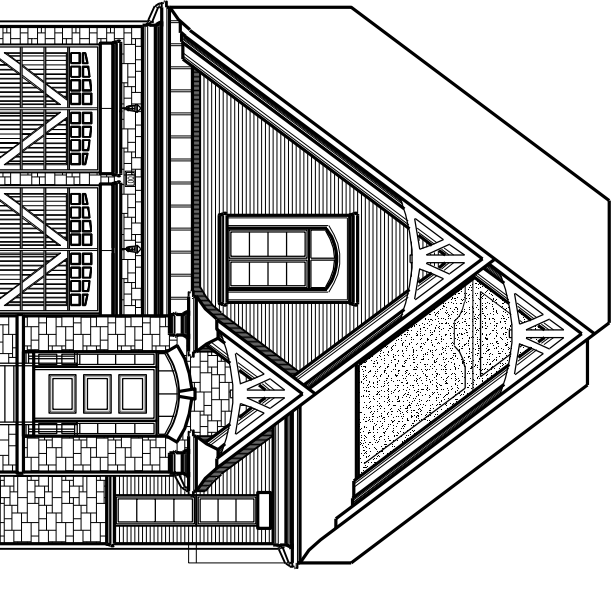


LOT NUMBER: 149
UNIT NAME: MAPLEWOOD
ELEVATION: B (REV)
UNIT NUMBER: 4201

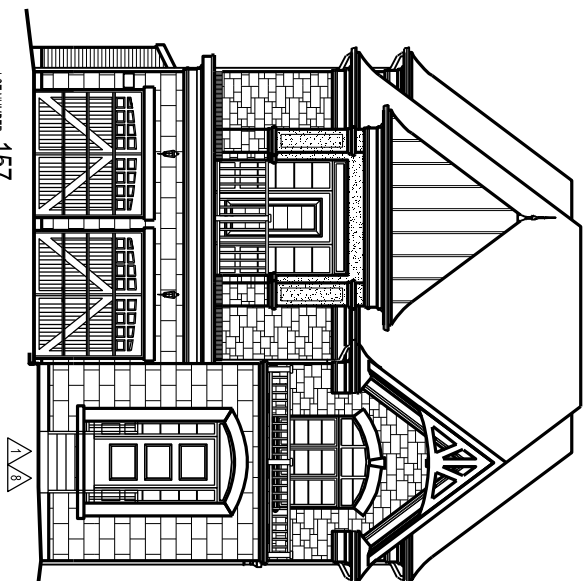


LOT NUMBER: 157
UNIT NAME: BROOKSIDE
ELEVATION: B (REV)
UNIT NUMBER: 4003

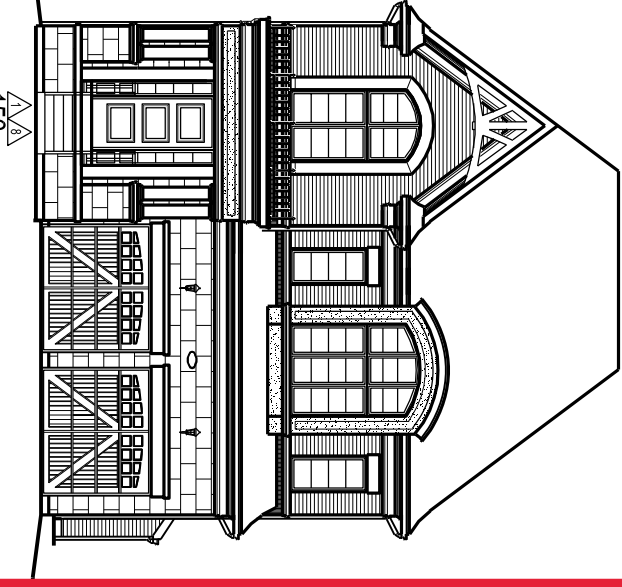

LOT NUMBER: 156
UNIT NAME: SUMMERDALE
ELEVATION: B
UNIT NUMBER: 4001

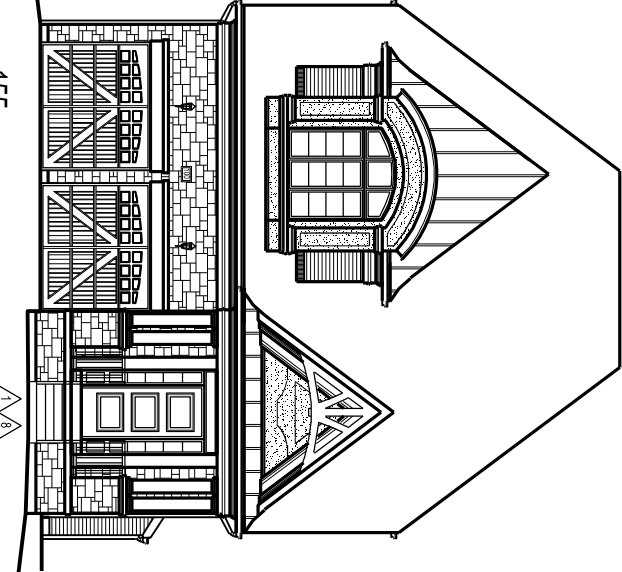

LOT NUMBER: 155
UNIT NAME: THE BRIARWOOD
ELEVATION: B (REV)
UNIT NUMBER: 4000

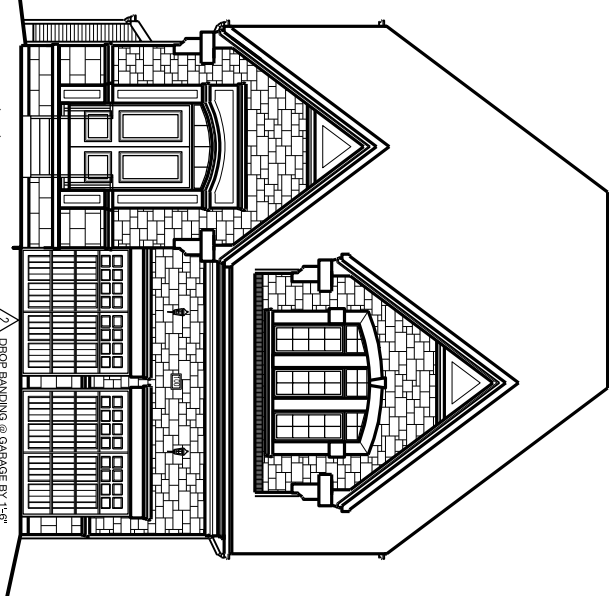

LOT NUMBER: 154
UNIT NAME: THE BRIARWOOD
ELEVATION: A
UNIT NUMBER: 4000

PROOF BANDING @ GARAGE BY 1'-6"

LEGEND:

1. BRICK/STONE VENEER ON SIDES OF STAIRS
POURED OR BRICK LEUGE PRECAST

2. DROP OR RAISE BANDING
BY AMOUNT INDICATED.

3. ADD BANDING AND/OR TRIM
AS INDICATED.

4. ADDED CAMBERED HEADERS

5. 8'-0" X 8'-0" GARAGE DOORS.

7. ADJUSTED ROOF OVERHANG
AS INDICATED ON ROOF PLAN.

9. FOYER SUNKEN AS INDICATED

10. LIGHT FIXTURE RELOCATED
AS INDICATED.

HUNT
DESIGN ASSOCIATES INC.
WWW.HUNTDDESIGN.CA

GOLDPARK HOMES - 217020
PINE VALLEY, VAUGHAN ONT.

STREETSCAPES - LOTS 150 - 157
PAGE XX

It is the builder's complete responsibility to ensure that all plans submitted for approval fully comply with the Architectural Guidelines and all applicable regulations and requirements including zoning provisions and any provisions in the applicable zoning by-law. The Architect is not responsible in any way for examining or approving site (lotting) plans or working drawings with respect to any zoning or building code or permit matter or that any house can be properly built or located on its lot. This is to certify that these plans comply with the applicable Architectural Design Guidelines approved by the City of VAUGHAN.