



CONSTRUCTION SUMMARY

Lot: 1
Model: 50.04 A BEAUMONT
Project/Phase: Pine Valley Forevergreen / 1

BASEMENT WINDOWS

Invoice	Qty.	Description
2478 72,675 20Oct20	4	BASEMENT WINDOWS - UPGRADE BASEMENT WINDOW SIZE TO 30 " X 24" - 10" FRAME (PINEVALLEY 50 FOOT LOTS ONLY)

CONCRETE AND DRAIN

Invoice	Qty.	Description
2478 20Oct20 NoCat	1	BACK-FLOW PREVENTER VALVE


SCHEDULE 'F'



PV-1
Oct 19 2020

The
Beaumont
50' SERIES

- ➔ Elevation A • 4,170 sq.ft.
4,315 sq.ft. Opt. Elevator
- Elevation B • 4,165 sq.ft.
4,315 sq.ft. Opt. Elevator
- Elevation C • 4,250 sq.ft.
4,400 sq.ft. Opt. Elevator

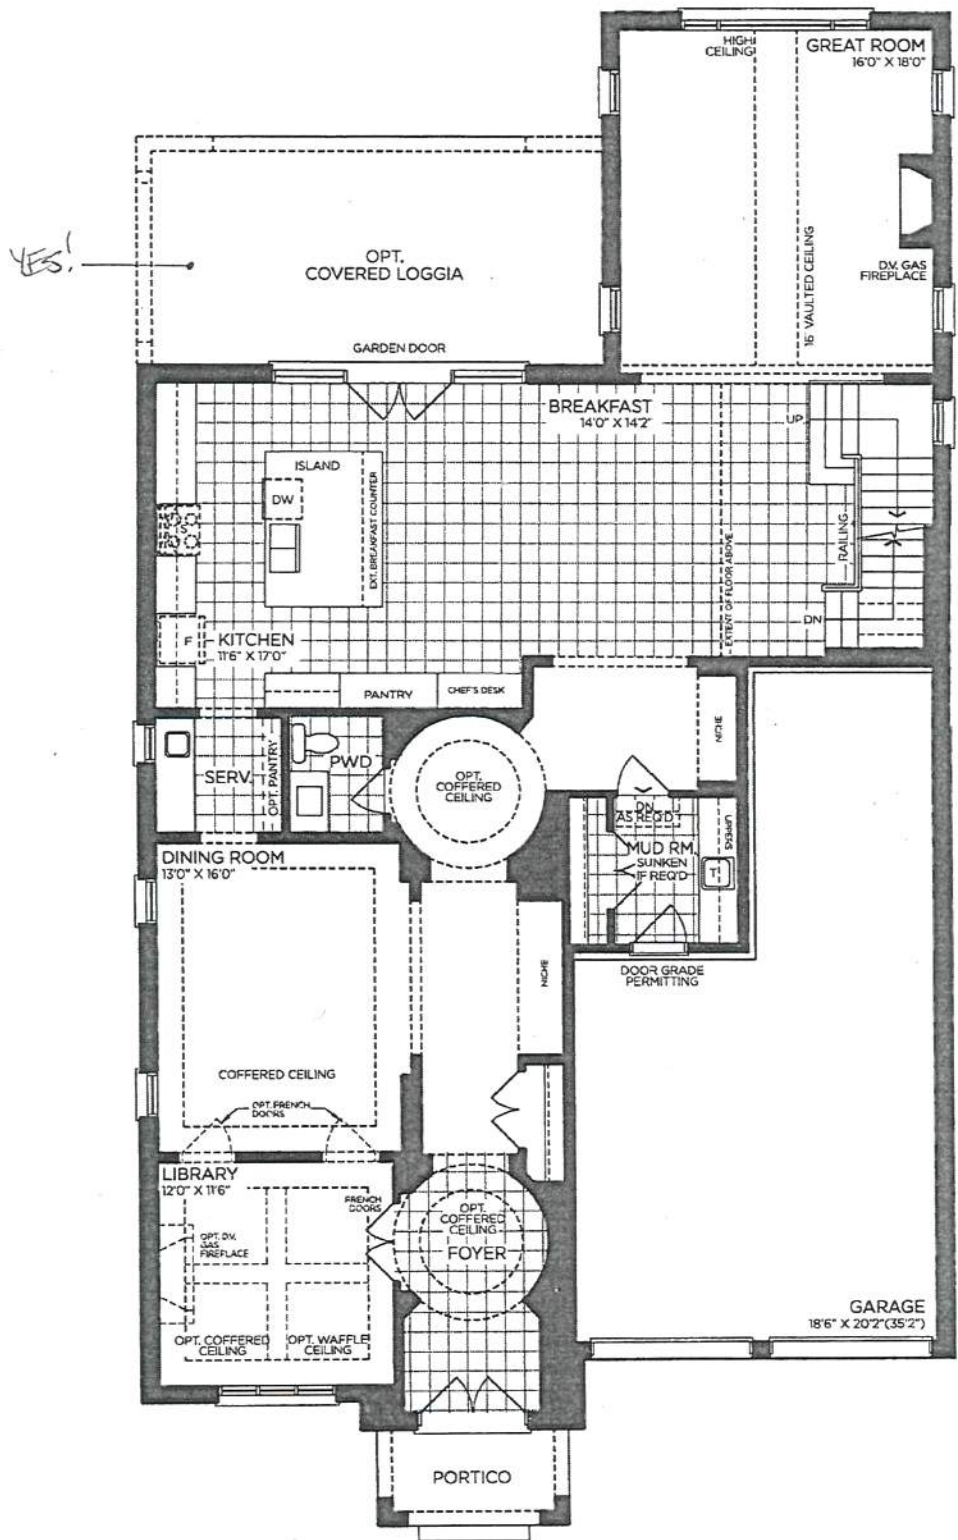

GROUND FLOOR | ELEV. A

VENDOR

PURCHASER

PURCHASER

GOLDPARK
WORTH MORE™

Prices, figures, illustrations, sizes, features and finishes are subject to change without notice. Areas and dimensions are approximate and actual usable floor space may vary from the stated area. Layout may be reverse of the unit purchased. E. & O.E. 5004


SCHEDULE 'F'



PV-1
OCT 19 2020

The
Beaumont
50' SERIES

- Elevation A • 4,170 sq.ft.
4,315 sq.ft. Opt. Elevator
- Elevation B • 4,165 sq.ft.
4,315 sq.ft. Opt. Elevator
- Elevation C • 4,250 sq.ft.
4,400 sq.ft. Opt. Elevator

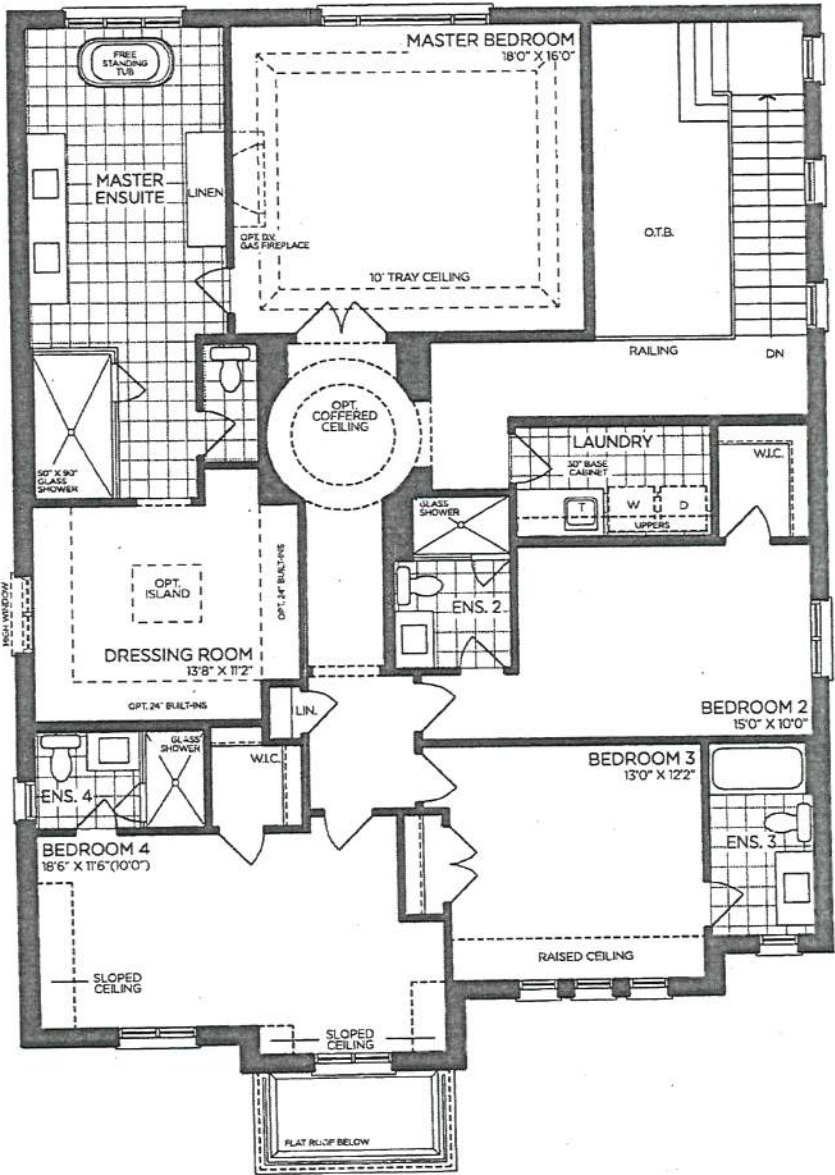

SECOND FLOOR | ELEV. A

VENDOR

PURCHASER

PURCHASER

GOLDPARK
WORTH MORE™

Prices, figures, illustrations, sizes, features and finishes are subject to change without notice. Areas and dimensions are approximate and actual usable floor space may vary from the stated area. Layout may be reverse of the unit purchased. E. & O.E. 5004


SCHEDULE 'F'



PV-1
Oct 19 2020

The
Beaumont
50' SERIES

- Elevation A • 4,170 sq.ft.
4,315 sq.ft. Opt. Elevator
- Elevation B • 4,165 sq.ft.
4,315 sq.ft. Opt. Elevator
- Elevation C • 4,250 sq.ft.
4,400 sq.ft. Opt. Elevator

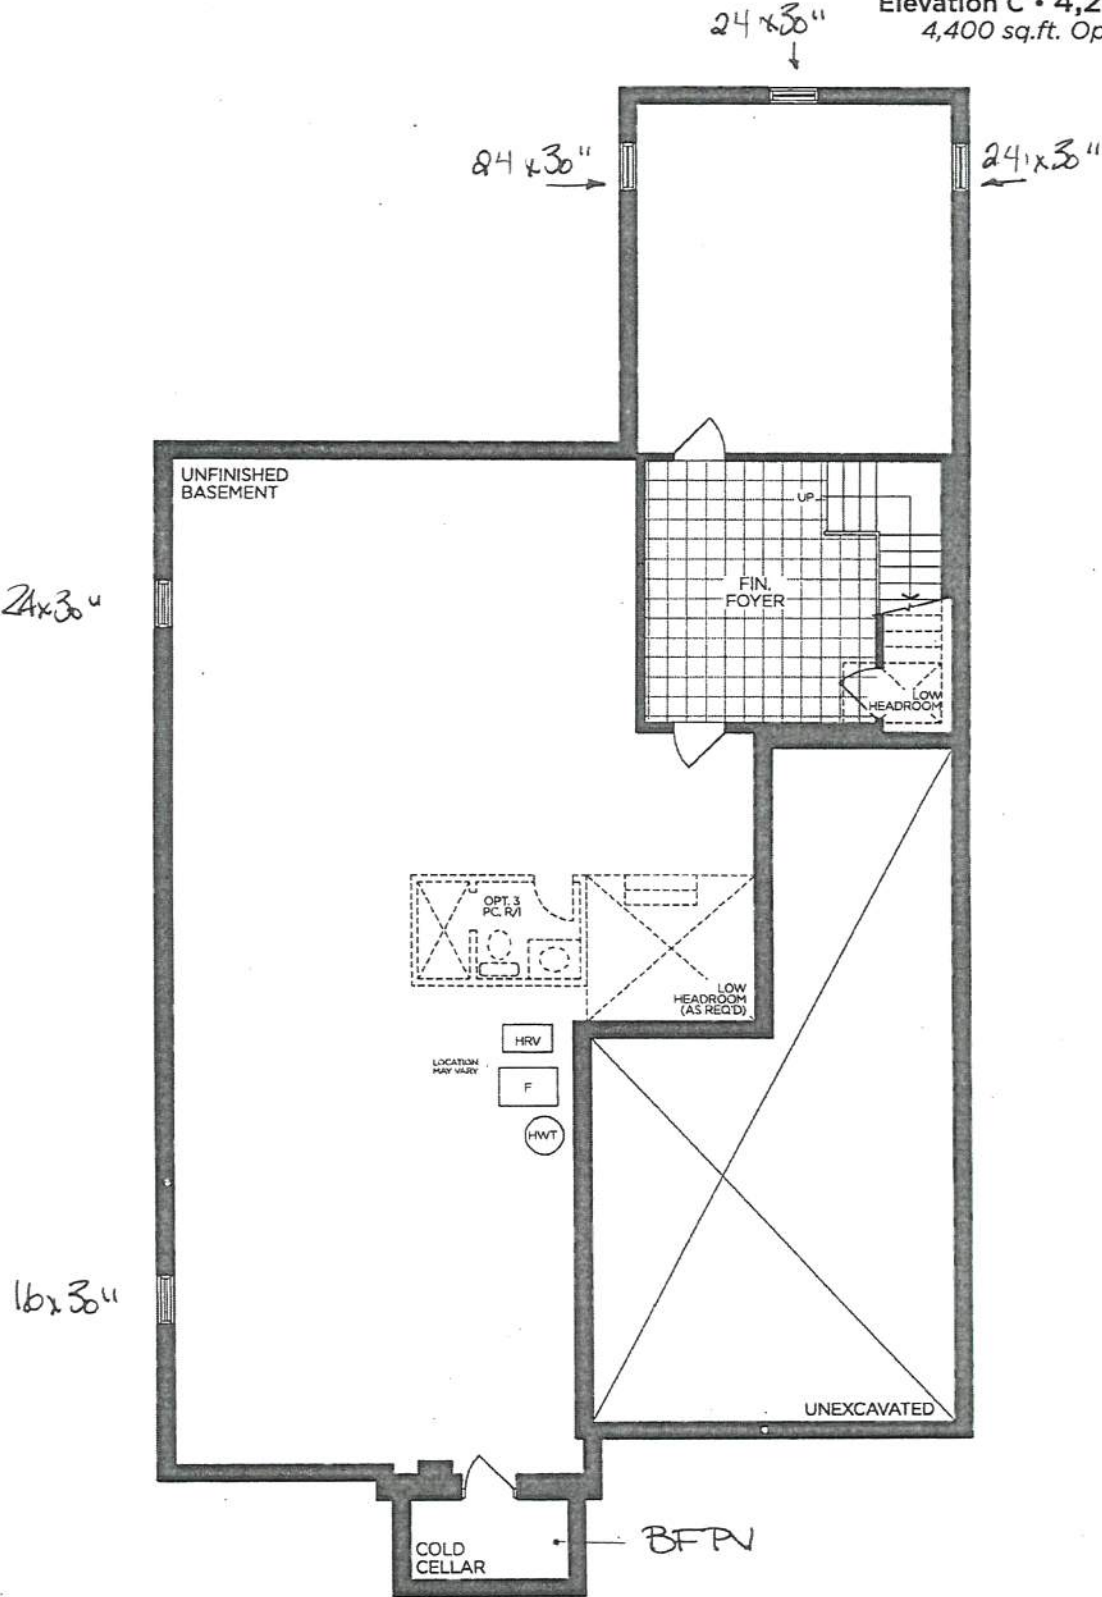

BASEMENT | ELEV. A

VENDOR

PURCHASER

PURCHASER

GOLDPARK
WORTH MORE™

Prices, figures, illustrations, sizes, features and finishes are subject to change without notice. Areas and dimensions are approximate and actual usable floor space may vary from the stated area. Layout may be reverse of the unit purchased. E. & O.E. 5004