

Lot: 3
Model: 42.02 B ROSEDALE
Project/Phase: Pine Valley Forevergreen / 1

BASEMENT WINDOWS

Invoice	Qty.	Description
2479 72,351 21Oct20	3	BASEMENT WINDOWS - UPGRADE BASEMENT WINDOW SIZE TO 30 " X 24" - 8" FRAME


CONCRETE AND DRAIN

Invoice	Qty.	Description
2479 21Oct20 NoCat	1	BACK-FLOW PREVENTER VALVE

AV-3
Oct 19 2020

SCHEDULE 'F'

The
Rosedale
42' SERIES
Elevation A • 3,655 sq.ft.
Elevation B • 3,605 sq.ft.
Elevation C • 3,590 sq.ft.

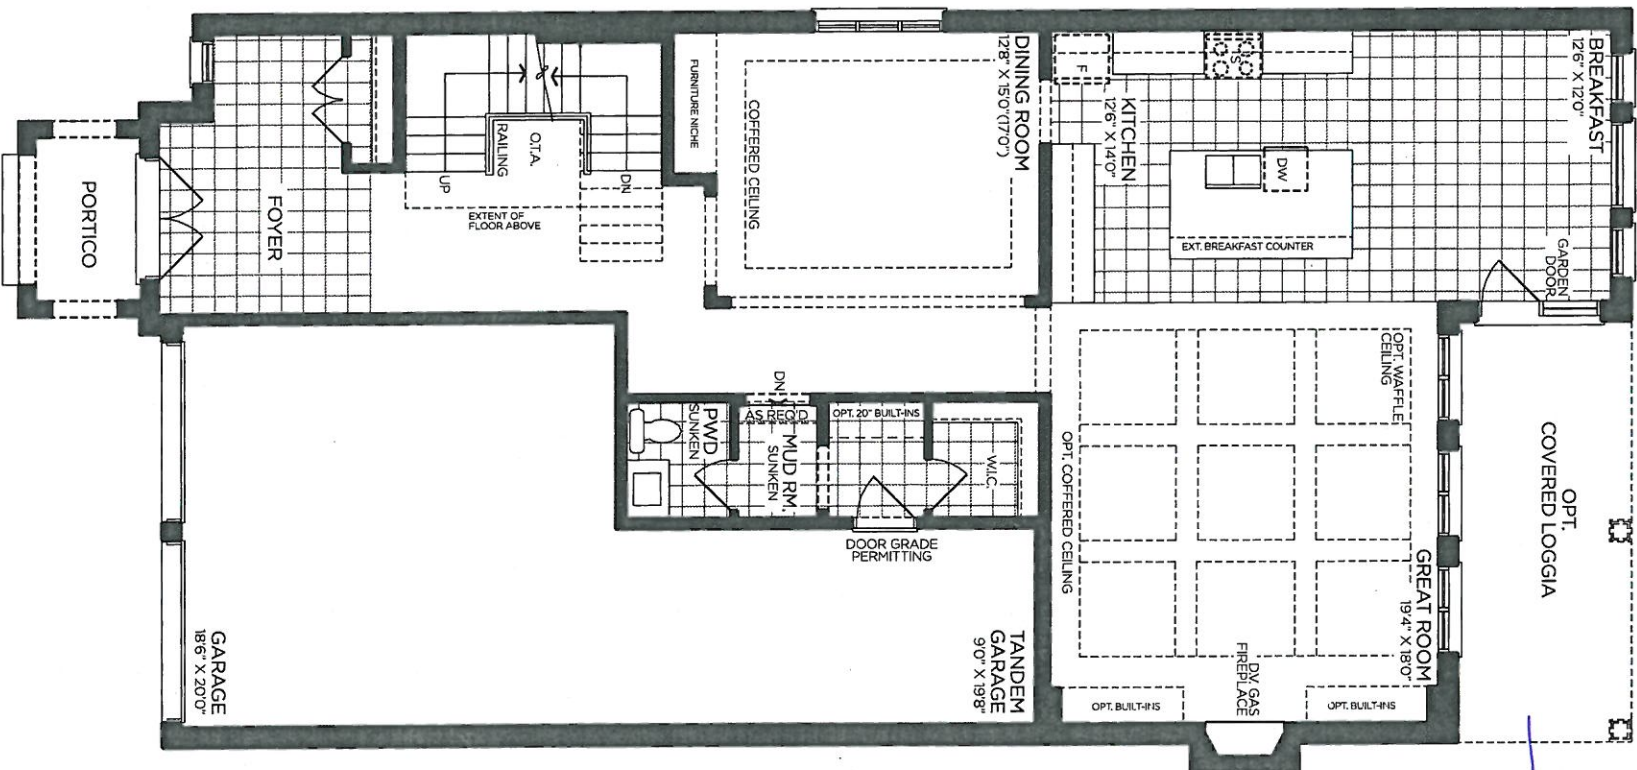

GROUND FLOOR | ELEV. A

VENDOR

PURCHASER

PURCHASER


GOLDPARK
WORTH MORE™

Prices, figures, illustrations, sizes, features and finishes are subject to change without notice. Areas and dimensions are approximate and actual usable floor space may vary from the stated area. Layout may be reverse of the unit purchased. E. & O.E. 4/202

TV-3
Oct 19 2020

SCHEDULE 'F'

The
Rosedale
42' SERIES
Elevation A • 3,655 sq.ft.
Elevation B • 3,605 sq.ft.
Elevation C • 3,590 sq.ft.

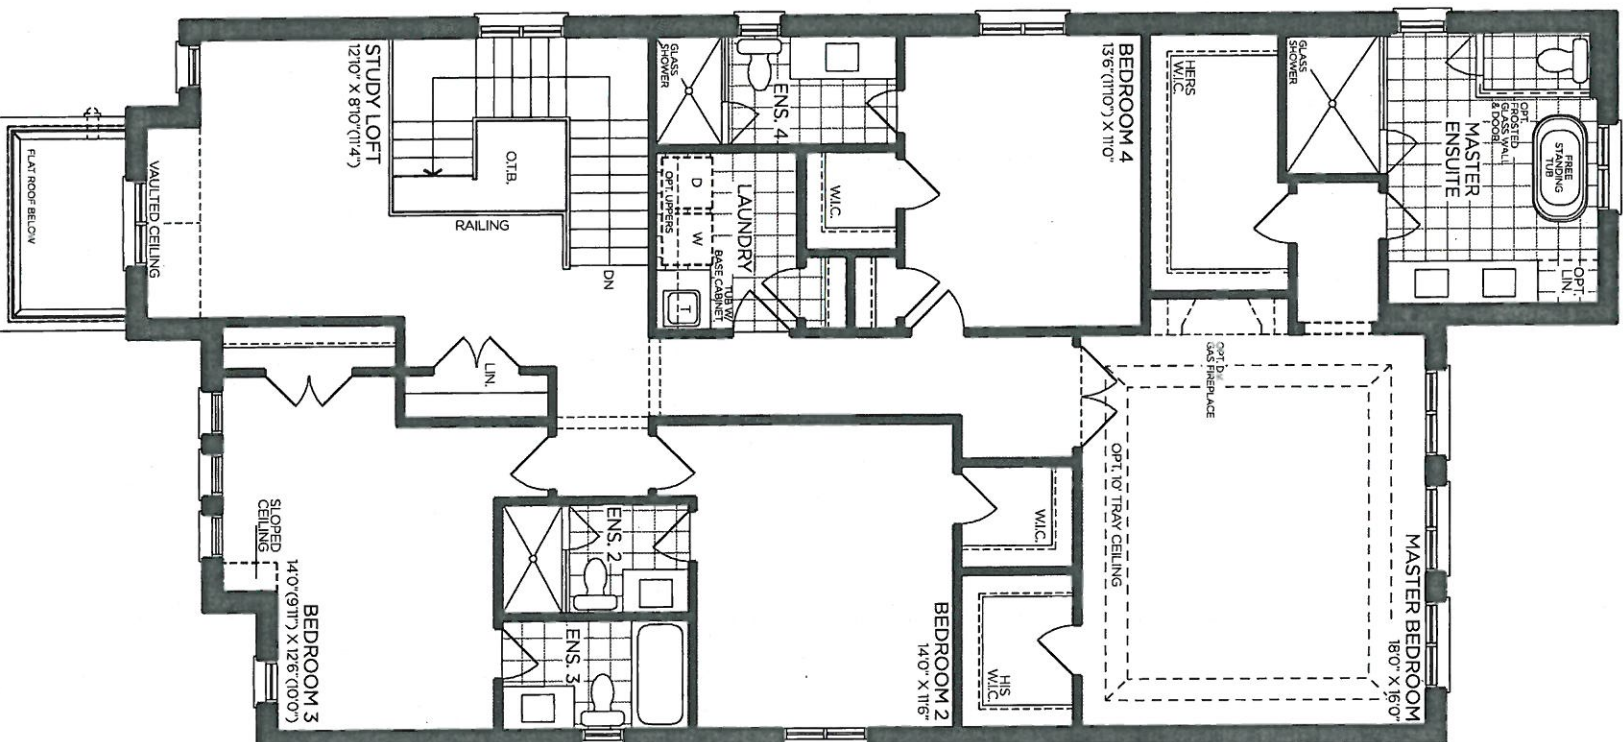

SECOND FLOOR | ELEV. A

VENDOR

PURCHASER

PURCHASER


GOLDPARK
WORTH MORE™

Prices, figures, illustrations, sizes, features and finishes are subject to change without notice. Areas and dimensions are approximate and actual usable floor space may vary from the stated area. Layout may be reverse of the unit purchased. E. & O.E. 4/202

AV-3
Oct 19 2020

SCHEDULE 'F'

The
Rosedale
42' SERIES
Elevation A • 3,655 sq.ft.
→ Elevation B • 3,605 sq.ft.
Elevation C • 3,590 sq.ft.

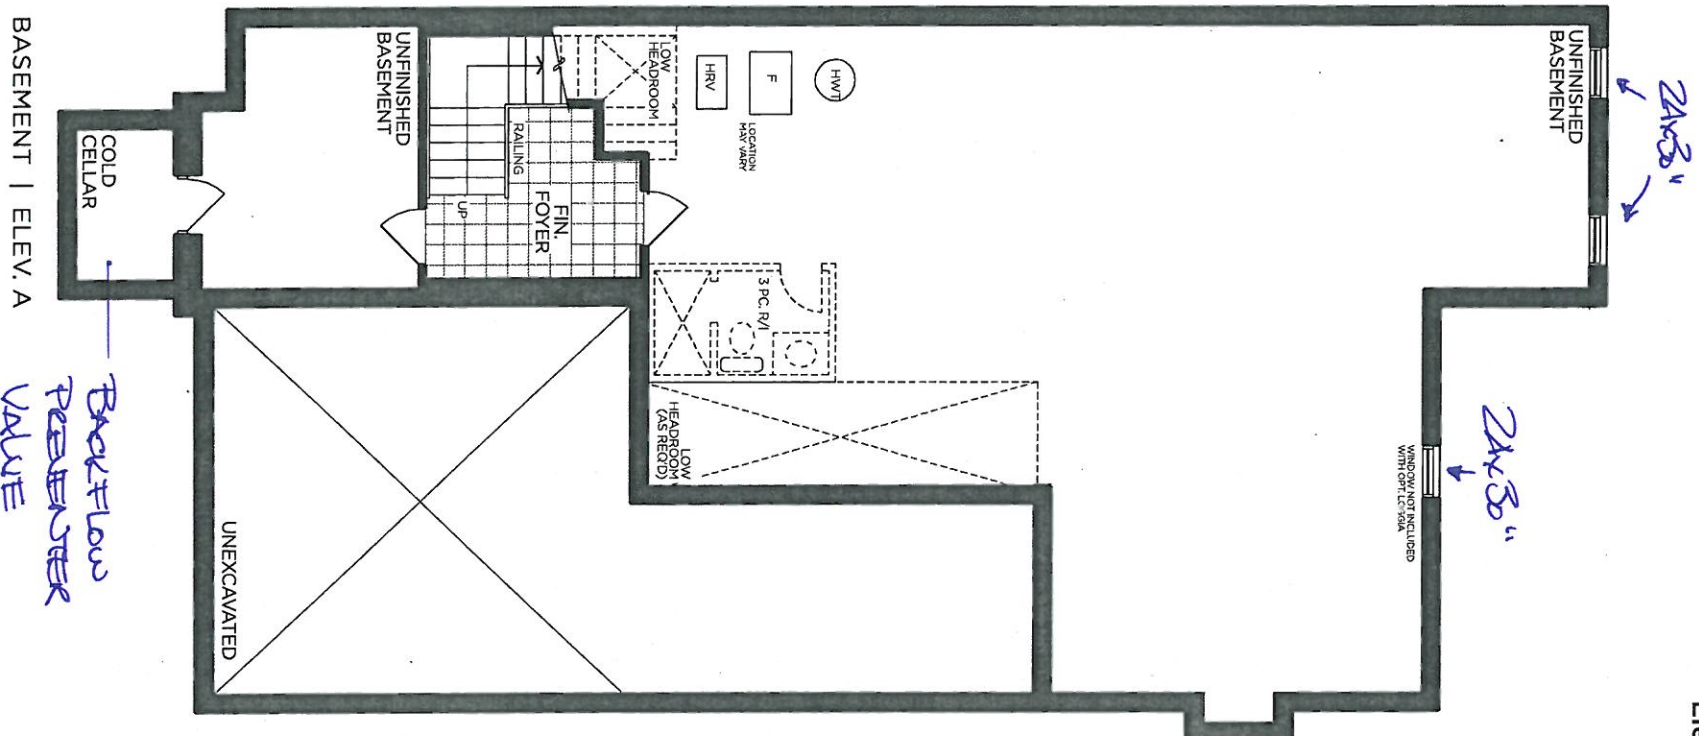

VENDOR


PURCHASER

PURCHASER

GOLDPARK
WORTH MORE™

Prices, figures, illustrations, sizes, features and finishes are subject to change without notice. Areas and dimensions are approximate and actual usable floor space may vary from the stated area. Layout may be reverse of the unit purchased. E. & O.E. 4202

The Rosedale 42' SERIES

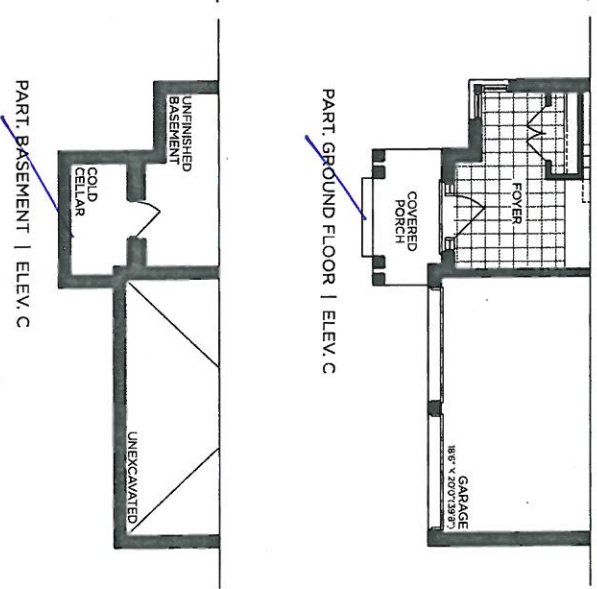

Prices, figures, illustrations, sizes, features and finishes are subject to change without notice. Areas and dimensions are approximate and actual usable floor space may vary from the stated area. Layout may be reverse of the unit purchased. E. & O.E. 4/202

GOLDPARK
WORTH MORE™