



CONSTRUCTION SUMMARY

Lot: 10
Model: 40.03 B BROOKSIDE
Project/Phase: Pine Valley Forevergreen / 1

BASEMENT WINDOWS

Invoice	Qty.	Description
2485 72,351 21Oct20	3	BASEMENT WINDOWS - UPGRADE BASEMENT WINDOW SIZE TO 30 " X 24" - 8" FRAME

CONCRETE AND DRAIN

Invoice	Qty.	Description
2485 21Oct20 NoCat	1	BACK-FLOW PREVENTER VALVE

Lot: 10
Model: 40.03 B BROOKSIDE
Project/Phase: Pine Valley Forevergreen / 1

ROUGH CARPENTRY

Invoice	Qty.	Description
2485 72,351 21Oct20 **	3	BASEMENT WINDOWS - UPGRADE BASEMENT WINDOW SIZE TO 30 " X 24" - 8" FRAME


WINDOWS - BASEMENT

Invoice	Qty.	Description
2485 72,351 21Oct20 **	3	BASEMENT WINDOWS - UPGRADE BASEMENT WINDOW SIZE TO 30 " X 24" - 8" FRAME

SCHEDULE 'F'

AV-10
Oct 19 2026

The
Brookside
40' SERIES
Elevation A • 3,380 sq.ft.
Elevation B • 3,350 sq.ft.

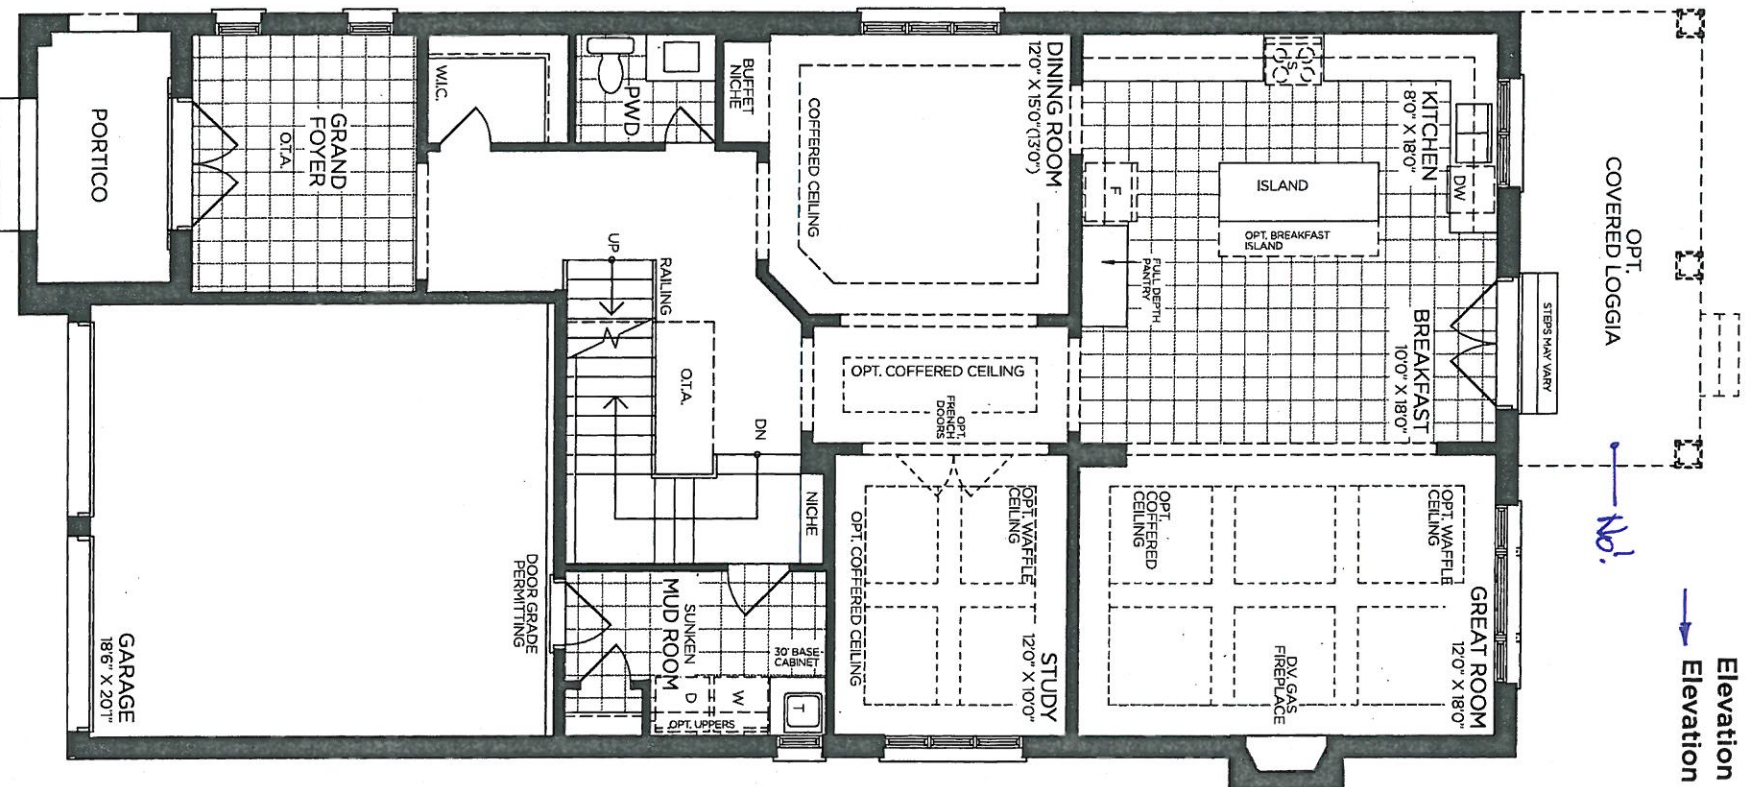

GROUND FLOOR | ELEV. A

VENDOR

PURCHASER

PURCHASER


GOLDPARK
WORTH MORE

Prices, figures, illustrations, sizes, features and finishes are subject to change without notice. Areas and dimensions are approximate and actual usable floor space may vary from the stated area. Layout may be reverse of the unit purchased. E. & O.E. 4003

PL-10
Oct 19 2020

SCHEDULE 'F'

The
Brookside
40' SERIES
Elevation A • 3,380 sq.ft.
Elevation B • 3,350 sq.ft.

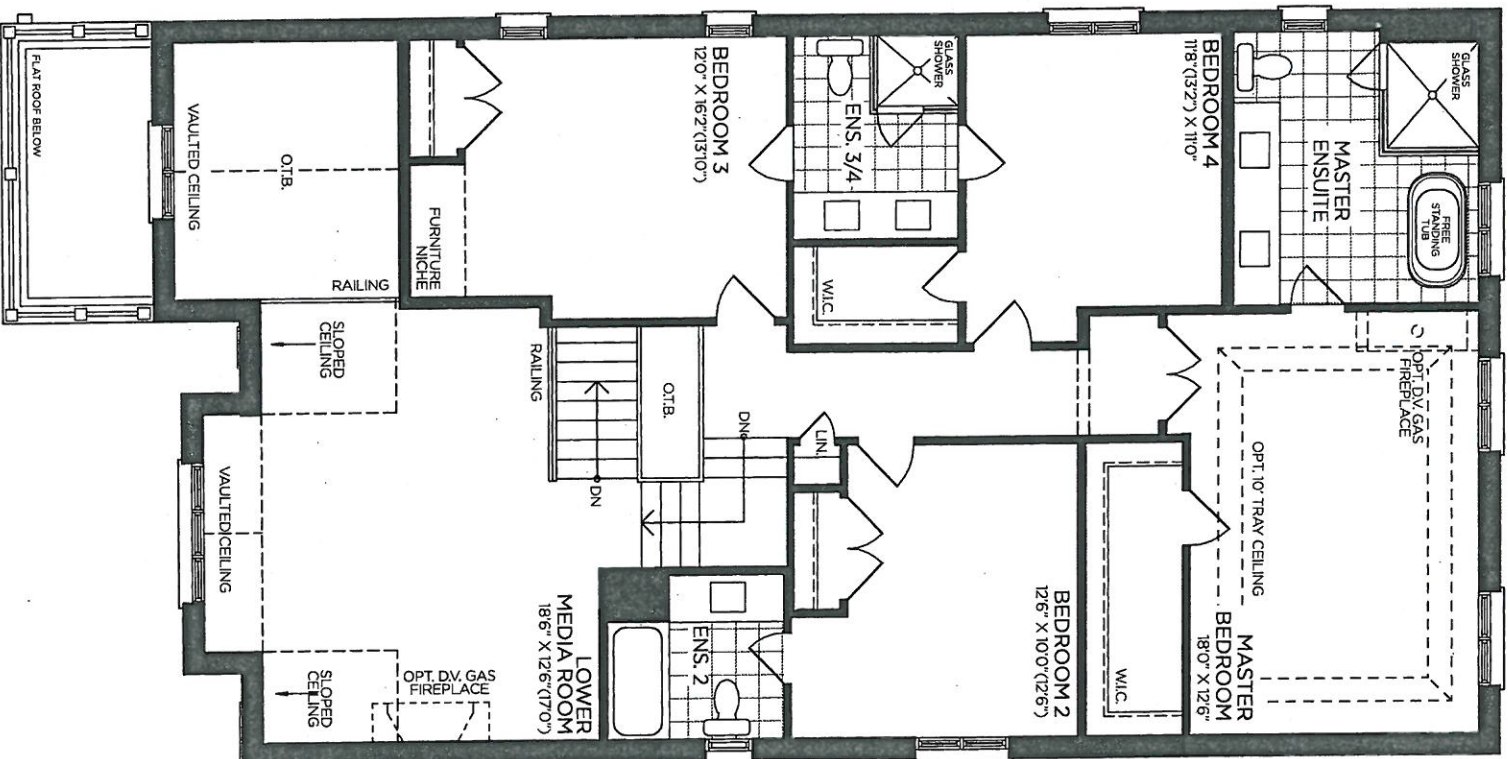

SECOND FLOOR | ELEV. A

VENDOR

PURCHASER

PURCHASER


GOLDPARK
WORTH MORE™

Prices, figures, illustrations, sizes, features and finishes are subject to change without notice. Areas and dimensions are approximate and actual usable floor space may vary from the stated area. Layout may be reverse of the unit purchased. E. & O.E. 4003

AL-10
Oct 19 2020

SCHEDULE 'F'

The
Brookside
40' SERIES
Elevation A • 3,380 sq.ft.
Elevation B • 3,350 sq.ft.

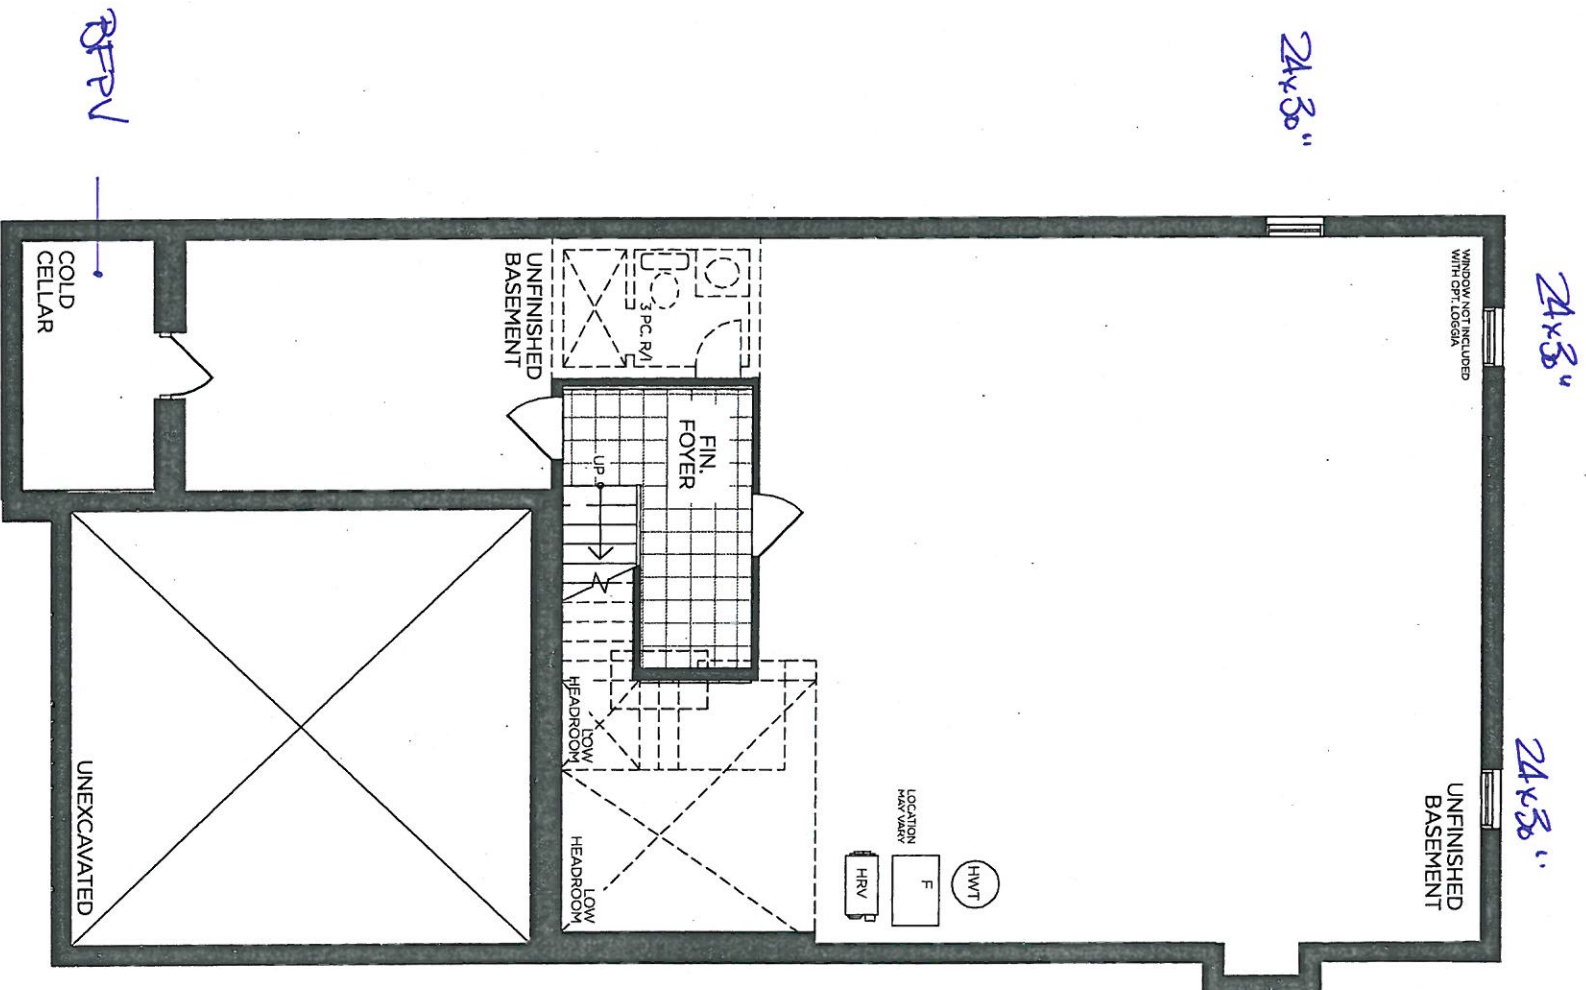

BASEMENT | ELEV. A

VENDOR

PURCHASER

PURCHASER

GOLDPARK
WORTH MORE™





Prices, figures, illustrations, sizes, features and finishes are subject to change without notice. Areas and dimensions are approximate and actual usable floor space may vary from the stated area. Layout may be reverse of the unit purchased. E. & O.E. 4003

SCHEDULE 'F'

 PINE VALLEY
FOREVERGREEN

AV-10
Oct 19 2026

The
Brookside
40' SERIES
Elevation A • 3,380 sq.ft.
Elevation B • 3,350 sq.ft.

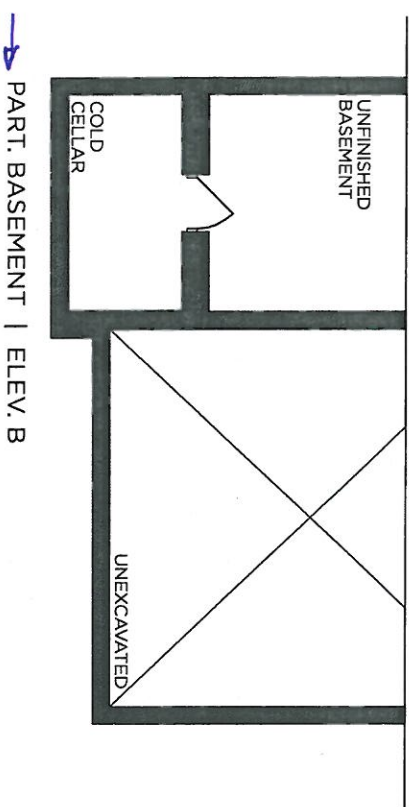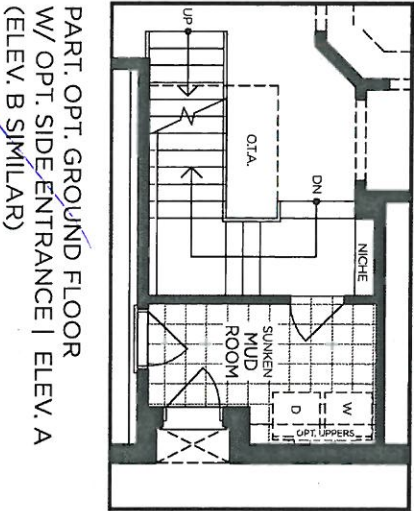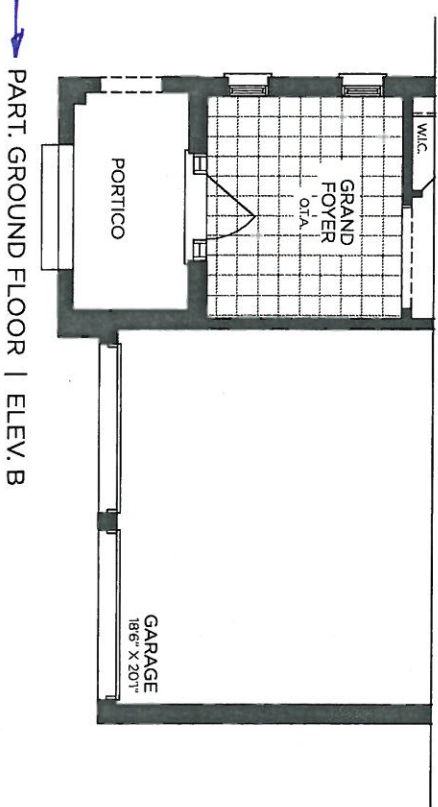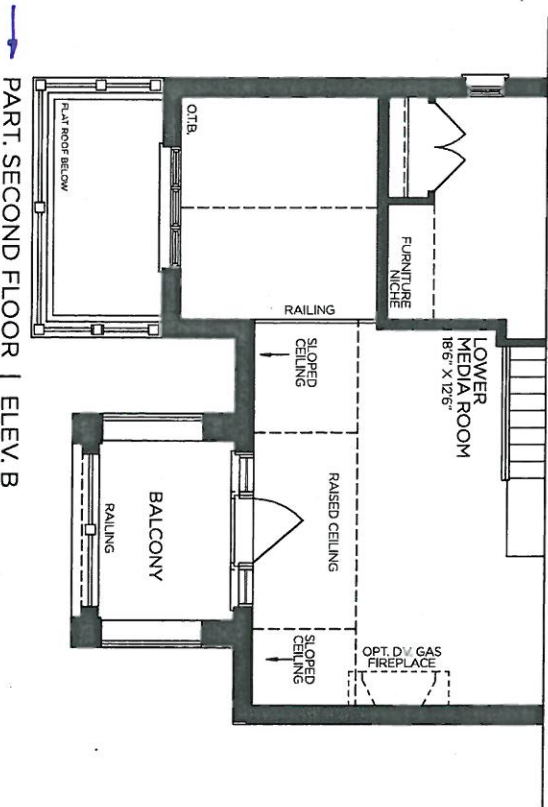

VENDOR

PURCHASER

PURCHASER

GOLDPARK
WORTH MORE™

Prices, figures, illustrations, sizes, features and finishes are subject to change without notice. Areas and dimensions are approximate and actual usable floor space may vary from the stated area. Layout may be reverse of the unit purchased. E. & O.E. 4003