

Lot: 155

Model: 40.00 B BRIARWOOD

Project/Phase: Pine Valley Forevergreen / 1

BASEMENT WINDOWS

Invoice	Qty.	Description
2488 72,351 21Oct20	2	BASEMENT WINDOWS - UPGRADE BASEMENT WINDOW SIZE TO 30 " X 24" - 8" FRAME

CONCRETE AND DRAIN

Invoice	Qty.	Description
2488 21Oct20 NoCat	1	BACK-FLOW PREVENTER VALVE

Lot: 155

Model: 40.00 B BRIARWOOD

Project/Phase: Pine Valley Forevergreen / 1

ROUGH CARPENTRY

Invoice	Qty.	Description
2488	2	BASEMENT WINDOWS - UPGRADE BASEMENT WINDOW SIZE TO 30 " X 24" - 8" FRAME
72,351		
21Oct20		
**		


WINDOWS - BASEMENT

Invoice	Qty.	Description
2488	2	BASEMENT WINDOWS - UPGRADE BASEMENT WINDOW SIZE TO 30 " X 24" - 8" FRAME
72,351		
21Oct20		
**		

RV-155
OCT. 19 2020

The Bearwood
40' Series
Elevation B - 2,800 sq.ft.

THIS PLAN
SHOWS OPT
GROUND
FLOOR

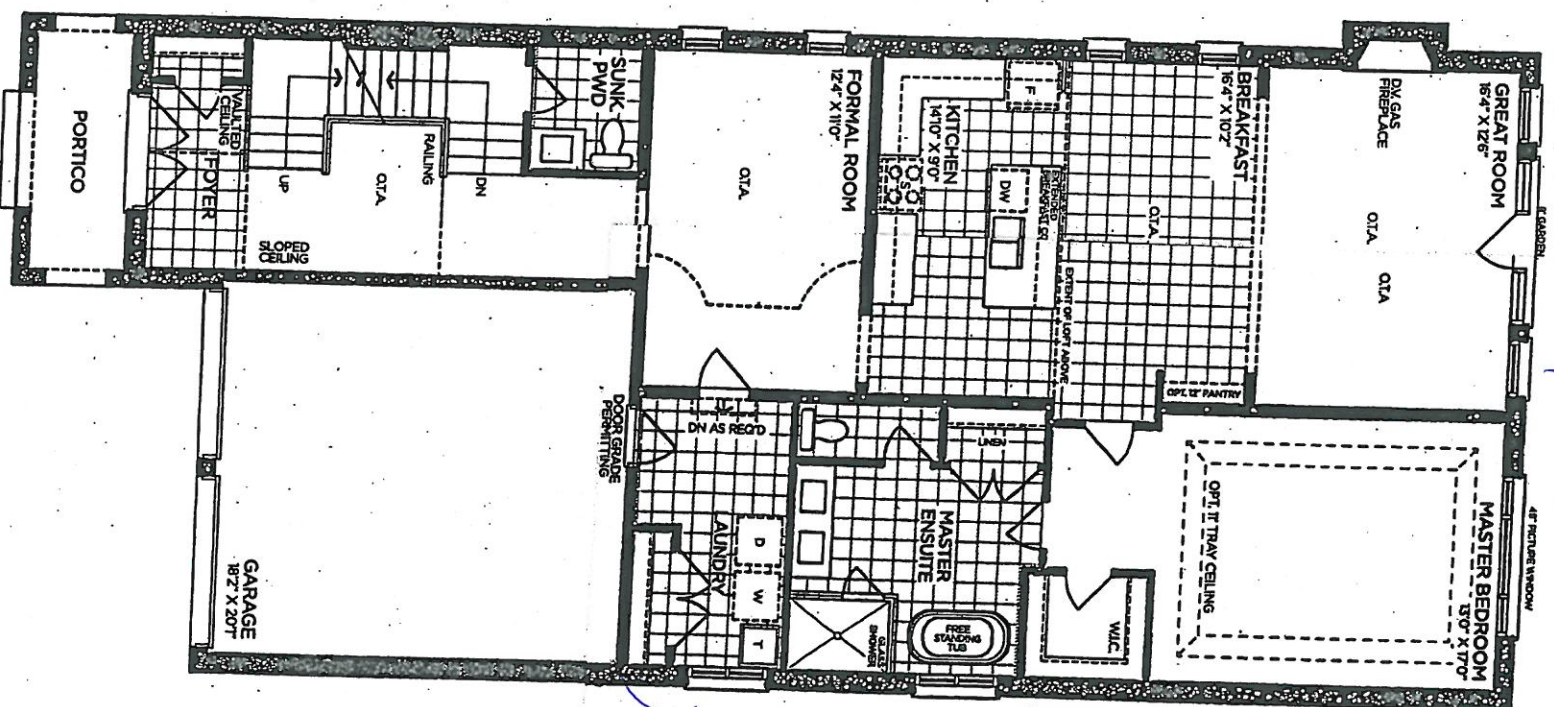

GROUND FLOOR | ELEV. A

ELEV. B

VENDOR _____

PURCHASER _____

PURCHASER _____

GOLDPARK
WORTH MORE™


Prices, figures, illustrations, sizes, features and finishes are subject to change without notice. Areas and dimensions are approximate and actual usable floor space may vary from the stated area. Layout may be reverse of the unit purchased. E & OE. 4000

2
SCHEDULE 'F'

 PINE VALLEY
FOREVERGREEN

FI-155
Oct 19 2020

The
Briarwood
40' SERIES
Elevation A • 2,870 sq.ft.
Elevation B • 2,860 sq.ft.

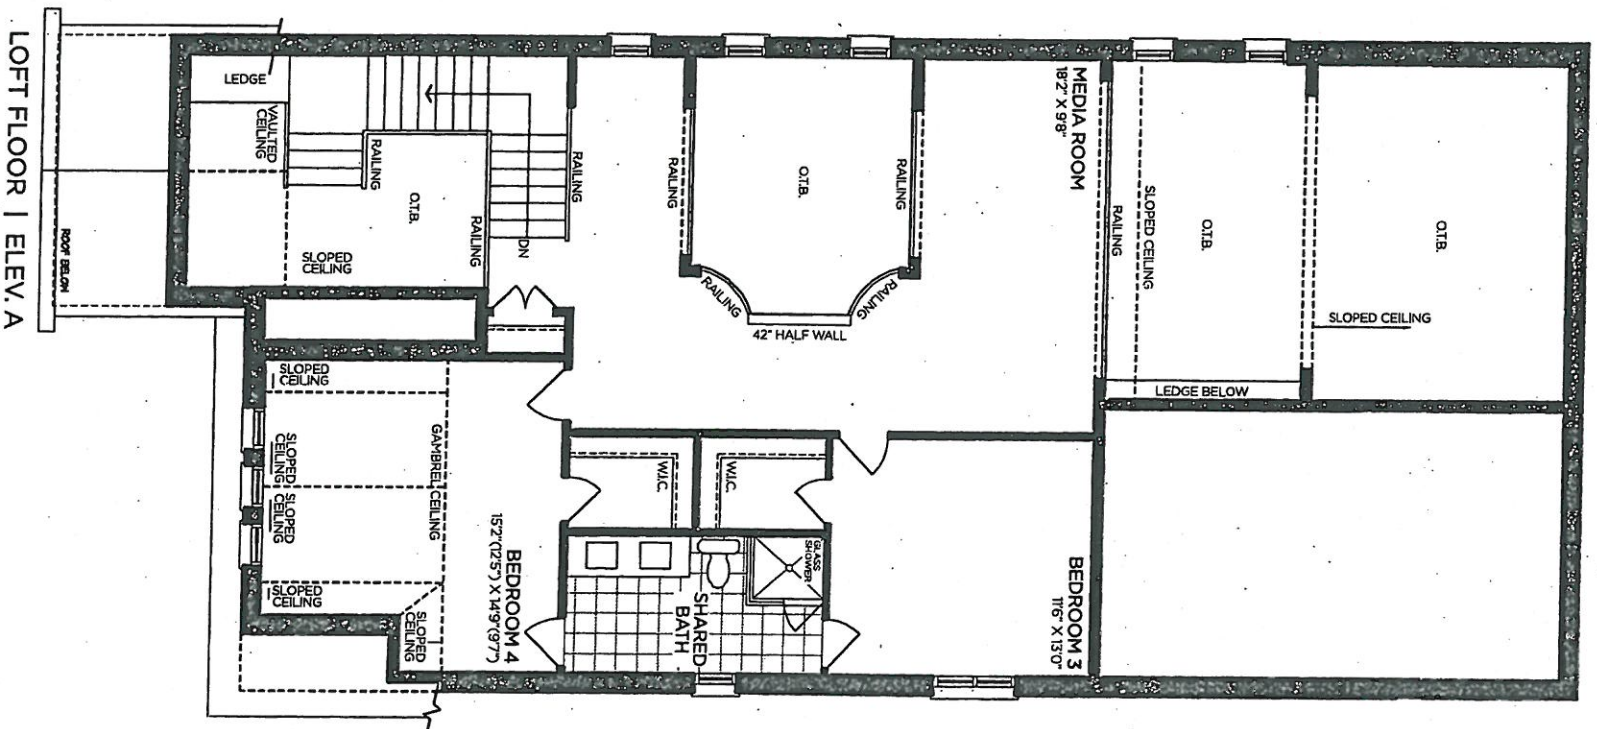

VENDOR _____
PURCHASER _____
PURCHASER _____


Prices, figures, illustrations, sizes, features and finishes are subject to change without notice. Areas and dimensions are approximate and actual usable floor space may vary from the stated area. Layout may be reverse of the unit purchased. E. & O.E. 4000

GOLDPARK
WORTH MORE™

FN-155
Oct 19 2020

SCHEDULE 'F'

The
Briarwood
40' SERIES
Elevation A • 2,870 sq.ft.
Elevation B • 2,860 sq.ft.

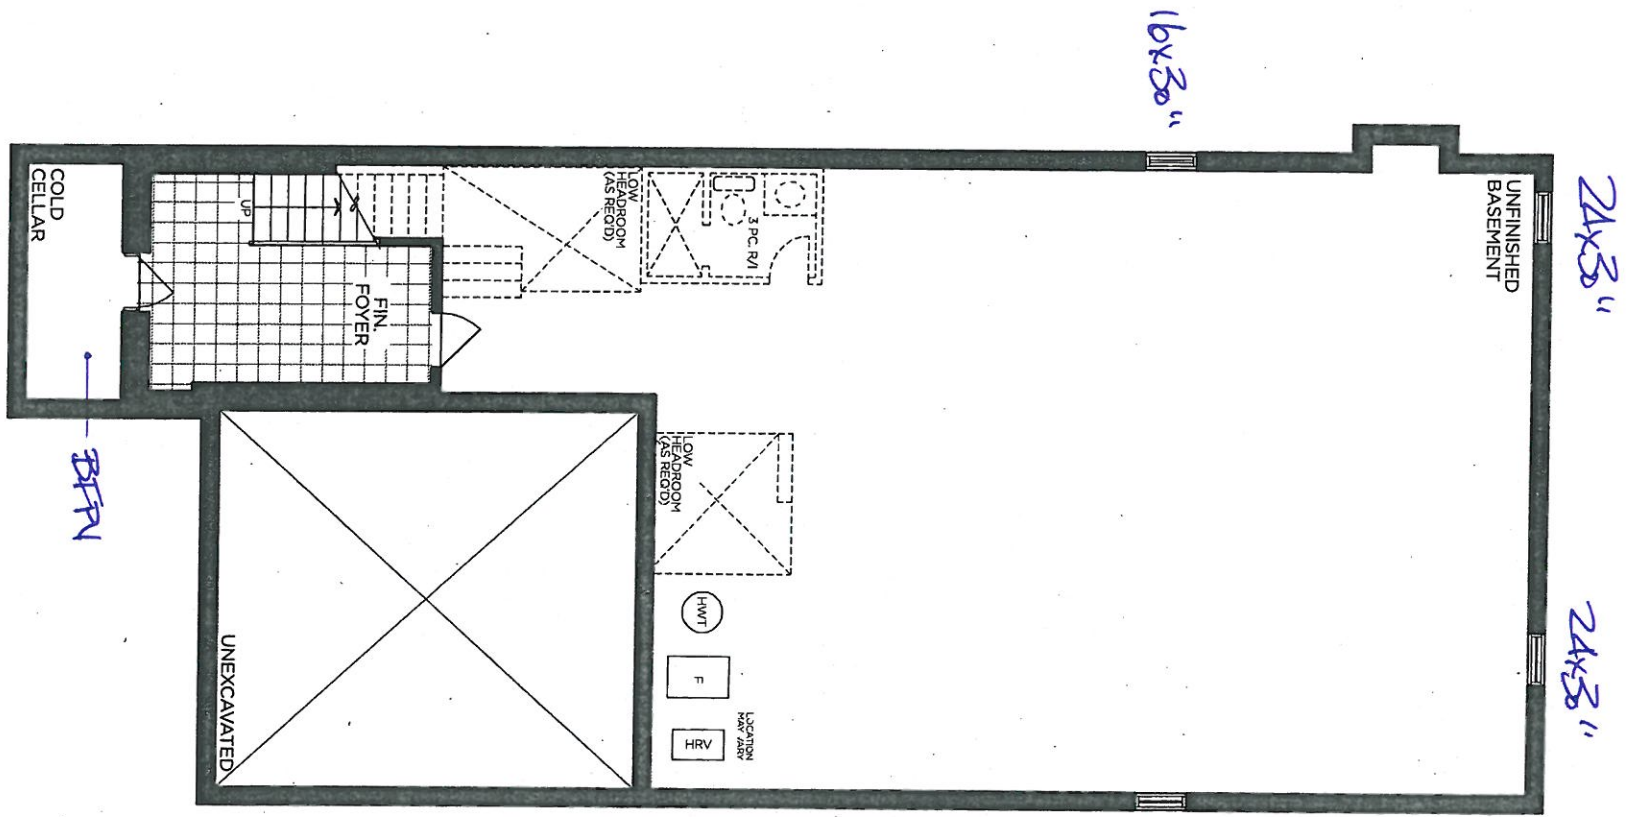

BASEMENT | ELEV. A & B
3

VENDOR _____
PURCHASER _____
PURCHASER _____

GOLDPARK
WORTH MORE™

Prices, figures, illustrations, sizes, features and finishes are subject to change without notice. Areas and dimensions are approximate and actual usable floor space may vary from the stated area. Layout may be reverse of the unit purchased. E. & O.E. 4000