


158

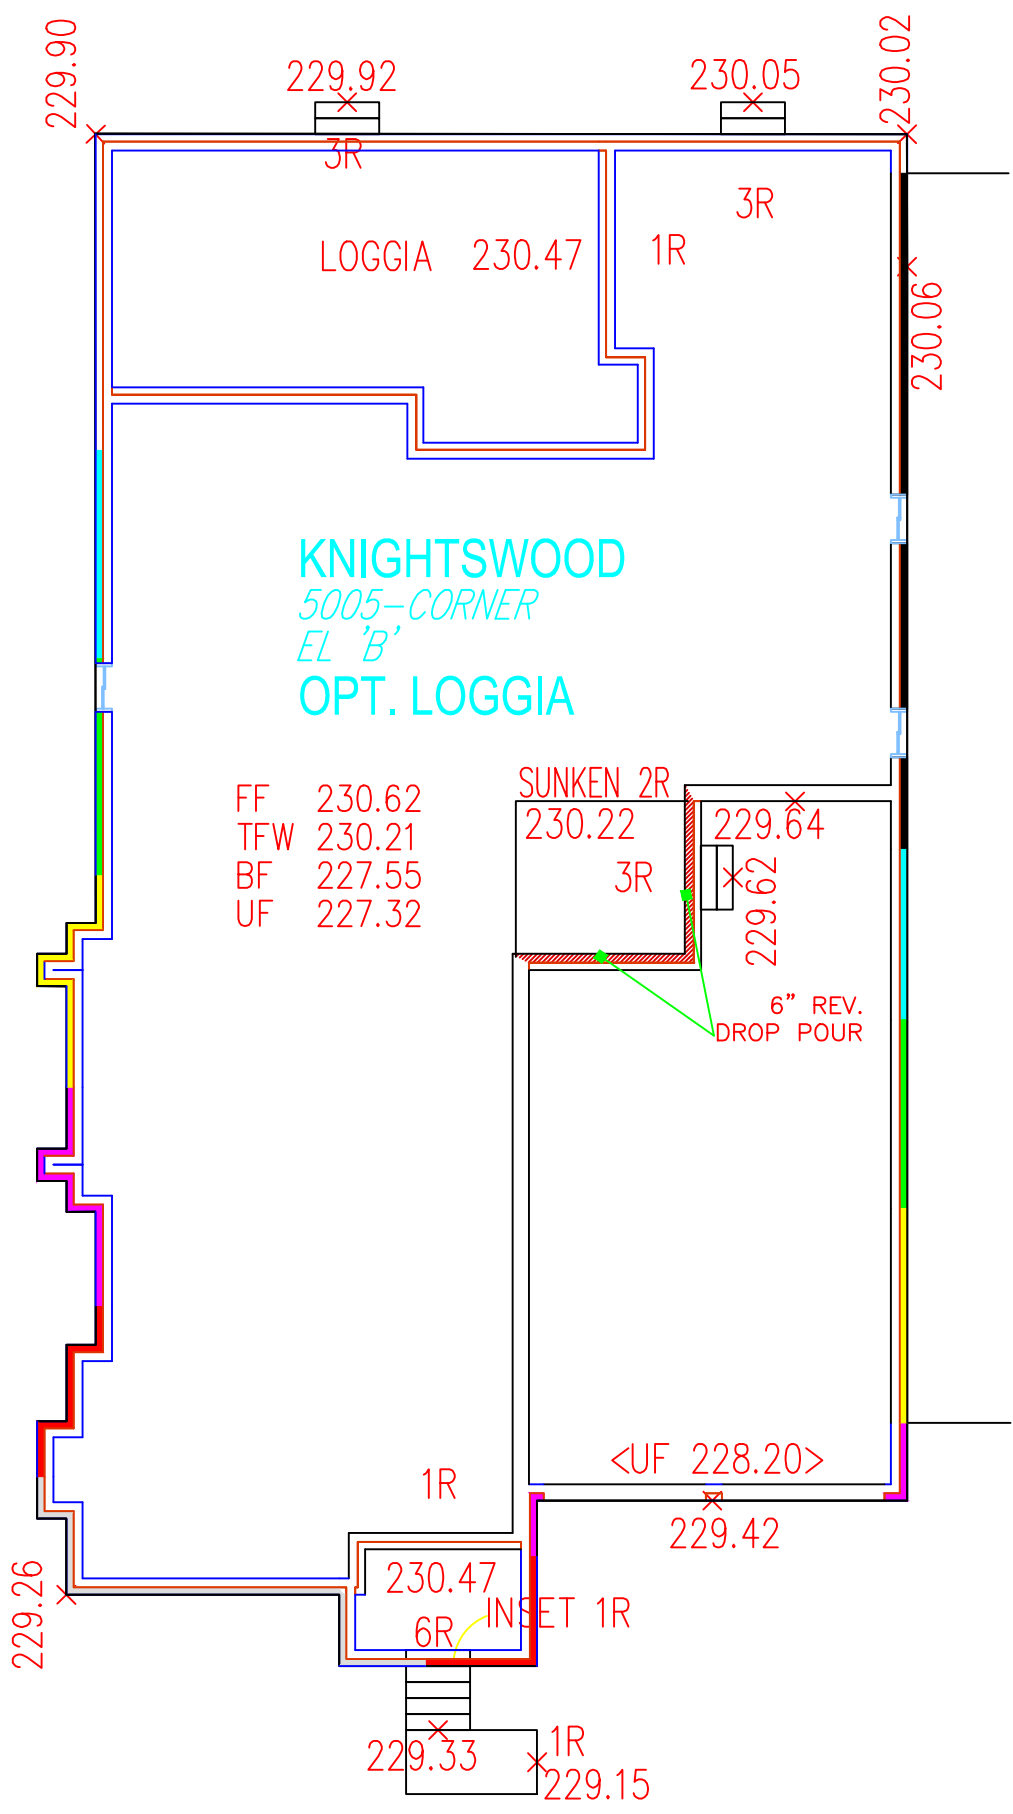

PLAN

PHASE:

Total Stone Area Sq. Ft. + 5% Waste = 171 SQFT

Total Bricks + 4% Waste 151

Legend

|                 |  |                 |  |
|-----------------|--|-----------------|--|
| 1 Brick (5")    |  | Standard Wall   |  |
| 2 Brcks (8.5")  |  | Garage Wall     |  |
| 3 Brcks (12")   |  | 1 Riser reverse |  |
| 4 Brcks (15.5") |  | 2 Riser reverse |  |
| 5 Brcks (19")   |  | 3 Riser reverse |  |
| 6 Brcks (22.5") |  | 4 Riser reverse |  |
| 7 Brcks (26")   |  | Cut Pour        |  |
| 8 Brcks (29.5") |  |                 |  |

|                             |                     |
|-----------------------------|---------------------|
| Site Name : Pine Valley     | Job No.             |
| Location : Vaughan, Ontario |                     |
| Date: 11/04/20              | Lot # 158 - REVISED |
| By : jamesp                 | Scale : n.t.s.      |