

GOLDPARK

WORTH MORE™

CONSTRUCTION SUMMARY

Lot: 143

Model: 38-8 Elev.B CORELLI

Project/Phase: Brampton Encore / 2

APPLIANCES

| Invoice          | Qty. | Description                                                                         |
|------------------|------|-------------------------------------------------------------------------------------|
| 2414             | 1    | APPLIANCE PACKAGE: FRIDGE/STOVE/DISHWASHER – STAINLESS STEEL + WASHER/DRYER – WHITE |
| 09Nov20<br>NoCat |      | INCLUDED IN APS                                                                     |

CERAMIC

| Invoice          | Qty. | Description                                                                                                                                                                     |
|------------------|------|---------------------------------------------------------------------------------------------------------------------------------------------------------------------------------|
| 2414             | 1    | MAIN FLOOR: FOYER / KITCHEN / BREAKFAST / SERVERY / POWDER / WIP (FORMER LAUNDRY): UPGRADE 5 FLOOR TILE 24X24" LAID IN STRAIGHT, STACKED PATTERN.                               |
| 09Nov20<br>NoCat |      |                                                                                                                                                                                 |
| 2414             | 1    | **CUSTOM LAYOUT** DELETE LAUNDRY ROOM, CREATE WIP INSTEAD. RELOCATE DOOR TO SERVERY SIDE - LEAVE WITH DRYWALL AND TILE FLOOR - PURCHASER TO INSTALL OWN CABINETRY AFTER CLOSING |
| 09Nov20<br>NoCat |      |                                                                                                                                                                                 |

CONCRETE AND DRAIN

| Invoice             | Qty. | Description                                                                                                                                                                     |
|---------------------|------|---------------------------------------------------------------------------------------------------------------------------------------------------------------------------------|
| 2414<br>28,894      | 1    | ROUGH-IN - 3PC BASEMENT ROUGH-IN                                                                                                                                                |
| 09Nov20             |      | INCLUDED IN APS                                                                                                                                                                 |
| 2414                | 1    | ROUGH-IN - 3PC BASEMENT ROUGH-IN                                                                                                                                                |
| 09Nov20<br>** NoCat |      | INCLUDED IN APS                                                                                                                                                                 |
| 2414                | 1    | **CUSTOM LAYOUT** DELETE LAUNDRY ROOM, CREATE WIP INSTEAD. RELOCATE DOOR TO SERVERY SIDE - LEAVE WITH DRYWALL AND TILE FLOOR - PURCHASER TO INSTALL OWN CABINETRY AFTER CLOSING |
| 09Nov20<br>NoCat    |      |                                                                                                                                                                                 |
| 2414                | 1    | **CUSTOM LAYOUT** RELOCATE LAUNDRY TO BASEMENT INCLUDES LAUNDRY TUB & PLUMBING / ELECTRICAL / VENTILATION LAUNDRY (DOES NOT INCLUDE FINISHED TILE, DRYWALL, ETC)                |
| 09Nov20<br>NoCat    |      |                                                                                                                                                                                 |

DisciplineMS.rpt 26jun20

Page 1 of 8  
Printed and Sent: 09-Nov-20





GOLDPARK

WORTH MORE™

CONSTRUCTION SUMMARY

Lot: 143

Model: 38-8 Elev.B CORELLI

Project/Phase: Brampton Encore / 2

GRANITE MARBLE QUARTZ

| Invoice                      | Qty. | Description                                               |
|------------------------------|------|-----------------------------------------------------------|
| 2414<br><br>09Nov20<br>NoCat | 1    | KITCHEN: UPGRADE QUARTZ COUNTER TOP + FLUSH BREAKFAST BAR |

HARDWOOD

| Invoice                      | Qty. | Description                                                                                             |
|------------------------------|------|---------------------------------------------------------------------------------------------------------|
| 2414<br><br>09Nov20<br>NoCat | 1    | MAIN FLOOR: FAMILY / LIVING-DINING / LIBRARY / LANDINGS: UPGRADE 1 HARDWOOD - 3/4X4-3/8" RED OAK SMOOTH |

HVAC

| Invoice                      | Qty. | Description                                             |
|------------------------------|------|---------------------------------------------------------|
| 2414<br><br>09Nov20<br>NoCat | 1    | A/C- 4.0 TON<br><br>INCLUDED IN APS                     |
| 2414<br>28,872<br>09Nov20    | 1    | KITCHEN: GAS LINE ROUGH - MAIN FLOOR- (3-STOREY MODELS) |

DisciplineMS.rpt 26jun20

Page 4 of 8  
Printed and Sent: 09-Nov-20



KITCHEN AND BATH CABINETRY

| Invoice                      | Qty. | Description                                                                                                                                                                                                                                                  |
|------------------------------|------|--------------------------------------------------------------------------------------------------------------------------------------------------------------------------------------------------------------------------------------------------------------|
| 2414<br><br>09Nov20<br>NoCat | 1    | SERVERY: OPTIONAL UPPERS (STANDARD LEVEL)                                                                                                                                                                                                                    |
| 2414<br><br>09Nov20<br>NoCat | 4    | KITCHEN: PLAIN, CLEAR GLASS DOOR<br>*NOTE* STANDARD WHITE INTERIOR TO REMAIN                                                                                                                                                                                 |
| 2414<br><br>09Nov20<br>NoCat | 1    | MAIN FLOOR CEILING 10FT - PACKAGE INCLUDES TALLER FRONT DOOR WITH TRANSOMS, 8' INTERIOR DOORS AND ARCHES, TALLER FRONT AND REAR WINDOWS/TRANSOMS, KITCHEN CABINETS TO RECEIVE CROWN & FURRING PANEL OVER EXTENDED CABINETS (COMES WITH 12" DRYWALL BULKHEAD) |

PAINT

| Invoice                      | Qty. | Description                                                                                                                                                                                                                                                  |
|------------------------------|------|--------------------------------------------------------------------------------------------------------------------------------------------------------------------------------------------------------------------------------------------------------------|
| 2414<br><br>09Nov20<br>NoCat | 1    | MAIN STAIRS: STAIN STAIRS TO MATCH HARDWOOD, AS CLOSE AS POSSIBLE.                                                                                                                                                                                           |
| 2414<br><br>09Nov20<br>NoCat | 1    | MAN DOOR FROM GARAGE TO HOUSE- GRADE PERMITTING<br><br>INCLUDED IN APS                                                                                                                                                                                       |
| 2414<br><br>09Nov20<br>NoCat | 1    | MAIN FLOOR CEILING 10FT - PACKAGE INCLUDES TALLER FRONT DOOR WITH TRANSOMS, 8' INTERIOR DOORS AND ARCHES, TALLER FRONT AND REAR WINDOWS/TRANSOMS, KITCHEN CABINETS TO RECEIVE CROWN & FURRING PANEL OVER EXTENDED CABINETS (COMES WITH 12" DRYWALL BULKHEAD) |
| 2414<br><br>09Nov20<br>NoCat | 1    | MASTER BEDROOM: OPTIONAL 10 FOOT TRAY CEILING - MASTER BEDROOM (AS PER PLAN)                                                                                                                                                                                 |
| 2414<br><br>09Nov20<br>NoCat | 1    | **CUSTOM LAYOUT** DELETE LAUNDRY ROOM, CREATE WIP INSTEAD.<br>RELOCATE DOOR TO SERVERY SIDE - LEAVE WITH DRYWALL AND TILE FLOOR - PURCHASER TO INSTALL OWN CABINETRY AFTER CLOSING                                                                           |
| 2414<br><br>09Nov20<br>NoCat | 1    | **CUSTOM LAYOUT** RELOCATE LAUNDRY TO BASEMENT<br>INCLUDES LAUNDRY TUB & PLUMBING / ELECTRICAL / VENTILATION LAUNDRY<br>(DOES NOT INCLUDE FINISHED TILE, DRYWALL, ETC)                                                                                       |





Scheduled Closing Date:

Purchasers: Sheldon Francis Lawrence & Allysa Zarah Khan Property: 143

Telephone Res. / Bus: (647) 270-6888

Project: Brampton Encore - Phase 2

Decor Advisor: Yolande Somerville

Model and Elevation: 38-8 Elev.B CORELLI

Layout Changes: ☒ Yes ☐ No

Sketch Attached: ☒ Yes ☐ No

Exterior Colour Scheme:

### 1. Cabinetry

|                                         | Style and Colour            | Counter                 | Hardware             |
|-----------------------------------------|-----------------------------|-------------------------|----------------------|
| Kitchen / Breakfast                     | Siena 'Greystone'           | *Quartz: 'White Shadow' | cs1-25               |
| Laundry Room                            | n/a                         | n/a                     | n/a                  |
| Powder Room                             | n/a                         | n/a                     | n/a                  |
| Twin Bath                               | Toscana pvc 'White Crystal' | P-Lam #P-282CA          | cs1-23               |
| Master Ensuite Bathroom                 | Toscana pvc 'White Crystal' | P-Lam #P-948CA          | cs1-24               |
| Second Ensuite Bathroom (If Applicable) | Toscana pvc 'White Crystal' | P-Lam #4757-60          | cs1-10               |
| <input type="text"/>                    | <input type="text"/>        | <input type="text"/>    | <input type="text"/> |

Comment

### 2. Floor Tile

|                                         | Selection                                            |
|-----------------------------------------|------------------------------------------------------|
| Entrance Vestibule                      | *24x24" Timeless polished 'White' & B/fast & Servery |
| Main Hall                               | n/a                                                  |
| Kitchen / Breakfast                     | *24x24" Timeless polished 'White'                    |
| Laundry Room                            | n/a                                                  |
| Powder Room                             | *24x24" Timeless polished 'White'                    |
| WIP (former Laundry)                    | *24x24" Timeless polished 'White'                    |
| Master Ensuite Bathroom                 | 13x13" Costa 'White' matte                           |
| Second Ensuite Bathroom (If Applicable) | 12x12" Lily 'White' matte                            |
| Lower Landing (If Applicable)           | 13x13" New Reeds 'Brown' (ground floor foyer)        |
| Twin Bath                               | 13x13" New Reeds 'Grey'                              |

Comment

### 3. Wall Tile

|                                         | Selection                                                     | Listello/Inserts                                              | Describe             |
|-----------------------------------------|---------------------------------------------------------------|---------------------------------------------------------------|----------------------|
| M. Ens. Tub skirt/splash                | 8x10" Weave 'White'                                           | <input type="radio"/> Yes <input checked="" type="radio"/> No | <input type="text"/> |
| Master Ensuite Bathroom                 |                                                               |                                                               |                      |
| Tub Deck                                | 8x10" Weave 'White'                                           | <input type="radio"/> Yes <input checked="" type="radio"/> No | <input type="text"/> |
| Shower Stall                            | 8x10" Weave 'White'                                           | <input type="radio"/> Yes <input checked="" type="radio"/> No | <input type="text"/> |
| Bathroom Walls                          | n/a                                                           | <input type="radio"/> Yes <input checked="" type="radio"/> No | <input type="text"/> |
| Second Ensuite Bathroom (If Applicable) | 8x10" Serpentine 'Grey'                                       | <input type="radio"/> Yes <input checked="" type="radio"/> No | <input type="text"/> |
| Twin Bath                               | 8x10" Splendour 'White'                                       | <input type="radio"/> Yes <input checked="" type="radio"/> No | <input type="text"/> |
| Kitchen Backsplash                      | <input type="radio"/> Yes <input checked="" type="radio"/> No | Backsplash Behind Fridge                                      | <input type="text"/> |

Comment

S.L.

A.K.

\*\*\* NOTE: This is not an approved document. Document must be locked \*\*\*

Scheduled Closing Date:

Purchasers: Sheldon Francis Lawrence &amp; Allysa Zarah Khan Property: 143

Telephone Res. / Bus: (647) 270-6888

Project: Brampton Encore - Phase 2

Decor Advisor: Yolande Somerville

Model and Elevation: 38-8 Elev.B CORELLI

## 4. Plumbing Fixtures

|                                                  |                                               |                          |                |                          |
|--------------------------------------------------|-----------------------------------------------|--------------------------|----------------|--------------------------|
| <input type="checkbox"/>                         | Second Ensuite                                | <input type="checkbox"/> | Powder Room    | <input type="checkbox"/> |
| Master Ensuite Bathroom <input type="checkbox"/> | Other Room - Specify <input type="checkbox"/> | <input type="checkbox"/> | Other Washroom | <input type="checkbox"/> |

Comment

Standard Thru out

## 5. Hardwood Flooring

|                                  | Type and Stain                      |                      | Type and Stain                      |
|----------------------------------|-------------------------------------|----------------------|-------------------------------------|
| Main Hall                        | 3/4x4-3/8" rd oak smooth 'Graphite' | Upper Landing        | 3/4x4-3/8" rd oak smooth 'Graphite' |
| Kitchen / Breakfast              | n/a                                 | Upper Hall           | n/a                                 |
| Living Room                      | 3/4x4-3/8" rd oak smooth 'Graphite' | Master Bedroom       | n/a                                 |
| Dining Room                      | 3/4x4-3/8" rd oak smooth 'Graphite' | Bedroom #2           | n/a                                 |
| Family Room                      | 3/4x4-3/8" rd oak smooth 'Graphite' | Bedroom #3           | n/a                                 |
| Den/Library                      | 3/4x4-3/8" rd oak smooth 'Graphite' | Bedroom #4           | n/a                                 |
| Entrance Vestibule               | n/a                                 | Bedroom #5           | n/a                                 |
| Lower Landing<br>(If Applicable) | 3/4x4-3/8" rd oak smooth 'Graphite' | Other Room - Specify |                                     |

Comment

## 6. Carpeting

|              | Upgrade                  | Description                     |
|--------------|--------------------------|---------------------------------|
| Ground Floor | <input type="checkbox"/> | Standard 4002-21 with std u/pad |
| Second Floor | <input type="checkbox"/> | Standard 4002-21 with std u/pad |
|              | <input type="checkbox"/> |                                 |

|                  |        |                   |
|------------------|--------|-------------------|
| Upgrade Underpad | Type   | Area              |
|                  |        |                   |
| Carpet on Stairs | Capped | Runner - *Upgrade |
|                  |        |                   |

Comment

## 7. Fireplace

|                | Living Room           |                       |                                  | Family Room           |                                  |                       | Other Room - Specify  |                       |                                  |
|----------------|-----------------------|-----------------------|----------------------------------|-----------------------|----------------------------------|-----------------------|-----------------------|-----------------------|----------------------------------|
|                | Purchased             | As Per Plan           | N/A                              | Purchased             | As Per Plan                      | N/A                   | Purchased             | As Per Plan           | N/A                              |
| Fireplace Type | <input type="radio"/> | <input type="radio"/> | <input checked="" type="radio"/> | <input type="radio"/> | <input checked="" type="radio"/> | <input type="radio"/> | <input type="radio"/> | <input type="radio"/> | <input checked="" type="radio"/> |
| Mantle Type    |                       |                       |                                  | Standard Gas          |                                  |                       |                       |                       |                                  |
| Colour / Stain |                       |                       |                                  | NF-20                 |                                  |                       |                       |                       |                                  |
| Surround       |                       |                       |                                  | White                 |                                  |                       |                       |                       |                                  |
| Hearth         |                       |                       |                                  | Grigio Carnico        |                                  |                       |                       |                       |                                  |
|                |                       |                       |                                  | none                  |                                  |                       |                       |                       |                                  |

Comment

S.L

A.K

Scheduled Closing Date:

Purchasers: Sheldon Francis Lawrence & Allysa Zarah Khan Property: 143

Telephone Res. / Bus: (647) 270-6888

Project: Brampton Encore - Phase 2

Decor Advisor: Yolande Somerville

Model and Elevation: 38-8 Elev.B CORELLI

### 8. Trim Carpentry

Interior Doors  Front Door Glass Inserts  Door Handles   
 Interior Trim

Comment

### 9. Plaster Mouldings and Medallions

Standard Throughout ☐ Yes ☐ No ☒ N/A

|                    |                      |                      |                      |                      |                      |
|--------------------|----------------------|----------------------|----------------------|----------------------|----------------------|
| Entrance Vestibule | <input type="text"/> | <input type="text"/> | Kitchen/Breakfast    | <input type="text"/> | <input type="text"/> |
| Main Hall          | <input type="text"/> | <input type="text"/> | Den/Library          | <input type="text"/> | <input type="text"/> |
| Living Room        | <input type="text"/> | <input type="text"/> | Lower Landing        | <input type="text"/> | <input type="text"/> |
| Dining Room        | <input type="text"/> | <input type="text"/> | Other Room - Specify | <input type="text"/> | <input type="text"/> |
| Family Room        | <input type="text"/> | <input type="text"/> |                      | <input type="text"/> | <input type="text"/> |

Comment

### 10. Railings and Spindles

Railing Package   
 Railing Colour   
 Stringer / Riser   
 Spindle Colour   
 Treads   
 Oak Stairs ☒ Yes ☐ No ☐ N/A

Comment

### 11. Wall Paint / Ceilings

Throughout Finished Areas

Trim Paint

Smooth Ceilings

Ground Floor ☐

Second Floor ☐

Note

Comment

S.L.

A.K.

Scheduled Closing Date:

Purchasers: Sheldon Francis Lawrence & Allysa Zarah Khan Property: 143

Telephone Res. / Bus: (647) 270-6888

Project: Brampton Encore - Phase 2

Decor Advisor: Yolande Somerville

Model and Elevation: 38-8 Elev.B CORELLI

**12. Electrical**

Hood Fan ☐ White ☒ Stainless ☐ N/A

Above Kitchen Cabinet Light ☐ Yes ☒ No

Below Kitchen Cabinet Light ☐ Yes ☒ No

Standard Appliances ☒

Over The Range Microwave ☐

Chimney Style Fan ☐

Comment

**13. Heating and Air Conditioning**

Air Conditioning

Gas Provisions Stove

Gas Provisions Dryer

Gas Provisions Barbecue

Comment

**14. Additional Comments**

**15. Disclaimers and Notes**

- 1) Colours of all materials are as close as possible to builder's selection, but not necessarily identical due to variances in manufacturing.
- 2) Any extras listed above are null and void unless accompanied by a separate invoice/amendment. Said invoice must be paid in full.
- 3) The Purchaser acknowledges that after Interior Colour Selection form is signed and dated, no further changes will be permitted other than re-selection due to unavailability. \_\_\_\_\_ Purchaser's Initials
- 4) The Purchaser acknowledges reading and accepting the "Gold Park Homes Decor Centre Disclaimers" form. This document contains other miscellaneous disclaimers.

This Interior Colour Selection is final and approved by:

Signature:  Date:

**encore**  
BRAMPTON

BE2-143

S.L

A.K

Sept. 24, 2020

# The Corelli 38' SERIES

Elevation A • 3,878 sq.ft. | Elevation B • 3,878 sq.ft.



Smooth  
Ceilings

10' MAIN  
96" DOORS +  
ARCHES

GAS + ELECT →

RELOCATE  
DOOR →  
(LAUNDRY to  
BASEMENT).

CENTER  
LIGHT TO →  
ROOM

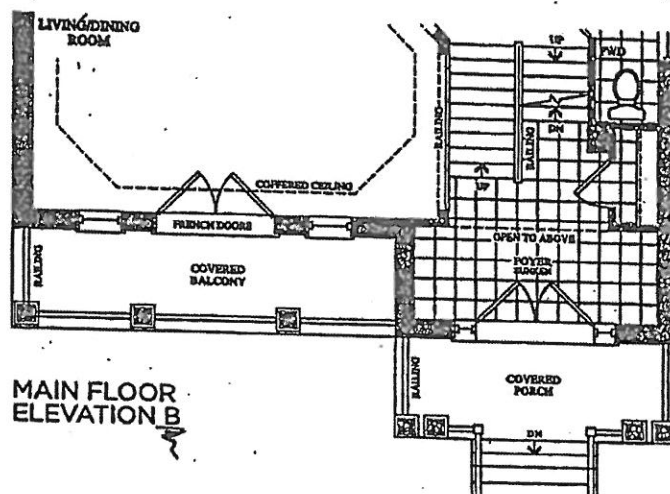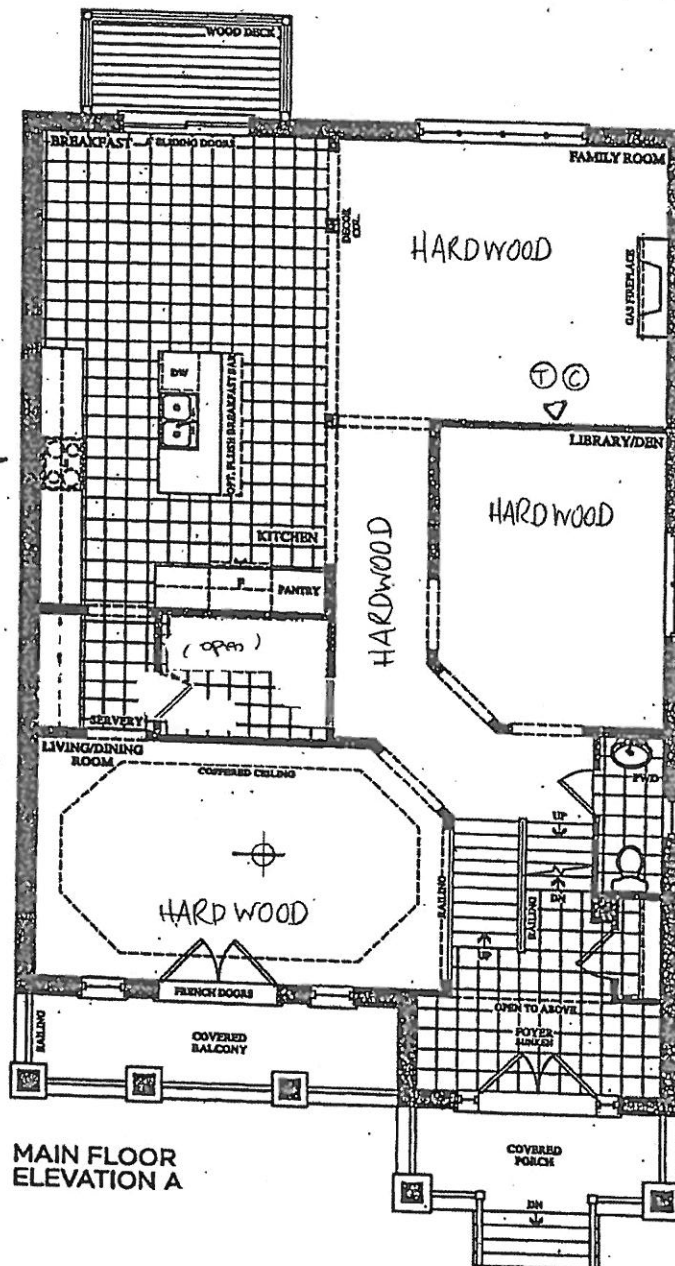

Prices, figures, illustrations, sizes, features and finishes are subject to change without notice. E.&O.E. Areas and dimensions are approximate and actual usable floor space may vary from the stated area. Layout may be reverse of the unit purchased. E. & O.E.

**GOLDPARK**  
HOMES

**encore**  
BRAMPTON

BE2-143



Sept. 24 2020

S.L

A.K

# The Corelli 38' SERIES

Elevation A • 3,878 sq.ft. | Elevation B • 3,878 sq.ft.

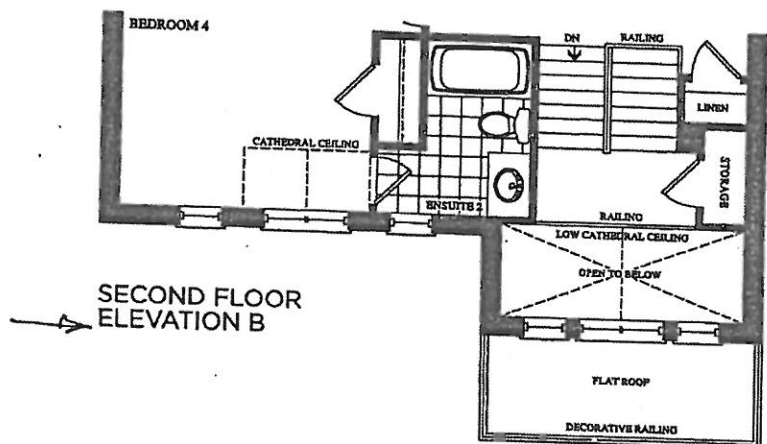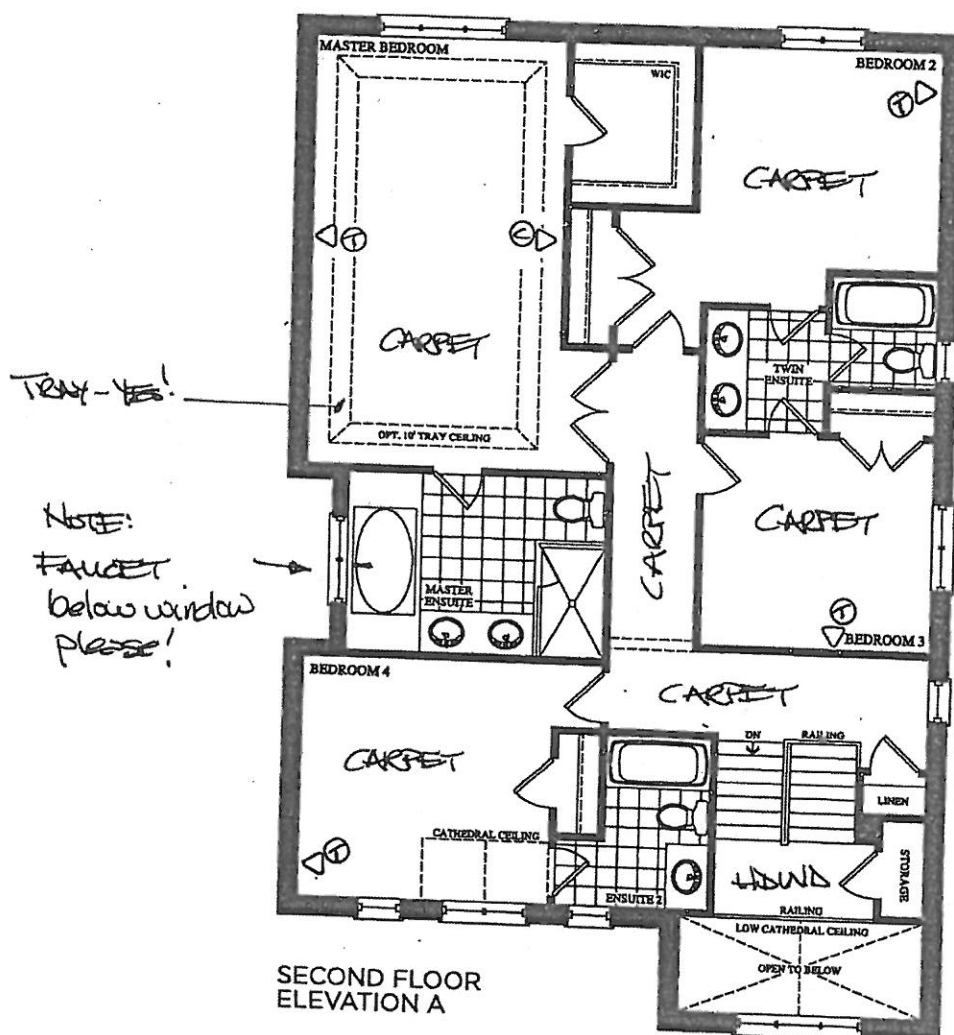

Prices, figures, illustrations, sizes, features and finishes are subject to change without notice. E.&O.E. Areas and dimensions are approximate and actual usable floor space may vary from the stated area. Layout may be reverse of the unit purchased. E. & O.E.

**GOLDPARK**  
HOMES

**encore**  
BRAMPTON


2-143  
Sept 24. 2020

S.L.

A.K.

The  
**Corelli**  
38' SERIES

Elevation A • 3,878 sq.ft. | Elevation B • 3,878 sq.ft.

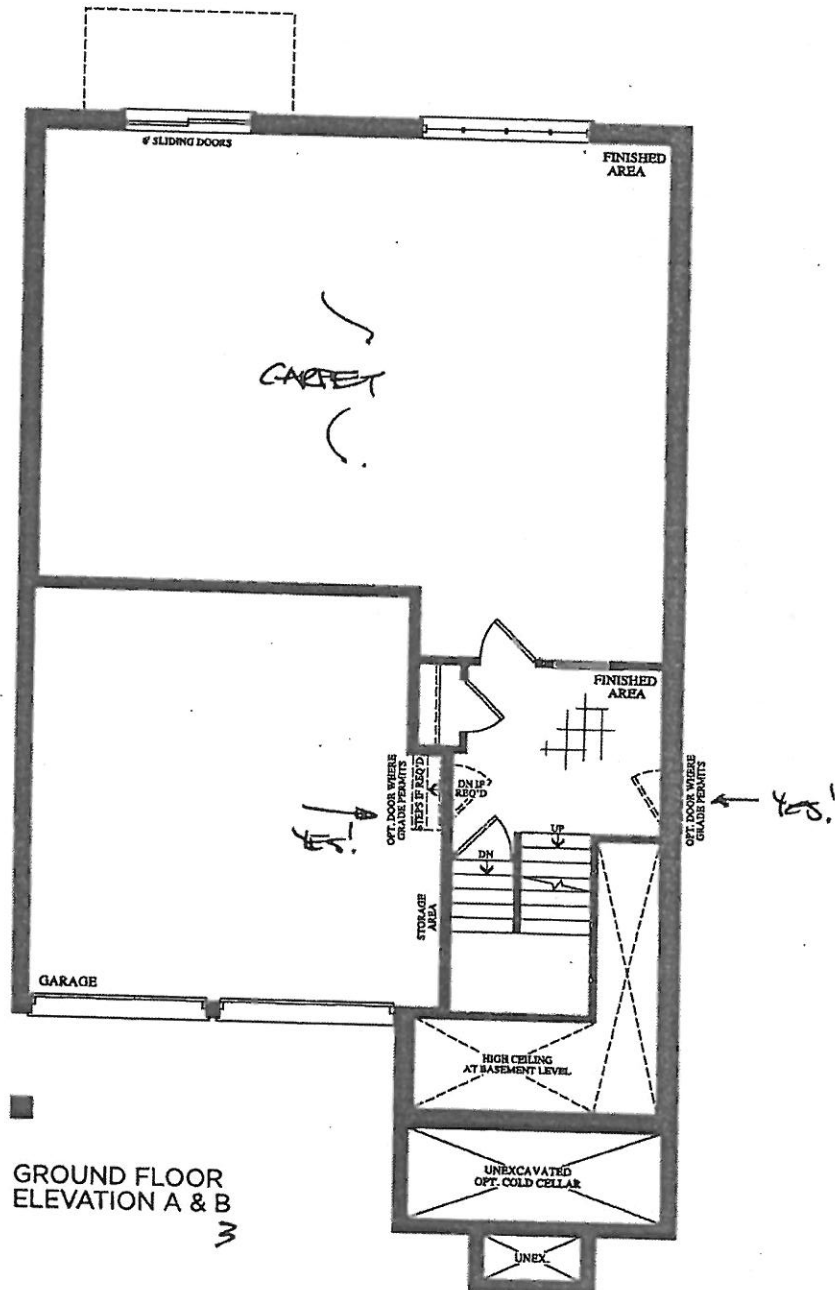

Prices, figures, illustrations, sizes, features and finishes are subject to change without notice. E.&O.E. Areas and dimensions are approximate and actual usable floor space may vary from the stated area. Layout may be reverse of the unit purchased. E. & O.E.


**GOLDPARK**  
HOMES

**encore**  
BRAMPTON

BE2-143  
Sept. 24, 2020  
S.L.  
A.K.

**The Corelli**  
**38' SERIES**

Elevation A • 3,878 sq.ft. | Elevation B • 3,878 sq.ft.

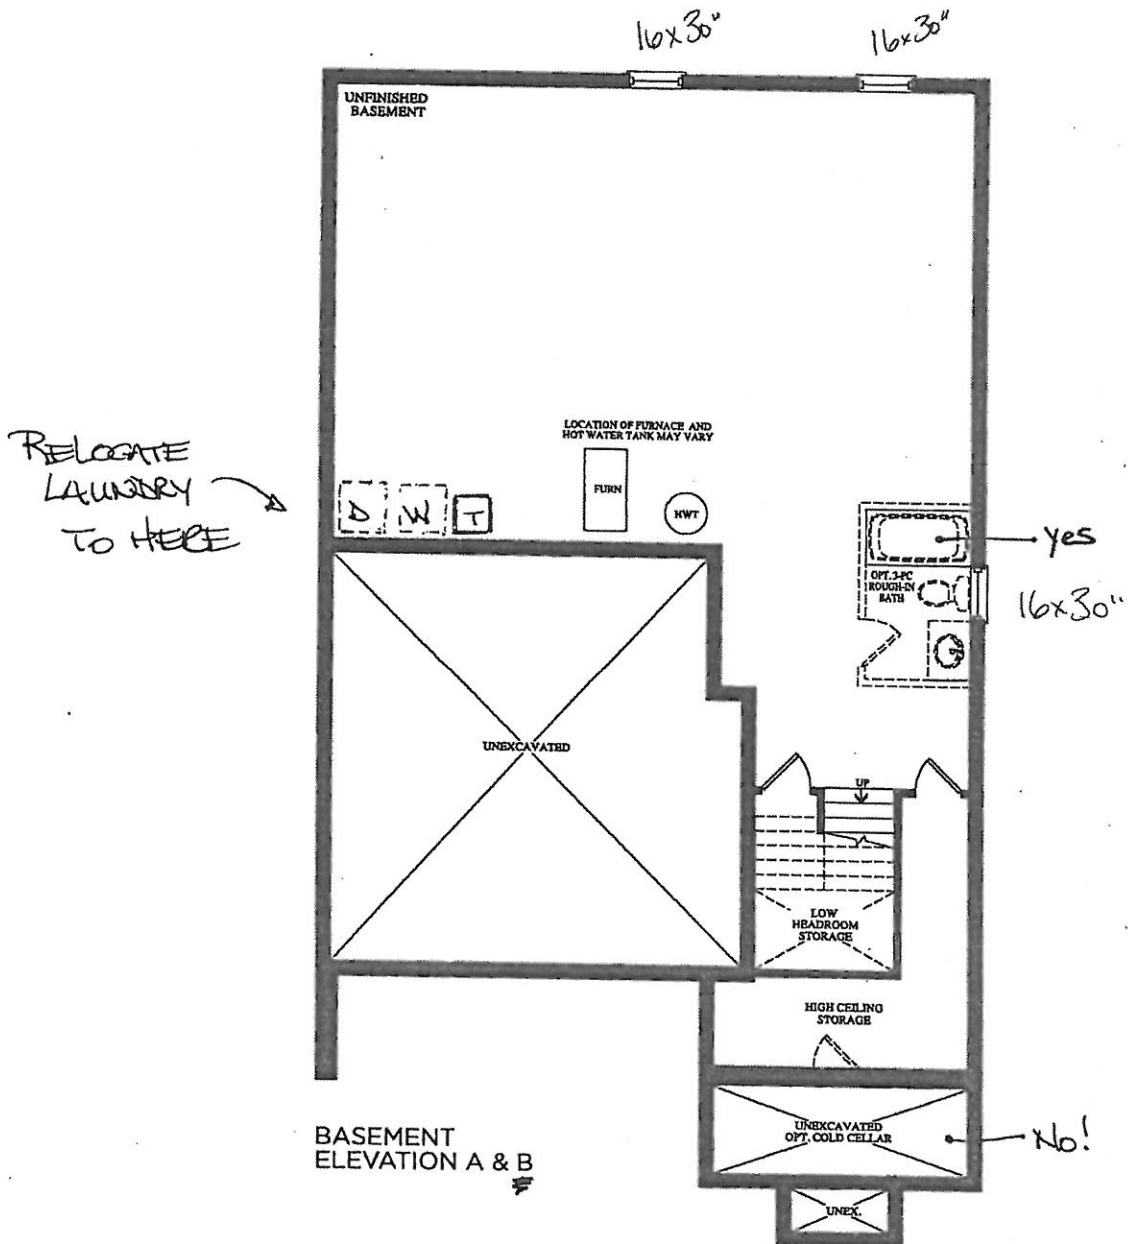

Prices, figures, illustrations, sizes, features and finishes are subject to change without notice. E.&O.E. Areas and dimensions are approximate and actual usable floor space may vary from the stated area. Layout may be reverse of the unit purchased. E. & O.E.

**GOLDPARK**  
HOMES

BE2 143

Sept 24 2020

S.L


A.K

**QUOTATION**

Date: 06/23/16

|                             |                         |             |
|-----------------------------|-------------------------|-------------|
| Trade Name: Gold Park Homes | Site location: Brampton | Model: 38-8 |
| Address:                    | Project: Encore         | Phase:      |

This layout has been explained to the purchaser by Cortina Kitchens Inc. and is understood by the purchaser.

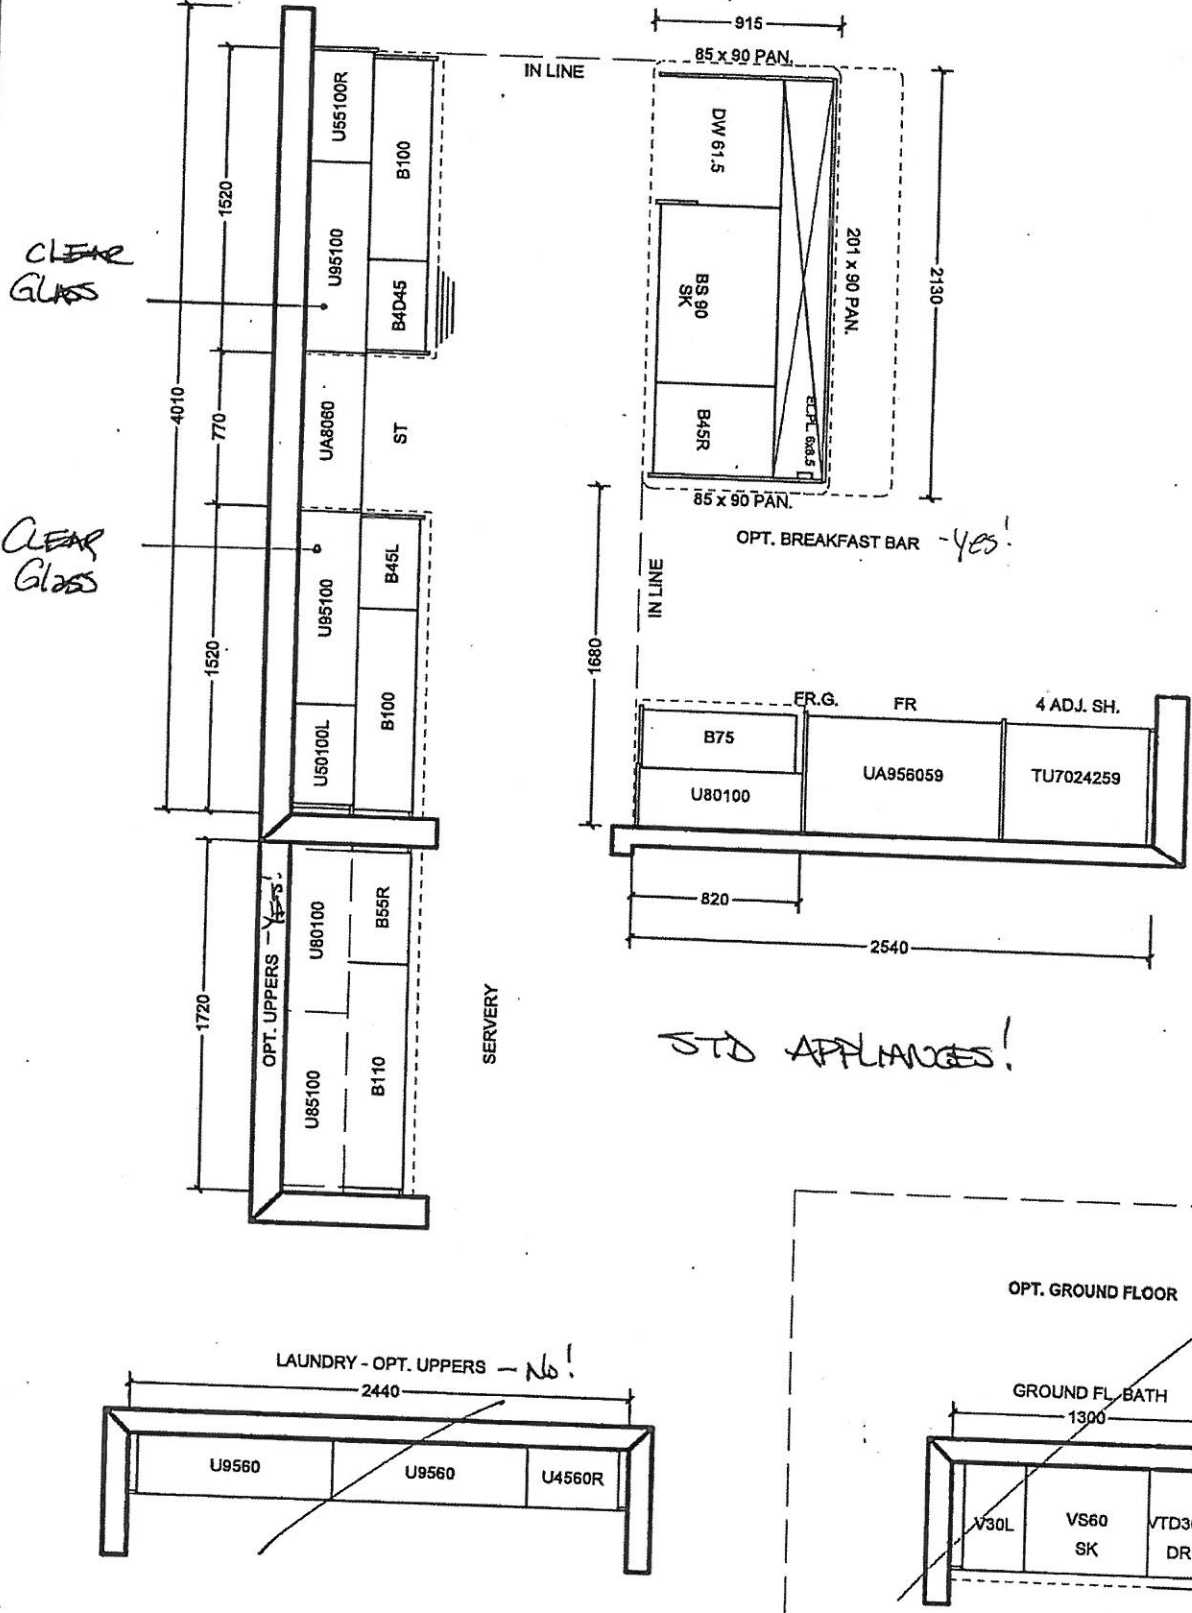

All prices subject to confirmation from head office.  
This quotation is subject to the terms & conditions set out  
in Cortina's Agreement of Purchase and Sale

ACCEPTED DATE: \_\_\_\_\_

All agreements are contingent upon strikes, accidents, and delay beyond our control.  
Please provide our installer with template for sinkholes or \$150.00 will be charged for callback.

CUSTOMER SIGNATURE \_\_\_\_\_ SALESPERSON SIGNATURE \_\_\_\_\_ CORTINA HEAD OFFICE APPROVAL \_\_\_\_\_

ITEM A. Wood grain and colour are characteristics of the product, we cannot guarantee that such grain and colour will always match  
ITEM B. Cortina Kitchens reserves the right to alter dimensions and make technical changes without notice.

BE2-43  
Sept 24 2020

S.L.




A.K.

**QUOTATION**





Date: 06/23/16

|                             |                         |             |
|-----------------------------|-------------------------|-------------|
| Trade Name: Gold Park Homes | Site location: Brampton | Model: 38-8 |
| Address:                    | Project: Encore         | Phase:      |

This layout has been explained to the purchaser by Cortina Kitchens Inc. and is understood by the purchaser.

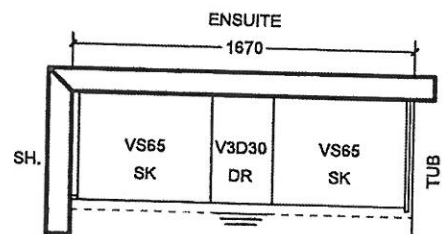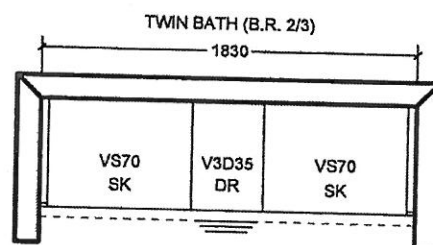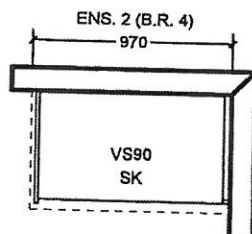

~~OPT. 5 B.R. SECOND FLOOR~~

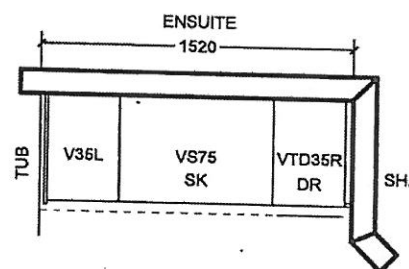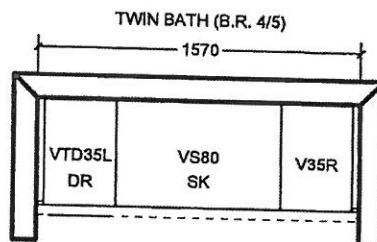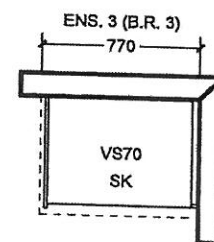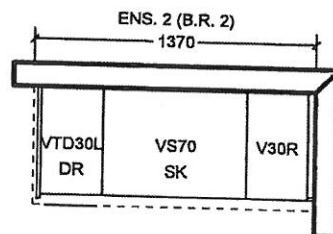

All prices subject to confirmation from head office.  
This quotation is subject to the terms & conditions set out  
in Cortina's Agreement of Purchase and Sale

All agreements are contingent upon strikes, accidents, and delay beyond our control.  
Please provide our Installer with template for sinkholes or \$150.00 will be charged for callback.

ACCEPTED DATE: \_\_\_\_\_

\_\_\_\_\_  
CUSTOMER SIGNATURE

\_\_\_\_\_  
SALESPERSON SIGNATURE

\_\_\_\_\_  
CORTINA HEAD OFFICE APPROVAL

ITEM A. Wood grain and colour are characteristics of the product, we cannot guarantee that such grain and colour will always match  
ITEM B. Cortina Kitchens reserves the right to alter dimensions and make technical changes without notice.

**GOLDPARK**  
HOMES



Granite, Marble,  
Engineered Surfaces


- Standard 2CM & 3CM
- ◐ Upgrade 1.2CM & 3CM
- ◑ Upgrade 1.4 CM
- Upgrade 2

**20mm (3/4") Profiles**


*Kitchen* →



**30mm (1 1/4") Profiles**

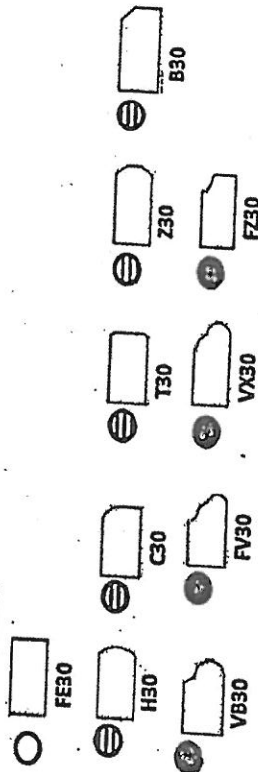

**40mm (1 1/2") Profiles**

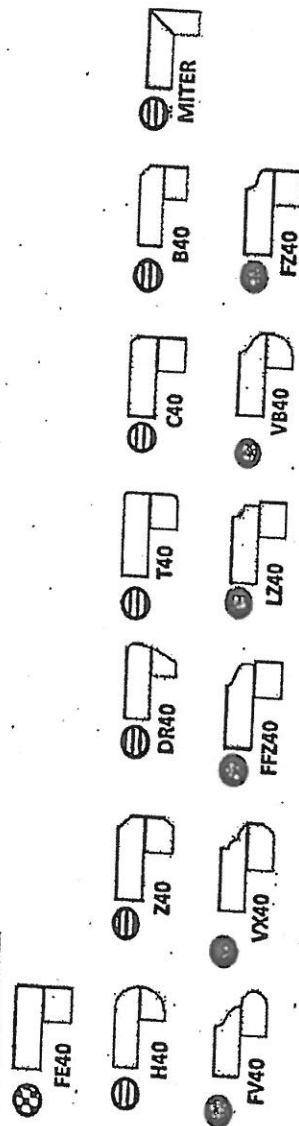

Note: All colours may not be available in 30mm at time ordered. Vendor reserves the right to use 40 mm edges (by lamination process).

\*Mitre edge is available in Upgrade 1 for an overall thickness of 2". All other Mitre edge options will be an Upgrade 2 Edge.

BE2-143  
Sept. 24 2026

S.L. A.K.

143  
Sept. 24 2020

S.L


A.K

MODIFIED: 19/05/18 H

STANDARD HARDWARE



CSI-6

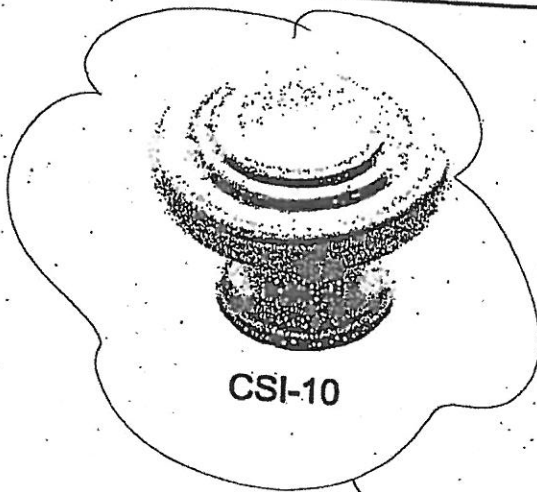


CSI-10


Ensuite 2




CSI-14

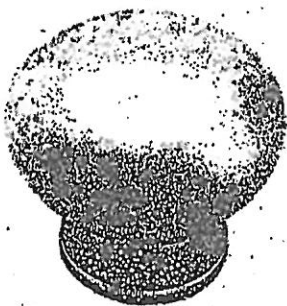


CSI-16

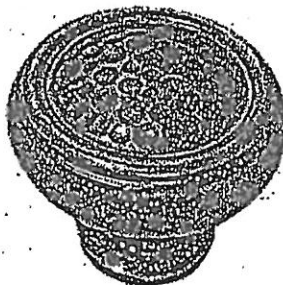

CSI-18

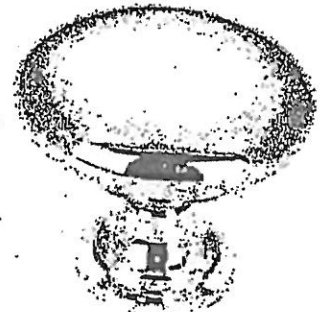

CSI-19

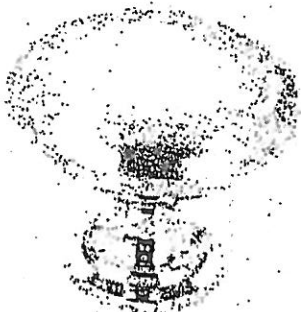

CSI-20




CSI-21




CSI-22

Twin Bath


Master Ensuite

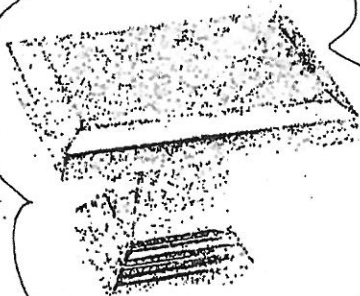

CSI-23

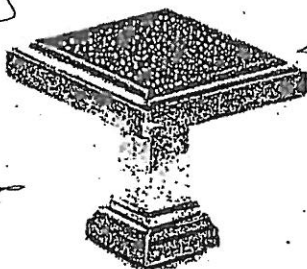

CSI-24

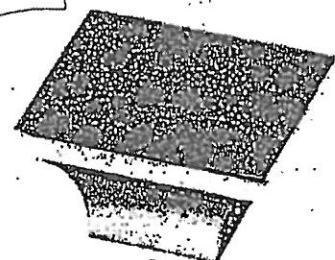

CSI-25

Kitchen

\*NOTES:

- IMAGES ARE FOR QUICK REFERENCE PURPOSES ONLY
- ACTUAL SIZES AND FINISHES AS PER HARDWARE
- SAMPLE BOARD PROVIDED TO DECOR CENTRE



**BATHROOM ACCESSORIES**

PROJECT: ENCORE 2

LOT: 143

*\*Please select one:*

INSTALL STANDARD BATHROOM ACCESSORIES  
THRU OUT (TOWEL BAR, SOAP DISH, TISSUE  
HOLDER) \*\*location as per vendors discretion

☒

**DO \*NOT\*** INSTALL STANDARD BATHROOM  
ACCESSORIES THRU OUT (TOWEL BAR, SOAP  
DISH, TISSUE HOLDER)

☐

SIGNATURE: Sheldon Lawrence

SIGNATURE: Allysa Khan

DATE: Sept 24 2020

## Gold Park Homes Décor

## Centre Disclaimers

**GOLDPARK**  
WORTH MORE

*Through years of doing business, we at Gold Park Homes have encountered issues beyond our control. The following disclaimers apply to all instances of Purchaser's Extras forms and all Interior Colour Scheme forms.*

### **FIREPLACES**

Fireplace Marble: Due to the many variables that can affect the pattern and/or design, frequently the marble installed on the fireplace will not be identical to the samples. We will make every attempt to come as close to the samples as possible, but cannot be responsible for results which differ from the samples.

### **CERAMIC FLOOR TILE**

Many variables including variegation can affect tile colour, pattern and/or design which mean installed tiles may not be identical to the samples. We will make every attempt to come as close as possible, but cannot be responsible for results which differ from the samples.

### **HARDWOOD FLOORING**

The purchaser is advised that cupping and shrinkage are characteristics of hardwood flooring normally appearing after installation, especially when humidity levels are not regulated, and no warranty is provided by the flooring supplier with respect to such cupping and shrinkage. Furthermore, hardwood floors may also heave and warp when located at or close to entrance points of the home, where rain could make its way to the flooring. The vendor agrees to install any hardwood flooring ordered by the purchaser in a good and workmanlike manner, but shall not be responsible for, and is hereby released by the purchaser from responsibility and liability for cupping, shrinkage, heaving and warping of hardwood flooring in the above mentioned circumstances.

### **STAIRCASE VS FLOORING WOOD SPECIES DIFFERENCE**

The purchaser is aware and therefore accepts and acknowledges that the wood species of the staircase and flooring chosen do not match. This difference might result in an undesirable colour variance.

The purchaser is aware and therefore accepts and acknowledges that though the flooring is of the same species as the staircase the difference in product finishing may result in a stain colour variance.

The purchaser agrees that the vendor is to be exempt from any and all claims by the purchaser regarding this colour variance.

### **RAILINGS**

All railings, pickets, posts, nosing's and stairs come from solid wood and veneered wood materials sourced from multiple locations and sources. As such there will be variations in grains and shades between the various natural components beyond our control. Due to this variance in material, all components will stain with colour or natural finish differently.

Iron pickets are wrought in nature and depending on the manufacturing process will have differences from picket to picket which is normal. Also the finish of the iron pickets is of a powder coated nature. This process can produce minor colour variations or tones. Furthermore, the assembly of the metal pickets can develop a natural rattle over time from vibration in the railing. Minor rattling is normal and is a part of the wrought iron picket assembly.

### **HOUSE EXTERIORS**

Variations in subcontractors across different sites and varying site conditions may result in house exteriors that differ from the artist renderings. We cannot be responsible for results which differ from the artists renderings of elevations.

### **PLASTER MOULDINGS AND MEDALLIONS**

Plaster mouldings will not be installed in open to above areas or areas with 2 storey elements.

### **STAIN COLOURS**

Due to the many variables that can affect the outcome of a stain colour on wood, staircases, railings, and fireplaces, the colour may not be identical to samples. Factors such as density, age, humidity, air temperature, and the uniqueness of each piece of wood can result in wide variations in darkness or lightness. We will make every attempt to come as close to the sample as possible, but cannot be responsible for results which differ from the samples.

Stain on pre-finished hardwood floors will not be an exact match to the stain colours available on stairs, pickets and rails. The purchaser is responsible for choosing the stain on these areas to their satisfaction.

### **IN-WALL CONDUIT FOR AUDIO/VIDEO CABLES**

It is important to note that due to the variation in framing requirements in different parts of your home, conduit lengths and routing can vary. In virtually all instances of ground floor installation (i.e. above a fireplace), conduit will first travel down into the basement below the floor joists, over to the termination point and back up into the main floor. As a result, it is best to measure the length of the conduit after occupancy with a "pull wire" before

S.L

A.K

purchasing your cables. For above-fireplace installations, the conduit wall plate will be installed approximately 10" above the Fireplace Mantle, unless otherwise specified in the Construction Summary.

#### APPLIANCE SPECIFICATIONS

All appliance openings are set to builder's standard openings. Please advise Décor Centre at time of your structural appointment if custom sizing of cabinets is required for any built-in appliances. The purchaser is responsible for costs and fees associated with changes to pre-manufactured kitchens made subsequent to colour appointments.

Purchaser accepts & acknowledges that in order to accommodate upgraded appliances, all appliance specifications should be provided at the time of their structural appointment, should this not occur they must be provided to the Décor Center within one (1) week of completion of structural chart. Failure to do so may result in the need to revert to the standard appliance openings or in a delay in construction of your dwelling, as well as a cost of \$500 to re-open your structural file should changes be required. As a result we may be forced to extend the closing of your transaction. Due to failure to complete the above-mentioned selections and at no fault of our own, we reserve our right to hold you responsible for this delayed closing, including charging extra administration cost and interest on the balance due on closing.

→ Purchasers Accept Standard Appliance Openings (unless otherwise specified):  
→ Fridge - 37-1/2" W x 73-1/2" High Approx.  
→ Range - 30-1/2" D x 31-1/2" W Approx.  
→ Dishwasher - 24" W Approx.

#### DELETION OF HOODFAN & CABINETS ABOVE STOVE:

The purchasers are aware that in requesting NOT TO INSTALL builder's standard hood fan and standard cabinets above stove they will receive NO STANDARD HOOD FAN and NO CREDIT. Purchasers are installing their own hood fan after closing and accept that it may waive any warranty associated with such a change.

Purchasers accept and acknowledge that the exhaust fan duct hole may be off-centered with the stove in the kitchen due to purchasers installing their own hood fan after closing. The vendor is exempt from adjusting such openings for the purchasers range hood.

#### ELECTRICAL FOR APPLIANCES

Pricing is subject to change based on the appliance specifications provided. Purchasers should provide proper appliance specifications and cut-out sheets in order for Gold Park to price extras accordingly.

#### KITCHEN CABINETS

The kitchen you order/purchase will undoubtedly contain slight colour variations. The degree of these variations is virtually impossible to determine before the kitchen is installed in its intended location. The amount of and type of lighting will also affect various highlights in the finish. Note: No two pieces of wood are identical. Variations in colour tone and grain patterns make a perfect colour match virtually impossible. It is generally agreed that these variations add to the natural beauty of a wood kitchen.

#### STAIN

Charcoal is a spray stain applied to Oak and Maple products with several characteristics that are important to be aware of when purchasing this product.

1. Shadow lines may be visible at the interior profile edges of a door or drawer front. If movement occurs shadow lines may increase or decrease, depending on the style and/or size of a door or drawer front.
2. Variation and unevenness may be visible in the finish.
3. Hairline cracks at the joints are created over time due to the nature of natural wood, caused by usage, humidity\*\*, or dryness. They tend to be more visible to darker stains, than lighter wood stains.

\*\* Relative humidity is recommended to be between 45% and 55%. Please refer to Cortina Kitchens "Cleaning, Care, Maintenance, & Warranty Information" guide.

Please be advised that Cortina Kitchens will not replace doors and/or parts that exhibit the above characteristics associated with this finish. These characteristics are not avoidable and are a result of the natural characteristics of wood and wood veneer, and the characteristics of darker stains on wood. The Charcoal stain is not available on doors in Group IV, Group IVA, Group V and Group VA.

Cortina Kitchens offers a wide variety of finishes, applied to oak and maple products. The subject finishes include the spray stains Cocoa, Espresso, Graphite as well as wiping stain Ebony.

Due to the very dark stains applied on natural maple and oak doors and joints, several characteristics are important to be noted when purchasing these products.

1. Shadow lines may be visible at the interior profile edges of a door or drawer front. If movement occurs shadow lines may increase or decrease, depending on the style and/or size of a door or drawer front.
2. Variation and unevenness may be visible in the finish.
3. Hairline cracks at the joints are created over time due to the nature of natural wood, caused by usage, humidity, or dryness. They tend to be more visible to darker stains, than lighter wood stains.

Please be advised that Cortina Kitchens will not replace doors nor parts that exhibit the above characteristics associated with this finish. These characteristics are not avoidable and are a result of the natural characteristics of wood and wood veneer, and the characteristics of darker stains on wood.

S.L

A.K

### CABINETRY DOOR HARDWARE

Cortina Kitchens' cabinetry doors and drawer fronts will be drilled to accept a standard knob or handle selected from Cortina's hardware boards. This drilling comes standard with the order, and is done ONLY in our shop, not on the job site.

For those not wanting Cortina's hardware drilling, the following applies:

No holes to be drilled on the doors and drawer fronts should be specified in writing on the colour chart and the P.O. If while in production, Cortina Kitchens misses this request, Cortina Kitchens and the Builder will not be held responsible to replace any or all doors and drawer fronts affected, and the customer agrees to accept the product as is. No hardware will be supplied or credited by Cortina Kitchens with this request. No charge will apply for this request.

### PVC DOORS

All cabinets with PVC (Thermofoil) Doors come with melamine gables, panels and kick. The doors, crown moulding and light valance are PVC wrapped. Open shelves incorporated in design will only be available with melamine interiors. There will be variations in colour shades between the PVC parts (doors, crown and Light valance) and the melamine parts (open shelves, Gables, Panels and Kick) due to the difference in material.

Furring Panel with crown moulding to the ceiling is not available on all PVC door styles due to subtle variations in colour shades between the PVC parts (moulding) and the melamine parts (furring panel) due to the difference in material. Grain directions in wood grain pattern melamine, vary between the furring panel, crown moulding (horizontal) and the PVC doors (vertical).

### GRANITE, MARBLE ENGINEERED SURFACES WAIVER

Granite and marble are naturally occurring products, and due to the many variables that can affect the pattern, colour and/or design and "pitting" of natural products slabs installed will not be identical to the samples displayed. We will make every attempt to come as close to the samples as possible, but cannot be responsible for results which differ from the samples. Every effort is made to provide granite counter tops as close as possible but the vendor is not responsible for results which differ from the sample displayed. All countertop surfaces may have seams & product pattern & shade can change in areas containing seams.

### RESELECTIONS

It is not uncommon for flooring, such as tile, to become discontinued prior to its installation. Therefore it may be necessary to make a reselection of certain materials sometime during the build process. We cannot assure you that another choice approximating your selection will be available.

### PLANS

Plans are subject to change without notice. Actual usable floor space may vary from the stated floor area. Layout for kitchen, furnace, HWT and laundry tub may vary from plan. Vertical and horizontal bulkhead, which are not shown on plan, may be required for plumbing and heating runs, E. & O.B.

### PLEASE NOTE:

In the event the work on the house has progressed beyond the point where the items covered by these invoices cannot be installed without entailing any unusual expense, then this order is to be cancelled and any deposit paid in connection with the same is to be refunded to the purchaser. The vendor will undertake to incorporate the work covered by the sales extra in the construction of the house but will not be liable to the purchaser in any way, if for any reason the work covered by the extra is not carried out. In that event, any monies paid in connection with the same shall be returned to the purchaser. It is understood and agreed that if for any reason whatsoever the transaction of Purchase and Sale is not completed, the total cost of extras ordered are not refundable to the Purchaser(s). Extras or changes will not be processed unless signed by the Vendor. These extras may not be amended without the written consent of Gold Park Homes. The purchaser(s) and the builder acknowledge and agree that this "Purchaser's Extra" form shall not be deemed to be part of the agreement of purchase and sale entered into between them, nor an addendum thereto. No postdated cheques will be accepted. No estimates or orders will be accepted once construction has commenced. Should a refund be requested on any extras purchased, an 80% reimbursement of the purchase price will be given. (a \$50.00 minimum charge and a maximum \$250.00 charge will apply). Estimates will only be considered when resubmitted on a signed Purchaser Extras form, accompanied by payment in full.

All prices are estimates only and may be subject to change. Should a change in price occur Gold Park Homes reserves the right to request from the purchaser an adjustment of the price or a refund limited to that item.

Purchasers are aware & accept that ANY changes made to upgrades after signing the Purchasers Extra Form are subject to a minimum administration fee of \$500. PLUS a 10% holdback fee.

Purchasers are aware that any request to add a percentage of upgrades from the purchaser's extras form will be processed only after the builder receives approval letter from the bank.

S.L

A.K

Please be advised that your failure to finalize your structural or colour selections may result in a delay in construction of your dwelling and we may have to extend closing of your transaction. Due to failure to complete the above-mentioned selections and at no fault of us, we reserve our right to hold you responsible for a delayed closing, including charging extra administration cost and interest on the balance due on closing.

Purchaser has attended a Colour appointment at the Decor Centre & has DECLINED any additional upgrades and accepts and acknowledges that there will be no further structural changes/additions/deletions to be made upon signing.

I hereby acknowledge reading and understanding the above copy and will not hold Gold Park Homes responsible for any issues in relation to above.

Purchaser's Signatures

S.L

A.K

Date Sept 24 2020

BE2-143