

DRYWALL

Invoice	Qty.	Description
2306 28Oct20 NoCat	1	.GREAT ROOM - OPT. COFFERED CEILING - AS PER PLAN
2306 28Oct20 NoCat	1	.LIVING ROOM - OPT. COFFERED CEILING - AS PER PLAN
2306 28Oct20 NoCat	1	.MASTER BEDROOM - OPT. SITTING AREA 10 FOOT TRAY CEILING - AS PER PLAN
2306 28Oct20 NoCat	6	MAIN FLOOR: UPGRADE TO 9' SOLID CORE DOOR
2306 28Oct20 NoCat	24	.2ND FLOOR: INCREASE HEIGHT OF DOOR TO 8FT SECOND FLOOR - PER DOOR

FRAMING

Invoice	Qty.	Description
2445 20Oct20 NoCat	1	MASTER ENSUITE: LINEAR SHOWER FLOOR DRAIN - Infinity Drain FXTIF 6548 48" SB
2306 72,542 28Oct20	1	.GREAT ROOM - OPT. COFFERED CEILING - AS PER PLAN
2306 72,546 28Oct20	1	.LIVING ROOM - OPT. COFFERED CEILING - AS PER PLAN
2306 72,552 28Oct20	1	.MASTER BEDROOM - OPT. SITTING AREA 10 FOOT TRAY CEILING - AS PER PLAN
2306 28Oct20 NoCat	6	MAIN FLOOR: UPGRADE TO 9' SOLID CORE DOOR
2306 28Oct20 NoCat	1	.***CUSTOM LAYOUT*** DELETE WALL AND DOOR AT M. WIC. SEE PLAN
2306 72,637 28Oct20	1	MASTER WIC: SUN TUNNEL EXTENSION, 6 FOOT RIGID TUNNEL EXTENSION [2TR 6 FOOT] - UP TO 6 FOOT MAX.
2306 72,671 28Oct20	1	MASTER ENSUITE: SHOWER BENCH COMPLETE WITH STANDARD TILE AND MATCHING MARBLE JAMB COLOUR SEAT TOP
2306 72,631 28Oct20	1	.MASTER ENSUITE: SHOWER NICHE [SHAMPOO SHELF] - COMPLETE WITH MATCHING MARBLE JAMBS ON 4 SIDES, STANDARD TILE, APPROX. 12 X 18 INSTALLED VERTICALLY - SEE PLAN FOR PREFERRED LOCATION
2306 28Oct20 NoCat	24	.2ND FLOOR: INCREASE HEIGHT OF DOOR TO 8FT SECOND FLOOR - PER DOOR
2306 28Oct20 NoCat	1	.GREAT ROOM: UPGRADE MAIN FLOOR LINEAR 1 SIDED FIREPLACE - JADE SERIES 42" LINEAR DIRECT VENT GAS FIREPLACE, INCLUDES ELECTRICAL NOT INCLUSIVE OF MANTEL SURROUND

GLASS AND MIRROR

Invoice	Qty.	Description
2445 20Oct20 NoCat	1	MASTER ENSUITE: UPGRADE SHOWER DOOR HARDWARE TO 'MATTE BLACK' HANDLE/TOWEL BAR #MT6X18
2445 20Oct20 NoCat	1	MASTER ENSUITE: UPGRADE SHOWER DOOR HINGES TO MATTE BLACK
2445 20Oct20 NoCat	1	SHARED ENSUITE: UPGRADE SHOWER DOOR HINGES TO MATTE BLACK
2445 20Oct20 NoCat	1	SHARED ENSUITE: UPGRADE DOOR HARDWARE TO HANDLE/TOWEL BAR - MT6X18 - MATTE BLACK
2495 24Nov20 NoCat	2	**CREDIT** MASTER ENSUITE + SHARED ENSUITE: DELETE SHOWER DOOR TOWEL BAR/HANDLE MT6X18 (from order pe.2445) **INSTALL** SHOWER DOOR HANDLES 'MT6X6' - MATTE BLACK INSTEAD CREDIT DIFFERENCE IN PRICE DUE TO SITE CONDITION



CONSTRUCTION SUMMARY

Lot: 104
Model: 50.03 B OAKGROVE
Project/Phase: Pine Valley Forevergreen / 1

HVAC

Invoice	Qty.	Description
2306 72,224 28Oct20	1	KITCHEN: GAS LINE ROUGH-IN - MAIN FLOOR FOR COOKTOP - SEE PLAN FOR LOCATION
2306 72,249 28Oct20	1	STEAM HUMIDIFER - APRILAIRE 800 WHOLE HOUSE STEAM HUMIDIFIER (UP TO 6,200 SQ.FT.) - COMPLETE WITH HI VOLTAGE WIRING, 240V DOUBLE BREAKER 20 AMP, SHUT OFF VALVE
2306 28Oct20 NoCat	1	.GREAT ROOM: UPGRADE MAIN FLOOR LINEAR 1 SIDED FIREPLACE - JADE SERIES 42" LINEAR DIRECT VENT GAS FIREPLACE, INCLUDES ELECTRICAL NOT INCLUSIVE OF MANTEL SURROUND
2306 28Oct20 NoCat	1	.GREAT ROOM: FIREPLACE - ADD HEAT ACTIVATED FAN

GOLDPARK

WORTH MORE™

CONSTRUCTION SUMMARY

Lot: 104

Model: 50.03 B OAKGROVE

Project/Phase: Pine Valley Forevergreen / 1

KITCHEN AND BATH CABINETRY

Invoice	Qty.	Description
2445 20Oct20 NoCat	1	THRU OUT: SEE ATTACHED CABINETRY SCHEDULE
2445 20Oct20 NoCat	2	KITCHEN ISLAND: WATERFALL LEG
2445 20Oct20 NoCat	1	**CUSTOM CABINETRY COLOUR** ' LONDON FOG'
2445 20Oct20 NoCat	1	MUD ROOM: UPGRADE TO UNDERMOUNT STAINLESS STEEL SINK BLANCO QUATRUS R15 LAUNDRY SINK #401802 SINK + RACK #401952
2445 20Oct20 NoCat	1	KITCHEN: BLANCO QUATRUS U SUPER SINGLE #401248
2495 24Nov20 NoCat	-1	**CREDIT** GREAT ROOM BUILT-IN CABINETS BESIDE FIREPLACE (order pe.2445)
2495 24Nov20 NoCat	-1	*DELETE* HALF-HEIGHT STEEL PULL OUT PANTRY ACCESSORY (order pe.2445) not required
2495 24Nov20 NoCat	1	KITCHEN: UPGRADE TO GLASS CABINETS WITH DECORATIVE (half moon) INSERTS AND FINISHED INTERIOR double door cabinets flanking hood fan
2495 24Nov20 NoCat	1	KITCHEN ISLAND: SHORTEN SMALL CABINET DOOR TO ALLOW FOR ELECTRICAL PLUG ON FIXED PANEL ABOVE DOOR CENTERED ON FALSE DRAWER FRONT
2495 24Nov20 NoCat	1	KITCHEN: MODERN SOAP DISPENSER - BRUSHED GOLD #S3947BG LOCATE RIGHT OF (standard) FAUCET
2495 24Nov20 NoCat	2	**CREDIT** MASTER ENSUITE + SHARED ENSUITE: DELETE SHOWER DOOR TOWEL BAR/HANDLE MT6X18 (from order pe.2445) **INSTALL** SHOWER DOOR HANDLES 'MT6X6' - MATTE BLACK INSTEAD CREDIT DIFFERENCE IN PRICE DUE TO SITE CONDITION

MISC.

Invoice	Qty.	Description
2237 03Jun20 NoCat	1	BONUS PACKAGE: \$30,000.00 (INCLUDING TAXES) WORTH OF UPGRADES FROM GOLD PARK HOMES DÉCOR CENTRE IS BEING APPLIED TOWARD THIS ORDER. PURCHASER HAS A REMAINING AMOUNT OF \$28,389.75 (INCLUDING TAXES).

DisciplineMS.rpt 26jun20

Page 12 of 16
Printed and Sent: 24-Nov-20

**Lot: 104****Model: 50.03 B OAKGROVE****Project/Phase: Pine Valley Forevergreen / 1**

WINDOWS - BASEMENT

Invoice	Qty.	Description
2237	3	BASEMENT WINDOWS - UPGRADE BASEMENT WINDOW SIZE TO 30 " X 24" - 10" FRAME (PINEVALLEY 50 FOOT LOTS ONLY).
03Jun20 NoCat		

WINDOWS AND DOORS

Invoice	Qty.	Description
2306	1	THRU OUT: UPGRADE TO BLACK INTERIOR WINDOWS
28Oct20		
NoCat		

Scheduled Closing Date: Wednesday, March 3, 2021

Purchaser: Monika Karimi

Property: 104 of Plan -

Telephone Res. / Bus: /

Project: Pine Valley Forevergreen - Phase 1

Decor Advisor: Yolande Somerville

Model and Elevation: 50.03 B OAKGROVE

Layout Changes: Yes No Sketch Attached: Yes No Exterior Colour Scheme:

1. Cabinetry

Table with 4 columns: Room, Style and Colour, Counter, Hardware. Rows include Kitchen / Breakfast, Laundry Room, Powder Room, Mud Room, Master Ensuite Bathroom, Second Ensuite Bathroom, and Shared Bath.

Comment

2. Floor Tile

Table with 2 columns: Room, Selection. Rows include Entrance Vestibule, Main Hall, Kitchen / Breakfast, Laundry Room, Powder Room, Mud Room, Master Ensuite Bathroom, Second Ensuite Bathroom, Lower Landing, and Shared Ensuite.

Comment

Master Shower floor: *Dolomite 'Picket' marble mosaic Shared Ensuite Shower Floor: 2" Eterna matte 'Volkas'

3. Wall Tile

Table with 4 columns: Room, Selection, Listello/Inserts, Describe. Rows include Master Ensuite Bathroom (Tub Deck, Shower Stall, Bathroom Walls), Second Ensuite Bathroom, Shared Ensuite, and Kitchen Backsplash.

Comment

Handwritten signature and date: Oct 7, 2020. PR-104

Purchaser: Monika Karimi

Property: 104 of Plan -

Telephone Res. / Bus: /

Project: Pine Valley Forevergreen - Phase 1

Decor Advisor: Yolande Somerville

Model and Elevation: 50.03 B OAKGROVE

4. Plumbing Fixtures

☐	Second Ensuite	☐	Powder Room	☐
Master Ensuite Bathroom	☐	Other Room - Specify	☐	Other Washroom
		☐		

Comment
upgraded thru out - see extras

5. Hardwood Flooring

Type and Stain	Type and Stain
Main Hall	Upper Landing
Kitchen / Breakfast	Upper Hall
Living Room	Master Bedroom
Dining Room	Bedroom #2
Family Room	Bedroom #3
Den/Library	Bedroom #4
Entrance Vestibule	Bedroom #5
Lower Landing (If Applicable)	Other Room - Specify
	Standard areas thru out
	*3/4x5" maple 'Peppermint'

Comment
Stairs and landings will not match hardwood floors in colour/textur/species

6. Carpeting

Upgrade	Description
Ground Floor	☐
Second Floor	☐
	☐


Type	Area
Upgrade Underpad	☐
Capped	Runner - *Upgrade
Carpet on Stairs	☐

Comment

7. Fireplace

Fireplace Type	Living Room			Family Room			Other Room - Specify		
	Purchased	As Per Plan	N/A	Purchased	As Per Plan	N/A	Purchased	As Per Plan	N/A
	☐	☐	☒	☐	☒	☐	☐	☐	☒
Mantle Type				*Linear Gas					
Colour / Stain				n/a					
Surround				n/a					
Hearth				none					
				n/a					

Comment

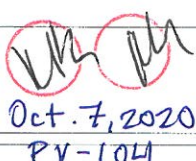

Oct. 7, 2020
PV-104

Purchaser: Monika Karimi

Property: 104 of Plan -

Telephone Res. / Bus: /

Project: Pine Valley Forevergreen - Phase 1

Decor Advisor: Yolande Somerville

Model and Elevation: 50.03 B OAKGROVE

8. Trim Carpentry

Interior Doors Front Door Glass Inserts Door Handles

Interior Trim

Comment

9. Plaster Mouldings and Medallions

Standard Throughout ☐ Yes ☒ No ☐ N/A

Entrance Vestibule Kitchen/Breakfast

Main Hall Den/Library

Living Room Lower Landing

Dining Room Other Room - Specify

Family Room

Comment

Thru out main floor (not mud room) + upper hall + Master Bedroom (not wic & ensuite) & Sitting Room: IWC-514

10. Railings and Spindles

Railing Package

Railing Colour

Spindle Colour

Stringer / Riser

Treads

Comment

Oak Stairs ☒ Yes ☐ No ☐ N/A

11. Wall Paint / Ceilings

Throughout Finished Areas

Trim Paint

Smooth Ceilings

Ground Floor ☒

Second Floor ☒

Note

Comment


Oct-7, 2020
PV-104

Scheduled Closing Date: Wednesday, March 3, 2021

Purchaser: Monika Karimi

Property: 104 of Plan -

Telephone Res. / Bus: /

Project: Pine Valley Forevergreen - Phase 1

Decor Advisor: Yolande Somerville

Model and Elevation: 50.03 B OAKGROVE

12. Electrical

Hood Fan ☐ White ☐ Stainless ☒ N/A

Above Kitchen Cabinet Light ☐ Yes ☒ No

Below Kitchen Cabinet Light ☒ Yes ☐ No

Standard Appliances ☐

Over The Range Microwave ☐

Chimney Style Fan ☐

Comment

13. Heating and Air Conditioning

Air Conditioning

Gas Provisions Stove

Gas Provisions Dryer

Gas Provisions Barbecue

Comment

14. Additional Comments

15. Disclaimers and Notes

- 1) Colours of all materials are as close as possible to builder's selection, but not necessarily identical due to variances in manufacturing.
- 2) Any extras listed above are null and void unless accompanied by a separate invoice/amendment. Said invoice must be paid in full.
- 3) The Purchaser acknowledges that after Interior Colour Selection form is signed and dated, no further changes will be permitted other than re-selection due to unavailability. _____ Purchaser's Initials
- 4) The Purchaser acknowledges reading and accepting the "Gold Park Homes Decor Centre Disclaimers" form. This document contains other miscellaneous disclaimers.

This Interior Colour Selection is final and approved by:

Signature:  Date: October 7, 2020

(PV-104)



SCHEDULE 'F'



PV-104 ^{see email}
MAR 27 2020

The Oakgrove 50' SERIES

Elevation A • 3,920 sq.ft.


→ Elevation B • 3,905 sq.ft.

Elevation C • 3,915 sq.ft.

PV-104 ^{see email}
APRIL 27 2020

PV-104 ~~NO~~
October 7, 2020

9' DOORS
ON MAIN
FLOOR

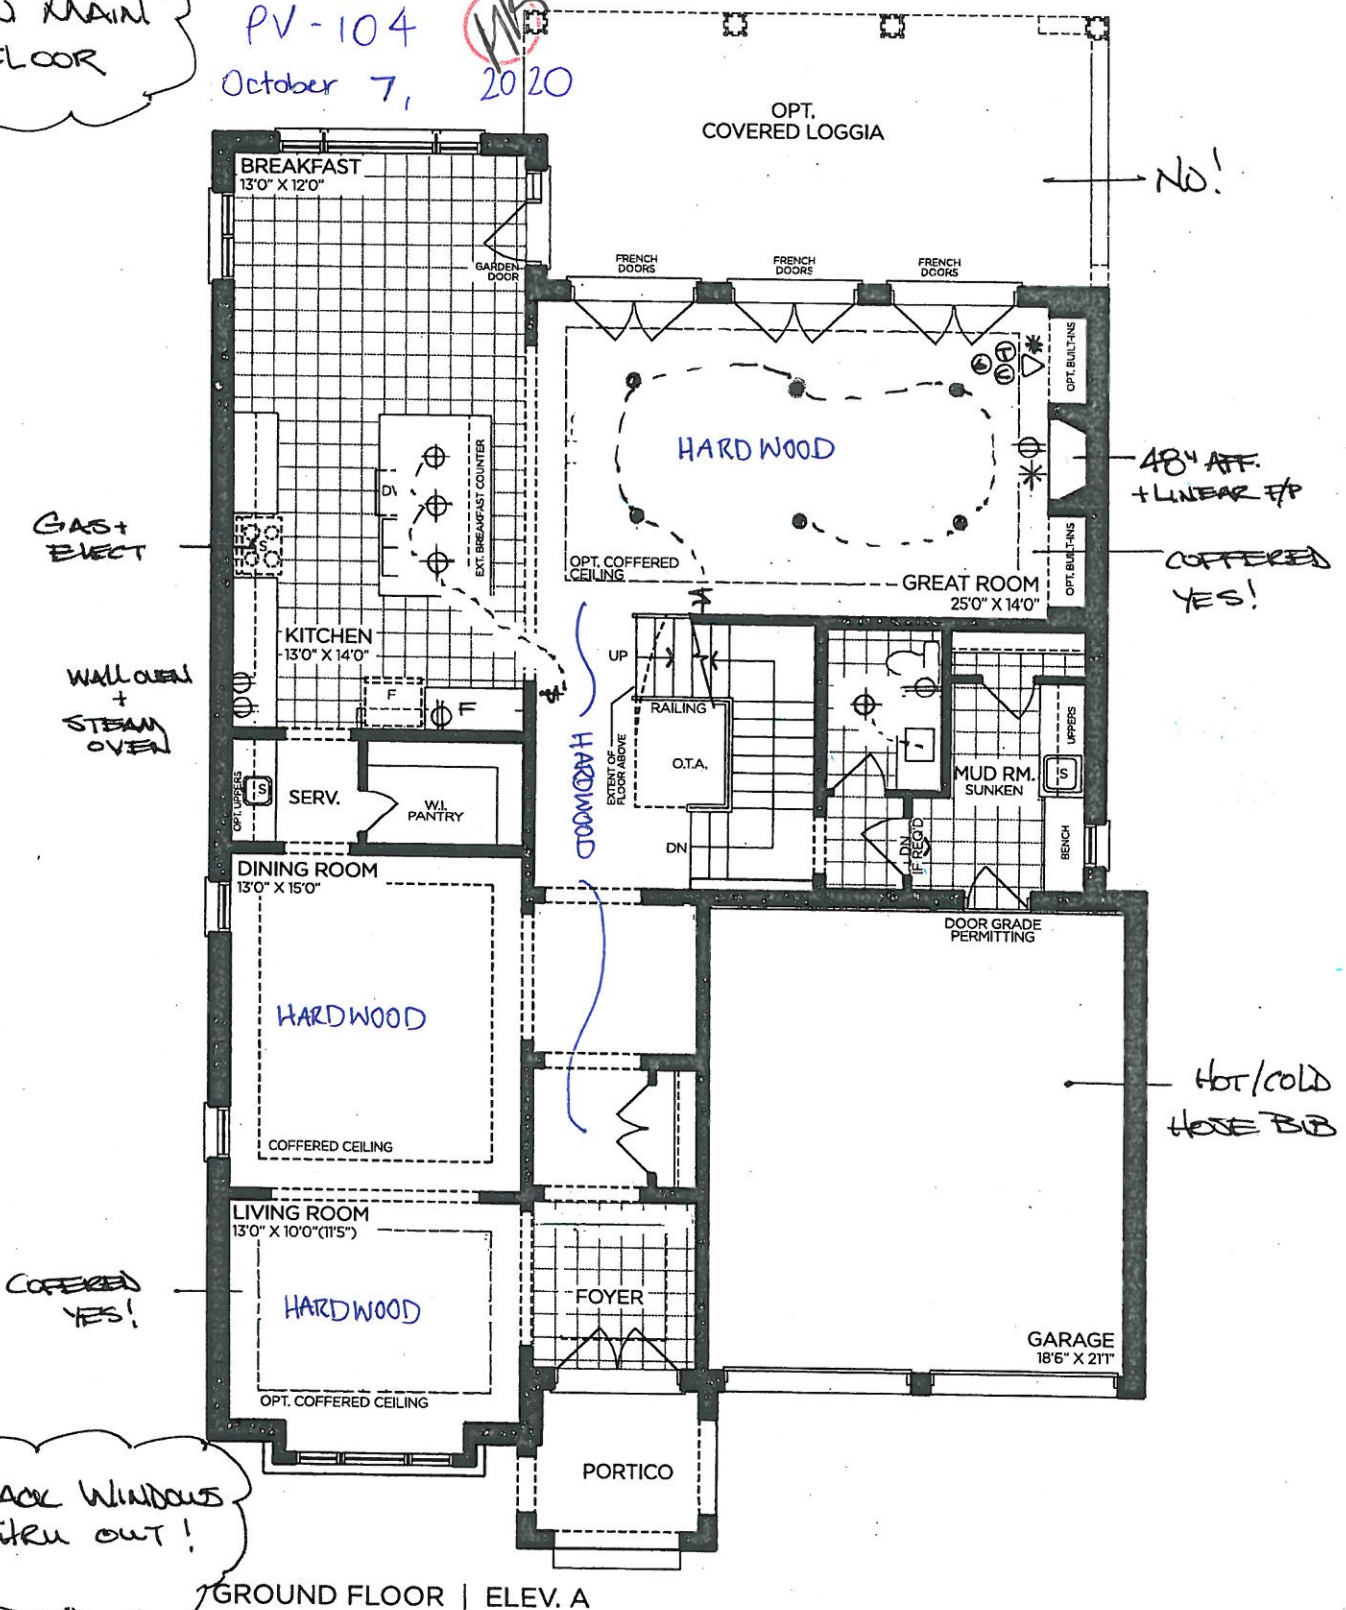

VENDOR
PURCHASER
PURCHASER

GOLDPARK
WORTH MORE™

Prices, figures, illustrations, sizes, features and finishes are subject to change without notice. Areas and dimensions are approximate and actual usable floor space may vary from the stated area. Layout may be reverse of the unit purchased. E. & O.E. 5003

SCHEDULE 'F'



The Oakgrove 50' SERIES

Elevation A • 3,920 sq.ft.

→ Elevation B • 3,905 sq.ft.

Elevation C • 3,915 sq.ft.


PV-104 ^{su email}
MAR 22 2020

PV-104 ^{su email}
APR 27 2020

PV-104 ^{VK}
October 7 2020

8 DOORS
ON 2ND
FLOOR

DELETE
Wall/Door
SUN
TUNNEL

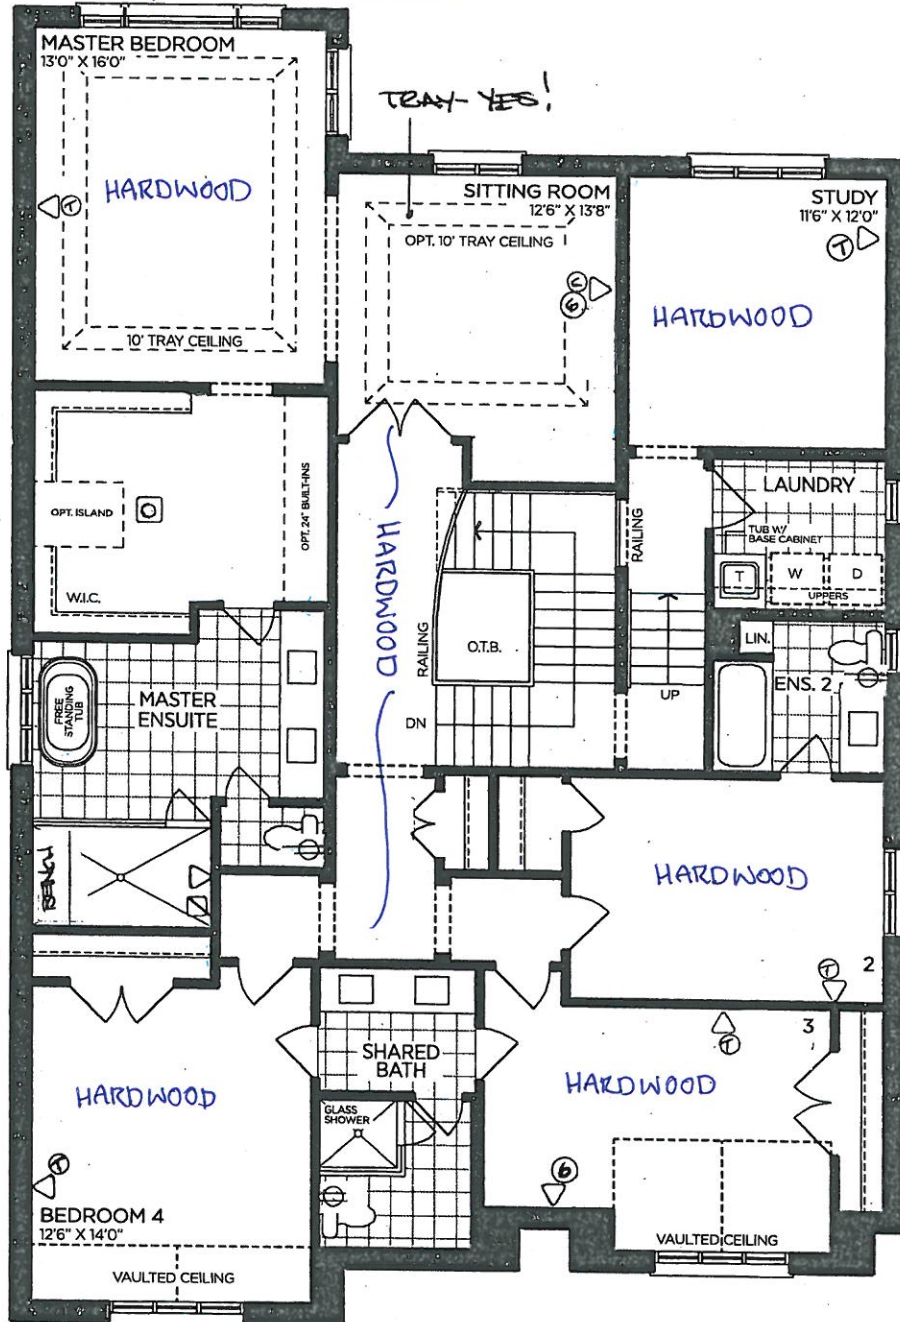

SECOND FLOOR | ELEV. A

VENDOR
PURCHASER
PURCHASER

GOLDPARK
WORTH MORE™

Prices, figures, illustrations, sizes, features and finishes are subject to change without notice. Areas and dimensions are approximate and actual usable floor space may vary from the stated area. Layout may be reverse of the unit purchased. E. & O.E. 5003

SCHEDULE 'F'



PV-104 ^{see email}
March 22 2020

PV-104.
April 27, 2020 ^{see email}

PV-104
October 7 2020


The Oakgrove

50' SERIES

Elevation A • 3,920 sq.ft.

Elevation B • 3,905 sq.ft.

Elevation C • 3,915 sq.ft.

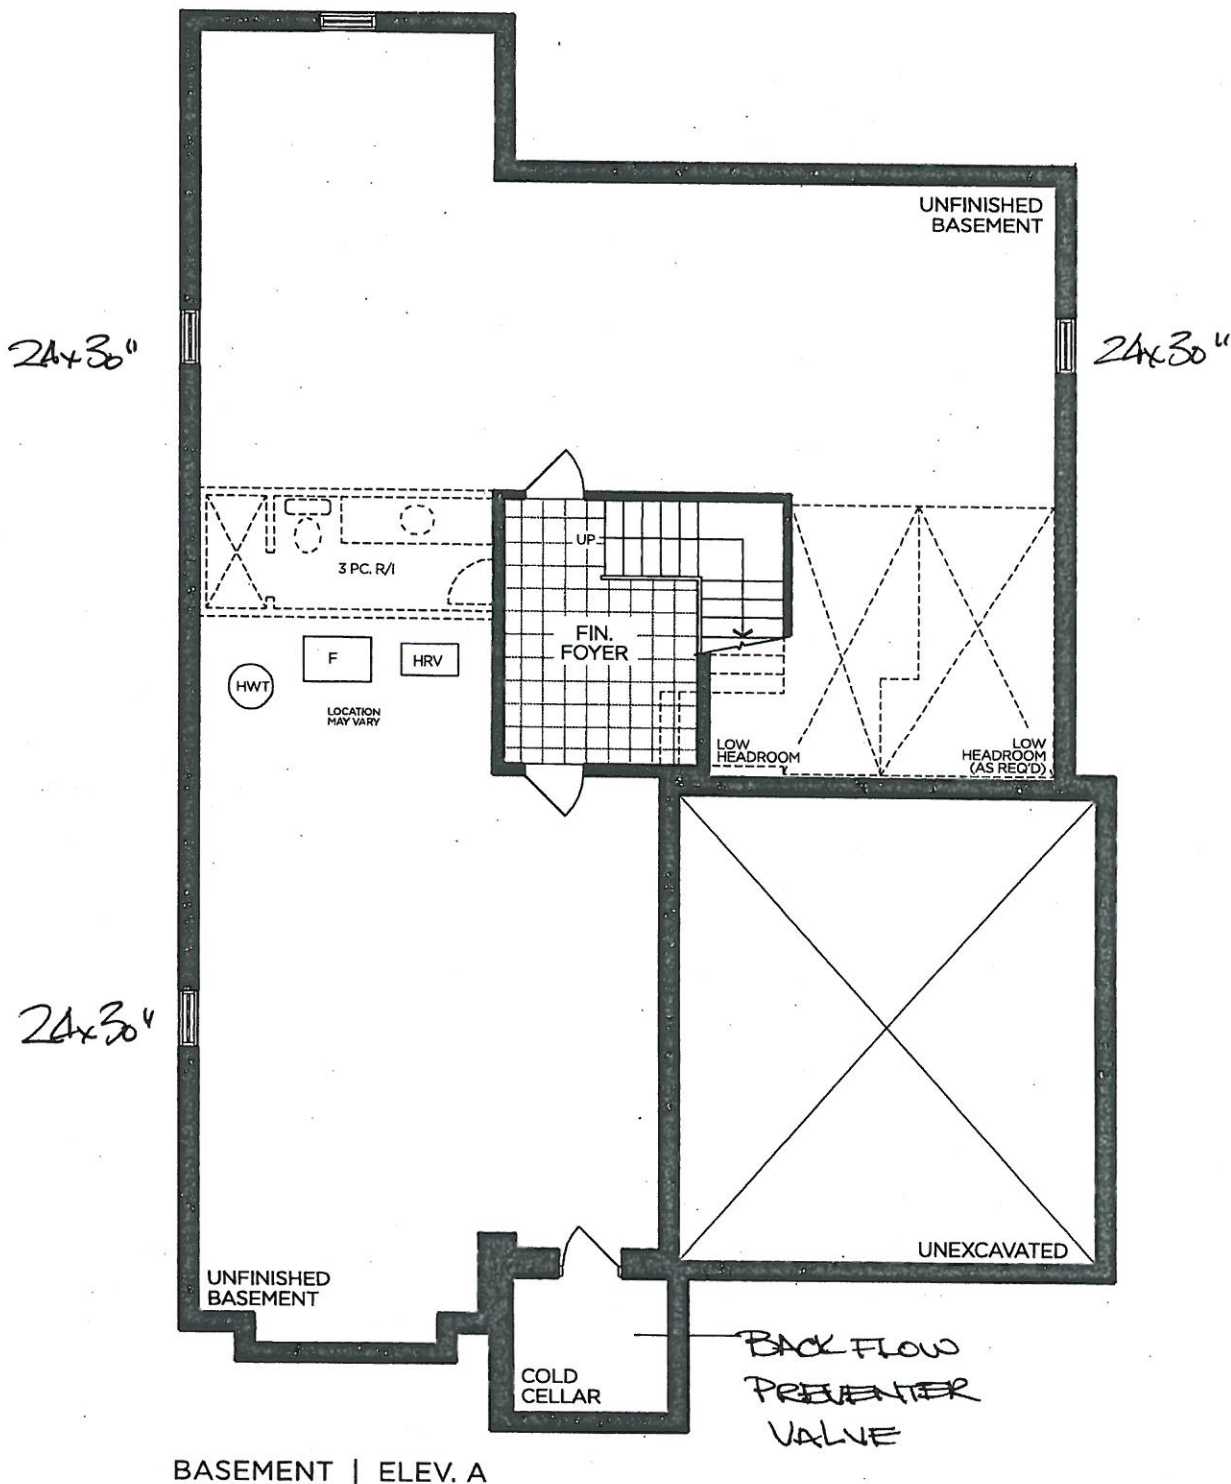

BASEMENT | ELEV. A

VENDOR

PURCHASER

PURCHASER

GOLDPARK
WORTH MORE™

Prices, figures, illustrations, sizes, features and finishes are subject to change without notice. Areas and dimensions are approximate and actual usable floor space may vary from the stated area. Layout may be reverse of the unit purchased. E. & O.E. 5003

SCHEDULE 'F'



PV-104. ^{see email}
MAR 22 2020

PV-104 ^{see email}
APRIL 27 2020


PV-104 ^{WKS}
October 7 2020

The Oakgrove 50' SERIES


Elevation A • 3,920 sq.ft.

→ Elevation B • 3,905 sq.ft.


Elevation C • 3,915 sq.ft.

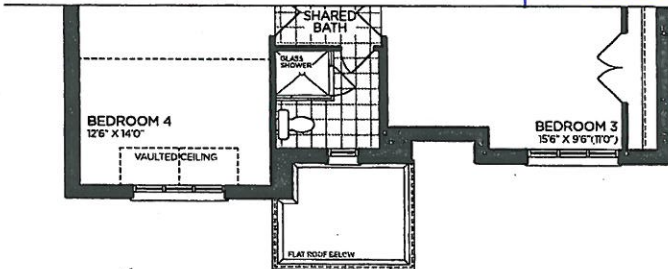


PART. OPT. SECOND FLOOR | ELEV. B
5 BEDROOM

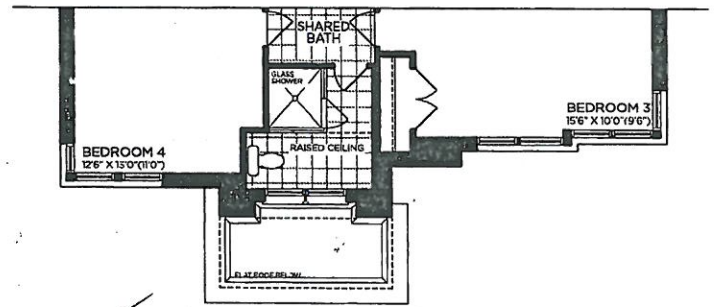


PART. OPT. SECOND FLOOR | ELEV. C
5 BEDROOM

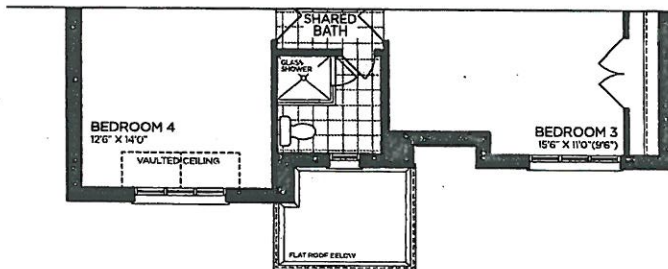


→ PART. SECOND FLOOR | ELEV. B

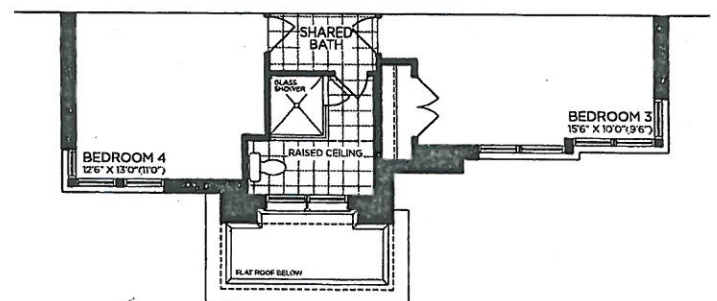


PART. SECOND FLOOR | ELEV. C

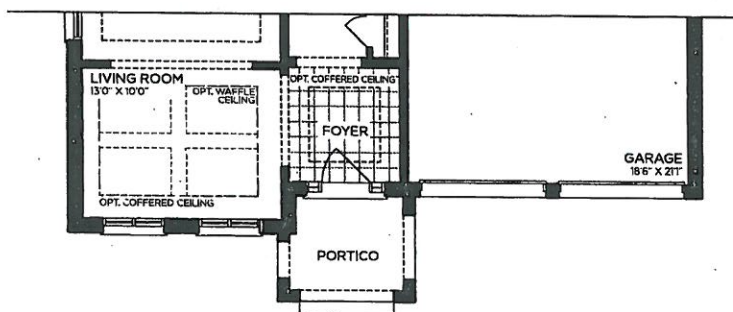


→ PART. GROUND FLOOR | ELEV. B

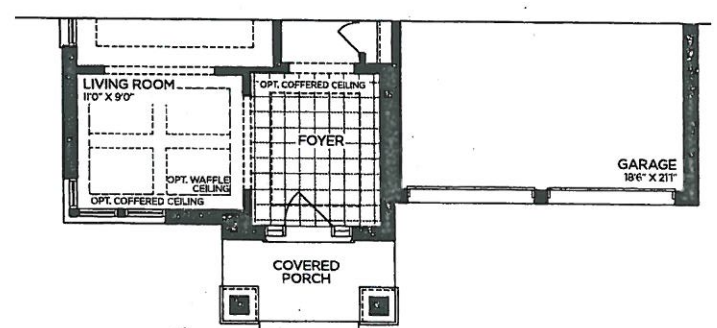

PART. GROUND FLOOR | ELEV. C

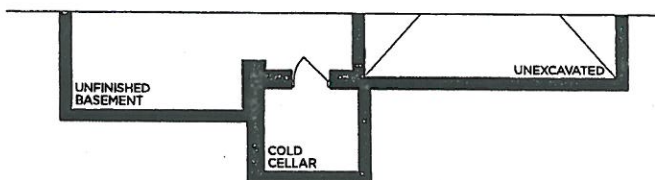

→ PART. BASEMENT | ELEV. B

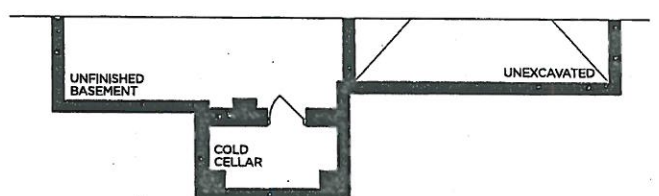

PART. BASEMENT | ELEV. C

VENDOR
PURCHASER
PURCHASER

GOLDPARK
WORTH MORE™







Prices, figures, illustrations, sizes, features and finishes are subject to change without notice. Areas and dimensions are approximate and actual usable floor space may vary from the stated area. Layout may be reverse of the unit purchased. E. & O.E. 5003

PV-104
Oct, 7 2020

**GOLDPARK HOMES
PINE VALLEY
VAUGHAN, ONTARIO
MODEL: (5003) OAKGROVE**

**SITE STANDARD: WHITE 3/4" EXTENSION
SOFT-CLOSE DRAWERS & STANDARD SLAM DOOR HINGES
TO VANITIES**

**ONE TOP DRAWER WHERE POSSIBLE THROUGHOUT EACH
VANITY, ONE BANK OF DRAWERS WHERE POSSIBLE
THROUGHOUT EACH MASTER ENSUITE VANITY**

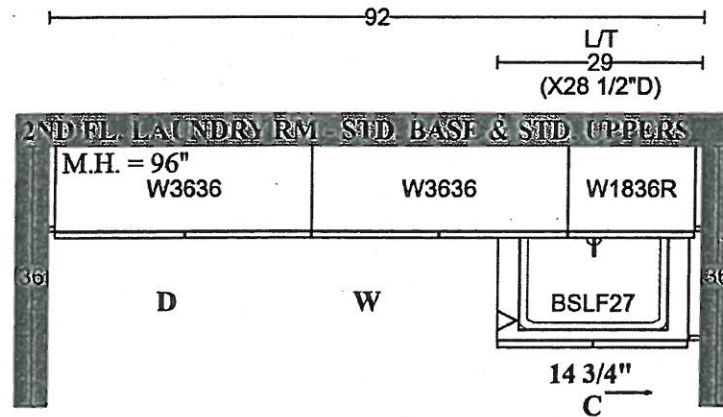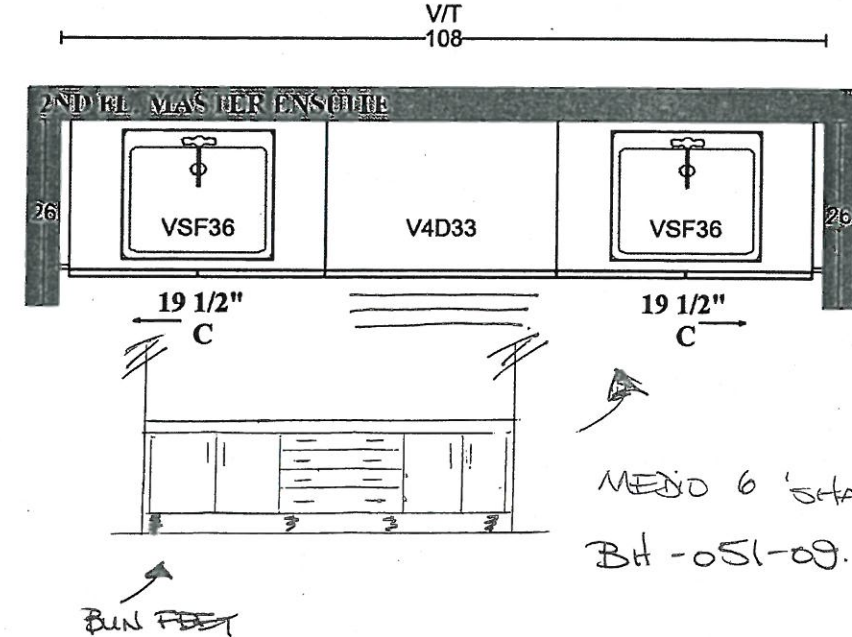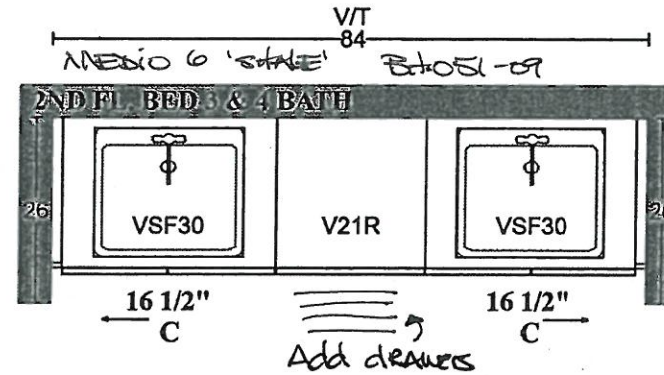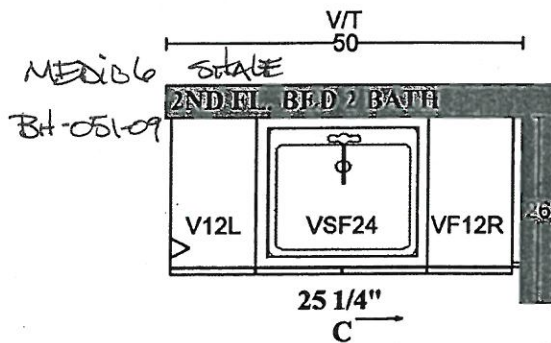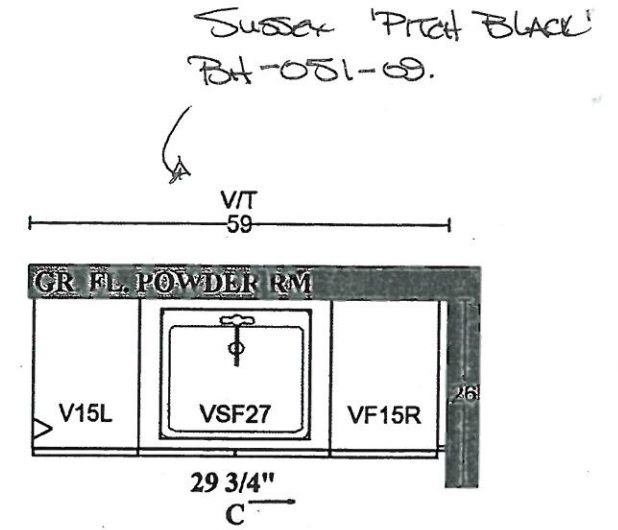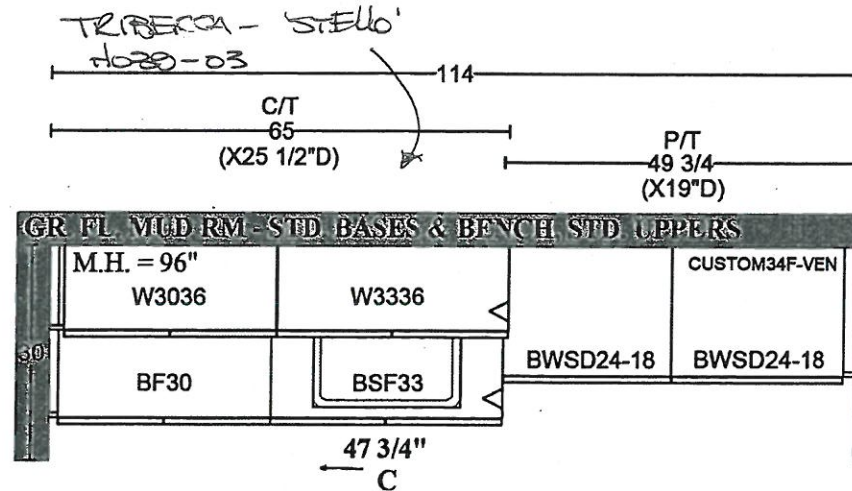

SUSSEX - 'Pitch BLACK'
BH-051-09.

Add Gables for
stone counter above machines


MEDIA 6 'STAGE'
BH-051-09.

PLAN VIEW

- Valance - plain
- Bl - 051-08.



*Turn the
Kick both long sides*

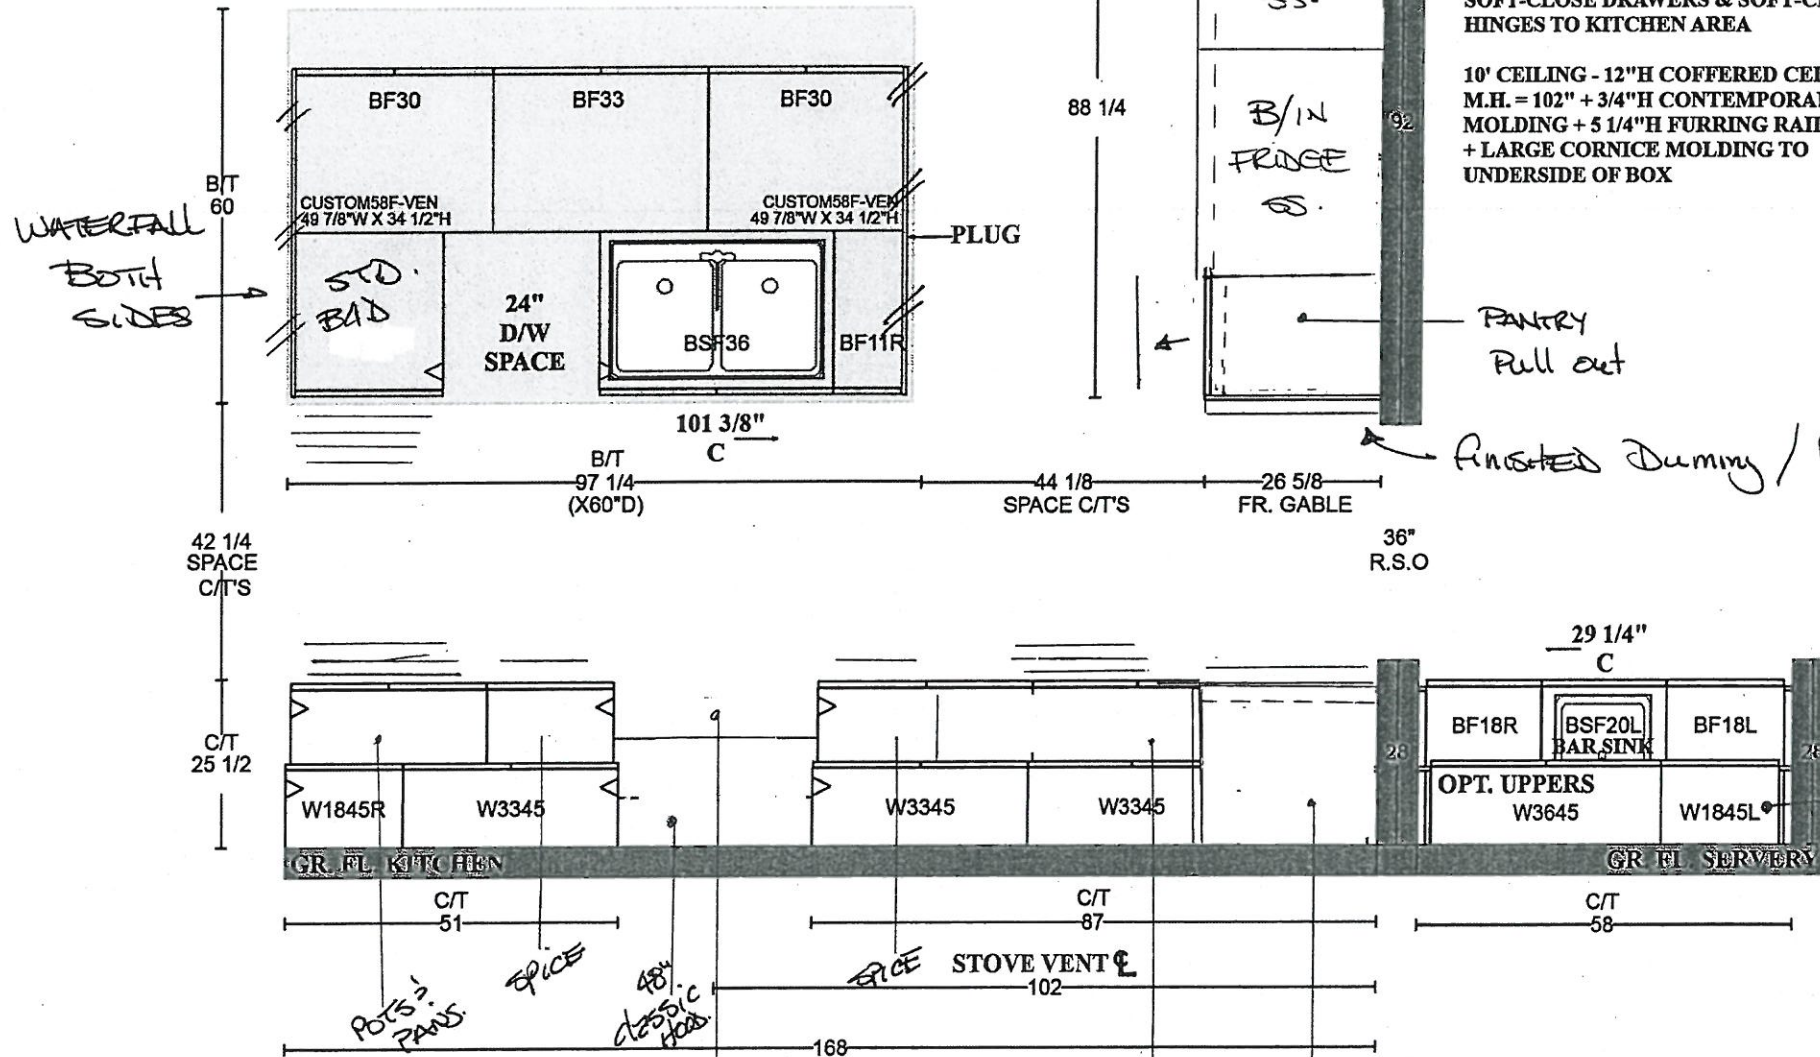

**GOLDPARK HOMES
PINE VALLEY
VAUGHAN, ONTARIO
MODEL: (5003) OAKGROVE**

**SITE STANDARD: WHITE 3/4" EXTENSION
SOFT-CLOSE DRAWERS & SOFT-CLOSE
HINGES TO KITCHEN AREA**

**10' CEILING - 12"H COFFERED CEILING -
M.H. = 102" + 3/4"H CONTEMPORARY
MOLDING + 5 1/4"H FURRING RAIL
+ LARGE CORNICE MOLDING TO
UNDERSIDE OF BOX**

PV-104.
Oct, 7 2020

MEMO 6
"LONDON Gable"




PLAN VIEW

#: AKOWALTCHUK-0033-20 (V1.12)

Page# 7/18

SOLID SURFACE COUNTERTOP EDGE DETAIL


STANDARD - 2CM EDGE

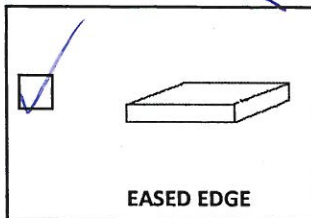


→ Powder Room (3cm)
 → Kitchen (3cm)
 → Master Ensuite (3cm)
 → Ensuite 2 (3cm)

→ Shared Ensuite (3cm)
 → Laundry (3cm)


LEVEL 1 (UPGRADE) - 2CM EDGE

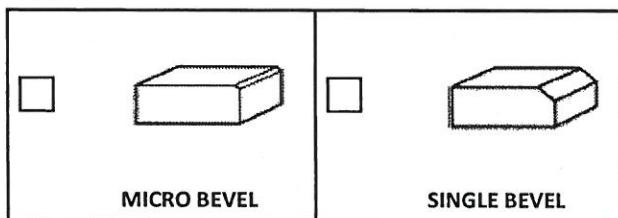


LEVEL 2 (UPGRADE) - 2CM EDGE

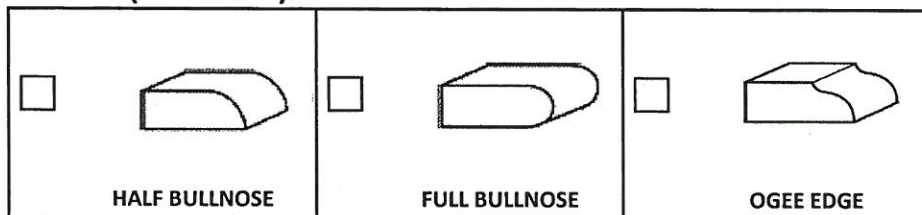


LEVEL 3 (UPGRADE) - 4CM EDGE - SEAMS WILL BE VISIBLE

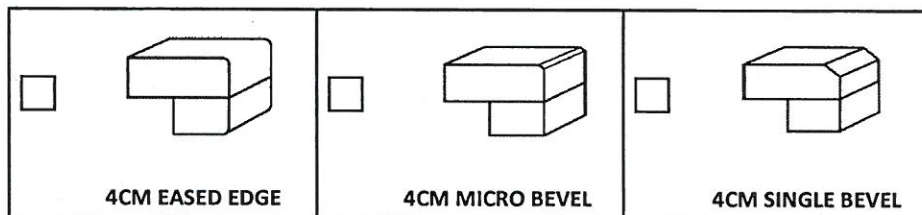

LEVEL 4 (UPGRADE) - 4CM EDGE - SEAMS WILL BE VISIBLE

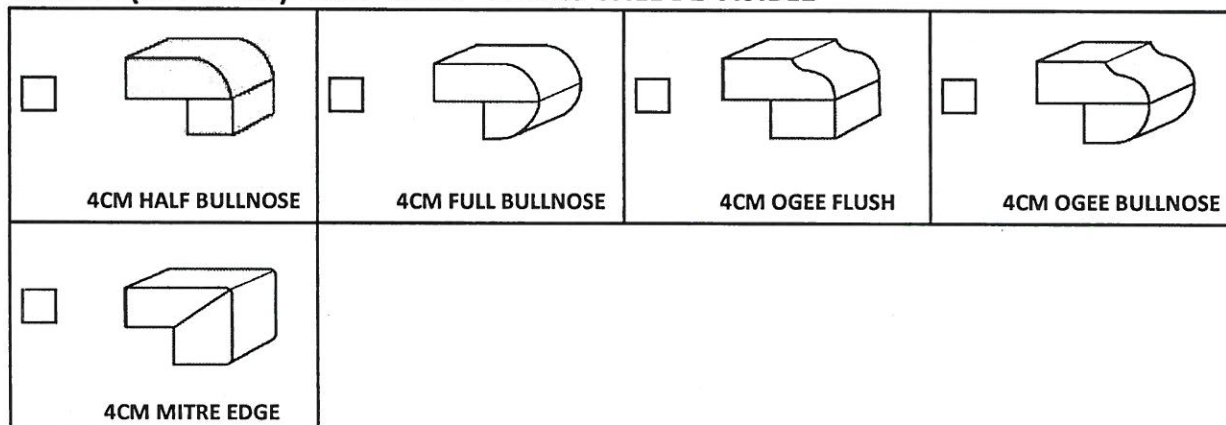

LEVEL 5 (UPGRADE) - 4CM EDGE - SEAMS WILL BE VISIBLE

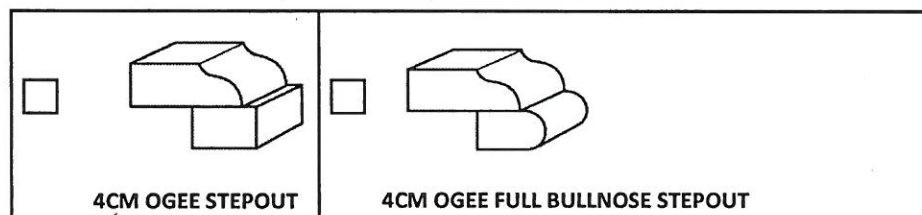


☒ 3CM UPGRADE EDGE DETAIL IN LIEU OF 2CM EDGE

LOT # 104

AREA:

DATE: October 7, 2020

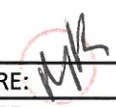SIGNATURE: 

SIGNATURE:

UPGRADE HARDWARE

BH-051-09

Modern Brushed Gold - Subtle Surge Pull
160mm C/C



LOCATION:

- kitchen
- Powder Room
- Master Ensuite
- Ensuite 2
- Shared Bath
- Laundry

LOT # PV-104

DATE: October 7, 2020.

SIGNATURE:

Moni

SIGNATURE:



PINE VALLEY



FOREVERGREEN

UPGRADE LAUNDRY SINK

BLANCO - QUATRUS R15 LAUNDRY

Stainless Steel - Dual-Mount

25" x 22" x 12"

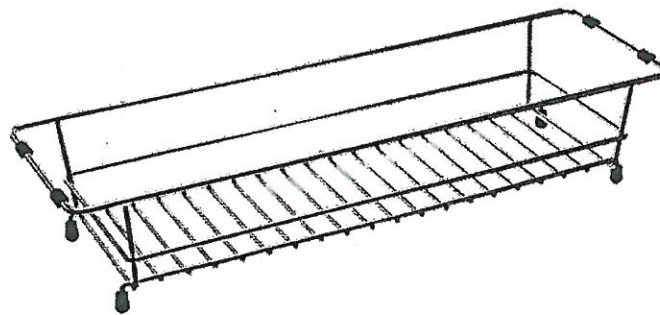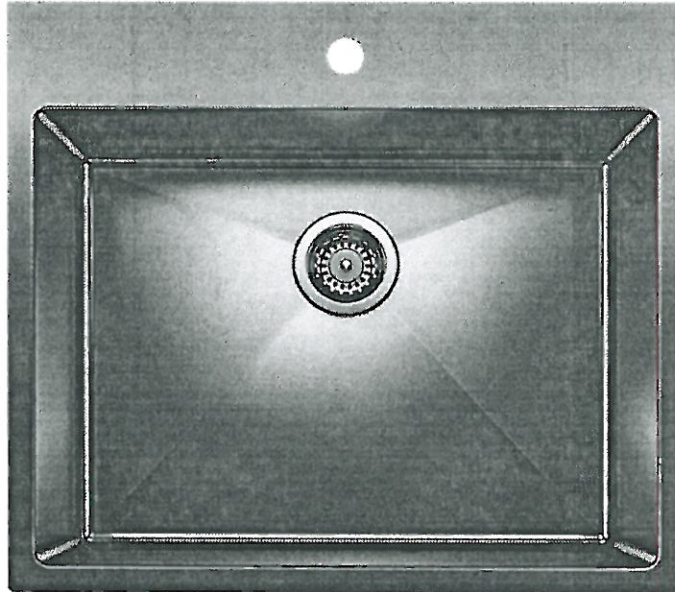

Stainless Steel

☒ LAUNDRY RACK

MODEL 401802 Stainless Steel / 401952 Grid

Lot# 104

Room: Laundry, Mud Room

Signature: MR

Date: October 7, 2020

Signature:



GOLDPARK
WORTH MORE



PINE VALLEY
FOREVERGREEN

UPGRADE KITCHEN SINK

BLANCO - QUATRUS U SUPER SINGLE
Stainless Steel - Undermount
32" x 18" x 9"

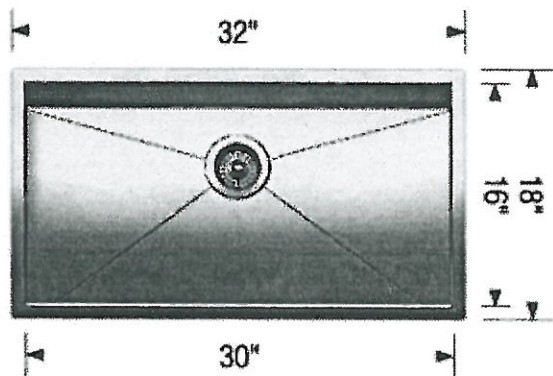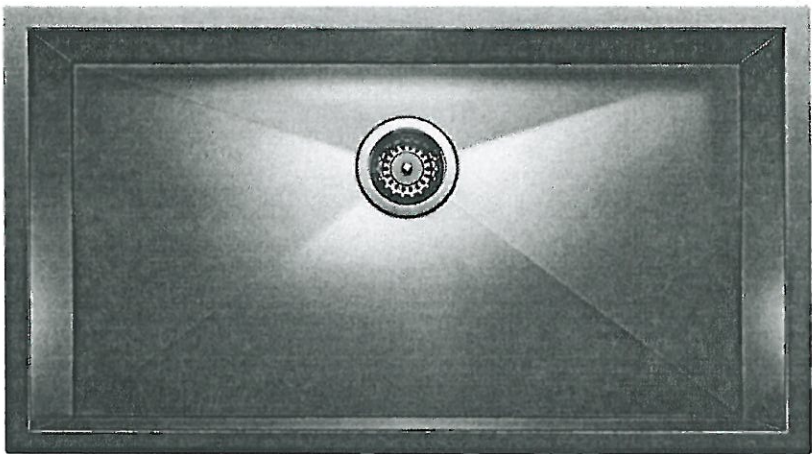

Stainless Steel

☐ GRID

MODEL 401248 Stainless Steel /-402125 Grid-

Lot# 104

Room: Kitchen

Signature:

Date: October 7, 2020 .



Signature:

PRODUCT-SPECIFICATIONS

model	DF486G
dimensions	47 7/8"W x 36 7/8"H x 29 1/2"D
Oven 1 Usable Capacity	1.5 cu. ft.
Oven 1 Overall Capacity	2.5 cu. ft.
Oven 2 Usable Capacity	2.8 cu. ft.
Oven 2 Overall Capacity	4.5 cu. ft.
Door Clearance	19 1/2"
weight	750 lbs
electrical-supply	240/208 VAC, 60 Hz
electrical-service	50 amp dedicated circuit
gas-supply	3/4" ID line
gas-inlet	1/2" NPT female

ELECTRICAL


GAS

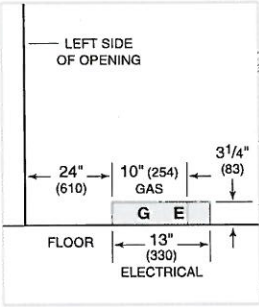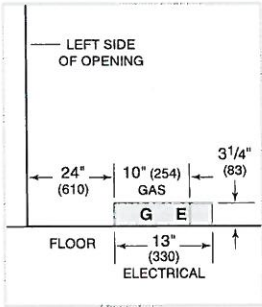


NOTE: Dimensions in parenthesis are in millimeters unless otherwise specified

PV-104 ~~W~~ ~~W~~
Oct. 7, 2020

DIMENSIONS

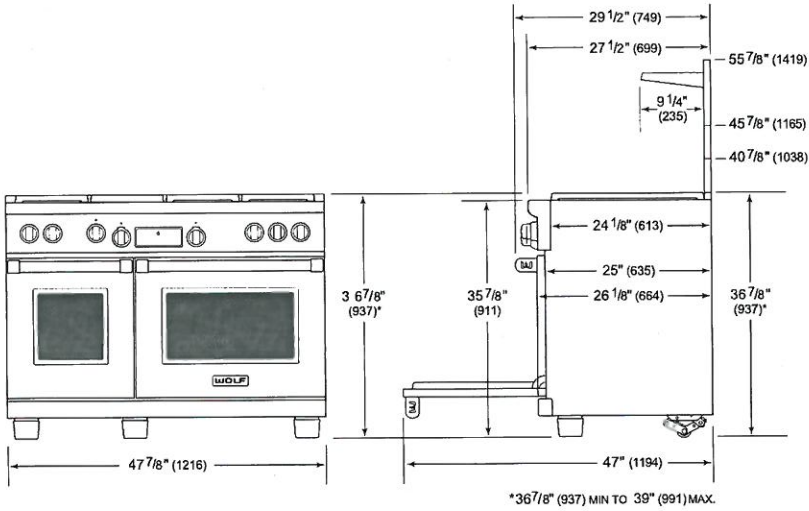

STANDARD INSTALLATION

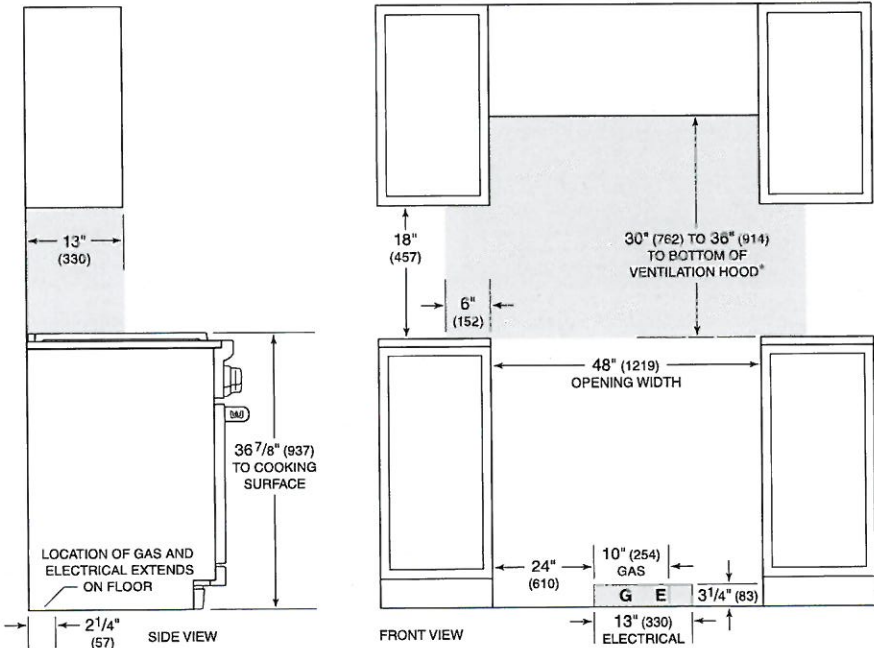

*Without ventilation hood, 36" (914) minimum clearance countertop to combustible materials, 44" (118) for charbroiler.
NOTE: Shaded area above countertop indicates minimum clearance to combustible surfaces, combustible materials cannot be located within this area.
For island installation, 12" (305) minimum clearance back of range to combustible rear wall above countertop.

DIMENSIONS

Technical drawings of the 2000 Series 24-inch refrigerator showing front and side views with dimensions.

Front View Dimensions:

- Width: 36" (914)
- Height (to top of door): 84" (2134)
- Height (to bottom of door): 73 3/4" (1873)
- Height (to top of refrigerator body): 37 1/4" (946)
- Height (to bottom of refrigerator body): 23 7/8" (606)

Side View Dimensions:

- Depth: 26 3/16" (665)
- Height (to top of door): 4" (102)
- Height (to bottom of door): 23 7/8" (606)
- Height (to bottom of refrigerator body): 23 7/8" (60)

HEIGHT DIMENSIONS $\pm 1/2"$ (13)

Diagram illustrating the right side of the opening. The diagram shows a vertical section with a horizontal line at the top. Below this line, a vertical dimension of 7" (178) is indicated. To the right of this dimension is a rectangular component labeled 'E'. Below the 7" dimension, a horizontal dimension of 6" (152) is indicated, with arrows pointing to the right and left. Below the 6" dimension, a vertical dimension of 75 1/2" (1918) is indicated, with the text 'FROM FLOOR' below it. The text 'RIGHT SIDE OF OPENING' is written below the diagram.


NOTE: Dimensions in parenthesis are in millimeters unless otherwise specified

A detailed line drawing of a refrigerator with its door open. The interior features several shelves, a crisper drawer at the bottom, and a freezer compartment with three drawers. The door is open to the right, revealing multiple storage compartments, including a large one at the top and a smaller one at the bottom. The drawing is a technical illustration, likely for a user manual.

This illustration is intended for interior reference only and may not represent the exterior of the model being specified.

PV-104  
Oct 7, 2020

FLUSH INSET INSTALLATION

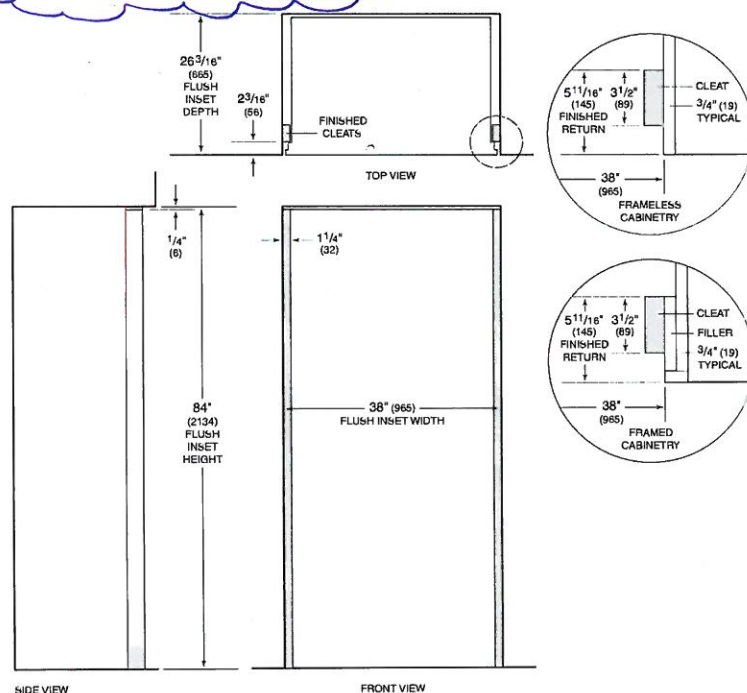


NOTE: 3 1/2" (89) finished returns and shaded areas will be visible and should be finished to match cabinetry. Shaded line represents profile of unit with 3/4" (19) panel.


PRODUCT SPECIFICATIONS

Model	BI-36F/O
Dimensions	36"W x 84"H x 24"D
Door Clearance	37 1/4"
Weight	406 lbs
Freezer Capacity	22.6 cu. ft.
Electrical Supply	115 VAC, 60 Hz
Electrical Service	15 amp dedicated circuit
Plumbing Supply	1/4" OD copper, braided stainless steel or PEX tubing
Plumbing Pressure	35-120 psi
Receptacle	3-prong grounding-type

ELECTRICAL

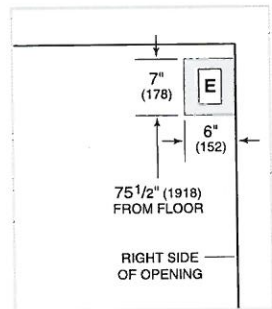


PLUMBING

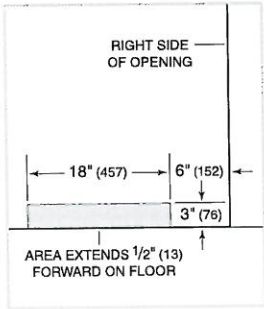

PANEL SPECIFICATIONS For complete panels specifications including width/height, weight requirements, thickness requirements and offset details visit subzero-wolf.com/builtinconfigurator.


NOTE: Dimensions in parenthesis are in millimeters unless otherwise specified

INTERIOR VIEW

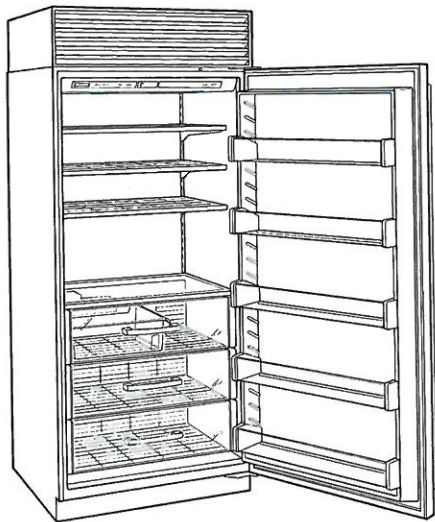


This illustration is intended for interior reference only and may not represent the exterior of the model being specified.

DIMENSIONS

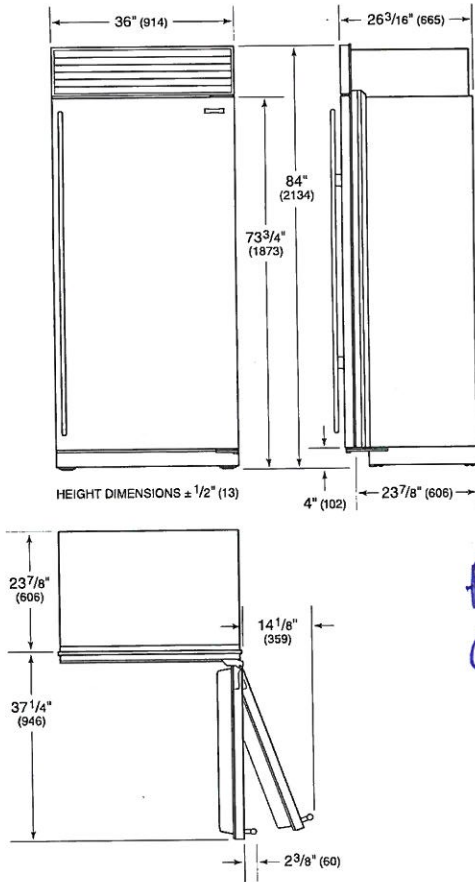

PV-104
Oct. 7, 2020

FLUSH INSET INSTALLATION

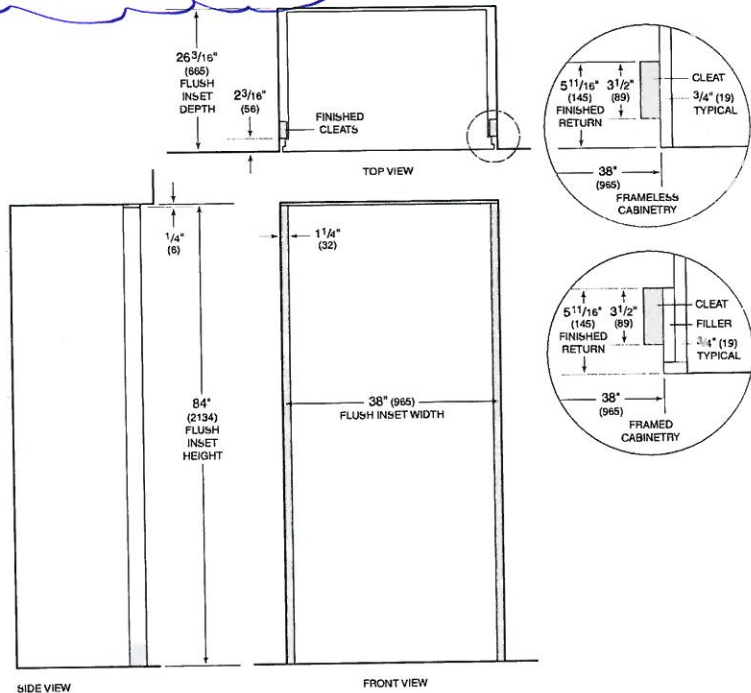

SIDE VIEW

FRONT VIEW

NOTE: 3/2 inch (89 mm) finished returns and shaded areas will be visible and should be finished to match cabinetry. Shaded line represents profile of unit with 3/4 inch (19 mm) panel.

Specifications are subject to change without notice. This information was generated on October 6, 2020. Verify specifications prior to finalizing your cabinetry/enclosures.

UPGRADE FAUCET

MOEN - MODERN

Pot Filler



- ☐ CHROME
- ☐ STAINLESS
- ☒ BRUSHED GOLD
- ☐ MATTE BLACK

MODEL S665 Chrome / S665SRS Stainless / S665BG Brushed Gold / S665BL Matte Black

LOT # 104	ROOM: Kitchen	DATE: October 7, 2020
SIGNATURE: 		
SIGNATURE: 		

Moen - ALIGN *BRUSHED GOLD

Freestanding Tub Filler



BRUSHED GOLD

MODEL 395BG Tub Filler / TS50100 Mounting Kit


LOT # 104	ROOM: Master Ensuite	DATE: October 7, 2020.
SIGNATURE: 		
SIGNATURE:		

PLUMBING UPGRADE



Moen - VELOCITY *BRUSHED GOLD

RAIN SHOWER W/ 3 FUNCTION TRANSFER VALVE/TRIM AND SLIDE BAR W/ HAND SHOWER

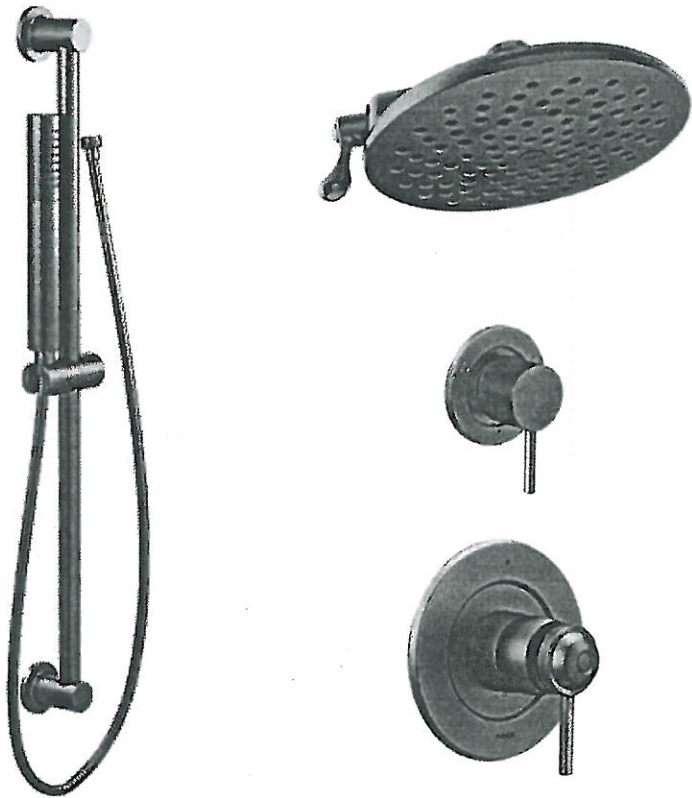

BRUSHED GOLD

MODEL S6320BG Brushed Gold / 226651BG Shower Arm from Ceiling / 3887EPBG Handshower / T4192BG Transfer Valve / T4291BG Temp-Valve

LOT # 104	ROOM: Master Ensuite	DATE: October 7, 2020.
SIGNATURE:		
SIGNATURE:		




PINE VALLEY
FOREVERGREEN

PLUMBING UPGRADES

TWO HANDLE ADJUSTABLE WIDESPREAD
FAUCET W/ LIFT ROD DRAIN

LAV

MOEN - ALIGN

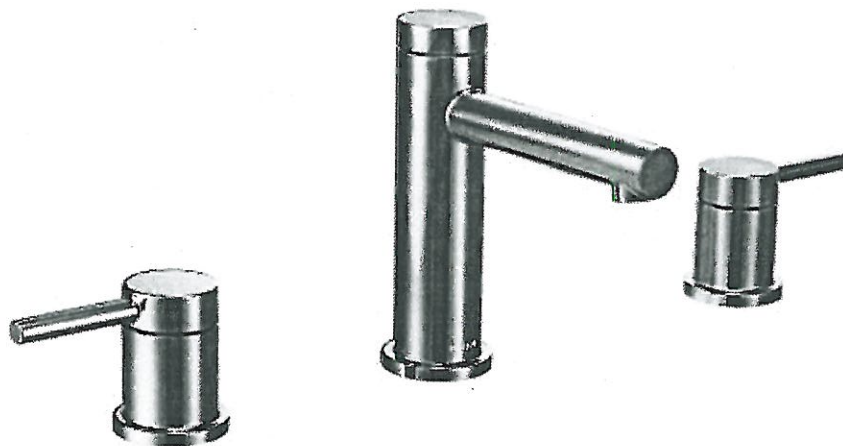

☐ CHROME

☒ BRUSHED GOLD - Master Ensuite (x2)

☒ MATTE BLACK - Ensuite 2
- shared Ensuite (x2)

MODEL T6193 / 69000

Lot# 104

Room: Master Ensuite (x2)
Ensuite 2
shared Ensuite (x2)

Signature:

Date: October 7, 2020.

Signature:



PINE VALLEY
FOREVERGREEN

UPGRADE SHOWER HARDWARE

MT6X18

Shower Door Handle / Towel Bar



MT6X18
Shower Door Handle / Towel Bar
6" x 18" back-to-back
3/4" dia. tube
Cut and miltred corners with washers

LOT #
104

ROOM: M. Ensuite +
Shared Bath

DATE:
October 7, 2020.

SIGNATURE:

SIGNATURE:




PINE VALLEY
FOREVERGREEN

PLUMBING UPGRADES

ECO-PERFORMANCE POSI-TEMP TUB/SHOWER FAUCET

MOEN - ALIGN

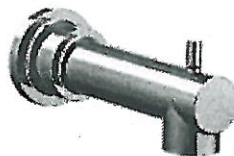

- ☐ CHROME
☐ BRUSHED GOLD
☒ MATTE BLACK

MODEL T2193EP / 62320

Lot#

104

Room: *Ensuite 2*

Signature: *[Signature]*

Date: *October 7, 2020.*

Signature: *[Signature]*

GOLDPARK
WORTH MORE



PINE VALLEY
FOREVERGREEN

PLUMBING UPGRADES

ECO-PERFORMANCE POSI-TEMP SHOWER ONLY*

MOEN - ALIGN



- ☐ CHROME
- ☐ BRUSHED GOLD
- ☒ MATTE BLACK

MODEL T2192EP / 62320

Lot# 104

Room: Shared Ensuite

Signature:

Date: October 7, 2020.

Signature:

BATHROOM ACCESSORIES



Tissue Holder
Mason - Chrome



Towel Bar
Mason - Chrome

☐ INSTALL STANDARD BATHROOM ACCESSORIES THRU OUT
(tissue holder + towel bar) **location as per vendors discretion**

☐ ***DO NOT*** INSTALL STANDARD BATHROOM ACCESSORIES
THRU OUT **tissue holder + towel bar will not be provided**

LOT #

PV-104

DATE:


October 7, 2020

SIGNATURE:

SIGNATURE:



PINE VALLEY
FOREVERGREEN

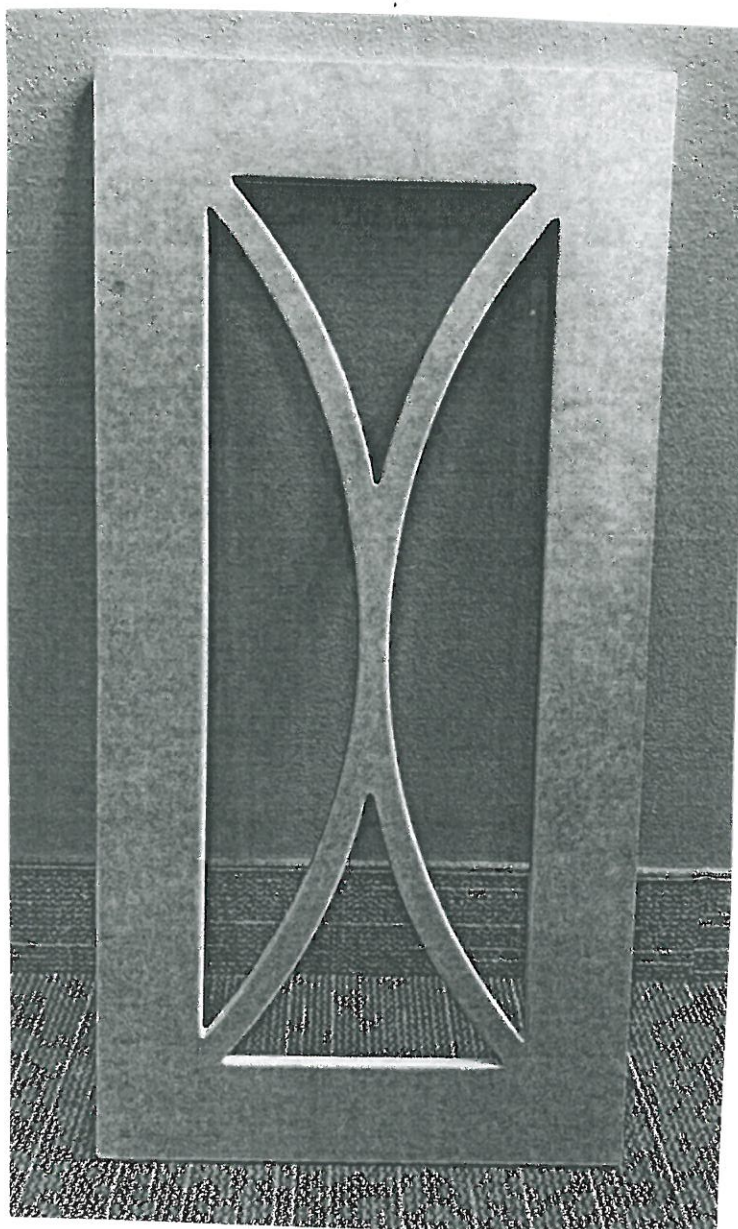

* FLANKING too FAR.


Lot# PV.104	Date: NOV. 17 2020	Room: KITCHEN
Signature: *see attached*		
Signature:		

UPGRADE SHOWER HARDWARE



MT6X6

Shower Door Handle

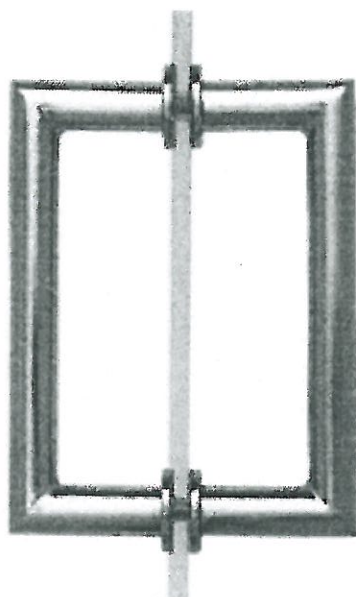

MT6X6
Shower Door Handle

6" x 6" back-to-back
3/4" dia. tube
Cut and mitred corners with
washers
(Also available single sided)

☐ CHROME
☒ MATTE BLACK

Lot# PV-104	Date: Nov. 17, 2020	Room: Master Ensuite, Shared Bath
Signature: *see attached*		
Signature:		



PINE VALLEY
FOREVERGREEN

UPGRADE FAUCET

MOEN - MODERN

Soap/Lotion Dispenser



- ☐ CHROME
- ☐ STAINLESS (SRS)
- ☒ BRUSHED GOLD (BG)
- ☐ MATTE BLACK (BL)

MODEL S3947C Chrome / S3947SRS Stainless / S3947BG Brushed Gold / S3947BL Matte Black

Lot#
PV-104

Date: Nov. 17, 2020

Room: Kitchen.

Signature: *see attached*

Signature:

GOLDPARK
WORTH MORE