

**Model: 40.03 B BROOKSIDE****Project/Phase: Pine Valley Forevergreen / 1**

INTERIOR TRIM AND DOORS

Invoice	Qty.	Description
2334 24Jul20 NoCat	1	.DELETE KITCHEN BULKHEAD, IF POSSIBLE, SITE APPROVAL REQUIRED
2334 24Jul20 NoCat	1	.STUDY - OPT. 8 FOOT HIGH DOUBLE FRENCH DOORS WITH FLAT CLEAR GLASS COMPLETE WITH BUILDERS STANDARD OFFERINGS
2515 26Nov20 NoCat	1	**CUSTOM LAYOUT** DELETE CLOSET IN BEDROOM 3

KITCHEN AND BATH CABINETRY

Invoice	Qty.	Description
2334	1	.DELETE KITCHEN BULKHEAD, IF POSSIBLE, SITE APPROVAL REQUIRED
24Jul20 NoCat		

NETWORK AND WIRING

Invoice	Qty.	Description
2334 72,259 24Jul20	1	GREAT ROOM: CONDUIT PIPE - FOR WALL MOUNT TV - LOCATE APPROX. 66" A.F.F. ABOVE FIREPLACE, THRU BASEMENT AND TERMINATING AT CABLE LOCATION - SEE PLAN
2334 72,264 24Jul20	1	MUD ROOM: ROUGH - IN FOR EXTRA SECURITY KEY PAD

PAINT

Invoice	Qty.	Description
2334 24Jul20 NoCat	1	.DELETE KITCHEN BULKHEAD, IF POSSIBLE, SITE APPROVAL REQUIRED
2334 24Jul20 NoCat	1	.STUDY - OPT. 8 FOOT HIGH DOUBLE FRENCH DOORS WITH FLAT CLEAR GLASS COMPLETE WITH BUILDERS STANDARD OFFERINGS
2515 26Nov20 NoCat	1	**CUSTOM LAYOUT** DELETE CLOSET IN BEDROOM 3

SCHEDULE 'F'




PV-157
NOV. 25, 2020

PV-157
APRIL 13 2020
MAY 11 2020
see attached

The Brookside
40' SERIES

Elevation A • 3,380 sq.ft.
Elevation B • 3,350 sq.ft.

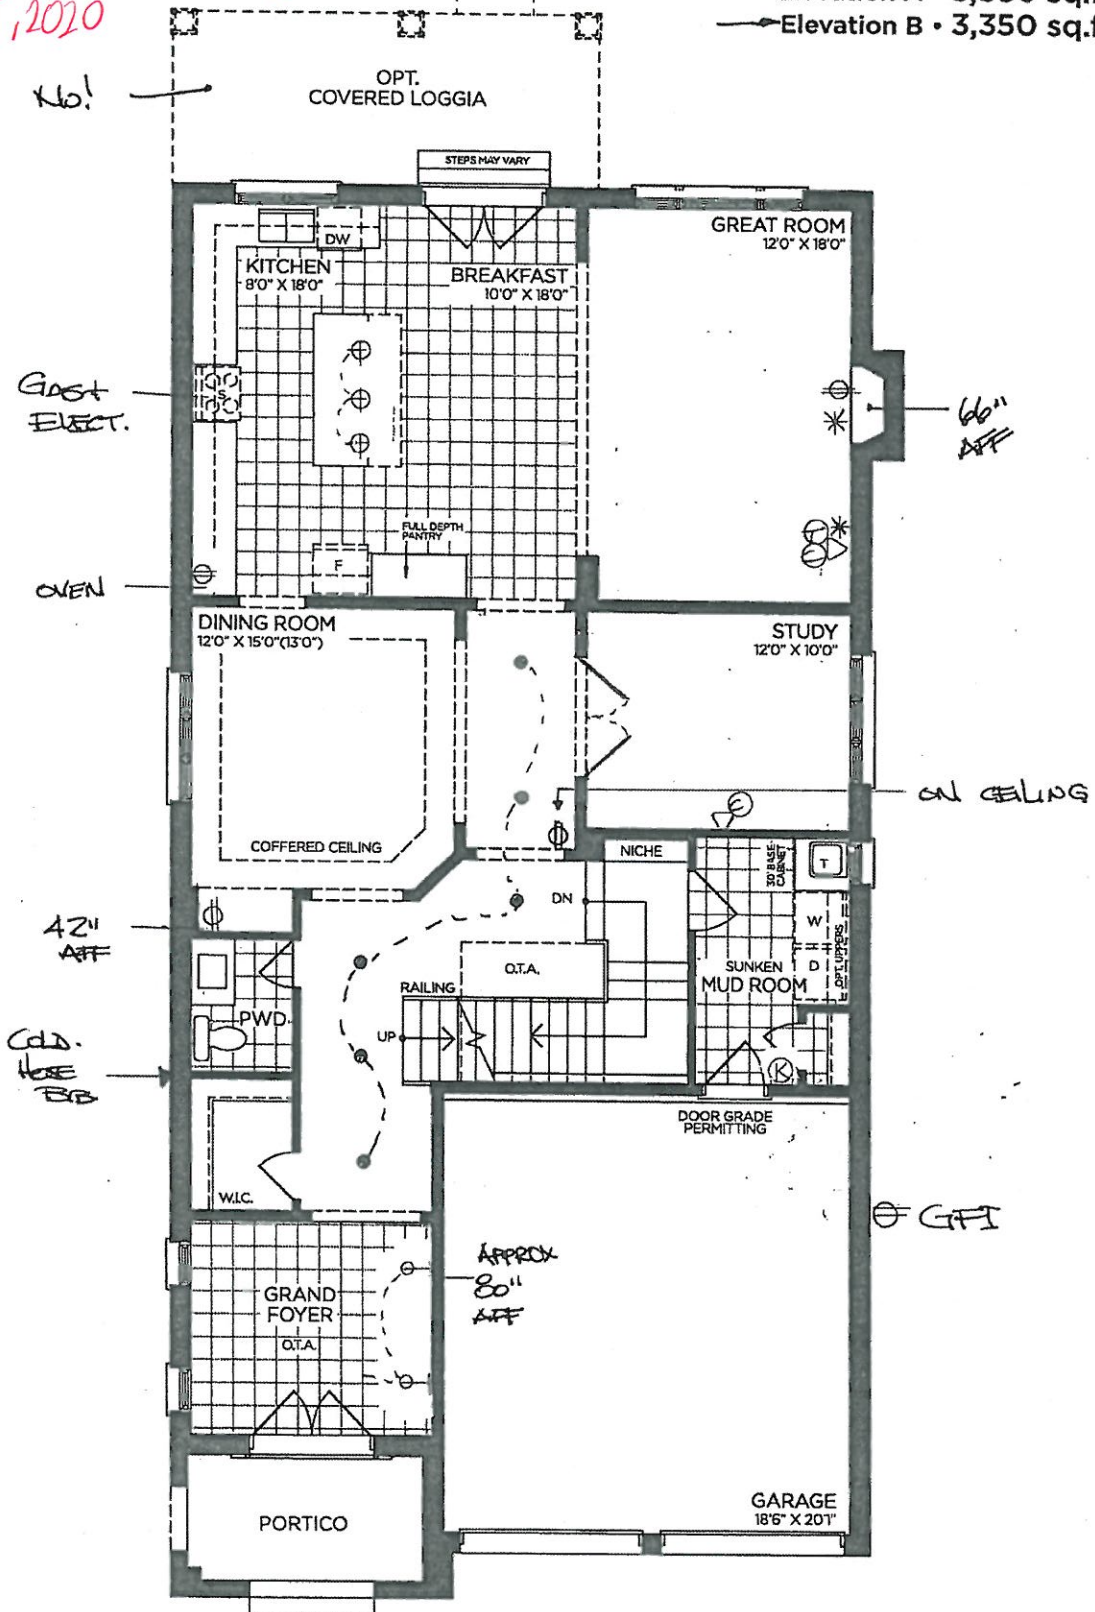

GROUND FLOOR | ELEV. A

VENDOR

PURCHASER

PURCHASER

GOLDPARK
WORTH MORE™

Prices, figures, illustrations, sizes, features and finishes are subject to change without notice. Areas and dimensions are approximate and actual usable floor space may vary from the stated area. Layout may be reverse of the unit purchased. E. & O.E. 4003


SCHEDULE 'F'



PV-157 *see attached*
April 13 2020
MAY 11 2020 *see attached*
PV-157 *see attached*
NOV. 25, 2020

The
Brookside
40' SERIES
Elevation A • 3,380 sq.ft.
Elevation B • 3,350 sq.ft.

REVISED
NOV. 25, 2020
DELETE CLOSET

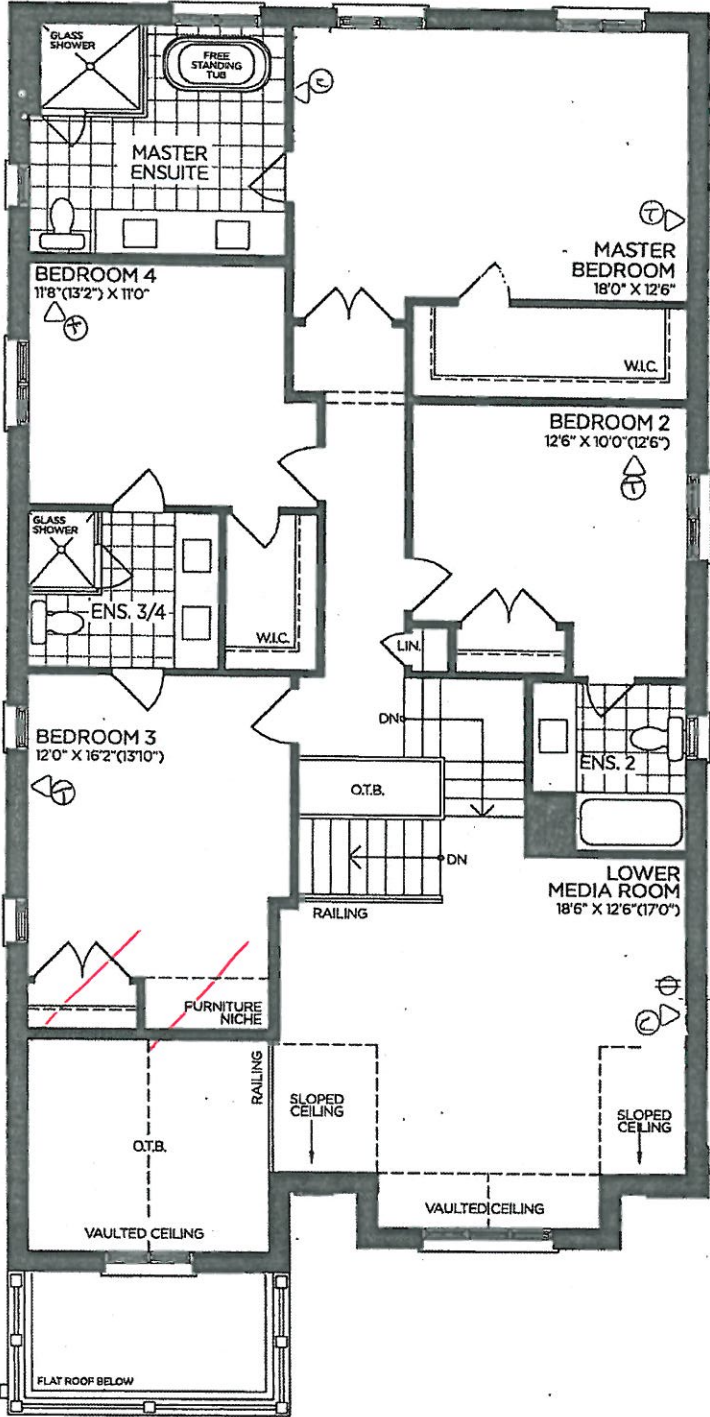

SECOND FLOOR | ELEV. A

VENDOR

PURCHASER

PURCHASER

GOLDPARK
WORTH MORE™

Prices, figures, illustrations, sizes, features and finishes are subject to change without notice. Areas and dimensions are approximate and actual usable floor space may vary from the stated area. Layout may be reverse of the unit purchased. E. & O.E. 4003

SCHEDULE 'F'




The Brookside

40' SERIES

Elevation A • 3,380 sq.ft.
Elevation B • 3,350 sq.ft.

7V-157 *see attached*
APRIL 13 2020
MAY 11 2020 *see attached*
PV-157 *see attached*
NOV. 25, 2020 *see attached*
47x35" 47x35"

24x30"

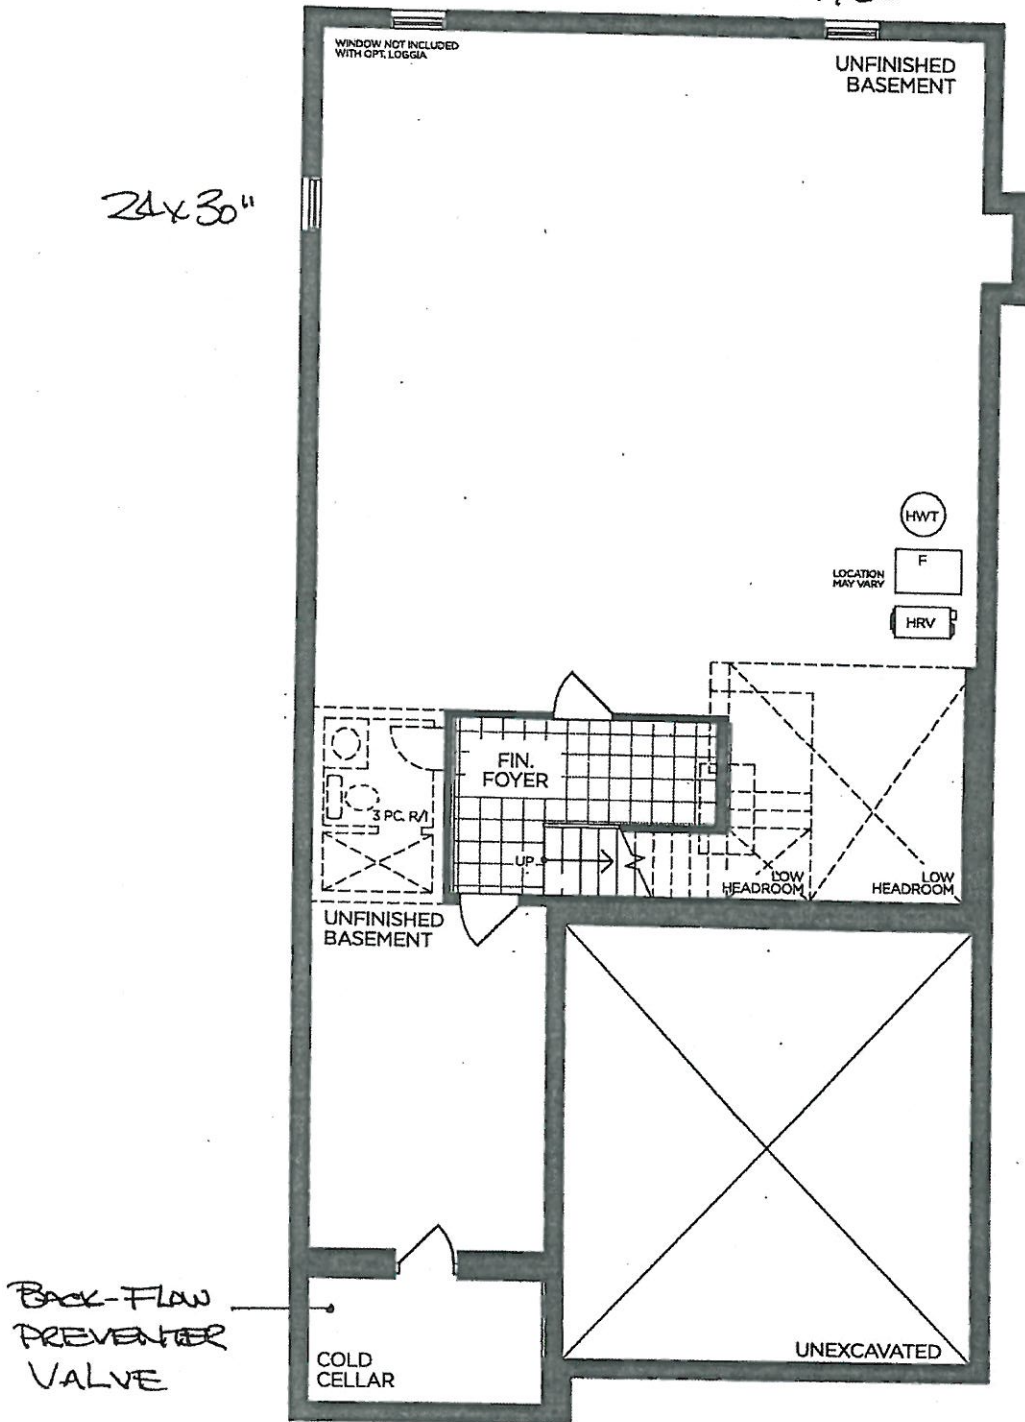

BASEMENT | ELEV. A

VENDOR

PURCHASER

PURCHASER

GOLDPARK
WORTH MORE™

Prices, figures, illustrations, sizes, features and finishes are subject to change without notice. Areas and dimensions are approximate and actual usable floor space may vary from the stated area. Layout may be reverse of the unit purchased. E. & O.E. 4003

SCHEDULE 'F'




PV-157 ^{see attached}
MAY 11 2020


PV-157 ^{*see attached*}
NOV. 25, 2020

The Brookside
40' SERIES


Elevation A • 3,380 sq.ft.
→ Elevation B • 3,350 sq.ft.

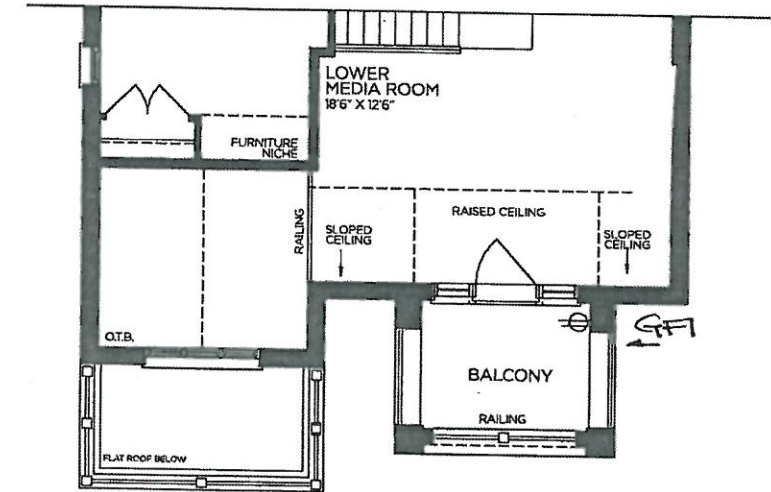


→ PART. SECOND FLOOR | ELEV. B

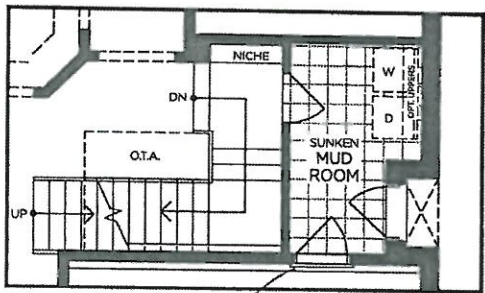

PART. OPT. GROUND FLOOR
W/ OPT. SIDE ENTRANCE | ELEV. A
(ELEV. B SIMILAR)

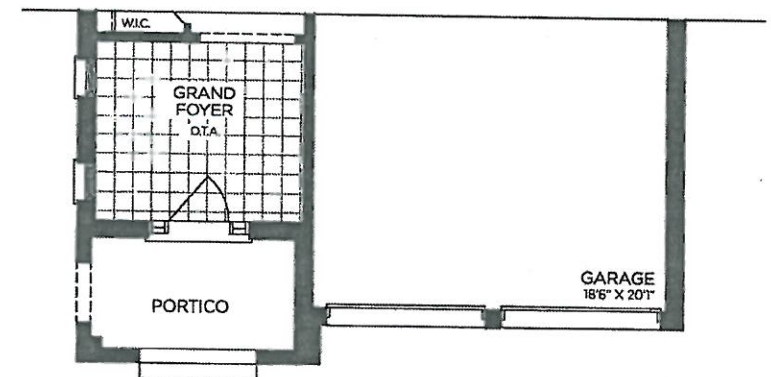

→ PART. GROUND FLOOR | ELEV. B

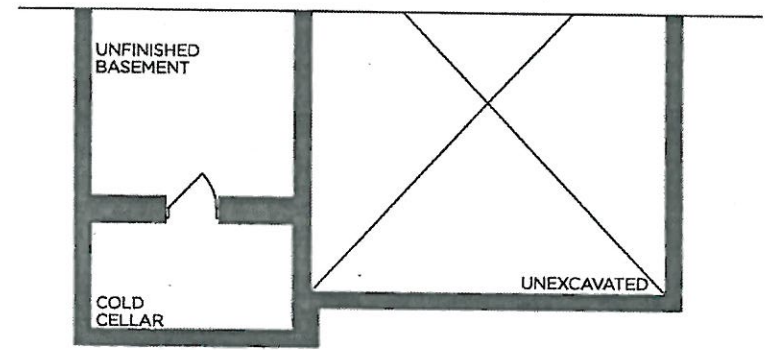

→ PART. BASEMENT | ELEV. B

VENDOR

PURCHASER

PURCHASER

GOLDPARK
WORTH MORE™

Prices, figures, illustrations, sizes, features and finishes are subject to change without notice. Areas and dimensions are approximate and actual usable floor space may vary from the stated area. Layout may be reverse of the unit purchased. E. & O.E. 4003