

GOLDPARK

WORTH MORE™

CONSTRUCTION SUMMARY

Lot: 156

Model: 40.01 B SUMMERDALE

Project/Phase: Pine Valley Forevergreen / 1

BASEMENT WINDOWS

Invoice	Qty.	Description
2492 72,351 01Dec20	2	BASEMENT WINDOWS - UPGRADE BASEMENT WINDOW SIZE TO 30 " X 24" - 8" FRAME

CONCRETE AND DRAIN

Invoice	Qty.	Description
2492 01Dec20 NoCat	1	BACK-FLOW PREVENTER VALVE

DRYWALL

Invoice	Qty.	Description
2492 72,351 01Dec20 **	2	BASEMENT WINDOWS - UPGRADE BASEMENT WINDOW SIZE TO 30 " X 24" - 8" FRAME
2492 72,324 01Dec20 **	2	GARAGE DOOR OPENER (CHAMBERLAIN BELT DRIVE) - WITH 1 REMOTE - PRICE IS PER DOOR
2492 01Dec20 ** NoCat	2	GARAGE DOOR OPENER (CHAMBERLAIN BELT DRIVE) - WITH 1 REMOTE - PRICE IS PER DOOR

DisciplineMS.rpt 26jun20

Page 1 of 6
Printed and Sent: 01-Dec-20

**Lot: 156****Model: 40.01 B SUMMERDALE****Project/Phase: Pine Valley Forevergreen / 1**

ELECTRICAL

Invoice	Qty.	Description
2492 72,280 01Dec20	1	COMPUTER NICHE: CEILING OUTLET: ADDITIONAL REINFORCED CEILING OUTLET - SEE PLAN FOR APPROX LOCATION
2492 72,278 01Dec20	1	COMPUTER NICHE: ADDITIONAL INTERIOR SWITCH FOR LIGHT IN LOFT
2492 01Dec20 NoCat	1	BREAKFAST: UPGRADE EXTERIOR GARDEN DOOR ASSEMBLY TO 96"

FORM - FORMING

Invoice	Qty.	Description
2492 72,351 01Dec20 **	2	BASEMENT WINDOWS - UPGRADE BASEMENT WINDOW SIZE TO 30 " X 24" - 8" FRAME

FRAMING

Invoice	Qty.	Description
2492	1	BREAKFAST: UPGRADE EXTERIOR GARDEN DOOR ASSEMBLY TO 96"
01Dec20 NoCat		

GARAGE DOORS

Invoice	Qty.	Description
2492 72,324 01Dec20	2	GARAGE DOOR OPENER (CHAMBERLAIN BELT DRIVE) - WITH 1 REMOTE - PRICE IS PER DOOR
2492 72,323 01Dec20	1	GARAGE: WIRELESS KEYPAD GARAGE DOOR ENTRY 877LM
2492 01Dec20 ** NoCat	2	GARAGE DOOR OPENER (CHAMBERLAIN BELT DRIVE) - WITH 1 REMOTE - PRICE IS PER DOOR

GOLDPARK

WORTH MORE™

CONSTRUCTION SUMMARY

Lot: 156

Model: 40.01 B SUMMERDALE

Project/Phase: Pine Valley Forevergreen / 1

NETWORK AND WIRING

Invoice	Qty.	Description
2492 72,259 01Dec20	1	FAMILY ROOM: CONDUIT PIPE - FOR WALL MOUNT TV - LOCATE APPROX 66" A.F.F. ABOVE FIREPLACE, THRU BASEMENT, TERMINATING AT CABLE LOCATION. SEE PLAN FOR LOCATION
2492 72,258 01Dec20	2	FAMILY ROOM + COMPUTER STUDY: ADDITIONAL CAT6 ETHERNET OUTLET - EACH SEE PLAN FOR LOCATION
2492 72,264 01Dec20	1	LAUNDRY: ROUGH - IN FOR EXTRA SECURITY KEY PAD
2492 01Dec20 NoCat	1	GARAGE: WIRELESS KEYPAD GARAGE DOOR ENTRY 877LM

PAINTING

Invoice	Qty.	Description
2492 72,351 01Dec20 **	2	BASEMENT WINDOWS - UPGRADE BASEMENT WINDOW SIZE TO 30 " X 24" - 8" FRAME

PANL - FRAMING

Invoice	Qty.	Description
2492 72,351 01Dec20 **	2	BASEMENT WINDOWS - UPGRADE BASEMENT WINDOW SIZE TO 30 " X 24" - 8" FRAME
2492 72,324 01Dec20 **	2	GARAGE DOOR OPENER (CHAMBERLAIN BELT DRIVE) - WITH 1 REMOTE - PRICE IS PER DOOR
2492 01Dec20 ** NoCat	2	GARAGE DOOR OPENER (CHAMBERLAIN BELT DRIVE) - WITH 1 REMOTE - PRICE IS PER DOOR

PLUMBING

Invoice	Qty.	Description
2492 72,332 01Dec20	1	KITCHEN: ROUGH-IN 1/4" COLD WATER LINE TO FRIDGE
2492 01Dec20 NoCat	1	BACK-FLOW PREVENTER VALVE

DisciplineMS.rpt 26jun20

Page 5 of 6
Printed and Sent: 01-Dec-20

**Lot: 156****Model: 40.01 B SUMMERDALE****Project/Phase: Pine Valley Forevergreen / 1**

ROUGH CARPENTRY

Invoice	Qty.	Description
2492 72,351 01Dec20 **	2	BASEMENT WINDOWS - UPGRADE BASEMENT WINDOW SIZE TO 30 " X 24" - 8" FRAME

WINDOWS - BASEMENT

Invoice	Qty.	Description
2492 72,351 01Dec20 **	2	BASEMENT WINDOWS - UPGRADE BASEMENT WINDOW SIZE TO 30 " X 24" - 8" FRAME

WINDOWS AND DOORS

Invoice	Qty.	Description
2492	1	BREAKFAST: UPGRADE EXTERIOR GARDEN DOOR ASSEMBLY TO 96"
01Dec20 NoCat		

SCHEDULE 'F'




PV-156
NOV 23 2020
* See attach. *

The
Summerdale
40' SERIES

Elevation A • 2,895 sq.ft.

→ Elevation B • 2,880 sq.ft.

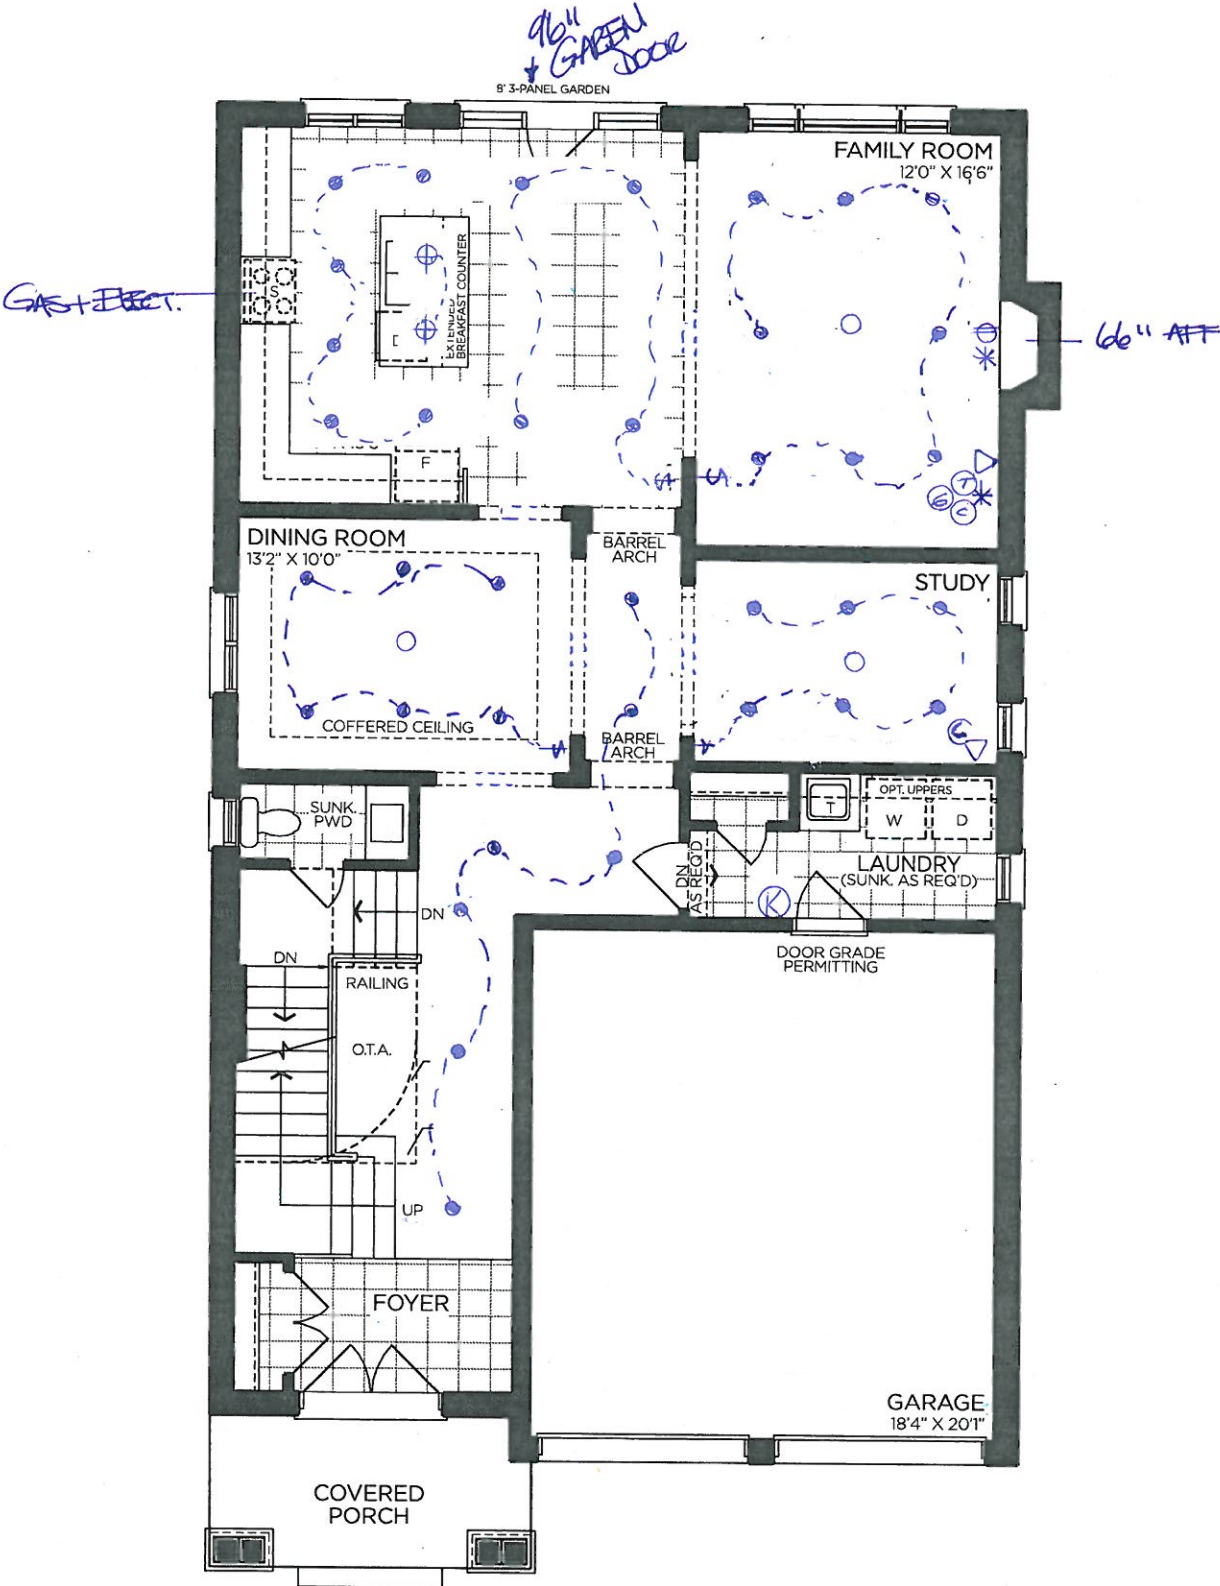

GROUND FLOOR | ELEV. A

VENDOR

PURCHASER

PURCHASER

GOLDPARK
WORTH MORE™

Prices, figures, illustrations, sizes, features and finishes are subject to change without notice. Areas and dimensions are approximate and actual usable floor space may vary from the stated area. Layout may be reverse of the unit purchased. E. & O.E. 4001

SCHEDULE 'F'



PV-156
Nov. 23, 2020.


* See attach *

The Summerdale

40' SERIES

Elevation A • 2,895 sq.ft.

Elevation B • 2,880 sq.ft.

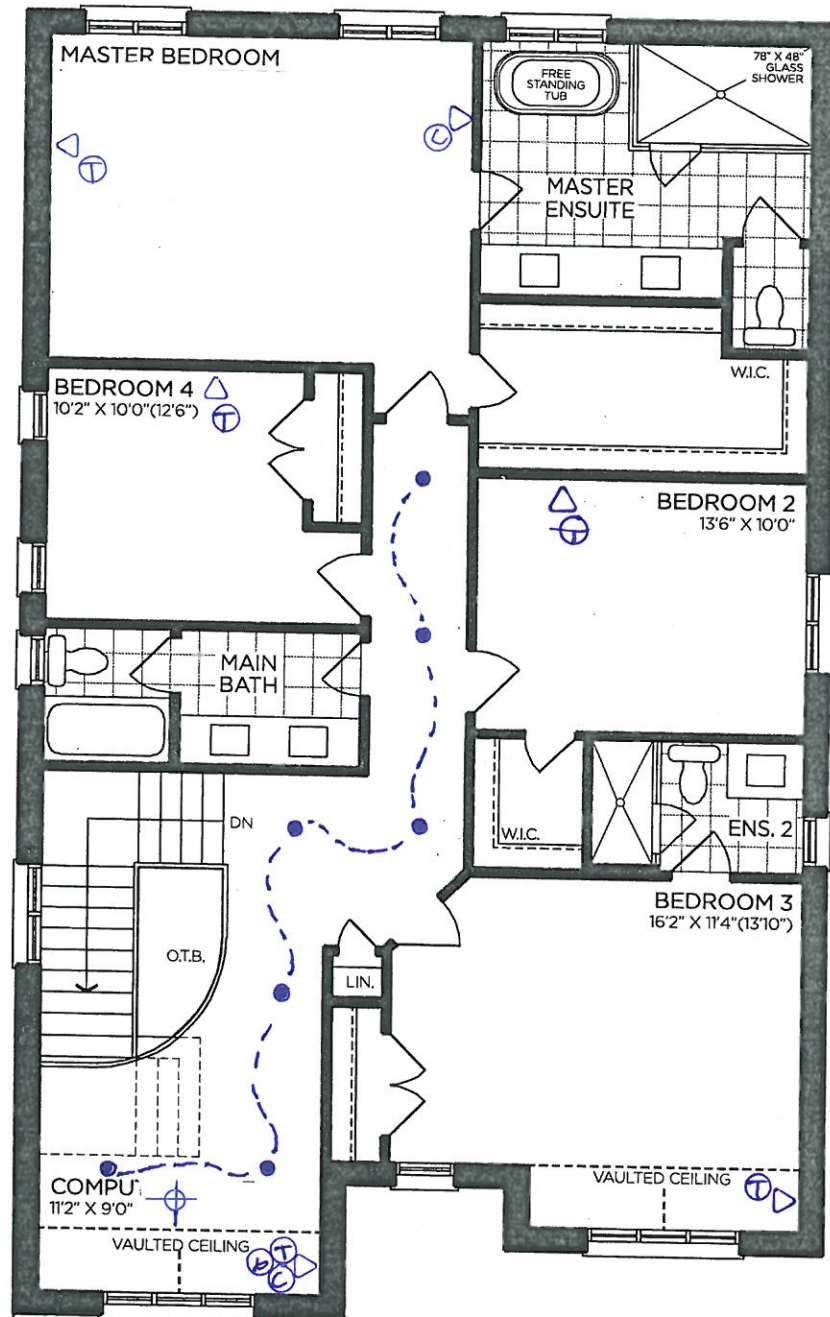

SECOND FLOOR | ELEV. A

VENDOR	
PURCHASER	
PURCHASER	

GOLDPARK
WORTH MORE™


Prices, figures, illustrations, sizes, features and finishes are subject to change without notice. Areas and dimensions are approximate and actual usable floor space may vary from the stated area. Layout may be reverse of the unit purchased. E. & O.E. 4001

SCHEDULE 'F'



See attach.
PV-156
Nov 23 2020

The
Summerdale
40' SERIES
Elevation A • 2,895 sq.ft.
Elevation B • 2,880 sq.ft.

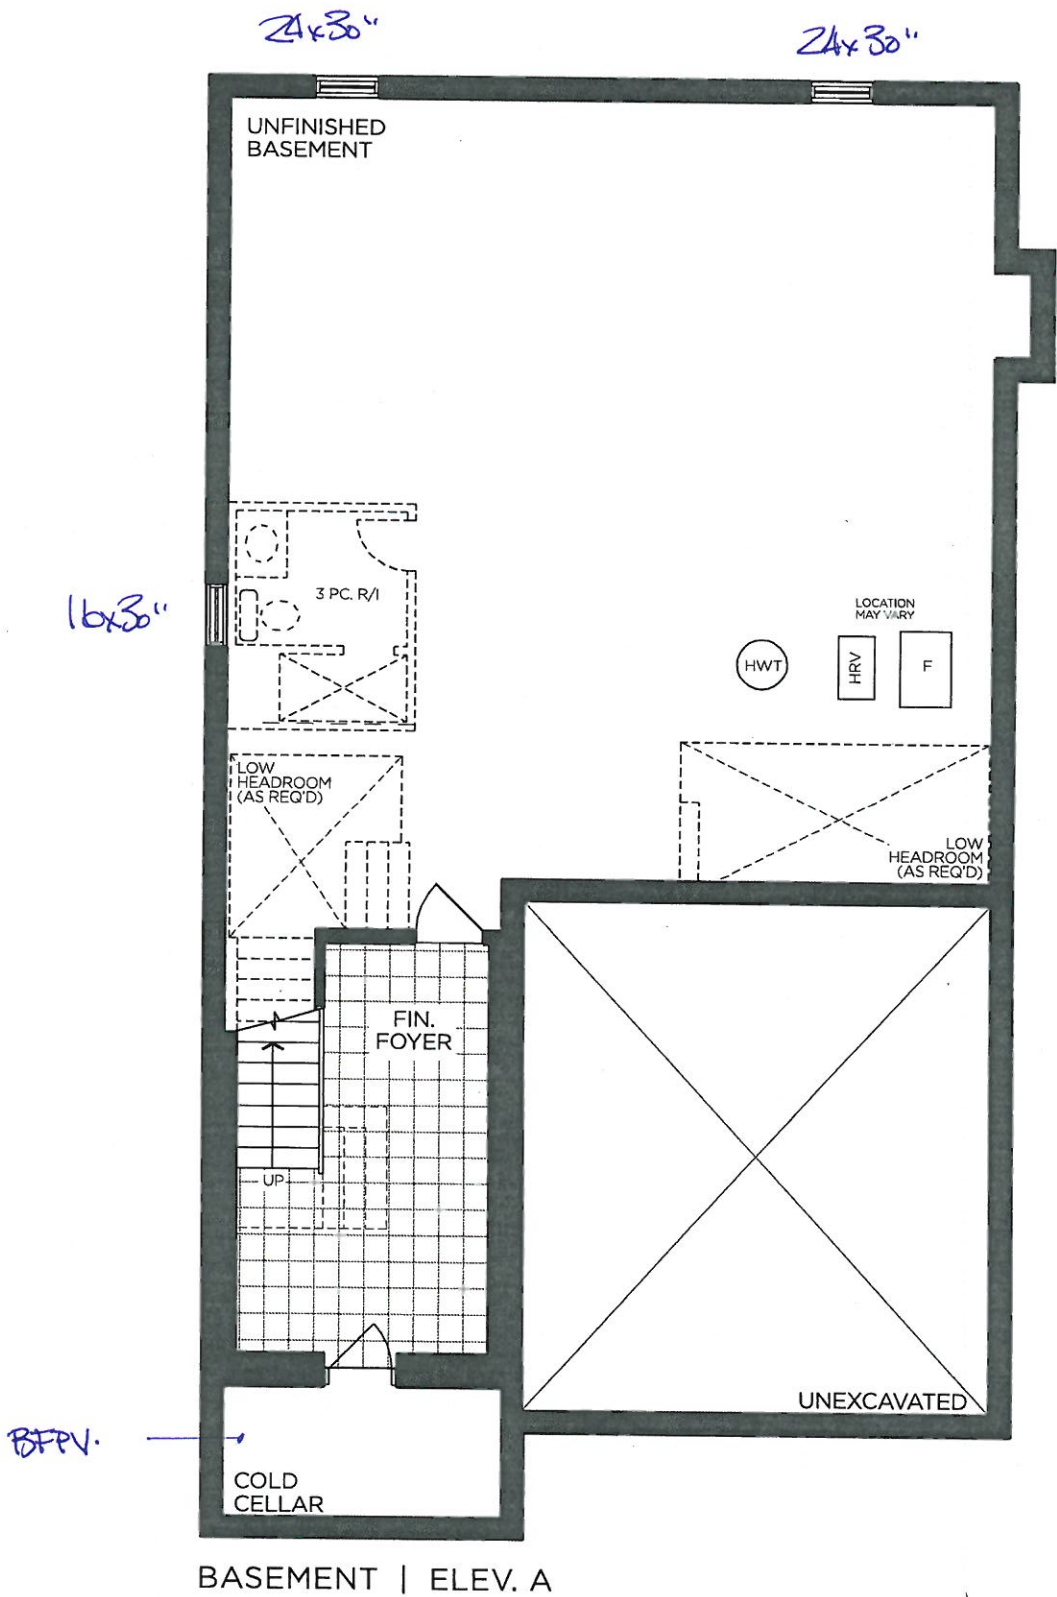

VENDOR

PURCHASER

PURCHASER

GOLDPARK
WORTH MORE™

Prices, figures, illustrations, sizes, features and finishes are subject to change without notice. Areas and dimensions are approximate and actual usable floor space may vary from the stated area. Layout may be reverse of the unit purchased. E. & O.E. 4001

SCHEDULE 'F'



PV-156

Nov 23 2020


see attach.

The Summerdale


40' SERIES

Elevation A • 2,895 sq.ft.


→ Elevation B • 2,880 sq.ft.

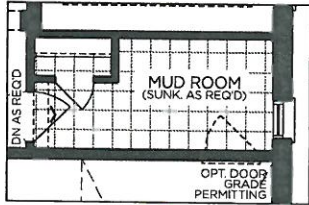


PART. GROUND FLOOR
MUDROOM FOR OPT.
SECOND FLOOR LAUNDRY

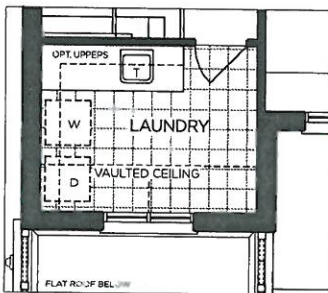


PART. SECOND FLOOR
W/ OPT. LAUNDRY
ELEV. B

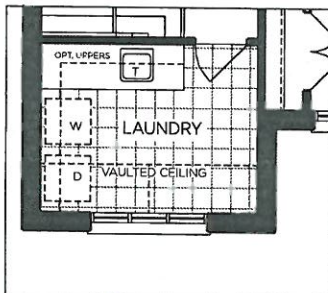


PART. SECOND FLOOR
W/ OPT. LAUNDRY
ELEV. A

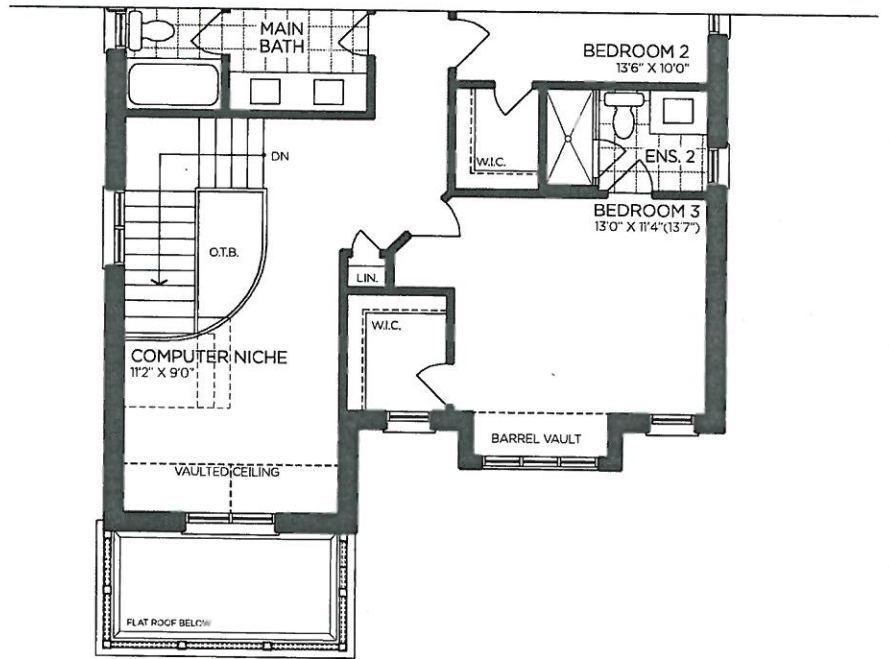

→ PART. SECOND FLOOR | ELEV. B

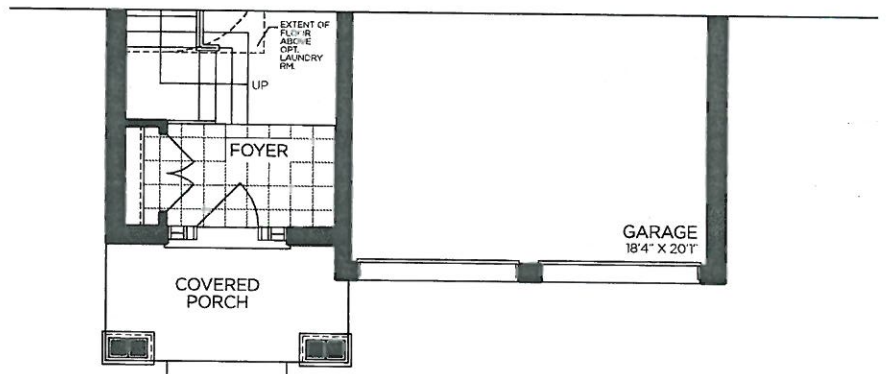

→ PART. GROUND FLOOR | ELEV. B

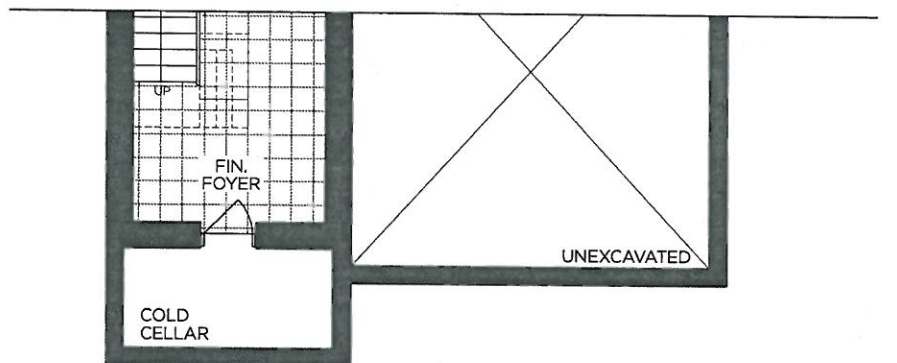

→ PART. BASEMENT | ELEV. B

VENDOR

PURCHASER

PURCHASER

GOLDPARK
WORTH MORE™

Prices, figures, illustrations, sizes, features and finishes are subject to change without notice. Areas and dimensions are approximate and actual usable floor space may vary from the stated area. Layout may be reverse of the unit purchased. E. & O.E. 4001