

CERAMIC

Invoice	Qty.	Description
2392 15Jun20 NoCat	1	.SHOWER NICHE [SHAMPOO SHELF] - COMPLETE WITH MATCHING MARBLE JAMBS ON 4 SIDES, STANDARD TILE, APPROX. 12 X 18 INSTALLED VERTICALLY - MUST SPECIFY LOCATION

CONCRETE AND DRAIN

Invoice	Qty.	Description
2262 15Jun20 NoCat	1	.BACK-FLOW PREVENTER VALVE

CROWN MOULDING

Invoice	Qty.	Description
2392 15Jun20 NoCat	1	.GREAT ROOM - OPT. COFFERED CEILING AS PER PLAN
2392 15Jun20 NoCat	1	.STUDY - OPT. COFFERED CEILING AS PER PLAN

DRYWALL

Invoice	Qty.	Description
2392 15Jun20 NoCat	1	.GREAT ROOM - OPT. COFFERED CEILING AS PER PLAN
2392 15Jun20 NoCat	1	.GREAT ROOM - OPT. WAFFLE CEILING , BEAM DETAIL AS PER PLAN (6 BOXES) OPTION # 1 CTR-B07
2392 15Jun20 NoCat	1	.STUDY - OPT. COFFERED CEILING AS PER PLAN
2392 15Jun20 NoCat	1	.STUDY- OPT. WAFFLE CEILING , BEAM DETAIL AS PER PLAN (4 BOXES) OPTION # 1 CTR-B07
2392 15Jun20 NoCat	1	.STUDY - OPT. 8 FOOT HIGH DOUBLE FRENCH DOORS WITH FLAT CLEAR GLASS COMPLETE WITH BUILDERS STANDARD OFFERINGS
2392 15Jun20 NoCat	2	.BREAKFAST ROOM: UPGRADE EXTERIOR FRENCH DOORS TO 96" HEIGHT
2392 15Jun20 NoCat	16	.INCREASE HEIGHT OF DOOR TO 8FT SECOND FLOOR - PER DOOR

DRYWALL

Invoice Qty. Description

2392	1	.MASTER BEDROOM - OPT. 10 FOOT TRAY CEILING
15Jun20 NoCat		

2534	1	.**CUSTOM LAYOUT** MASTER BEDROOM/BEDROOM 2 - DELETE UPPER HALL LINEN CLOSET + REACH IN CLOSET AT BEDROOM 2. CREATE 1 LARGE DRESSING ROOM BY COMBINING MASTER WIC AND BEDROOM 2, COMPLETE WITH SINGLE POCKET DOOR - SEE PLAN FOR LAYOUT CUSTOM CABINETRY NOT INCLUDED - TO BE PRICED SEPARATELY AT COLOUR APPOINTMENT
21Dec20 NoCat		

ELECTRICAL

Invoice	Qty.	Description
2392 72,281 15Jun20	1	.GREAT ROOM: INTERIOR WALL OUTLET: ADDITIONAL 110V WALL INTERIOR RECEPTACLE ON EXISTING CIRCUIT FOR WALL MOUNTED TV - LOCATE APPROX 66" A.F.F. ABOVE FIREPLACE
2392 72,289 15Jun20	5	.MAIN HALL: 4" E/S LED INTERIOR POT LIGHT - GROUND FLOOR - EACH USE STANDARD SWITCHES
2392 72,309 15Jun20	2	.MAIN HALL: UPGRADE STANDARD CEILING MOUNT FIXTURE TO (1) LED POT LIGHT - GROUND FLOOR -
2392 72,289 15Jun20	3	.STUDY: 4" E/S LED INTERIOR POT LIGHT - GROUND FLOOR - EACH USE STANDARD SWITCH
2392 72,309 15Jun20	1	.STUDY: UPGRADE STANDARD CEILING MOUNT FIXTURE TO (1) LED POT LIGHT - GROUND FLOOR - SEE PLAN FOR LOCATION
2392 72,309 15Jun20	1	.MAIN HALL (AT STUDY): UPGRADE STANDARD CEILING MOUNT FIXTURE TO (1) LED POT LIGHT - GROUND FLOOR
2392 72,289 15Jun20	2	.HALL (AT STUDY) 4" E/S LED INTERIOR POT LIGHT - GROUND FLOOR - EACH
2392 72,307 15Jun20	1	.KITCHEN: FIXTURE: RELOCATE STANDARD CEILING MOUNT FIXTURE - ABOVE ISLAND
2392 72,280 15Jun20	1	.KITCHEN; CEILING OUTLET: ADDITIONAL REINFORCED CEILING OUTLET - LOCATE ABOVE ISLAND, USE SAME SWITCH AS STANDARD LIGHT
2392 72,303 15Jun20	1	.KITCHEN; FIXTURE: UNDER CABINET FLUORESCENT LIGHT FIXTURES - DOES NOT INCLUDE (AND REQUIRES) LIGHT VALANCE
2392 72,275 15Jun20	1	.KITCHEN; 240V WALL RECEPTACLE ON SEPARATE CIRCUIT FOR FUTURE WALL OVENS - APPLIANCE NOT INCLUDED
2392 72,273 15Jun20	1	.KITCHEN: 110V WALL RECEPTACLE ON SEPARATE CIRCUIT - GAS FIRED APPLIANCE - FOR AUX. EQUIPMENT - NOT A STOVE PLUG
2392 72,289 15Jun20	6	.KITCHEN: 4" E/S LED INTERIOR POT LIGHT - GROUND FLOOR - EACH INCLUDED IN APS - INCLUDES 1 SWITCH

ELECTRICAL

Invoice Qty. Description

2392 72,289 15Jun20	2	.KITCHEN: 4" E/S LED INTERIOR POT LIGHT - GROUND FLOOR - EACH SAME SWITCH AS STANDARD
2392 72,310 15Jun20	2	.UPPER HALL: UPGRADE STANDARD CEILING MOUNT FIXTURE TO (1) LED POT LIGHT - SECOND FLOOR -
2392 72,290 15Jun20	3	.4" E/S LED INTERIOR POT LIGHT (INSULATED CEILING) - SECOND FLOOR - EACH

EXTERIOR COLOURS

Invoice Qty. Description

2392 15Jun20 NoCat	1	EXTERIOR COLOUR PKG # BR. 4
------------------------------	---	-----------------------------

FORMING

Invoice Qty. Description

2262 72,672 15Jun20	2	DELETE **.BASEMENT WINDOWS - EGRESS BASEMENT WINDOW 47 " X 35" - 8" FRAME
2262 15Jun20 NoCat	3	.BASEMENT WINDOWS - UPGRADE BASEMENT WINDOW SIZE TO 30 " X 24" - 8" FRAME

FRAMING

Invoice	Qty.	Description
2262 15Jun20 NoCat	3	.BASEMENT WINDOWS - UPGRADE BASEMENT WINDOW SIZE TO 30 " X 24" - 8" FRAME
2392 72,398 15Jun20	1	.GREAT ROOM - OPT. COFFERED CEILING AS PER PLAN
2392 72,397 15Jun20	1	.GREAT ROOM - OPT. WAFFLE CEILING , BEAM DETAIL AS PER PLAN (6 BOXES) OPTION # 1 CTR-B07
2392 72,401 15Jun20	1	.STUDY - OPT. COFFERED CEILING AS PER PLAN
2392 72,400 15Jun20	1	.STUDY- OPT. WAFFLE CEILING , BEAM DETAIL AS PER PLAN (4 BOXES) OPTION # 1 CTR-B07
2392 72,402 15Jun20	1	.STUDY - OPT. 8 FOOT HIGH DOUBLE FRENCH DOORS WITH FLAT CLEAR GLASS COMPLETE WITH BUILDERS STANDARD OFFERINGS
2392 72,404 15Jun20	1	.MASTER BEDROOM - OPT. 10 FOOT TRAY CEILING
2392 72,631 15Jun20	1	.SHOWER NICHE [SHAMPOO SHELF] - COMPLETE WITH MATCHING MARBLE JAMBS ON 4 SIDES, STANDARD TILE, APPROX. 12 X 18 INSTALLED VERTICALLY - MUST SPECIFY LOCATION
2392 72,644 15Jun20	16	.INCREASE HEIGHT OF DOOR TO 8FT SECOND FLOOR - PER DOOR
2392 15Jun20 NoCat	2	**DELETE** BASEMENT WINDOWS - EGRESS BASEMENT WINDOW 47 " X 35" - 8" FRAME
2392 15Jun20 NoCat	2	.BREAKFAST ROOM: UPGRADE EXTERIOR FRENCH DOORS TO 96" HEIGHT
2534 21Dec20 NoCat	1	**CUSTOM LAYOUT** MASTER BEDROOM/BEDROOM 2 - DELETE UPPER HALL LINEN CLOSET + REACH IN CLOSET AT BEDROOM 2. CREATE 1 LARGE DRESSING ROOM BY COMBINING MASTER WIC AND BEDROOM 2, COMPLETE WITH SINGLE POCKET DOOR - SEE PLAN FOR LAYOUT CUSTOM CABINETRY NOT INCLUDED - TO BE PRICED SEPARATELY AT COLOUR APPOINTMENT

HVAC

Invoice Qty. Description

2392 72,224 15Jun20	1	.KITCHEN: GAS LINE ROUGH-IN - MAIN FLOOR FOR APPLIANCE - SEE PLAN FOR LOCATION
---------------------------	---	--

INTERIOR TRIM AND DOORS

Invoice Qty. Description

2392 15Jun20 NoCat	1	.GREAT ROOM - OPT. COFFERED CEILING AS PER PLAN
2392 15Jun20 NoCat	1	.GREAT ROOM - OPT. WAFFLE CEILING , BEAM DETAIL AS PER PLAN (6 BOXES) OPTION # 1 CTR-B07
2392 15Jun20 NoCat	1	.STUDY - OPT. COFFERED CEILING AS PER PLAN
2392 15Jun20 NoCat	1	.STUDY- OPT. WAFFLE CEILING , BEAM DETAIL AS PER PLAN (4 BOXES) OPTION # 1 CTR-B07
2392 15Jun20 NoCat	1	.STUDY - OPT. 8 FOOT HIGH DOUBLE FRENCH DOORS WITH FLAT CLEAR GLASS COMPLETE WITH BUILDERS STANDARD OFFERINGS
2392 15Jun20 NoCat	16	.INCREASE HEIGHT OF DOOR TO 8FT SECOND FLOOR - PER DOOR
2392 15Jun20 NoCat	1	.MASTER BEDROOM - OPT. 10 FOOT TRAY CEILING
2534 21Dec20 NoCat	1	.**CUSTOM LAYOUT** MASTER BEDROOM/BEDROOM 2 - DELETE UPPER HALL LINEN CLOSET + REACH IN CLOSET AT BEDROOM 2. CREATE 1 LARGE DRESSING ROOM BY COMBINING MASTER WIC AND BEDROOM 2, COMPLETE WITH SINGLE POCKET DOOR - SEE PLAN FOR LAYOUT CUSTOM CABINETS NOT INCLUDED - TO BE PRICED SEPARATELY AT COLOUR APPOINTMENT

NETWORK AND WIRING

Invoice Qty. Description

2392 72,259 15Jun20	1	.GREAT ROOM: CONDUIT PIPE - FOR WALL MOUNT TV - LOCATE APPROX. 66" A.F.F. ABOVE FIREPLACE, TERMINATING AT CABLE LOCATION SEE PLAN
---------------------------	---	---

PAINT

Invoice	Qty.	Description
2392 15Jun20 NoCat	1	.GREAT ROOM - OPT. COFFERED CEILING AS PER PLAN
2392 15Jun20 NoCat	1	.GREAT ROOM - OPT. WAFFLE CEILING , BEAM DETAIL AS PER PLAN (6 BOXES) OPTION # 1 CTR-B07
2392 15Jun20 NoCat	1	.STUDY - OPT. COFFERED CEILING AS PER PLAN
2392 15Jun20 NoCat	1	.STUDY- OPT. WAFFLE CEILING , BEAM DETAIL AS PER PLAN (4 BOXES) OPTION # 1 CTR-B07
2392 15Jun20 NoCat	1	.STUDY - OPT. 8 FOOT HIGH DOUBLE FRENCH DOORS WITH FLAT CLEAR GLASS COMPLETE WITH BUILDERS STANDARD OFFERINGS
2392 15Jun20 NoCat	16	.INCREASE HEIGHT OF DOOR TO 8FT SECOND FLOOR - PER DOOR
2392 15Jun20 NoCat	1	.MASTER BEDROOM - OPT. 10 FOOT TRAY CEILING
2534 21Dec20 NoCat	1	.**CUSTOM LAYOUT** MASTER BEDROOM/BEDROOM 2 - DELETE UPPER HALL LINEN CLOSET + REACH IN CLOSET AT BEDROOM 2. CREATE 1 LARGE DRESSING ROOM BY COMBINING MASTER WIC AND BEDROOM 2, COMPLETE WITH SINGLE POCKET DOOR - SEE PLAN FOR LAYOUT CUSTOM CABINETRY NOT INCLUDED - TO BE PRICED SEPARATELY AT COLOUR APPOINTMENT

PLUMBING

Invoice	Qty.	Description
2262 15Jun20 NoCat	1	.BACK-FLOW PREVENTER VALVE
2392 15Jun20 NoCat	1	.MASTER ENSUITE: MOEN `ARRIS` POSI-TEMP 3-FUNCTION RAIN SHOWER (from ceiling) + HAND SHOWER + SLIDE BAR - CHROME #TS22002EP/3372/TS23005/62320/3887EP/A725

PLUMBING FIXTURES

Invoice	Qty.	Description
2392 15Jun20 NoCat	1	.MASTER ENSUITE: MOEN `ARRIS` POSI-TEMP 3-FUNCTION RAIN SHOWER (from ceiling) + HAND SHOWER + SLIDE BAR - CHROME #TS22002EP/3372/TS23005/62320/3887EP/A725

WINDOWS - BASEMENT

Invoice	Qty.	Description
2262 72,351 15Jun20	1	.BASEMENT WINDOWS - UPGRADE BASEMENT WINDOW SIZE TO 30 " X 24" - 8" FRAME
2392 72,672 15Jun20	2	**DELETE** BASEMENT WINDOWS - EGRESS BASEMENT WINDOW 47 " X 35" - 8" FRAME INV # 2262
2392 72,351 15Jun20	2	.BASEMENT WINDOWS - UPGRADE BASEMENT WINDOW SIZE TO 30 " X 24" - 8" FRAME

WINDOWS AND DOORS

Invoice	Qty.	Description
2392 15Jun20 NoCat	2	.BREAKFAST ROOM: UPGRADE EXTERIOR FRENCH DOORS TO 96" HEIGHT

UB¹¹ LOT 116
AS BUILT

SCHEDULE 'F'

JUNE 15 2020

PV-116

APRIL 1 2020




PV-116

Dec. 17, 2020.

see attach.

The Brookside
40' SERIES

Elevation A - 3,380 sq.ft.
Elevation B - 3,350 sq.ft.

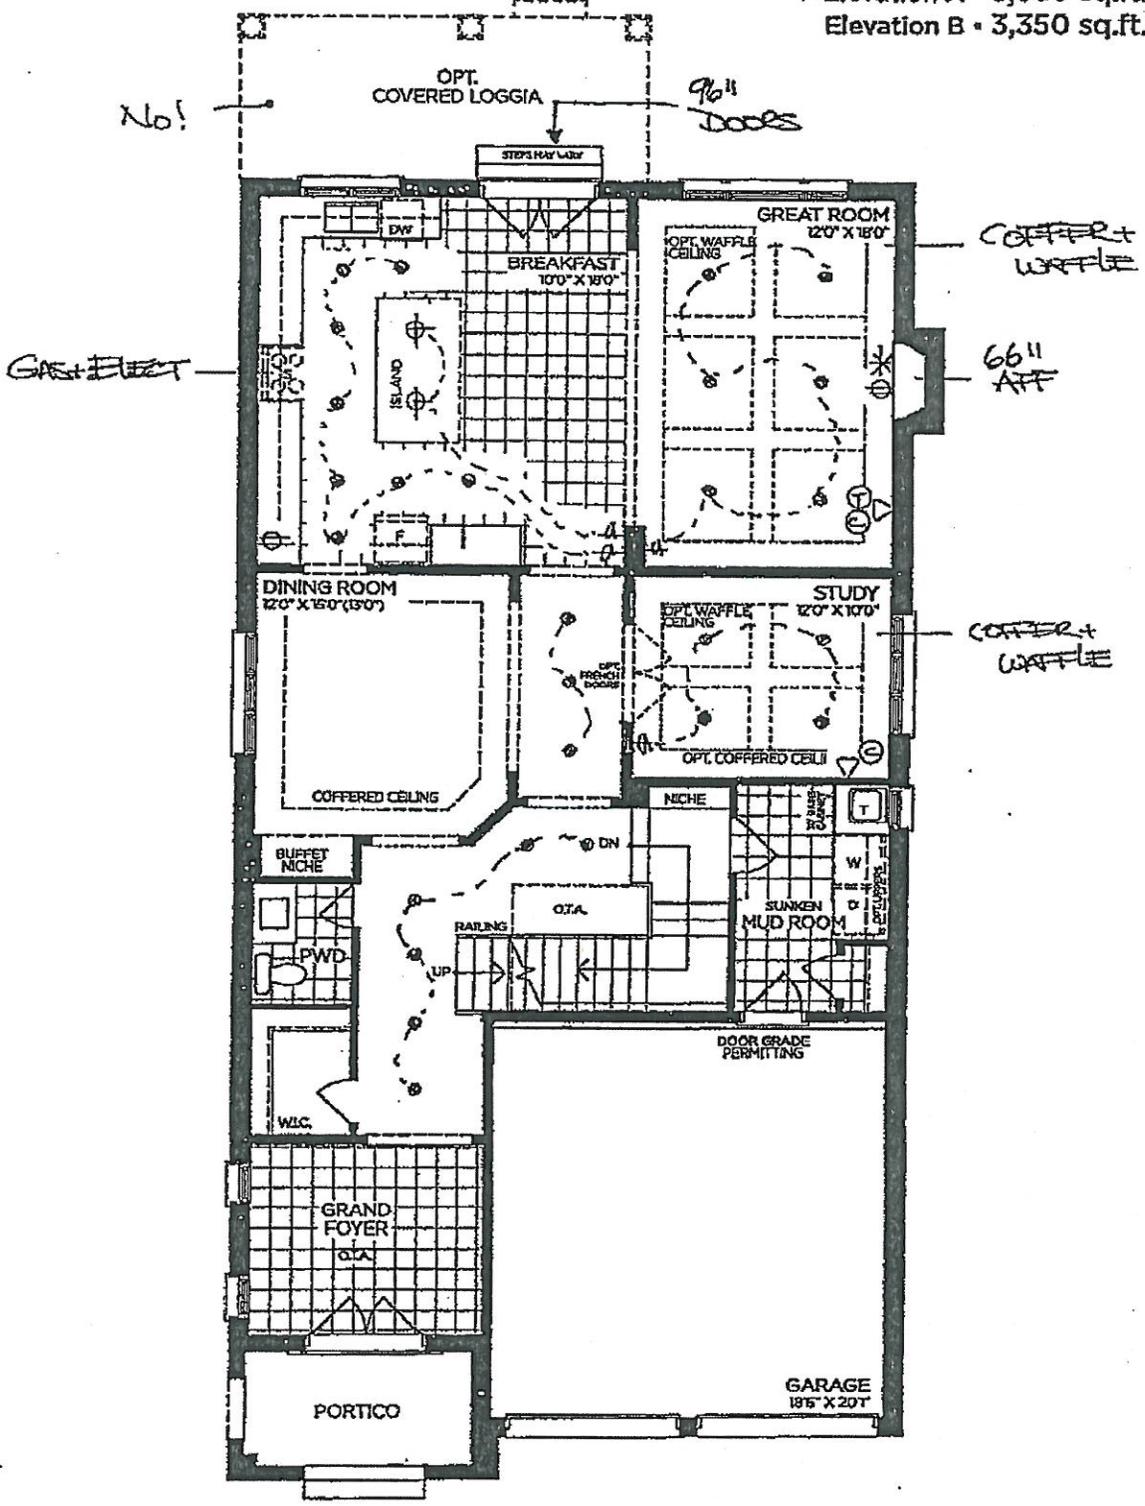

GROUND FLOOR | ELEV. A

VENDOR
PURCHASER
PURCHASER

GOLDPARK
WORTH MORESM

Prices, figures, illustrations, sizes, features and finishes are subject to change without notice. Areas and dimensions are approximate and actual usable floor space may vary from the stated area. Layout may be reverse of the unit purchased. E. & O.E. 4003

LOT 116 "B" AS BUILT

SCHEDULE 'F'



PV-116
Dec. 17, 2020.
Revised

JUNE 15 2020

PV-116

APRIL 1 2020

See attach


Rail storage
+ Niche

The Brookside

40' SERIES

Elevation A • 3,380 sq.ft.
Elevation B • 3,350 sq.ft.

8' Doors
on 2nd
Floor

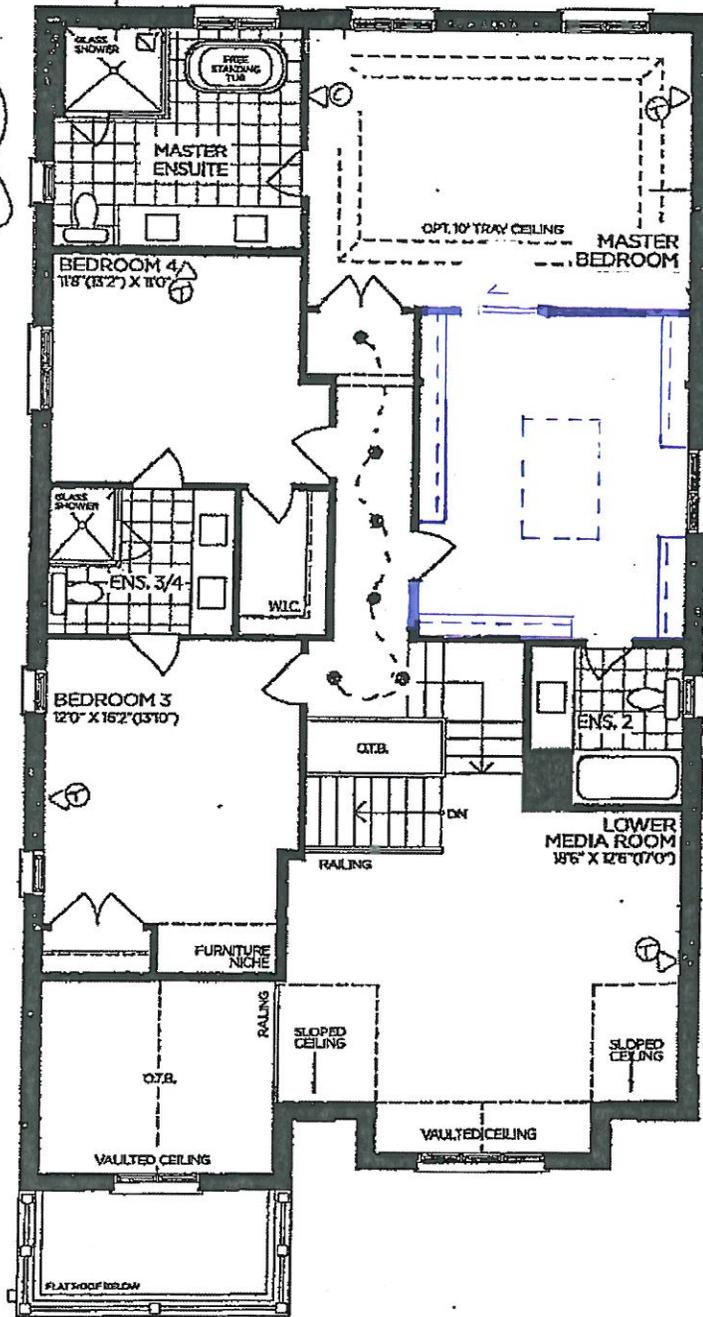

TRAY CEILING.
CREATES
DRESSING
ROOM.
*CABINETS TO BE
PRICED SEPARATELY

SECOND FLOOR | ELEV. A

VENDOR	
PURCHASER	<i>[Signature]</i>
PURCHASER	<i>[Signature]</i>

GOLDPARK
WORTH MORE™

Prices, figures, illustrations, sizes, features and finishes are subject to change without notice. Areas and dimensions are approximate and actual usable floor space may vary from the stated area. Layout may be reverse of the unit purchased. E. & O.E. 4003

[Handwritten signature]

Lot 116 "B" AS BUILT

SCHEDULE 'F'



JUNE 15 2020

PV-116


APRIL 1 2020

PV-116
Dec. 17, 2020

see attach.

The Brookside
40' SERIES

Elevation A • 3,380 sq.ft.
Elevation B • 3,350 sq.ft.

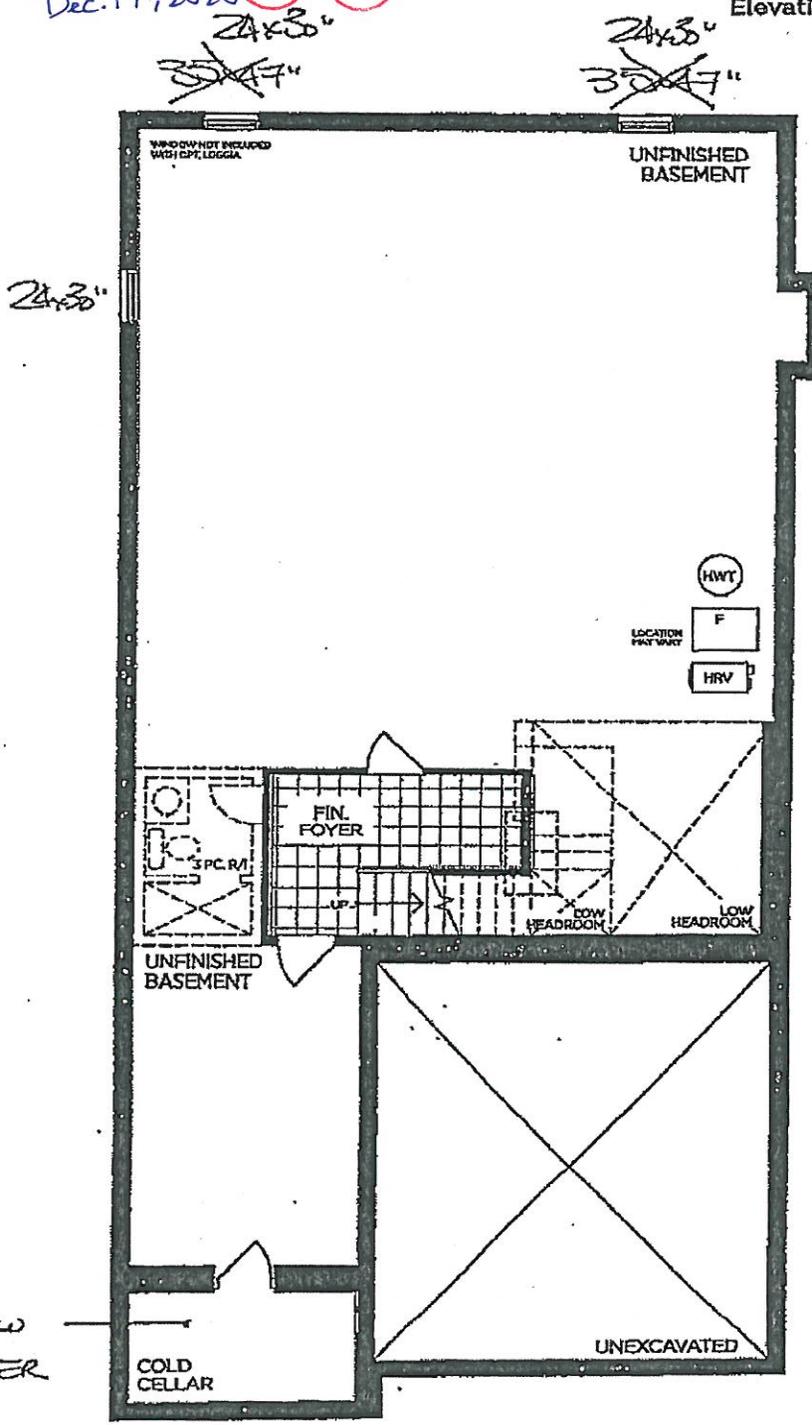

BACK-FLOW
PREVENTER
VALVE

BASEMENT | ELEV. A

VENDOR []
PURCHASER []
PURCHASER []

GOLDPARK
WORTH MORE™

Prices, figures, illustrations, sizes, features and finishes are subject to change without notice. Areas and dimensions are approximate and actual useable floor space may vary from the stated area. Layout may be reverse of the unit purchased. E. & O.E. 4003

**POSI-TEMP SHOWER ONLY* W/3 FUNCTION TRANSFER VALVE
TRIM AND SLIDE BAR W/HAND SHOWER**

MOEN - ARRIS



CHROME

from WALL

BRUSHED NICKEL

from CEILING

MATTE BLACK

MODEL TS22002EP / 3372 / TS23005 / 62320 / 3887EP / A725

Lot#
116

Room:
MASTER ENSUITE

Signature:

Date:
JUNE 15 2020

Signature: